



UNIVERSITY OF CALIFORNIA
OBSERVATORIES

The Mechanical Design of HIRES

Jack Osborne

Bruce Bigelow

*University of California Observatories/Lick Observatory
University of California, Santa Cruz, CA 95064
UCO/Lick Observatory Technical Report No. 64
April 21, 1993*

Contents

Chapter 1	The Mechanical Design of HIRES	1
	Abstract	1
	Introduction	1
Chapter 2	DESIGN OF THE COLLIMATOR MIRRORS	3
	Drawing List:	3
	Mirror Cell:	3
	Mirror Shuttle (Red to Blue):	4
	Focus Control:	5
Chapter 3	DESIGN OF THE ECHELLE MOSAIC	7
	List of Drawings:	7
	Grating Support and Subplate:	7
	Grating Supports:	7
	Gluing:	8
	Echelle Mosaic Testing:	9
	Echelle Drive:	10
	Gluing Notes:	10
	Cover	11
Chapter 4	DESIGN OF THE CROSS-DISPERSER MOSAIC	12
	List of Drawings:	12
	Grating Support and Subplate:	12
	Mosaic Testing:	12
	Rotary Table and Drive:	12
	Lifting Equipment and a Second Cross-Disperser:	13
Chapter 5	CCD DEWAR AND SUPPORT	14
	List of Drawings:	14
	Focus Stage and Drive:	14
	Vacuum Chamber and Liquid Nitrogen Fill System:	14
	Dewar Performance:	15

Chapter 6	HOUSING and STRUCTURE	16
	List of Drawings:	16
	Bally Enclosures:	16
	Light Trap Ante-room:	17
	Kinematic Mounting of the Structure on the Nasmyth Platform:	17
	Optical Layout:	18
	Cooling Tests at UCSC:	18
Chapter 7	MISCELLANEOUS (SHIPPING AND INITIAL ALIGNMENT)	19
	Handling Equipment:	19
	Initial Alignment Scenario:	20
Chapter 8	RE-ALUMINIZING AND RE-ALIGNMENT	21
	Camera mirror (or "Hextek" mirror); about 44" diameter:	21
	Sol-gel re-coating:	21
	Collimator Mirrors (17" diameter) red and blue:	22
	Re-aligning the collimator mirrors:	22
	Pumping:	22
	Mosaic testing:	22
	Re-aligning the corrector lenses:	23
Chapter 9	OTHER COMMENTS	24
Chapter 10	The HIRES Slit Area	25
	Slit Area Structure:	25
	Common Motion Stage Features:	26
	Slit Area Stages:	27
Chapter 11	THE SLIT	29
	General Description:	29
	Adjustments:	29
Chapter 12	THE SLIT ACCESSORY SERVER (Decker)	30
	General Description:	30
	Adjustments:	30

Chapter 13	FILTERWHEELS	31
	General Description:	31
	Adjustments:	31
Chapter 14	SHUTTER	32
	General Description:	32
	Adjustments:	32
Chapter 15	TV AUTOGUIDER	33
	General Description:	33
	CCD Camera System Description:	33
	CCD Camera Adjustments:	33
	Lens Focus Drive Description:	34
	Lens Focus Drive Adjustments:	34
	Lens Aperture Drive Description:	35
	Lens Aperture Adjustments:	35
	TV Filterwheel Description:	35
	TV Filterwheel Adjustments:	36
	TV Autoguider Stage Description:	36
	TV Guider Stage Adjustments:	36
Chapter 16	COMPARISON SOURCE SYSTEM	37
	General Description:	37
	Motion Stage Description:	37
	Motion Stage Adjustments:	38
	Thermal Enclosure Description:	38
	Thermal Enclosure Adjustments:	38
	Filterwheel Description:	39
	Filterwheel Adjustments:	39
	Comparison Source Optics Description:	39
	Comparison Source Optics Adjustments:	40
Chapter 17	IODINE CELL STAGE	41
	General Description:	41
	Adjustments:	41

Chapter 18	SLIT AREA COLLIMATION	42
Chapter 19	INSTRUMENT COOLING SYSTEM	45
	General Description:	45
Chapter 20	DESIGN OF THE CAMERA MIRROR SUPPORT	48
	Conceptual Design of the Support:	48
	Finite Element Analysis of the Mirror:	50
	Detail Design of the Mountings:	51
	Radial Support:	51
	Axial Support:	52
	Torsional Support:	53
	Mirror Testing:	53
	Mirror Figure Tests	54
	Mirror/Cell Figure Tests	54
	Conclusions:	55
Chapter 21	CAMERA CORRECTOR LENSES AND CELLS	56
	Conceptual Design of the Cells:	56
	Finite Element Analyses of the Lenses:	57
	Detail Design of the Cells:	58
	Radial Supports	58
	Axial Supports	58
	Force Application Assemblies	59
	Lens Cells	59
	Lens Testing:	60
	Biconvex Lens Testing	60
	Meniscus Lens Testing	60
	Conclusions:	61
	Lens Installation and Removal	62
	Lens Cell Covers and Doors	62
	Lens Lifting Slings	62

Chapter 22	ACKNOWLEDGMENTS	63
Appendix A	REFERENCES	1
Appendix B	List of Drawings — Design	1
Appendix C	List of Drawings — Collimators	1
Appendix D	List of Drawings — Echelle Mosaic	1
Appendix E	List of Drawings — Cross-Disperser Mosaic	1
Appendix F	List of Drawings — CCD Dewar	1
Appendix G	List of Drawings — Housing & Structure	1
Appendix H	List of Drawings — Shipping & Initial Alignment	1
Appendix I	List of Drawings — Re-Aluminizing and Re-Aligning	1
Appendix J	List of Drawings — Other Comments	1
Appendix K	List of Drawings — Slit Area	1
Appendix L	List of Drawings — Slit Assembly	1
Appendix M	List of Drawings — Slit Accessory Server	1
Appendix N	List of Drawings — Filterwheels	1
Appendix O	List of Drawings — Shutter	1
Appendix P	List of Drawings — TV Autoguider	1
Appendix Q	List of Drawings — Comparison Source System	1
Appendix R	List of Drawings — Iodine Cell Stage	1
Appendix S	List of Drawings — Slit Area Collimation	1
Appendix T	List of Drawings — Instrument Cooling System	1
Appendix U	List of Drawings — Camera Mirror	1
Appendix V	List of Drawings — Corrector Lenses	1
Appendix W	HIRES Control Functions	1
Appendix X	Glossary	1

Chapter 1

The Mechanical Design of HIRES

University of California Observatories/Lick Observatory
University of California, Santa Cruz, CA 95064
UCO/Lick Observatory Technical Report No. 64
April 21, 1993

1.1 Abstract

The Spectrograph design was begun in 1987 and published as "HIRES Phase C: Core Proposal" in 1988 (UCO/L.O. Technical Report No. 57). The design has continuously evolved: the latest change was to accommodate the curved CCD from Tektronics (Epps' design #4052 of 6/3/92: 65" convex radius CCD). The instrument will be shipped to Hawaii by mid-1993.

1.2 Introduction

The mechanical design was done by Jack Osborne, Bruce Bigelow and Steve Vogt. Bigelow's work included the slit area items, the corrector lenses, the camera mirror and the instrument cooling system. The "slit area" includes the television guide system and the comparison source system. Also described here will be the collimators; echelle mosaic; cross-disperser mosaic; CCD dewar; main housing; main structure; re-aluminizing and re-alignment; and miscellaneous tooling. Bruce left in September 1992 and Osborne and Vogt finished the alignment, integration and testing. A report detailing the optical components has been prepared by Dave Hilyard. Two separate reports by Terry Ricketts describe the instrument control system and the CCD control system.

The instrument was designed and drawn using AutoCAD software resulting in a complete 2-D representation and a partial set of 3-D drawings. There are 1380 mechanical drawings (25" by 42"). Many assembly drawings are included in this report. We have anticipated changes and additions to the instrument. HIRES was fabricated by the UCO/Lick Observatory shops at UCSC working from full size blueprints. These were prepared from pen plots. Vellums are stored at UCSC as well as the digital files on 1/4" magnetic tape cassettes (8

cassettes). 11" x 17" laserwriter drawings will accompany the instrument to Hawaii. The British Engineering system of units (as opposed to the metric system) was used in this project.

A brief general overview of the optical design and scientific philosophy behind the HIRES instrument was presented by Vogt²¹. The optical design for the HIRES camera is described by Epps and Vogt¹. The general assembly of the Keck Telescope and HIRES optics are shown on drawing H0010. Drawing H0102 shows the optical layout and H0148 details just the camera. A schematic is shown on H0200. An additional schematic is also in the Appendix.

All drawings and figures are in the Appendices at the rear of this report. Some drawings are used in more than one place. When updating this report please change all copies of the same drawing.

Chapter 2

DESIGN OF THE COLLIMATOR MIRRORS

2.1 Drawing List:

There are 85 E-size drawings which are listed in the locating tree, H2005.

2.2 Mirror Cell:

A single cell supports both the red and blue collimator mirrors. These are 17" diameter Pyrex® mirrors. The 2.7" thickness was set by the manufacturer and agrees with the 6:1 rule of thumb for diameter-to-thickness ratio for glass disks. The radial supports are located at 120° but should have been 90° for the lower two supports. This error should not present a problem. The radial supports are designed to be temperature-compensating. This technique is described by Nelson in TMT Note 28². Details of the design are shown in Drawing H2209. The 3 axial supports are front-defining. Three swivel-foot pads are used on the front of each mirror with spring loaded plungers directly opposite on the rear. The axial supports are also located at 120° around the mirror. The usable light beam was roughly square and so this support geometry cleared the beam. See Drawing H2206 for details of the spring plungers and Drawing H2000 for the cell assembly. The total force on the rear of the mirror should equal 1.5 times the weight of the mirror (90 lbs = 1.5 x 60). The general shape of the cell and shuttle mechanism is narrow along the optical axis of the spectrograph. This is because the original design had the slit 20" further back to allow more room at the slit area. The collimator cell was thus up against the rear wall of the housing. It wasn't until later that more room became available in the area behind the cell. (The slit was moved to improve image quality.)

The two mirrors have the same spherical shape: 327" radius. The difference between them is 0.02". This makes the cell easier to design since the mirror support and cell need only accommodate 0.02" of motion along the mirror axes in locating the two mirrors in their cell.

The mirrors will be removed for re-coating by removing the front faceplate of the double cell. Each mirror will be removed manually after removing the 3 front-defining pad assemblies. The adjustment will not be lost if the collimating

screws are not turned. The upper radial support is loosened and a special clip is installed to retain the Delrin® pad. The mirror can be replaced by noting the orientation of the outer edge index mark. Re-installation is the reverse of this. The upper radial support screw is tightened to 5 in-lbs.

The mirror covers are air-operated with magnetic reed switches mounted onto the cylinders to indicate open or closed condition. Speed control valves are mounted to either end of the air cylinders. The covers are not interlocked with the shuttle motion.

2.3 Mirror Shuttle (Red to Blue):

The motion from red collimator to blue collimator is controlled by 2 double-acting air-cylinders. An air switch causes an air-operated 4-bar linkage locking mechanism to hold one of the two upper kinematic mounts tight and an air-operated caliper brake holds the lower kinematic mount tight. The 3rd kinematic mount is loaded by the weight of the cell and focus mechanism (about 300 lbs). The electrical signal to shift from red to blue puts pressure (75 psi) on the release side of the lock which overcomes the 60 psi locking pressure. When the stage moves about 1/2" the mechanical limit switch opens to make the locking pressure zero. The switch is then ready for the blue-to-red motion. The opposite switch causes the opposite lock to engage when the shuttle is within 1/2" of touchdown. This locking motion also helps seat the ball-in-groove kinematic mount since we found that friction was high enough that seating at the ball-in-cone mount was a problem. We added check valves to prevent exhaust air from operating the lock cylinders prematurely. See Drawing H2415 for details of the pneumatic control logic.

The speed control valves on the main motion cylinders are set to bleed slowly so that the shuttle motion is very gentle at the touchdown portion of the travel. Valves were added to bleed the remaining air after touchdown to unload the drive cylinders and speed up the cycle time from red to blue and back. Time delay circuits were designed to open the valves for 4 seconds after arriving at the kinematic mounts. All motion is prohibited during the time these valves are open.

Before the collimator mirrors are aligned to the rest of the spectrograph, the shuttle should be adjusted so that the mirror cell is tilted 1.75° (half of 3.5°) at each end of travel. There are 2 adjustments, one at each of the lower (ball-on-flat) kinematic mounts.

The air exhaust runs through a long, large diameter pipe. A 1/2" tube was tried but the back pressure caused the clamp cylinders to engage the stage while it was moving.

Red or blue position status is via magnetic reed switches mounted to the main drive cylinders.

Drawing H2401 shows the parallel linkage of the shuttle system; Drawing H2415 shows the air system schematically; and Drawing H2460 shows one of the locking mechanisms and one kinematic (ball-in-cone) mount.

There is a middle position for the shuttle: this was designed after assembly. Moving to the middle and staying there is rather crude. Two split, plastic cylinders attach to the main drive cylinder rods to hold the stage in the center position. To center manually, halt the shuttle and release the brake button in the middle of its travel. This should be done with 2 people and lots of light. The rear-mounted autocollimator can now be used without removing either mirror or opening the covers.

2.4 Focus Control:

The focus control was added after the project was begun and the cell was finished. The total travel is about 3/4" along an axis halfway between the incoming and outgoing beams. That is, along the mirror normal axis. The focus control stage is 3 flex plates arranged in a triangular pattern. There is no sideplay in the stage. The stage is driven by 3 THK ball screws bearing on 3 hardened steel pads. Drawing H2600 shows the focus housing and shuttle stage. The mirror cell, shuttle housing and 3 flex plates are all made of aluminum, thus avoiding thermal expansion and contraction problems. Coil springs are used to keep the cell in contact with the 3 screws. The 3 screws are tied together with 3 timing belt sprockets and a long timing belt (337 teeth). A DC servo motor is mounted directly to one of the 3 screws. The motor is mounted to a THK linear slide so that it follows the screw (and cell) relative to the housing of the focus stage. Four limit switches locate the travel ends and an optical interrupter locates the center of travel and which side of center you start from. Encoding is via the motor-mounted incremental encoder. There is no absolute encoder for this stage. The motor is used throughout HIRES but has a 5:1 gear box mounted here for more torque. There are 3 dial indicators which serve as rough alignment devices in case the belt must be removed from the 3 drive screws. Drawing

H2610 is a schematic of the drive. Drawing H2620 is an assembly drawing of the focus stage and shows the triangular arrangement of the 3 flex arms. The motor/encoder is shown in Drawing H2623 and the gearbox is shown in Drawing H2660. The limit switches are shown in Drawing H2630. During the testing we discovered that one of the electric brakes failed causing the belt to come off. We then removed both brakes and saw no drift in the focus. We are still watching for this. The 5:1 gearbox is able to hold the stage from back-driving.

Chapter 3

DESIGN OF THE ECHELLE MOSAIC

3.1 List of Drawings:

There are 93 E-size drawings which are shown on locating tree H3005.

3.2 Grating Support and Subplate:

A 1 x 3 mosaic of gratings was used with overall dimensions of 12.6" by 49.6". The gratings were replicated by Milton Roy from a master grating which they ruled. The substrates are Zerodur® from Schott Glass. Each Zerodur grating is 12.6" by 16.5" by 3" thick. (see Drawing H3454) The rulings run along the 12.6" direction. The two gaps are 0.04" wide. The gratings are stepped by 0.09" to hide the un-used portion in the shadow of each upper grating (about 3/8" wide). See H3150. The pivot axis is arranged to be on the surface of the central grating, parallel to the rulings. See assembly Drawings H3600 and H3100. Drawing H3425 shows the blaze detail. All 3 gratings are held against a 4" thick granite subplate. The grating back support detail is shown in Drawing H3500 and side support details are shown in Drawings H3510, H3511 and H3520. The subplate is held in an aluminum cell. The subplate is black gabro, a type of granite with an elastic modulus of 12×10^6 psi. Note: standard tool room granite plates are 30% quartz for better wear resistance but have 1/3 the stiffness ($E = 4 \times 10^6$). The subplate is seen in Drawing H3470. Details of the three subplate back-supports are shown in Drawing H3300. The three side supports are shown in Drawings H3340 and H3345. The finite element analysis results are shown in Drawing H3801: The predicted deflection for 180° gravity change is 0.16 arc-sec for the worst case. This is the relative angular change between the worst 2 grating blanks. The software package used to model this flexure was ANSYS. The location of the 3 back supports was selected to minimize this flexure.

3.3 Grating Supports:

The mosaic concept was to be a passive support. The initial alignment would then be done and no adjusting would be needed forever. The Zerodur gratings

would be located by three Zerodur washers against the granite subplate. The details of the support can be seen in Drawings H3500 (back support), H3510 (side support, type I) and H3520 (side support, type II). The washers were polished on one side and fine ground on the other. The polished side was optically contacted to the polished grating surface. The three supports in each grating pull the grating against the subplate with 1.5 times the grating weight (90 lbs = 1.5 x 60). The washers were machined by fine grinding after measurements of the mosaic were made by interferometer. The washers could be measured by Anorad profilometry in 6 places around the perimeter, ground to remove as little as 0.000,02", re-measured and re-installed for another interferometric test in one day. It took one day to evaluate the test results and predict the next cut and it took typically 4 cuts to get one pair of gratings aligned to each other. This was about 8 cuts for the echelle mosaic (and 4 cuts for the cross-disperser mosaic). We did this with bare, polished blanks and then again after replicating. The error in replication turned out to be less than 3 arc-sec. The gratings were aligned in the plane of the gratings by pushing on the sides or on Zerodur blocks which were glued to the sides. These adjustments and supports were aluminum and stainless steel. We found during cold testing that the side supports are not stable enough and so invar parts are being built to replace these components.

3.4 Gluing:

The first experience with mosaics is documented in UCO/Lick Technical Report #49 (Reference 9). This 2 x 2 mosaic used 6" x 8" Zerodur blanks. Each blank was supported with three invar inserts epoxied into the back of each blank. We used Devcon 5 minute epoxy. We scaled up the design for the HIRES mosaics. The under-cut pockets in the back were larger and we used Eccobond 285 with catalyst 11 by Emerson and Cuming to embed the invar threaded inserts. This epoxy cures at an elevated temperature (80°C). We had failures in the glass after this process. The side pads were glued with Eccobond 285 and catalyst 24LV. This is a black adhesive and comes apart at boiling water temperature. The plan was to remove the side blocks for replication after our initial alignment testing, by placing the blanks in boiling water. The rear inserts would then stay in place and not come out. The 285 glue with this catalyst is rated to take up to 177°C. They would not interfere with the replication process at Milton Roy. The side pads were 2" long invar blocks and we had glass failures here, too.

Though the expansion coefficient for invar is small, it is not zero and so we suspect the motion of the invar pads from day to night in the lab caused the glass to be stressed to failure.

The solution to both these problems was to use a different epoxy. We were referred to Hysol EA 9313 by A. DuBois (See Reference 18). Drawing H3040 details the gluing procedure and shows a test block. The side support block is now Zerodur instead of invar and we have had no more problems there. The Hysol epoxy is softened with Methylene Chloride and by using a thin saw blade, the side blocks were removed before replicating. This was a time-consuming process. The blocks were re-attached after replication. The invar inserts were bonded into new holes bored into the grating blanks by Zygo. The old pockets were cleaned out with Eccostrip and then we decided to acid etch the cracks with Ammonium Bisulfate. This caused more problems than it solved because the acid seemed to migrate to all the surfaces of the grating blanks and left stains on every surface. We sent the tarnished blanks to Zygo to polish again.

3.5 Echelle Mosaic Testing:

This topic is covered in greater detail in the optical report. Drawing H3061 shows one of the grating tests using a folding flat mirror and Zygo interferometer. Drawing H3603 shows the final test with the mosaic at 10.5° to the interferometer. An isolation platform using Newport air-mounts was built to test this mosaic. We have tested the mosaic with the interferometer while it is mounted inside HIREs.

The blaze angle turned out to be slightly different from specified and so the drive was modified to move the center position by 1.5° (70.5° instead of 69°). The grating was enough oversize to accommodate this change and the tilted grating and cell did not interfere with the incoming light from the slit. Final alignment of the three gratings in the plane formed by the mosaic is less than 1 arc-sec ("hinge" or dispersion direction). Alignment in the cross-dispersion direction is also sub arc-sec. Alignment of the gratings about the center grating normal axis is less than 5 arc-sec.

We tried to make grating blanks here (UCSC) but found it was cheaper and faster to have Zygo make the blanks. The front and back surfaces have to be flat to 20 waves. Zygo can do this easily. We had tighter tolerances since we were first testing the concept to 1 arc-sec and we needed 1 wave surfaces. This will not be necessary in the future. Zygo bored the mounting pockets in the back.

Zygo also machined the bevels which are very important for proper separation during the replication process. Milton Roy returned our first set of blanks because the bevels were out of tolerance. This "take-apart" process is proprietary and so we never learned exactly what the bevel minimum could be. The success of replication lies in their ability to split apart a 12" by 16" glue joint without damaging the glass or the thin (0.001") layer of epoxy.

3.6 Echelle Drive:

The drive is shown in Drawing H3200 and the bearings in Drawing H3240. Echelle drive and encoder sub-assembly are shown in Drawing H7300 and limit switches are shown in Drawing H7330. A 6" linear stage from Daedal and Heidenhain linear encoder are used here. This encoder was not rated below 0°C but we have tested it to -20°C. We found that the motor encoder works as well as the (expensive) linear encoder. After the echelle drive was finished and tested we decided not to design a linear encoder into the CCD focus stage.

The echelle pivots by two stub axles bolted to the cell. These are carried in two SKF double row spherical roller bearings. One stub axle has a contingency stub protruding from the bearing block. This is for locating a rotary encoder if the linear drive and encoder did not work out. The opposite side of the A-frame support structure has a tab which angles down to the third kinematic mount of the main frame. This was not used but was intended for a stiffening element if the echelle ended up with a low natural frequency. Drawing H3244 shows the alignment tooling for locating the echelle bearings.

3.7 Gluing Notes:

Keck Observatory Technical Notes 194⁴ and 160⁵ derive practical guidelines for glue joint design. We have used Hysol EA9313 epoxy resin with a nominal thickness of 0.012". A description of the glue methods used in the Keck Telescope was written by A. DuBois as "Keck Observatory PMSS, Epoxy Bonds for Segment Inserts," November 26, 1990. HIRES Drawing H3040 lists our cleaning and preparation methods and shows a 3" x 3" x 3" test block which has been loaded to twice the maximum insert load. The three small side blocks which are arranged around the test block, are loaded to 1 times the maximum expected load. This test assembly was glued and loaded in July, 1991. It was then placed

in a freezer at -20°C . It has been stored at that temperature for almost 2 years. It will be kept at UCSC and inspected periodically.

The solvent for this epoxy is Methylene Chloride.

3.8 Cover

The air-operated cover is shown in Drawing H3700 and the pneumatic control is diagramed in Drawing H3703.

Chapter 4

DESIGN OF THE CROSS- DISPERSER MOSAIC

4.1 List of Drawings:

There are 126 E-size drawings which are shown in the locating tree, H4005. 21 of these are for the replacement turntable.

4.2 Grating Support and Subplate:

A 2 x 1 mosaic of 12.5" x 16.5" blanks was designed. The gap is 0.04". The overall size is 16.5" x 25". This is very similar to the echelle support and common parts were used wherever possible. Drawing H4470 shows the subplate. Drawing H4000 shows the cell assembly. Drawing H4700 shows the air-operated doors and Drawing H4751 shows the pneumatic details.

4.3 Mosaic Testing:

The final alignment accuracy yielded a pair of gratings with 0.77 arc-sec error in the direction perpendicular to the echelle dispersion ("cross" dispersion) and less than 0.02 arcsec error in the echelle dispersion plane ("hinge" error at the joint). This corresponds to mismatches of less than 5.4 microns of cross-dispersion error and 0.14 microns of echelle dispersion error at the CCD. We were not sure what kind of specification we had to meet, but are very happy with this result.

4.4 Rotary Table and Drive:

An initial purchase of an Anorad precision rotary table was a disaster. We then found ourselves in the position of designing a precision turntable to fit in a very narrow package to replace the Anorad table. We were successful. The drive uses one of the servo motors used throughout HIRES and a Heidenhain incremental rotary encoder is mounted directly on axis. This encoder has 720,000

pulses per revolution and a single pulse per revolution index track. The resolution is 2 arc-sec. Drawing H4251 shows the encoder. A brake was designed and installed. This is shown on Drawing H4534. It was discontinued because we observed the stage to creep over long (8 hour) time periods. An air cylinder provides a counter balance to the offset weight of the mosaic (450 lbs). See Drawing H4511. Turntable details can be seen in Drawings H4264 and H4530. Drive schematic is on Drawing H4281.

4.5 Lifting Equipment and a Second Cross-Dispenser:

The lifting bridle is detailed in Drawing H4740. The manual hydraulic crane is used to exchange grating mosaics. A second mosaic will be built soon.

Chapter 5

CCD DEWAR AND SUPPORT

5.1 List of Drawings:

There are 216 E-size drawings which are shown in the locating tree, H7005.

5.2 Focus Stage and Drive:

Drawing H7250 shows the dewar frame and stage. The stage is 3 flex links mounted with disconnect pins. This is the point where a second dewar will be attached. The dewar frame is then defined by 3 hardened steel pads resting on 3 steel buttons. These are driven through a 20:1 lever system by 3 micrometer screw drives. The micrometer screws are coupled to a single motor by timing belts. See the H73xx series of drawings. Drawing H7350 is a kinematic drawing of the drive. One pulse of the motor encoder represents a theoretical motion of 6.94×10^{-8} inch (1.76 nano-meters). Total focus travel is $\pm 0.012''$. (The target was $\pm 0.5''/20 = \pm 0.025''$, but the double set of limit switches and the required overtravel for each one, limited the focus travel.) There are three manually-adjusted bronze screws in the focus system which allow for a coarse adjustment of $\pm 0.5''$.

5.3 Vacuum Chamber and Liquid Nitrogen Fill System:

Drawing H7130 shows the CCD dewar and support frame. Drawing H7131 shows the detail of the liquid nitrogen can, Drawing H7180 shows the central vacuum housing with field flattener window and Drawing H7500 shows the pre-amp box which hides in the shadow of the center housing. The liquid nitrogen automatic fill system is shown in Drawing H7600. The design for the level-sensing tri-axial capacitors was borrowed from Lawrence Berkeley Lab⁶. See Drawing H7601. The dewar transport and lifting systems are shown in Drawing H7800.

5.4 Dewar Performance:

The LN₂ reservoir holds 3.5 liters. An ion pump keeps the vacuum at 10⁻⁸ torr. Details of the dewar design and construction can be found in a UCO/Lick Observatory Technical Report in progress by Osborne. Hold time is approximately 15 hours and so transfer happens twice daily. A 50 liter supply dewar rests on the Nasmyth platform. The utility board in the CCD controller monitors the level sensors and begins the transfer of cryogen and stops it when full. The venting of nitrogen gas is carefully done so that the housing does not fill up with nitrogen which is deadly. The 50 liter supply dewar is pressurized to 2.5 psi with clean, dry compressed air until the transfer is completed.

The Varian ion pump (2 liter/second) power supply has been modified. The schematic is shown in the Appendix. This modification prevents over-heating of the pump unit after power loss and during start up at a pressure higher than about 10⁻⁴ torr. The pump could get hot enough to cause the o-ring in the valve to fail. Or the pump could get hot enough to start a fire.

Chapter 6

HOUSING and STRUCTURE

6.1 List of Drawings:

There are 225 E-size drawings. These are shown on H6000, the locating tree for Housing and Structure.

6.2 Bally Enclosures:

Three pre-fab modular rooms were bought for this instrument: The small, 6 foot by 6 foot "Vault" contains the electronics and operates above 5°C. It is cooled by Observatory coolant until the temperature drops below 5°C. The heat generated by the electronics component serves to keep the temperature above 5°C. The components are not rated to go below 5°C. The large room was 15'5" by 17'4" when ordered from Bally. It was modified with a large cylindrical portion which fits inside the elevation axle. The design clearance is 1" in radius or 2" in diameter. A 5' by 10' ante-room was added later. These enclosures use 4" thick poured-in-place polyurethane foam for insulation. They come with self-closing sealed doors and insulated floors. The locking latches have been removed (for safety). The incandescent lights are dim. We added 8-foot fluorescent lights which are rated for very low temperatures (-40°F). These fluorescent lights have persistent glow for many minutes after being turned off and also cause the paint of the interior walls to fluoresce. Thus, we recommend that the bulbs be removed during routine operation of the spectrometer and only installed and used during extended periods of maintenance. We added an overhead raceway for wires and hoses. The main enclosure is shown in Drawing H6400. The Vault is shown in Drawing H6425. H6410 is a 3-D drawing of the main housing and vault. It shows the conical transition section and cylindrical "nose." This drawing can only be viewed in the drawing editor in AutoCAD. The single view shown in the Appendix here is one of an infinite number of views.

6.3 Light Trap Ante-room:

An ante-room was added to help keep the main enclosure dark and provide a location for donning clean-room apparel. This room is shown on Drawings H6460 and H6461. It is about 5' by 10'.

6.4 Kinematic Mounting of the Structure on the Nasmyth Platform:

The instrument is located on the RIGHT Nasmyth Platform. The decision to move from the Left platform was made in May, 1993, during packing and shipping. There are benefits in occupying the Right platform: 1. access to the elevation encoder is preserved, 2. access from the fixed Nasmyth Deck structure is easier while the telescope is in the stored position, and 3. no walkways need modifications. Drawing H0010.H shows the new configuration. Drawing H0010.G shows the old configuration. The mounting holes are different between the two platforms. We intend to match the slots in the 3 support feet to the mounting holes (12 mm threaded holes) on the Right Platform by using transfer screws and aligning the feet, then removing the feet and using a milling machine at the Summit to locate the slots.

The attachment to the telescope is through 9 threaded holes (12 mm). The mainframe of HIRES attaches to 3 feet which bolt to the 9 holes in the platform to distribute the load into the telescope. The foot closest to the slit is fitted with a spherical bearing. This bearing is shown in Drawing H6177. A typical foot assembly is shown in Drawing H6120. An adjustment in the up/down direction is provided by a large acme screw (1.5" Dia x 5 TPI). Adjustment in the slit jaw direction (telescope-defined y-axis, that is horizontal direction) is via slots in this foot assembly. The foot near the collimator mirrors has a spherical pad resting on a flat surface. This simulates a ball-on-flat joint. An acme screw here (5 TPI) allows vertical adjustment and a tilt adjustment to align with the telescope elevation axis. The 3rd foot has a simulated ball-in-groove joint. The detail is shown in Drawing H6174. This last foot allows the Nasmyth deck to change shape without introducing forces into the HIRES optical bench structure. This preserves the original alignment of the spectrograph optics. There are slots in this 3rd foot which run in the telescope-defined z-axis (along the instrument axis). This allows the instrument frame to be steered in the plane of the deck to align with the elevation axis. There is no vertical adjustment in this foot. If

one is required, then we will use shim plates. It is thus possible the slit jaws will not be perfectly horizontal.

A series of drawings beginning with Drawing H6020 show the day-to-day assembly of HIRES onto the Nasmyth deck. The mounting feet are shown clearly.

6.5 Optical Layout:

The spacing of the optical elements is detailed in Drawing H0102. The Camera layout is shown in Drawing H0148.

6.6 Cooling Tests at UCSC:

Drawing H6470 shows the Bally freezer unit located in the main enclosure. The freezer is not to be shipped to Hawaii. During the initial cold testing in 1989, the temperature was -22°C . The final optical testing in February of 1993 was done at -7°C . The electronics vault also had a Bally freezer installed. Its temperature was kept at 5°C .

Chapter 7

MISCELLANEOUS (SHIPPING AND INITIAL ALIGNMENT)

7.1 Handling Equipment:

The Ruger Crane is a manually operated 1/2 ton crane. It has a 2 speed feature which is not straightforward to initiate: When lifting very heavy items (750 lbs), the relief valve must be set to 1/4 to 1/2 turns open. This is not an obvious thing to do. The crane has 2 mounting sockets. There are 2 lifting arms to reach different items. See Drawing H9000. The main use for the crane will be changing Cross-Dispersers. The socket on the optical centerline will be used for this. Note- be sure to remove the crane aafter using at this station or it will interfere with the optical path of HIRES! See Drawing H9005 for the correct arm location. Other items to be lifted include the Collimator Mirror Cell (used with the white lift arm) and the Echelle mosaic cell. The Echelle can be lifted from either socket (See Drawing H9006). These will not be routine operations.

The pneumatic-tired dollies are for moving the grating mosaics (See Drawing H3075 for the Echelle and Drawing H4075 for the Cross-Disperser cart). This keeps the loads on the fragile subplate supports to less than 1.2 g's. Only manual lifting devices should be used to lift grating cells. A lifting bridle is provided for the Cross-Disperser. A commercial swivel eye is located in the top of the Echelle cell.

The roll-around hand-cranked lifter is for corrector lens cells and the CCD dewar. See Drawing H7800.

The camera mirror and mount are removed as a single unit using the overhead I-beam trolley and manual chain hoist. Be sure to release the hold-down clamps before attempting to lift the camera mirror, or you will lift the entire spectrograph! The mount has 4 casters for rolling once it is lowered to the floor. In the future, there will be both a red and a blue camera mirror. The passing arrangement is shown in Drawing H6936.

Three large steel casters mount onto the mainframe and are for moving during dis-assembly, packing and re-assembly. They will have no other use after

commissioning. See Drawing H6605. The mainframe dis-assembles for shipping in 8 foot wide containers. See Drawing H6200.

7.2 Initial Alignment Scenario:

Drawing H6500 shows some of the alignment tooling. The permanent tripod at the rear of the mainframe has been bolted, pinned and welded. It is not intended to be removed or adjusted. An autocollimating telescope is fitted to the tripod and used to align the spectrograph. There are no adjustments to this mounting. The philosophy here was to open the slit jaws and use this same autocollimator to find the telescope optical axis. This will be used in the future for modifications, additions or to look for problems. The Davidson Autocollimator will remain with the HIRES instrument.

Drawing H6510 shows the rear tripod. A moveable tripod assembly which mounts ahead of the slit is shown in Drawing H6530. This device has an aluminum storage plate for protection and a wooden storage crate when not in use. The tripod is fitted with adjustments but should never need adjusting. Should this tripod be needed, it can either be installed through the forward panel which has the entrance hatch (use the "man-lift") or by carefully 'snaking' it into position from the inside of the HIRES housing. Whenever this tripod is re-installed, its alignment should first be verified by checking against the fixed autocollimator mounted behind the collimator cell.

Alignment of the slit area is detailed in Section 18. No re-alignment is intended; all of the joints have been pinned. The only alignment which may need looking after is the tilt of the comparison lamp feed mirror and the centering of the pupil mask in the comparison lamp optical system. The strategy is to ensure that the apparent pupil of the comparison source system coincides precisely with that from the telescope.

Chapter 8

RE-ALUMINIZING AND RE-ALIGNMENT

8.1 Camera mirror (or "Hextek" mirror); about 44" diameter:

This mirror will be coated at Mauna Kea using an adapter which is shown in Drawing H5420. The adapter assembly has been engraved to help identify it. The mirror support hardware is left in place during cleaning and aluminizing. The old coating will be stripped off using chemicals. A strip of 1/4" wide non-hardening strip caulking is placed in the joint just behind the front plate. This will keep any liquid from going into the cavities in the interior of the mirror. This strip of material must be removed before placing in the vacuum chamber. The original coating was done at Mt. Hamilton hanging vertically. The tank at Mauna Kea has the mirror looking face down. The red and blue mirrors will require different coatings. We are assuming that the coating technology will be present at the Summit. This will keep travel to a minimum for these fragile mirrors.

8.2 Sol-gel re-coating:

The 2 large corrector lenses (about 32" diameter) have been Sol-gel coated at the Lawrence Livermore National Lab. They have lifting slings and carrying fixtures which have been reviewed by the technicians there. Refer to UCO/Lick Observatory Technical Report No. 62 dated June 1992 by Bigelow entitled: "Mechanical Engineering Safety Note - Lifting Slings for the HIRES Spectrograph Corrector Optics." (Reference 8). There are 2 clean cases for shipping the lenses.

The field flattener lens (6.5" diameter) has a case but no special sling. This optic will be coated before HIRES arrives in Hawaii. LLNL has slings for this size lens.

The Sol-gel is extremely fragile and scratches easily if even lightly wiped. The Sol-gel also has 35 times the surface area of the part it is on, so is a virtual sponge for dust and other contamination. Great care must thus be taken to guard against dirt or touching of these coatings.

8.3 Collimator Mirrors (17" diameter) red and blue:

These mirrors have wooden cases for storage and shipping. They will be hand-carried to Z, C & R in Los Angeles for red coating and blue coating. These mirrors weigh 60 lbs each and so can be installed or removed manually.

8.4 Re-aligning the collimator mirrors:

This is done with the Davidson autocollimator mounted in the slit area tripod socket (refer to Drawing H6530). Before removal of one or both of the mirrors, the autocollimator will be installed and the target mounted onto the central pedestal using the kinematic mount and the 3 steel balls (refer to Drawings H6560 thru H6565). We have used this method and achieved 10 arc-sec re-installation accuracy. If a focus drive belt should break, then refer to the 3 dial indicators on the rear of the collimator housing. These will be recorded after initial instrument assembly and checkout. Drawing H2640 would be a good place to record these readings.

8.5 Pumping:

A clean, oil-less vacuum pump must be used inside the HIRES enclosure after the field flattener lens is re-installed onto the dewar since this is the vacuum sealing window. We expect to have such a pump in place after arrival in Hawaii. This pump uses a liquid nitrogen cold trap and so the room must be ventilated while pumping the dewar or while operating the pumping station.

8.6 Mosaic testing:

There is no provision for mosaic (either echelle or cross disperser) re-alignment. This was intended to be a passive support and so far we have seen nothing to change our original intent. We do have hardware for mounting the Zygo interferometer on the main frame to look at either of the 2 echelle mosaic grating joints or the single cross disperser mosaic grating joint. These setups are shown in Drawings H6220 and H6222. We are not leaving the interferometer in Hawaii. We have used it in our shop at UCSC and found it to give stable enough results that an air isolation table was not needed. We hope that the

telescope environment is at least this stable. The mounting stand replaces the center hydraulic lift mount socket.

The gratings cannot be re-aluminized, of course. There is no cleaning procedure. The spectrograph was designed with the echelle facing down to minimize dust collection. There is one thumb print on the echelle mosaic and it has been documented on H3640. It is fortunately outside of the beam footprint.

8.7 Re-aligning the corrector lenses:

The first step before removing anything is to align the autocollimator with the corrector lenses: Lift the cross-disperser cell and store it on its cart. The autocollimator adapter fits onto the turntable and the autocollimator can then be rotated to line up with the camera axis. Drawing H4210 shows the adapter. Drawing H6500 shows the autocollimator in place. The inter-lens spacing should be documented. There is no need to locate the lenses along the optical axis to better than 0.01" and the elements will easily go back into their cells to that tolerance.

To re-align the entire camera, the dewar frame and camera mirror must be removed and the second camera mirror mount installed with its autocollimator. (Two autocollimators are required here for efficient aligning) Note that when the second mirror has been installed onto this mount, an additional fixture will be needed for this alignment procedure. It will be designed and built at the same time the mirror support hardware is fabricated. This fixture allows the cross-disperser table to be rotated to align with the camera mirror axis. The camera mirror (and camera mirror mount #1) can now be re-installed to check its alignment using the cross-disperser autocollimator. The corrector lenses are re-installed and checked. Finally, the dewar frame is replaced. If you suspect it has shifted or want to check it, the camera mirror is removed again and the camera mirror mount autocollimator is installed to look at the field flattener. The spacing between the camera mirror and the field flattener cannot be measured directly anymore, unless the field flattener can be recoated since any touching with an inside micrometer will damage the Sol-gel. The spacing can however be measured indirectly by measuring between the mirror and front lip of the dewar body, and then subtracting the known distance from dewar body to lens vertex. See Drawing H0148. The CCD is aligned by taking many spectra at many focus settings. This has been detailed by Vogt in his notes.

Chapter 9

OTHER COMMENTS

Hooks were left for future expansion. The large side door in the housing was located so that in the future a Cross-Disperser might be rotated to look at a camera axis on the other side of the optical axis. See the layout on Drawing H6100. There are 4 stub flanges attached to the main frame to add additional supporting structure.

This project has been reviewed by a committee chaired by Dr. Bob Tull at the University of Texas. Also on that committee was Dr. Frank Melsheimer of DFM Engineering Inc, Longmont, Colorado. Progress was also monitored by 17 Quarterly Reports submitted to the Science Steering Committee (SSC). Software reviews were included with the mechanical reviews and supplemented with reviews of the Low Resolution Imaging Spectrograph (LRIS) together with HIRES.

Chapter 10

The HIRES Slit Area

The HIRES spectrograph slit area is composed of a large steel supporting structure and twelve motorized or air-powered stages for remote control of slit area functions. The intent of this document is to provide a brief overview of the standards and design philosophy used throughout the slit area, and to give a general description of the layout, operation and adjustment of each of the various stages (see Drawing P1001). This document will also serve as a roadmap for any journey in search of engineering information concerning the slit area.

10.1 Slit Area Structure:

Previous experience with slit area instrumentation at Lick Observatory suggested three important features for the HIRES slit area. First, the slit area is subject to improvement and modification throughout the life of the instrument, and should be designed for easy modification from the start. Second, the slit area is typically the most crowded region in the spectrograph, so all structures and components should strive for compactness. Finally, certain accessories will tend to preclude the use of others, so stages should be able to be readily removed or interchanged. These three features of easy modification, compactness and interchangeability will be discussed in relation to the slit area and its motion stages.

The central backbone of the HIRES slit area is the "slit area structure" and several constraints drove its design. One aspect dictated by the telescope was the requirement that the slit area structure be of a cantilever design. The location of the nominal Nasmyth focus at the center of the elevation axis journal required that the slit, decker and autoguider all be located inside the bearing. Another important objective was to leave a maximum amount of space for accessories and relatively easy access to them. Another issue was to design the structure such that its first natural frequency was not likely to be excited by motion of the telescope or the active mirror control system. All of these points and others lead to the design of the cantilevered space frame for the slit area (see Drawings H6710 and H6711). The 2" x 4" structural steel tubes are liberally peppered with 1/4-20 threaded inserts on regular spacings to provide easy installation of

new components. Note that the threaded inserts are stainless steel and will gall with stainless fasteners unless they are properly lubricated (i.e. "Never-seez") on assembly. The structure is primarily a rectangular weldment, with several bolt-on diagonals to increase stiffness, but which are removable for access if needed.

10.2 Common Motion Stage Features:

From the outset of the HIRES project, it was clear that there might be as many as twenty (first light) remotely controlled functions, which strongly suggested standardization on a minimum assortment of components. To that end, DC servo systems were selected for all areas requiring precision motion control and air cylinders for all toggling and non-precision motion applications.

We chose to standardize on DC servo systems for all of the precision motion functions for a variety of reasons including freedom from annoying (stepper motor) resonant frequencies, low power and high torque, compact motor/encoder units, and prepackaged servo drive and optimizing software. We selected Galil 50/1000 systems including Galil motor controllers, Pittman 50 oz-in DC servo motors with integral Hewlett-Packard 4000-count per revolution shaft encoders, and the Galil software package. For fiducial location sensing, a TRW OP8970T55 optical interrupter switch was chosen. To provide software limit sensing, Microswitch BZ-2RW822-A2 limit switches were used. A second switch, Microswitch DT-2RV22-A7, was used to cut power to the servo motor in the event of a software or software limit switch failure.

For the roughly twenty non-precision situations, we selected a variety of different sizes of air cylinders manufactured by Bimba. Although we had already decided to use the Microswitch limit switches for the precision stages, we chose to use the Bimba magnetic reed switches for sensing limits on all of the air powered stages. These switches are designed for use with the air cylinders and helped avoid a fair amount of bracket design and fabrication. Along with the cylinders, we standardized on Skinner Magnalatch 4-way solenoid valves, which have the benefit of no power consumption after latching. Wilkerson R16-02-000 air pressure regulators were used throughout. Camozzi "super rapid" quick assembly fittings were used for many areas. These developed trouble during the cold test and are being removed and replaced with Swagelok tube connectors. The nature of the trouble was that these finger-operated fittings couldn't be operated by human fingers at cold temperatures. The Swagelok

connectors dis-assemble with small hand tools (wrenches). The Bimba cylinders should always be supplied with clean dry air. We experienced many cold-related problems: moisture freezing caused cylinders to hang up or operate un-reliably; the factory-supplied lubricant became very viscous and caused the speed controls to work slowly. We also had trouble with the latching solenoids sometimes not shuttling from one state to the other. Much of our testing will be done in Hawaii where the temperature is cold while the air is dry. Our testing problems were made worse because we had to keep the instrument full of dry nitrogen during the cold testing to prevent condensation. This required oxygen masks and made testing impossible. We have cleaned all of the air cylinders with the solvent (petroleum distillate) and purged all air lines with dry gas. During shipment all air ports have been sealed to prevent moisture from entering.

There were a variety of linear and rotary bearing requirements in the slit area, and we chose a different manufacturer for each, based on previous experience. For linear bearings and ball screws, THK products were used exclusively. SKF bearings with integral seals are used throughout.

For small mechanical components such as clutches, timing gears and belts, and worm gears, Berg products were used. All worm gearing meshes are lubricated with Nyogel 788 from W. F. Nye Co.

10.3 Slit Area Stages:

The HIRES Phase C Proposal (UCO/Lick Observatory Technical Report No. 57, January 1991, Vogt) briefly listed the remote control functions to be provided in the slit area. All of these were completed in addition to several others. The following sections will give a general description of the design and operation of each stage, as well as a short list of appropriate adjustments for each. The stages are discussed as follows:

1. Slit
2. Slit Accessory Server (Decker)
3. Instrument Filterwheels
4. Shutter
5. TV guider
 - a. CCD camera and cooler
 - b. Lens Drives (Focus and Aperture Control)

- c. Filterwheels
- 6. Comparison Source System
 - a. Light Source Motion Stage
 - b. Thermal Enclosure and cooler
 - c. Filterwheel
 - d. Projection Optics
- 7. Iodine Cell System (Stage)

Chapter 11

THE SLIT

11.1 General Description:

The slit controls the vertical dimension of the aperture to the spectrograph by opening or closing a bilateral pair (both jaws move about their centerline) of reflective jaws. The slit jaws are opened by a ball-screw driven wedge which separates the flex-pivot mounted slit plates (see H1324). The slit jaws are roughly 2" x 4", made of 420 stainless steel, and polished flat to about 5 waves. Return springs force the slit jaws closed as the wedge is withdrawn. The shaft encoder attached to the motor provides for a theoretical resolution of about 0.5 microns at the slit jaws. An optical interrupter provides the fiducial location, and travel is protected by software and mechanical limit switches (see dig H1326). The slit is mounted at an angle (7.5° nominal) to reflect most of the field back to a TV camera for autoguiding.

11.2 Adjustments:

The slit has individual adjustments for tip, tilt, rotation, and piston on one jaw, while the other jaw remains fixed. The adjustments are made by tightening or loosening the screws supporting the jaw (see dig H1322). The jaws are readily adjusted within 10 arc-sec using an autocollimator and a reference flat for parallelism. The minimum slit opening can be adjusted using the travel limit screws, which can be reached through the access holes, found near the return springs (see dig H1324). The travel limit switches may be adjusted by loosening the mounting screws and sliding the switches in the slots.

The slit assembly as a whole can be adjusted for up/down, left/right, focus, and tilt, using the slotted mounting screws attaching the slit to its support (see dig H6760). In addition the adjustments on the stage, the slit and filterwheel supporting beam can be adjusted for left/right, up/down, and focus, using its slotted mounting screws (see dig H6758).

Chapter 12

THE SLIT ACCESSORY SERVER (Decker)

12.1 General Description:

The Slit Accessory Server (SAS) can provide both vertical and horizontal control over the aperture into the spectrograph. The SAS can be used in conjunction with the slit, or it can be used alone to define the aperture. The SAS carriage has positions for four, 4" square aperture trays, and sufficient travel to see all of the trays, plus a stowed position giving a full unvignetted view of the slit (see Drawing H1359). The aperture plates are EDM machined, and are optically polished flat to a few waves (see Drawings H1384, H1389, H1390 and H1391). The carriage is attached to a timing belt driven by a motor and gearbox. An optical interrupter provides the fiducial location, and travel is protected by software and mechanical limit switches (see Drawing H1378). The shaft encoder attached to the motor provides a theoretical resolution of about 0.8 microns at the aperture plate (see Drawing H1387). Like the slit, the SAS is mounted at a 7.5° angle, in order to reflect most of the field back to a TV camera for autoguiding.

12.2 Adjustments:

No adjustments are provided for the SAS carriage itself. All alignment of the SAS is controlled by adjustment of the upper and lower stage mounts. By translating the upper and lower mounts, left/right, up/down, rotation, and focus can be accomplished (see Drawings H6759 and H6760). The travel limit switches can be adjusted by loosening the mounting screws and sliding the switches in the slots. The belt tension for the carriage can be adjusted by loosening or tightening the idler pulley adjusting screw. An autocollimator mounted in the front of the slit area is used to align the SAS with the slit on the optical axis, and to adjust the reflected beam to the TV camera. The TV camera, once operational, can be used to verify that the Slit and SAS are both properly aimed.

Chapter 13

FILTERWHEELS

13.1 General Description:

Two 12 position filterwheels provide a wide range of filter options for the spectrograph. Each filterwheel has 12 numbered locations for mounting a HIRES-standard filter holder, which can accommodate a 2" round or 2" square filter, up to 3/8" thick. The number 1 position has an extended opening which allows a 1" x 4" light beam to pass thru unfiltered if desired (see dig H1104). The wheels themselves are interchangeable, so that an observer can have a "personal" set of filters optimized for a given task (see dig H1115). A worm gear drive rotates the filterwheels and precludes the need for a brake to hold position with power off. An optical interrupter provides the fiducial location. A shaft encoder mounted to the motor provides a theoretical resolution of 10.8 arc-seconds (see dig H1114).

13.2 Adjustments:

The worm gear mesh can be adjusted by pivoting the worm gear carrier (see dig H1110) around its mounting shoulder screw. No other adjustments are provided on the filter stage.

The filterwheel assemblies can be aligned left/right, up/down, and focused by adjusting the slit and filterwheel support beam (see Drawings H6758 and H6760). Note that this will also affect the alignment of the slit. The filters are generally oversized for a given aperture, and typically should not require adjustment after initial collimation.

Chapter 14

SHUTTER

14.1 General Description:

A Melles Griot / Ilex (p/n 04 IES 005) 2.5" aperture shutter controls the exposure time for the spectrograph. The shutter is mounted to the back of the second instrument filterwheel, and defines the rear light boundary of the slit area (see dig H1203). The shutter is controlled by the CCD detector controller mounted above the dewar. The shutter was modified at the Lick Instrument Lab to use a reed switch rather than the stock limit switch, in order to improve reliability.

14.2 Adjustments:

The shutter is hard-mounted to the filterwheel via a threaded ring and has no adjustments. With the shutter removed there is a 3.2" diameter clearance hole.

Chapter 15

TV AUTOGUIDER

15.1 General Description:

The TV guider stage is composed of a high quality commercial CCD camera system, a commercial camera lens, and two filterwheels, all mounted together in a compact package. There are two motorized drives for the lens, one for focus and the another for aperture adjustment. Between the CCD camera head and the lens are a pair of 8 position filterwheels for color and brightness control. Due to the variety of features and adjustments to be covered, the CCD camera and the motor driven functions will be discussed individually in the following order: CCD camera system, lens drives, and filterwheels. Finally, the entire stage and its adjustment as a unit will be described.

15.2 CCD Camera System Description:

The TV guider uses a Photometrics 200 series CCD camera system for direct and offset guiding from the slit and/or decker. This system includes a CH250 liquid cooled camera head with a Thomson TH7883 frame transfer CCD, a CE200 camera electronics unit individually tuned for the CCD, a special order 10' cable from the camera head to the electronics box and a LC200 liquid recirculator for cooling the CCD. The camera electronics unit and the liquid recirculator are mounted in a thermal enclosure mounted inside of HIRES but outside of the slit area (see Drawing H1401). The TV thermal enclosure is in turn cooled by the instrument cooling system (see Cooling System Drawing H1406). The last item required in the TV system is the CC200, a controller unit which is provided by the telescope.

15.3 CCD Camera Adjustments:

The only mechanical adjustments for the camera head are by way of the slotted mounting screws which allow some travel in the up/down and focus directions (see Drawing H8105).

15.4 Lens Focus Drive Description:

The TV guider system uses a Canon 200mm focal length, f/1.8 lens to image the slit onto the camera detector. The plate scale at the slit is 1.379 arc-sec/mm, and 0.26 arc-sec/mm at the TV CCD. The Thomson CCD has a $23\mu\text{m}$ pixel size, giving a detector scale of 0.156 arc-sec/pixel (see Drawing P1003).

The lens focus is driven by a timing belt gear reduction attached to a 60:1 worm gear speed reducer, which is in turn driven by the standard DC servo motor. An optical interrupter provides the fiducial location, and travel is protected by software and hardware limit switches, as well as by a clutch between the worm gearbox and the lens gear. A large split clamp attached to the focus ring of the lens carries the drive gear, limit switch triggers and the optical interrupter blade (see Drawings H8105 and H8119).

15.5 Lens Focus Drive Adjustments:

There are several adjustments for the focus drive which will be discussed in the following order: fiducial, limits, belt tension and clutch.

1) Fiducial:

The blade attached to the clamp ring is adjusted by loosening the clamp ring and rotating the blade until its edge is in the center of the optical switch at the middle of the lens focus travel. This will place the lens focus at its nominal position on power-up.

2) Limits:

The limit switch mounts have oversized holes for attaching the switches, as well as slotted holes for attaching to the mounting plate. By loosening all the mounting screws for the switch, it can be translated and rotated as required to trip sometime before the mechanical stop in the lens is reached. The software limit switch should be adjusted to trip before the mechanical limit switch cuts power to the motor.

3) Belt Tension:

The belt tension is adjusted by loosening the screws which mount the motor and gearbox assembly to the baseplate.

4) Clutch:

The clutch is adjusted by loosening the locknut on the clutch and tightening or loosening the adjusting nut as required. The intent of the clutch is to prevent the motor from overdriving the lens in the case of both limit switches failing.

15.6 Lens Aperture Drive Description:

The Canon lens aperture setting is driven by a bell-crank linkage attached to a 60:1 worm gear speed reducer, and powered by a DC servo motor. An optical interrupter defines the fiducial location. Because the bell-crank rotates freely without any mechanical stop no limit switches are required. One half revolution of the bell crank drives the aperture ring through its full range of travel. A split clamp attached to the aperture ring carries the bell crank link and the fiducial blade (see Drawings H8105 and H8119).

15.7 Lens Aperture Adjustments:

The stroke of the drive wheel is fixed by the radius to the link end. The stroke at the aperture ring can be adjusted by moving the motor-gearbox assembly on its slotted mounting screws, and by varying the position split clamp on the aperture ring.

15.8 TV Filterwheel Description:

Two 8 position filterwheels provide a variety of filter options for the TV guider camera. Each filterwheel has 8 locations for mounting a HIRES-standard filter holder, which can accommodate 2" diameter or 2"x 2" square filters up to 3/8" thick (see Drawing H8326). The wheels themselves are readily removed and are interchangeable, so that an observer can have a "personal" set of guiding filters optimized for a given task (see Drawing H8325). A worm gear drive, identical to the instrument filterwheel drive, rotates the filterwheels. An optical interrupter indicates the fiducial position and the motor encoder provides a theoretical resolution of 10.8 arc-sec. The filterwheels are removed by withdrawing the center mounting pin, rotating the filterwheel assembly out of the guider assembly, depressing the button in the wheel hub, and pulling off the wheel.

15.9 TV Filterwheel Adjustments:

The worm gear mesh can be adjusted by pivoting the worm gear carrier (see Drawing H1110) around its mounting shoulder screw. The filterwheel assemblies can be adjusted left/right using the slotted mounting blocks.

15.10 TV Autoguider Stage Description:

The camera head, lens, and filterwheels are mounted together on the Autoguider stage (see Drawing H8001). The upper and lower pin mounts for the stage provide support and allow the stage to be manually rotated up into a stowed position (see Drawing H8002). By removing all four pins, and disconnecting the electrical and cooling connections, the stage may be removed from the slit area as a unit.

15.11 TV Guider Stage Adjustments:

The four main components of the TV guider; the camera head, lens and filterwheels; may be adjusted relative to each other using the slotted mountings for each part. The camera head mount has slots for adjusting up/down, left/right, and focus. In order to collimate the stage with the reflected slit optical axis, its mounts can be translated to provide left/right, up/down, focus and rotation of the stage.

Chapter 16

COMPARISON SOURCE SYSTEM

16.1 General Description:

The Comparison Source System provides a variety of light sources for calibration of the spectrograph. The initial complement of light sources includes two Thorium-Argon hollow cathode lamps, a diode laser, a 3450°K color temperature quartz lamp and a Deuterium lamp. The latter two lamps are mounted in two 8" Labsphere integrating spheres. Wiring is installed to support up to eight sources (low voltage and current). The motion stage is mounted in a cooled thermal enclosure to prevent thermally induced turbulence above the slit area. The four main parts of the system are the light source motion stage, the thermal enclosure and cooler, the filterwheel and the projection optics.

16.2 Motion Stage Description:

The light source motion stage carries and positions the various lamps which are used for aligning or calibrating the spectrograph (see Drawing H1620). The carriage nominally has 6 positions, each providing 6 square inches for mounting a source. The moving stage is a 8" x 36" long platform with a mounting hole pattern for mounting any number and size of sources as required (see Drawing H1618). The stage has 34" of travel, which is more than sufficient to bring any of the mounting locations on to the optical axis of the slit area. The carriage is driven by the same arrangement designed for the decker, using a timing belt to position the stage, and servo motor and worm gear speed reducer to drive the belt. A pair of negator springs preload the stage to eliminate backlash. An optical interrupter defines the fiducial location and software and mechanical limit switches protect the range of travel. The theoretical resolution of the stage is the same as the decker, about 0.8 microns at the stage. The actual resolution has been measured mechanically to be better than 0.0005". Drawing H1622 gives encoder resolution.

16.3 Motion Stage Adjustments:

The main adjustment for the motion stage is the drive belt tension, which is accomplished by loosening or tightening the idler pulley screw. The limit switches can be adjusted by loosening the screws and sliding the switches in the mounting slots, but will require that the stage be removed from the enclosure. The entire assembly has four pin joint supports for left/right, up/down, focus, and rotation adjustments. By translating the mounting points in their slots, the full range of adjustments can be made. For collimation and alignment, the mounts are designed to be adjusted while the stage is installed in its housing (see Drawing H1688).

16.4 Thermal Enclosure Description:

The comparison sources operate inside of a sealed enclosure in order to avoid thermal convection currents which could disrupt the seeing in the slit area. The enclosure construction consists of a sandwich of extruded fiberglass ribs, polyethylene foam insulation, and aluminum or CPVC skins. The CPVC skins are used internally in locations where the aluminum would create a thermal short to the main instrument enclosure (see dig H1680). The panels and ribs are epoxied and riveted together to form a light, rigid unit. The top and end panels are latched and/or hinged to allow for removal when servicing the calibration lamps. A small heat exchanger and two muffin fans are installed in the top of the enclosure directly above the optical axis. Coolant flows continuously through the system, while a sensor cycles the fans as required to maintain the temperature at the same level as the main housing.

16.5 Thermal Enclosure Adjustments:

Once the motion stage has been aligned, the housing can be realigned with the stage to avoid any interference. Care should be taken to insure that the lamps will always have clearance throughout their travel. This is especially important for the hollow cathodes, which move in a trough on the inside of the housing. Four slotted stainless steel supports carry the weight of the housing and locate it relative to the motion stage. The housing may be moved by loosening the mounting screws and sliding the unit to the desired position. The weight of the

housing must be supported while the mounts are being adjusted. The latches for the top and end covers can be adjusted for tightness by turning the threaded catch in or out as required. The hinges are made of delrin and cannot be adjusted. The lamps can be replaced by either removing an end or top panel for access. Poron foam is used as a gasket material to seal the panels. (Boyd Corp., Ceres, CA)

16.6 Filterwheel Description:

The comparison source system is equipped with a filterwheel for controlling source bandpass or brightness. The filterwheel and drive assembly are virtually identical to the main instrument filterwheels, except for their mountings (see "Filterwheels" and Drawings H1701 & H1706).

16.7 Filterwheel Adjustments:

The filterwheel locates a filter between the doublet and the aperture stop of the comparison source optical system. Adjustments are provided to insure adequate clearance between the filters and the optics (see Drawing H1706). Slots in the filterwheel mounts allow for up/down, left/right, and focus adjustments.

16.8 Comparison Source Optics Description:

The design of the comparison source optics attempts to mimic the exit pupil of the telescope, in order to more accurately calibrate the spectrograph. The optical system consists of a 2" doublet, a filter, a fixed aperture stop, a 6" triplet, and a 6" folding flat (see Drawings H1655 and H1692). The comparison source apertures tend to be small compared to the slit width, so the projection optics also provide a 2:1 magnification at the slit. If the entire 4" width of the slit requires illumination, the source can be scanned across the slit using the motion stage. The folding flat reflects the comparison source beam into the spectrograph and stows to one side when not in use. A pupil plate is located between the 2" doublet and the 6" triplet in order to create a circular image with a central obstruction which simulates the telescope and the secondary mirror baffle.

16.9 Comparison Source Optics Adjustments:

There are three main assemblies for the comparison source optics, including the 2" doublet, the 6" triplet, and the 6" flat. The doublet and the triplet both have slotted mounts and tilt adjustments to accommodate up/down, left/right, focus, and rotation (see Drawings H1812 and H1816). The 6" folding flat is mounted in a commercial mirror mount made by Janos (model no. 2017-0003). The mount has two rotational adjustments and a slotted support for focus. Left and right adjustment is controlled by hard stops on the air powered stage that moves the flat in and out of the optical path. Vertical adjustment is accomplished by raising or lowering the folding flat stage (see Drawing H1814).

Chapter 17

IODINE CELL STAGE

17.1 General Description:

The iodine cell stage is an air-powered translation stage mounted to the slit accessory server. The iodine cell can be used to impress a field of iodine spectra on top of an object of interest. The iodine cell stage consists of the iodine cell, a mount to attach the cell to a linear bearing, and an air cylinder to extend or retract the cell in and out of the optical path (see Drawing H1955). Electrical connections to the cell include a 120VAC strip heater, two temperature sensors and limit switches to report the location of the stage to the instrument computer. Travel of the stage is limited by hard stops attached to the linear bearing support. Limit switches attached to the air cylinder indicate the position of the stage. The cell is mounted on a simple platform which could be used to support other accessories if required in the future.

Note that the iodine cell is designed to operate at 122° F, approximately 90° F warmer than the surroundings. No provisions other than insulation have been made to prevent thermal gradients and air motion in the slit area due to heat dissipation by the cell. It remains to be seen if this will be a problem.

17.2 Adjustments:

The stage mounting platform has mounting slots for adjusting focus of the cell. Travel of the stage can be adjusted by moving the stops in their mounting slots. No other adjustments are provided because the stage is designed to be coaxial with the slit accessory server. If the SAS is properly collimated, the iodine cell should be as well.

Chapter 18

SLIT AREA COLLIMATION

The purpose of this section is to describe the order and procedure of collimating the slit area stages. Detailed notes about the collimation procedure can be found throughout Vogt's test/integration lab notes. The procedure begins after the establishment of the instrument optical axis, using alignment telescopes located in the front of the slit area and behind the 17" collimating mirror stage. Once this axis has been set, the stages can be collimated successively in the order listed here.

1) Slit and Filterwheels:

The slit and instrument filterwheels are mounted together on a beam attached to the slit area structure (see Drawings H6758 and H6760). The slit and filterwheels should be adjusted to be at the same height and left/right location relative to each other on the supporting beam. The whole assembly can then be adjusted on to the optical axis by sliding the support beam in the mounting bracket slots. Finally, the slit should be individually collimated for tip, tilt and rotation, taking care not to translate the slit off of the optical axis.

2) Slit Accessory Server (Decker):

The decker should be adjusted to place the back side of the decker plates as close as possible to the slit jaws (about 0.060") to minimize reflection pathlength differences for offset guiding. The decker is supported by upper and lower mounts which provide for up/down, left/right, and two rotations (see Drawings H6758, H6759 and H6760). The decker housing has a cut-out to accommodate the slit housing, and the cut-out should be adjusted to center over the slit. Once the slit and decker have been collimated, their alignment relative to each other should be verified by viewing the slit and decker with the guide camera.

3) Guider TV and filterwheels:

The four main components of the guider system are the lens, the two filterwheels, and the CCD camera head. The lens is attached to the main platform (see Drawing H8105), and the lens height relative to the platform is fixed. Consequently, the lens should be collimated first, by adjusting the four mountings for the platform. Once the lens is collimated, the CCD camera head can be adjusted in its mounting slots to be coaxial with the lens. The filterwheels are

not adjustable individually, but are fixed on the platform at the same elevation as the lens, so that if the lens is collimated, the filterwheels should be as well.

4) Comparison Source System:

The comparison source system consists of a motion stage, a thermal enclosure, a filterwheel, and an optical projection system which doubles the size of image of the source at the slit. All parts of the system have a range of adjustments which will allow the various parts to be collimated relative to each other, as well as to the spectrograph. However, the enclosure is probably the limiting component in terms of travel adjustment and distance from the slit, so it will be most practical to establish the optical axis based on the window in the enclosure. Once the optical axis is set, the stage, lens groups and filterwheel should be aligned in that order.

5) Comparison Source Housing:

The comparison source stage is mounted in an insulated enclosure to prevent thermal air disturbances in the slit area. The enclosure has adjustments to allow it to be moved relative to the stage during collimation. The housing mounting brackets have slots for fore/aft and up/down adjustment (see Drawing H1688).

6) Comparison Source Stage:

The comparison source stage is mounted on a steel weldment attached to the slit area frame (see Drawings H1688 and H1692). The four degrees of freedom to be adjusted are focus and the three rotations (tip and tilt relative to the optical axis, and rotation around the direction of travel.) The left/right alignment is controlled by motion of the stage, and the height of the sources is adjusted at the individual source on the stage. All of the stage adjustments are accomplished by sliding mounting brackets in their slots, which are found in the following locations:

1. slots in the individual source mountings on the stage;
2. up/down slots in the pivot brackets attached to the bottom of the stage;
3. fore/aft slots and set-screws in the brackets attaching the stage to the support weldment;
4. fore/aft slots in the support weldment flanges where they attach to the slit area structure;

7) Comparison Source Optics

The comparison source stage (CSS) optical system has a 6" diameter folding flat, a 6" triplet, a 2" aperture stop and a 2" doublet. The optical system is

defined to be in the plane of the instrument optical path and plumb to the slit area. This plane is established by hanging a plumb bob through the slit area such that the plumb line is visible at the slit and at the window into the comparison source stage housing. Using the plumb line for a vertical reference, and alignment telescopes for the instrument optical axis, the CSS folding flat, triplet, and doublet can be collimated in that order.

1. Folding Flat: The flat height adjustment is by way of the slots in the supporting beam brackets. The slots can also be used to adjust the angle of beam tilt (see Drawing H1814).
2. Triplet: The triplet has adjustments for focus, left/right, up/down, and two rotations. The adjustments are either by screws in slots or by set-screw (see Drawing H1816).
3. Doublet: The doublet has adjustments for focus, left/right, up/down, and two rotations. The adjustments are either by screws in slots or by set-screw (see Drawing H1812).

8) Comparison Source Filterwheel:

The comparison source system has a 12 position filterwheel which places a filter between the aperture stop and the doublet in the projection optics. The filterwheel and mounting brackets have slotted adjustments for focus, up/down, and left/right (see Drawing H1706). Additional adjustments are by slots in the filterwheel support beam and mounting brackets.

9) Iodine Cell Stage:

The iodine cell is mounted on an air-driven linear bearing which allows the cell to be quickly inserted or removed from the optical path. The iodine cell is essentially a pair of windows with iodine gas between them, with limited adjustments for collimation. The height of the cell is fixed by attachment of the stage to the decker housing. The left/right position of the stage is set by adjusting the travel limit brackets on the stage. The primary collimating adjustment is focus, being the distance from the cell to the decker, and is set by sliding the cell support in its slots (see Drawing H1955). The tip and tilt of the cell relative to the optical axis can be changed by adjusting and shimming the cell in the supporting cradle.

Chapter 19

INSTRUMENT COOLING SYSTEM

19.1 General Description:

A liquid cooling system is provided to reduce the buildup of heat in the spectrograph, and avoid the resulting thermally induced air motion which could degrade seeing in the instrument. Coolant at about 3°C below the ambient air temperature is provided by “the telescope system” at a nominal flow rate of 2.6 gallon per minute (gpm) and 80 psi. The HIRES cooling system is designed to remove all the heat generated in the instrument with the 1500 W of cooling provided. A control panel for the cooling system is located near the large door into HIRES and houses a flow meter and flow control valve, as well as gauges for the inlet and outlet pressures.

The design of the cooling system faced a number of challenges. First, the cooling provided by the telescope was provided over a very narrow temperature difference (5°C), and a relatively low flow rate, both of which made heat removal more difficult. The main variables to balance for an exchanger are the size and the flow rates of the coolant and the air. In most cases in HIRES, the heat exchangers were limited in size by packaging constraints. With the ΔT of the coolant, the exchanger size, and the flow rate all fixed, the main choices left were the coolers themselves and the air flow rates. A second consideration was the cooling circuit through the instrument, and whether to make it a serial or parallel system. Finally, the type and design of the coolers was considered to maximize the efficiency of the system. There are four sources of heat, in decreasing heat load; the electronics vault (600 W), the CCD TV electronics and liquid recirculator (130 W), the CCD controller (100 W) and the Comparison source stage (50 W). This adds up to 880 Watts. The CCD controller chassis is mounted close to the CCD dewar and pre-amp. This thermally insulated box has a cooler mounted inside. See Drawings H1462 and H1463 for details.

The final design of the HIRES cooling system uses a serial fluid circuit and Hayden and LYTRON all-aluminum heat exchangers. The coolant flows first through the comparison source enclosure, which has the smallest heat load (50 W) and the tightest packaging constraints. Because of the size limit in

this case, a small Hayden (Thinline TU10416G5-14JE2) cooler is used with a custom plenum and two 12VDC muffin fans (see Drawing H1423). This choice allows the smallest cooler to see the greatest initial temperature difference (ITD) between the inlet coolant and the ambient air in the enclosure, for maximum heat removal. The HIRES instrument computer reads two temperature sensors in the enclosure and cycles the fans to maintain the temperature at the ambient level. The coolant then flows to the CCD TV enclosure (130 W), where it passes through a LYTRON (5221G10) cooler with integral fans (see Drawing H1406). This exchanger was chosen to fit the space constraints and to simplify the mounting of the cooler, shrouding and fans. The temperature is controlled in the same manner as in the Comparison source box. The HIRES electronics enclosure (600 W) has plenty of room for large exchangers and consequently is the last area cooled. In this case, two large LYTRON coolers (5321G10), with two 9" fans each, operate with the smallest ITD (see Drawing H1411). The long coolant path and the high air flow rates allow the exchangers to remove the heat given the worst ITD and the highest heat load in the system. The electronic enclosure must be maintained at 5°C, rather than ambient, but the computer again uses sensors to monitor the temperature and cycles the fans as required.

The design objectives for the rest of the cooling system were to minimize danger to the instrument from coolant leaks and other failures, to simplify assembly and maintenance, and to standardize on plumbing fittings.

Most of the coolant runs are through insulated copper tubing attached to the outside of the instrument housing, which provides several benefits (see Drawing H1450). First, in the event of a leak, the coolant is more likely to run down the sides of the HIRES enclosure rather than onto optical surfaces or electronics. Second, the coolant lines are more easily accessible for removal and reinstallation. Finally, long straight runs of copper tubing are the most economical way to move the coolant over the distances between the various thermal enclosures. In locations where flexibility or disconnection are required, Goodyear "Gorilla" 3/4" ID hose is used. This hose is inert to a variety of solvents, resistant to ozone and remains flexible at low temperatures.

For shipment and re-assembly, there are several logical places to provide quick disconnects in the plumbing circuit. The most obvious break is at the instrument and electronics enclosures where hoses and Parker 60 Series quick disconnects attach to a feedthru to the heat exchangers. Quick disconnects

are also found at the comparison source, CCD controller box, and CCD TV enclosures to simplify assembly and removal.

Unfortunately, a wide variety of brass and stainless steel plumbing fittings were required to join the various parts of the cooling system. For brass parts, pipe thread and SAE 45° flare fittings were used whenever possible, with a bias towards the SAE standard. The LYTRON heat exchangers, fabricated with 37° flare ends, were the only exception. Stainless steel tubing and Swagelok fittings were used inside the electronics enclosure because the heat exchangers are hard-mounted to the roof of the housing. The control panel is plumbed with brass fittings and bronze pipe, along with the flow valve, meter and pressure gauges (see Drawing H1432).

Chapter 20

DESIGN OF THE CAMERA MIRROR SUPPORT

The design, analysis and testing of a large mirror mount are described. The optic is a 44" diameter, $f/0.75$ gas-fusion structured mirror manufactured by Hextek (Tucson, AZ). The mirror is the primary reflector for a split-corrector camera system for the Keck Telescope High Resolution Echelle Spectrograph (HIRES). The spectrograph is mounted on the Nasmyth platform of the telescope, with the camera mirror optical axis downward-looking 10.3° below horizontal. This paper describes the finite element analysis of the mirror, conceptual and detail design of the mount, and interferometric testing of the mirror figure before and after installation in the support. This design chapter was extracted from Reference 3 by Bigelow.

20.1 Conceptual Design of the Support:

The Hextek mirror, at 44 inches in diameter, is the largest of its type ever fabricated. The construction of the mirror is a two step process. First, the front and rear face sheets, 0.47" thick Schott Tempax, are fusion bonded to a center section of Tempax tubes. The sandwich of face sheets and tubes is heated to molten temperature, the tubes are inflated at low pressure through holes in the rear face. The face sheets and tubes fuse together. The second step involves reheating the blank as it sits on a convex mold. When the glass softens, it slumps to conform to the shape of the mold.

A variety of design considerations were evaluated for supporting the mirror. The support system was simplified by the fact the mirror would be stationary, and so would always have the same orientation to gravity. The positioning requirements for the mirror were stringent, but once met, would not require repositioning or focusing. The mirror would actually be one of two mirrors, each with a coating optimized for red or blue wavelengths, so the support would need to be as light-weight as possible and readily interchanged. The end result of the two diffraction grating dispersions is that the beam through the camera system is roughly rectangular. Consequently, only about 60% of the clear aperture of the

mirror, centered with the long axis vertical with respect to the mirror, must meet the optical specifications. The thermal environment for the mirror would be cold but stable on the order of 4° F per day, with a median temperature of about 32° F. The small daily temperature variation was especially favorable considering the 2 to 3 hour time constant for the 25% weight density mirror. On Hextek's recommendation, it was decided to exercise the internal mounting boss option (for \$7000), which provided six 3-inch-square mounting bosses in the plane of the center of gravity, located symmetrically around the mirror at the 0.7 R locations. Hextek had previous experience providing both radial and axial support of smaller mirrors through similar mounting bosses, using a six-link kinematic connection to a sub-cell. The mirror was to be re-coated with its mounting boss hardware intact, which required vacuum rated materials and components. Extensive mirror mounting research and development work conducted by others for the 36 Keck primary mirror segments was reviewed for possible adaptation to the Hextek mirror. The Keck segment design uses 36 individual axial supports bonded to the back of the segments, a torsional link for stiffness about the normal axis, and a stainless steel diaphragm radial support bonded into a pocket in the back of the segment and passing through its center of gravity.

After much consideration and debate, it was decided to use a hybrid of the Keck and Hextek approaches, using the mid-plane mounting bosses for the axial support, a torsional link and a diaphragm bonded to the back of the mirror for the radial support. The six axial supports would be reduced to three mounting points on three whiffletree balance beams. The diaphragm would be designed such that it was very stiff in the radial (in plane) direction and very compliant in the axial direction where it would be in conflict with the axial supports.

Several concepts dictated this choice. First, for collimation and initial focus the mirror support would have to be readily adjustable. The proposed Hextek design would have required a sub-cell for kinematic support of the mirror, and a second cell for carrying and adjusting the mirror by way of the sub-cell. This duplication would be more complicated (and expensive) than a single support cell. The six-link kinematic support uses three pairs of crossed links to constrain the mirror, and these links would be long and relatively more complicated in order to reach into the submerged mounting bosses. In order to reach the sub-cell in the required locations and at the proper angles, the forces in the links would be much larger than required to simply support the mirror at the six locations. The first benefit of the hybrid support was that the kinematic support and the

axial tilt adjustability would be combined in a single cell. The radial support minimized the forces input through the mounting bosses, allowed for differential thermal expansion between the radial and axial supports, and simplified the assembly and adjustment of the cell. Separating and isolating the radial and axial supports reduced the danger that the imperfectly realized kinematic supports would excessively strain the optic.

20.2 Finite Element Analysis of the Mirror:

The objective of the analysis was to determine whether or not the proposed support system would acceptably carry the mirror while maintaining its figure to a $\lambda/2$ specification. It was clear from the outset that the radial support, attached several inches away from the CG plane, would add a bending moment into the mirror, which would be counter-acted by the axial supports. The FEA would allow the testing of a variety of connection schemes and would provide insight into the deflections and stresses as a function of the number and location of the radial support points.

Hextek provided a 2-D AutoCAD file containing the mirror's exterior geometry and interior tube structure. A $1/12^{\text{TH}}$ symmetric section of this file was translated into ANSYS, using the ANSYS/AutoCAD DXF file translator. Inside the solid modeling preprocessor of ANSYS, the "pie-slice" of tube and facesheet detail was projected onto a spherical surface of areas at the correct radius of curvature, and then spherically offset to create the rear surface of the mirror. Given the front and rear areas of the mirror and the correct tube mesh from the translator, the tube wall areas were created by connecting the corresponding front and rear surface edges. Once the $1/12$ section was complete, it was reflected three times to create an accurate half-geometry model. The mounting boss areas were added to the model after the main structure was finished. With solid model plane areas now in place for all the plate geometry of the mirror, 4 node, 3-D plate bending (no shear deformation) elements with the correct material constants and thicknesses were assigned to each area. In order to model the effects of the axial support whiffletrees, 3-D beam elements were defined to connect one pair of support points, while the third remained a simple constraint (see figure 1 in the Appendix). The beam elements were defined by the material constants to be very stiff, so that deformation of the whiffletree would be negligible compared to the displacements of the mirror. The finished model contained 1345 nodes,

2106 elements, and 7959 degrees of freedom (see figure 2 in the Appendix). The weight of the various support components was neglected in the analyses.

A total of about twenty configurations were run with ANSYS several of which were used to determine the sensitivity of the model to parameters such as the modulus of elasticity and plate element thicknesses. The final version of the model showed 0.8λ deformation across the whole front surface, and about 0.5λ across the required aperture (see figure 3 in the Appendix). This residual deformation was primarily astigmatic, and judged to be acceptable for the requirements of the camera system. The analyses also indicated that the mirror was relatively insensitive to small variations in material constants, face sheet and cell wall thicknesses, and small loads such as the weight of the torsional link. The satisfactory results from the FEA gave us the confidence to continue on the detail design of the mirror support.

20.3 Detail Design of the Mountings:

The conceptual design of the mirror support specified a kinematic arrangement of three mutually exclusive constraints for the radial, axial and torsional degrees of freedom. The detail design process was then simply a matter of approximating the idealized supports with reliable hardware that could be easily manufactured and assembled. Stainless steel blade flexures were used in situations where small translations, high stiffness and zero backlash were desired. Simple pin joints with stainless steel pins in aluminum bores were used where stiff, small angle pivots were required. Commercial (THK) spherical ball-joints were used for one-degree-of-freedom constraints. The design features of the radial, axial and torsional supports will be discussed in that order.

20.3.1 Radial Support:

Keck Observatory Technical Note 142¹¹ derives several useful formulae for designing diaphragms for radial supports. The design of the Keck segment radial support has several well considered features which were adapted for the support of the Hextek mirror. The primary requirement of the diaphragm is that it safely carry the radial loads of the mirror under static (installed), as well as dynamic (transport and installation) loadings. It was anticipated that the mirror might see loads during handling perhaps as high as 6 G's. It was also required that the diaphragm be sufficiently compliant in its axial direction that it not adversely

affect the figure of the mirror by over-constraining the six axial supports. Keck Observatory Technical Note 189¹² documents the testing of a 8" diameter, 0.010" thick stainless steel diaphragm and found the small displacement radial and axial spring rates to be 200,000 lbs/in and 894 lbs/in respectively, for a stiffness ratio of 224:1. The results of the finite element analyses had indicated that a diaphragm of the same diameter and thickness as the Keck diaphragm would provide the necessary radial stiffness and axial compliance, even though the Hextek mirror is only 1/6 the weight of a Keck segment (180 lbs vs. 1200 lbs). The in-plane bending stiffness of the diaphragm was found to be the most important consideration because excessive stiffness would overconstrain the axial supports. Testing verified that the diaphragm was compliant enough to avoid deforming the mirror through a range of axial adjustments.

There is a significant difference in the coefficient of thermal expansion for Tempax (borosilicate, 1.8 ppm/°F) and 304 stainless steel (9.6 ppm/°F). For a given temperature change, the diaphragm and its supporting ring would expand or contract 5–6 times as much as the mirror. This difference would lead to an axial strain in the mirror if it were not compensated. The Keck approach was to mount the diaphragm in a pocket at the center of gravity of the segment, with a ring of axial flex springs which would deflect to allow for the temperature induced size variations. The flex springs for the Hextek mirror were designed such that a 40°F change in temperature will create a force of 2–3 ounces at each of the six mounting points. The Keck design was modified for the camera mirror by attaching the flex springs to Pyrex blocks epoxied to the back of the Hextek mirror (see Drawing H5530). A fixture was built to test the radial support system, using a Pyrex plate to substitute for the mirror (see Drawing H5514). This set-up was used to test the mounting blocks and diaphragm assembly under varying temperatures and loads. The assembly was tested to failure in the case of the mounting blocks, two of which showed small fractures at the bond-line at about 1200 lbs, more than six times the weight of mirror. This failure was disappointing, but reassuring in several ways. First, the fractures were in the mounting blocks, which could conceivably be removed and replaced. Second, there was no apparent damage to the mirror. Finally, the failures were in no way catastrophic, and the support continued to carry the load after the fractures appeared.

20.3.2 Axial Support:

Hextek provided six bosses evenly spaced around the mirror approximately

two inches inside the back surface, which were to be used for the axial support connecting points. The bosses were 0.47" thick and roughly 3" square, with a 3/4" diameter hole bored through the center of the boss. These holes and the clearance holes in the back sheet, were bored out in the Lick Optical Lab to 1.25" and 2" respectively. Several pieces of 0.47" thick Tempax were provided by Hextek for axial support testing. The first connection design used 2 stainless steel flanges to clamp to the mounting boss. The flanges indexed loosely on the hole, to axially locate the supporting link. Unfortunately, when the two flanges were clamped together, the indexing ridge managed to jam in the hole, and neatly cleaved the test mounting boss in half during tightening. An identical clamp made of Delrin was also able to fracture the mounting boss. With these enlightening experiences fresh in mind, all components expected to contact the glass were redesigned using plastic; Delrin in the case of the axial supports, and CPVC in the case of the radial support block clamps. Additionally, the clamps were redesigned to assure that only compressive stress could be generated in the mounting boss. Drawing H5537 shows the final design of the Delrin 3-point contacting mounts. The Delrin mounting flanges accommodate variations in the thickness of the mounting bosses, and the Delrin contact points are compliant enough to provide low contact stresses and avoid introducing moment loads into the mounting boss. Drawing H5536 shows the remainder of the axial support, showing the THK spherical ball-joints, links and whiffletree balance beams. The threaded connection between the spider and the balance beam allows for collimation.

20.3.3 Torsional Support:

The torsional support is largely redundant but insures that under all conditions, the radial support is not subjected to large torque loads. The weight of the torsion link was a concern initially, but was not found to cause a problem. The weight of the torque link could be counterweighted or supported independently if necessary. Drawing H5539 shows the torque link and its connections to the supporting cell and the mirror. The Pyrex mounting block is identical to the radial support blocks. Note: as of May 1993, this support element has been eliminated. The glass block is still glued to the back of the mirror.

20.4 Mirror Testing:

The mirror was tested in two different positions in order to confirm the finite

element modeling and to insure that the figure as polished was still acceptable once installed on the mount. Zenith and 10° below horizontal tests were performed on a large vibration isolation stand which was designed for testing the Keck secondary mirror (see Drawings H5824 and H5825). After several inconclusive tests it was determined that the only good time to test the mirror was early in the morning, before small temperature variations (1°F/hr) in the test tunnel began to change the mirror's figure. The Hextek blank is believed to thermalize in 2 to 3 hours and is unstable under even small temperature changes.

20.4.1 Mirror Figure Tests

The initial tests were performed on the mirror without its supporting cell, mounted instead on a layer of foam which closely matched the back radius of curvature. All mirror figure tests were conducted in the zenith-looking position. Interferograms were taken after a 12 to 18 hour soak in the test tunnel at 67° F. The mirror was then rotated 90°, allowed to soak again and more interferograms taken. The figures found in the samples are very consistent, with amplitudes ranging from 1 to 1.5 λ , mostly astigmatic. The amplitude of the astigmatism varied slightly with rotation of the part, suggesting that the foam support might not be as neutral as we thought, but the topography of the figure was very consistent.

20.4.2 Mirror/Cell Figure Tests

After the horizontal testing was completed the mirror was installed in its supporting cell, mounted onto the camera sub-structure and tested again. The finite element analyses had indicated that the predominant aberrations induced by the cell would be astigmatism and coma, with a vertical axis of symmetry. The interferogram and fringe analysis data (WYCO WISP®) shows the predicted astigmatism and coma, with amplitudes roughly three times the expected values. It is not entirely clear how much of the amplitude discrepancy is due to testing and data analysis uncertainty or the FEA model predictions. The 1.28 λ P-V and 0.25 λ RMS values exceed the initial $\lambda/2$ P-V specification but were judged to be acceptable based on analysis of the worst slope errors. The worst-case slope error of 4.4 micro-radians was found to cause a 6.7 μm deviation at the focal plane. The optical design of the camera system (i.e. perfect optics) predicted a 12.6 μm RMS image diameter. The actual degraded image diameter can be estimated by adding the predicted image size and worst case ray deviation in quadrature, which yields

a 13.9 μ m RMS image size. This was considered to be a negligible degradation of the ideal image and consequently an acceptable figure for the camera mirror.

20.5 Conclusions:

A stationary support was designed to carry a very large and fragile gas-fusion structured mirror. Finite element analysis was successfully used to analyze deformation of the mirror under a variety of conditions and orientations. Extensive testing of the mirror confirmed the results of the analyses and although the amplitudes of the deflections were greater than expected, it was not entirely clear how much of the difference was due to the models, the final figure on the mirror, testing conditions or unexpected effects from the cell. In terms of topography, the finite element model did an exceptional job of predicting the flexural behavior of a large and complicated structured mirror. Finally, optical testing and slope error analysis confirmed the acceptability of the mirror, its figure, and the hybrid kinematic mounting.

Thanks to Mark Rodamaker of MCR Associates, Sunnyvale, California for help with the creation of the ANSYS® FEA model and to Robert Parks and Richard Whortley of Hextek Corporation, Tucson, Arizona for assistance concerning the handling, figuring and support of the mirror.

and assemble. A previous paper discussed the initial finite element analyses of the lenses, and a more complicated plan of attack for static figure correction¹⁰. The earlier work was completed without a good understanding of the required clear apertures, and consequently did not take advantage of the areas on the lenses which were outside the required aperture. In fact, the echelle and cross-dispersed beam is roughly rectangular, with the long axis rotated about 8° from vertical. The clear aperture only uses about 60% of the total aperture of the lenses. Once the beam shape was known, it was clear that the forces could be applied closer to the center of the lenses and that two force points would be sufficient. With a conceptual layout of the support and constraining points, a second round of finite element analysis was undertaken to determine the optimum locations and values for the reforming forces.

21.2 Finite Element Analyses of the Lenses:

The initial finite element analyses for the lenses were described in the previous paper. The same general input routine was used again, with an added subroutine for applying the reforming forces. The ANSYS® finite element models typically used about 1450 nodes, 1050 3-D solid elements, and 4200 degrees of freedom. More than thirty trials were completed for each lens, manually varying the force or location with each run. Given enough computing power, this process could be automated for a more complete optimization. Still, a variety of solutions showing a $\lambda/4$ P-V optical path difference (OPD) were found, and the location requiring the least force was used in each case (see ANSYS input files in the Appendix). Figure 1 shows a typical finite element model of the meniscus lens showing the defining points, symmetric boundary conditions and the locations of the reforming forces. Figures 2 and 3 show the finite element predictions for deformation of the meniscus lens before and after the application of the forces. Figures 4 and 5 show the same plots for the biconvex lens. Note that although the overall P-V deformations are more than $\lambda/4$, the clear apertures (bold lined) are $\lambda/4$ P-V. It is important to note that the reforming forces induce stresses in the fused silica lenses and consequently contribute birefringence effects to the optical path length errors. However, because the stresses never exceeded 50 psi, well below the accepted 500 psi limit for birefringence¹⁷, the OPD errors were considered negligible.

21.3 Detail Design of the Cells:

As mentioned before, a variety of considerations drove the design process for the corrector cells. The corrector lenses would ultimately be anti-reflection coated using a Sol-Gel process, developed and applied at Lawrence Livermore National Lab for the Nova Laser Program. This coating was expected to be stripped and reapplied occasionally, which required that the lenses be completely and readily separable from their cells, and precluded "potting", or elastomeric mounting. The cells would be manufactured in the Lick Observatory Instrument Labs, which required that conventional fabricating and testing processes be used. Reducing cell weight would benefit assembly and handling. Corrosion resistant materials and surface treatments would be used throughout. Detail design of the radial supports, axial supports, force application assemblies and cells will be discussed in that order.

21.3.1 Radial Supports

The justifications for the basic design of the radial supports is discussed in the previous paper. To summarize, the radial support contacts are split twice in the theta direction and twice again in the z-direction (see Detail A in Drawing H5324). The balance beams operate in both directions in order to reduce the bearing stresses in the optic. Two sets of two radial supports were selected to reduce contact stress and minimized the deformation of the lenses. Stainless steel flex pivots were designed to minimize the axial forces transferred to the optic, while allowing minor focus adjustments without lifting the lens off of the support. The flex pivots reduce (but do not eliminate) the risk of axially overconstraining the lens. The Delrin contact pads are mounted to the second flex pivot, to divide the load across the lens center of gravity, again reducing stress and avoiding local deformation of the optic. A single threaded post at the top of the cell constrains the lens in the cell during handling.

21.3.2 Axial Supports

The axial supports provide two functions in the corrector lens cells: First, the axial constraints define the location of the optical surface and provide a way to align the optical axis of the part. Second, the axial contacts provide a location for the force points to react against. So in addition to locating the lens, the axial constraints help to reform the figure. The design of the defining points and

backside constraints are identical for both lens cells. The defining surface axial contacts are composed of fine threaded stainless steel posts, with commercial swivel-feet and Delrin caps to follow and protect the surface of the lens (see Drawing H5328). The backside axial constraints are primarily “earthquake clips”, to prevent the lens from falling out of its cell during handling. The backside contacts are also threaded stainless steel shafts, with spherical Delrin tips (see Drawing H5328). In the case of the meniscus, the forces applied to correct the figure actually transfer the lower pair of axial loads to the back of the lens, causing the backside (or “uphill”) constraints to become the defining points.

21.3.3 Force Application Assemblies

The force application assemblies (force points) provide a means for applying an adjustable force on the optics. The force point consists of a stainless steel shaft, a swivel-foot/Delrin cap, a threaded brass adjusting body, a spring, and a stainless steel end cap (see Drawing H5328). The springs are standard commercial parts that were calibrated for use in the force points. Although the forces applied to the two lenses are different by a factor of two, the force points are identical except for the stiffness of the springs. The length and spring constants for the springs were selected so that both would require about 0.5” of compression to apply the desired force (11.5 lbs for the meniscus, 6.0 lbs. for the biconvex lens). The springs can be compressed from each end, either by tightening the end cap, or by tightening the brass adjusting body. The two adjustments allow for very fine tuning of the force applied and allow the force point to compensate for axial adjustments of the lens.

21.3.4 Lens Cells

The cells house the lenses and provide a base for attaching the defining and forcing hardware. The housing is composed of two stiffened face plates which are screwed to a ring weldment. This construction is relatively light weight and allows the cell to be dismantled for installing or removing the lens. The remainder of the cell includes a door for dust protection and a hoisting ring for handling. Drawings H5324 and H5349 show the complete lens and cell assemblies. For reference, the corrector lenses both weigh about 120 lbs., and the meniscus and biconvex cells weigh 130 lbs. and 110 lbs. respectively.

21.4 Lens Testing:

The preliminary optical specification for the corrector lenses was to achieve a P-V OPD of $\lambda/4$ over the specified clear apertures. This is probably the easiest value to work towards during finite element analysis as well as for figuring in the Optical Lab. However, later analysis of the optical system indicated that local slope errors were much more important than the overall P-V figure on a given surface.

21.4.1 Biconvex Lens Testing

Due to convex surfaces and long radii of curvature, it was not practical to perform interferometric testing on the biconvex lens. Instead, all testing of the biconvex lens was completed using 10" diameter test plates. Although the test plates cannot qualify the peak-to-valley specification for the full aperture, they do give an excellent representation of local slope errors. Based on test plate measurements, the biconvex lens was found to be better than $\lambda/4$ over any given 10" aperture. The following section will focus entirely on the testing of the concave surface of the meniscus lens, which was the only surface readily tested with the interferometer.

21.4.2 Meniscus Lens Testing

The meniscus lens was tested in two different positions to confirm the results of the finite element analysis and to verify that the figure as polished was still acceptable after installation and figure-correction in the cell. In each case, interferograms were taken and the Wyco WISP® program was used for fringe analysis. Zenith-pointing testing was conducted with the lens mounted on a foam-lined support which was in turn carried on a large vibration isolation structure (see Drawing H5811). Interferograms were taken for several rotations of the lens relative to the foam support. The figures were consistent at about 1.5λ P-V, mostly astigmatism, and 0.25λ RMS.

The next set of tests were run in the final, tilted orientation. The lens cell and interferometer were assembled on a Newport Research Series vibration isolation table down-looking (see Drawing H5826). The first set of tests was to establish the deformed figure without any correcting forces applied. The finite element model predicted about 2 waves of deformation across the full aperture (Figure

2). The measured figure was a little more than 4 waves P-V (Figures 9 and 11), roughly twice the expected amount.

The next set of tests involved applying the correcting forces and taking more interferograms. One of the goals at this stage was to determine if the predicted correcting forces were in fact the optimum. Tests were run at 1 lb. intervals above and below the predicted optimum of 11.5 lbs. The sign of the deformation was seen to reverse between 10.5 lbs. and 12.5 lbs., suggesting that 11.5 lbs. really was the best value. By applying the optimum 11.5 lb. force at each location, the overall figure improved from 4.34 waves to 1.47 waves, a reduction of almost 3 waves of astigmatism (See Figure 14). The 1.47λ P-V was still much worse than the 0.3λ P-V (see Figure 3) prediction from the finite element model, but nevertheless was a dramatic improvement realized by a rather simple mechanical correction. The FEA predictions and interferograms do agree on the topography of the deformed (astigmatic) shape, but the FEA model underestimates the amplitude of the deformation by almost 5 times. Finite element models are typically reliable to 10-20%, not 500%, so there is clearly a problem. Possible contributors include errors in the FEA model, the figure on the lens, errors in the location or assembly of the lens in its cell or other testing error.

The last interferogram shows the figure over the required clear aperture (Figure 17). For this area, the P-V OPD is 0.68λ and 0.10 RMS. Again, the P-V number is worse than predicted, but the RMS value is actually quite good. The fringe analysis program indicated that the worst slope error was $2.1\lambda/14.15''$ ($14.15''$ is the pupil radius) for a maximum slope of 3.7×10^{-6} radians. The slope error can then be multiplied by the focal length of the lens to determine the worst case typical ray deviation at the focal plane. In this case, the maximum deviation was $1.4\mu\text{m}$ and the RMS image diameter was $1.2\mu\text{m}$. The diffraction limited image diameter was $1.64\mu\text{m}$ suggesting that the concave surface was essentially diffraction limited. This conclusion was also indicated by the 0.66 Strehl ratio calculated by WISP (Figure 18).

21.5 Conclusions:

Two novel figure-correcting lens cells were analyzed, designed and tested. Finite element models were successfully used to predict the optimum forces and locations for applying corrections to the lenses. Although the FEA predictions seriously underestimated the amplitude of the deformations, the models closely

matched the measured topography of the figures. This result suggests that there is room for improvement in the modeling process, although it is not entirely clear whether the disagreement lies in the FEA, the design or assembly of the cell, or the testing methods. Although much work remains to be done in improving the accuracy of the figure correcting cell, the concept has been tested and proven able to remove as much as 3 waves of elastic deformation.

21.6 Lens Installation and Removal

The lenses are shown in Drawings H5384 and H5385. The removal tool is detailed in Drawing H5363. The lens carrying frames are used during the installation and removal procedures. They are shown in Drawings H5247 and H5254.

21.7 Lens Cell Covers and Doors

Drawing H5376 shows the bi-folding door for the first lens cell. This door replaced the original sliding door which did not provide an adequate seal. The door is air-operated. The air logic diagram is shown in H5375 and the air control station for both lenses and the camera mirror is shown in Drawing H5380. Drawing H5342 shows the meniscus lens cell air-operated door.

Between the two lens cells is a 6" gap. Instead of building doors for these interior cell faces, a flexible cover has been installed around the cells in this gap. It is held on using Velcro strips glued to the cells and cell mounting base structure.

21.8 Lens Lifting Slings

Bigelow⁸ describes the Sol-Gel coating procedure at Lawrence Livermore National Lab. Drawings H5266 and H5267 show the lens lifting slings assembled with the lenses.

Appendix A REFERENCES


1. H.W. Epps and S.S. Vogt, *Applied Optics*, 1993, in press.
2. J. Nelson, "TMT Technical Note 28, Thermally Compensated Ring Mirror Supports," February, 1982.
3. B. Bigelow, "UCO/Lick Observatory Technical Report No. 63, Design, Analysis and Testing of a Fixed Mount for a 1-m Gas-Fusion Mirror," August 1992.
4. B. Iraninejad, "Keck Observatory Technical Note No. 194, Surface Deformations Caused by Inserts," August, 1986.
5. B. Iraninejad, J. Lubliner, T. Mast and J. Nelson, "Keck Observatory Report No. 160, Mirror Deformations Due to Thermal Expansion of Inserts Bonded to Glass," February, 1987.
6. D.A. Landis, N.W. Madden and F.S. Goulding, "A Reliable Automatic Liquid Nitrogen Filling System," UC Berkeley, LBL, Engineering Division, May 1985.
7. J. Osborne and B. Bigelow, "UCO/Lick Observatory Technical Report No. 51, Keck Telescope High Resolution Spectrograph Thermal Models," October 1989, Revised March 1990.
8. B. Bigelow, "UCO/Lick Observatory Technical Report No. 62, Mechanical Engineering Safety Note: Lifting Slings for the HIRES Spectrograph Corrector Optics," June, 1992.
9. J. Osborne, D. Hilyard and B. Bigelow, "Lick Observatory Technical Report No. 49, Mosaic Project," June 1988, Revised January 30, 1989.
10. B.C. Bigelow, "UCO/Lick Observatory Technical Report No. 59, Finite Element Analysis of Large Lenses for the Keck Telescope High Resolution Echelle Spectrograph," June, 1991. Also Proceedings of the SPIE Conference on Analysis of Optical Structures, D. C. O'Shea Ed., pp 15, Vol. 1532-02, San Diego, 1991.
11. R. H. Weitzmann, "Keck Observatory Technical Note 142, Stress/Strain Relationship for a Diaphragm Clamped at the Inner and Outer Edges, and Subjected to Axial Displacements," May, 1985.
12. R. H. Weitzmann, "Keck Observatory Technical Note 189, Keck Telescope Radial Support Assembly Test Results," May, 1986.

13. B.C. Bigelow, "UCO/Lick Observatory Technical Report No. 65, Design, Analysis and Testing of Figure-Correcting Cells for Two 0.8-m Lenses," September, 1992.
14. T.S. Mast, J.E. Nelson, "The fabrication of Large Optical Surfaces Using a Combination of Polishing and Mirror Bending", Proceedings of the SPIE conference on Advanced Technology Optical Telescopes IV, L. D. Barr Ed., pp. 671-681, Vol 1236, Part 2, Tuscon, 1990.
15. P. Y. Bely, D. A. Salmon, P. L. Wizinowich and A. Tournaire, "Bending the CFHT Cassegrain Secondary for Optical Figure Improvement", Proceedings of the SPIE, pp. 253, Vol. 444, London, 1983.
16. L. Noethe, F. Franza, P. Giordano, R. N. Wilson, and M. Tarenghi, "Active Optics: From the Test Set up to the NTT in the Observatory", Proceedings of the SPIE Conference on Active Telescope Systems, pp. 314, Vol. 1114, Orlando, 1989.
17. P. R. Yoder, Opto-Mechanical Systems Design, Chap. 4, Marcel Dekker, Inc., New York, 1986.
18. A. DuBois, Keck Observatory PMSS, "Epoxy Bonds for Segment Inserts," November 26, 1990.
19. Ed Romana, CARA Document 142: "Statement of Work for Epoxy Bonding the Keck F/25 Secondary Mirror Attachment Inserts," October 30, 1990.
20. Vogt, et al, "UCO/Lick Observatory Technical Report No. 57, HIRES: A High Resolution Echelle Spectrometer for the Keck Ten-Meter Telescope, Phase C: HIRES Core," January 1991.
21. Vogt, S.S. "HIRES: A HIGH RESOLUTION ECHELLE SPECTROMETER FOR THE KECK TEN-METER TELESCOPE," European Southern Observatory Workshop on High Resolution Spectroscopy with the VLT, (ESO, Garching, 11-12 Feb. 1992). Also published as UCO/Lick Observatory Bulletin No. 1216.

This Publisher file is /u/jack/text/uco.64





Appendix B List of Drawings — Design

1. H0000 Family Tree, Entire
2. H0001 General Design Tree
3. H0010 General Telescope Assembly
4. H0102 Final Optical Layout
5. H0148 Super-Duper Camera Layout
6. H0200 Control Functions, Schematic
7. Un-named schematic

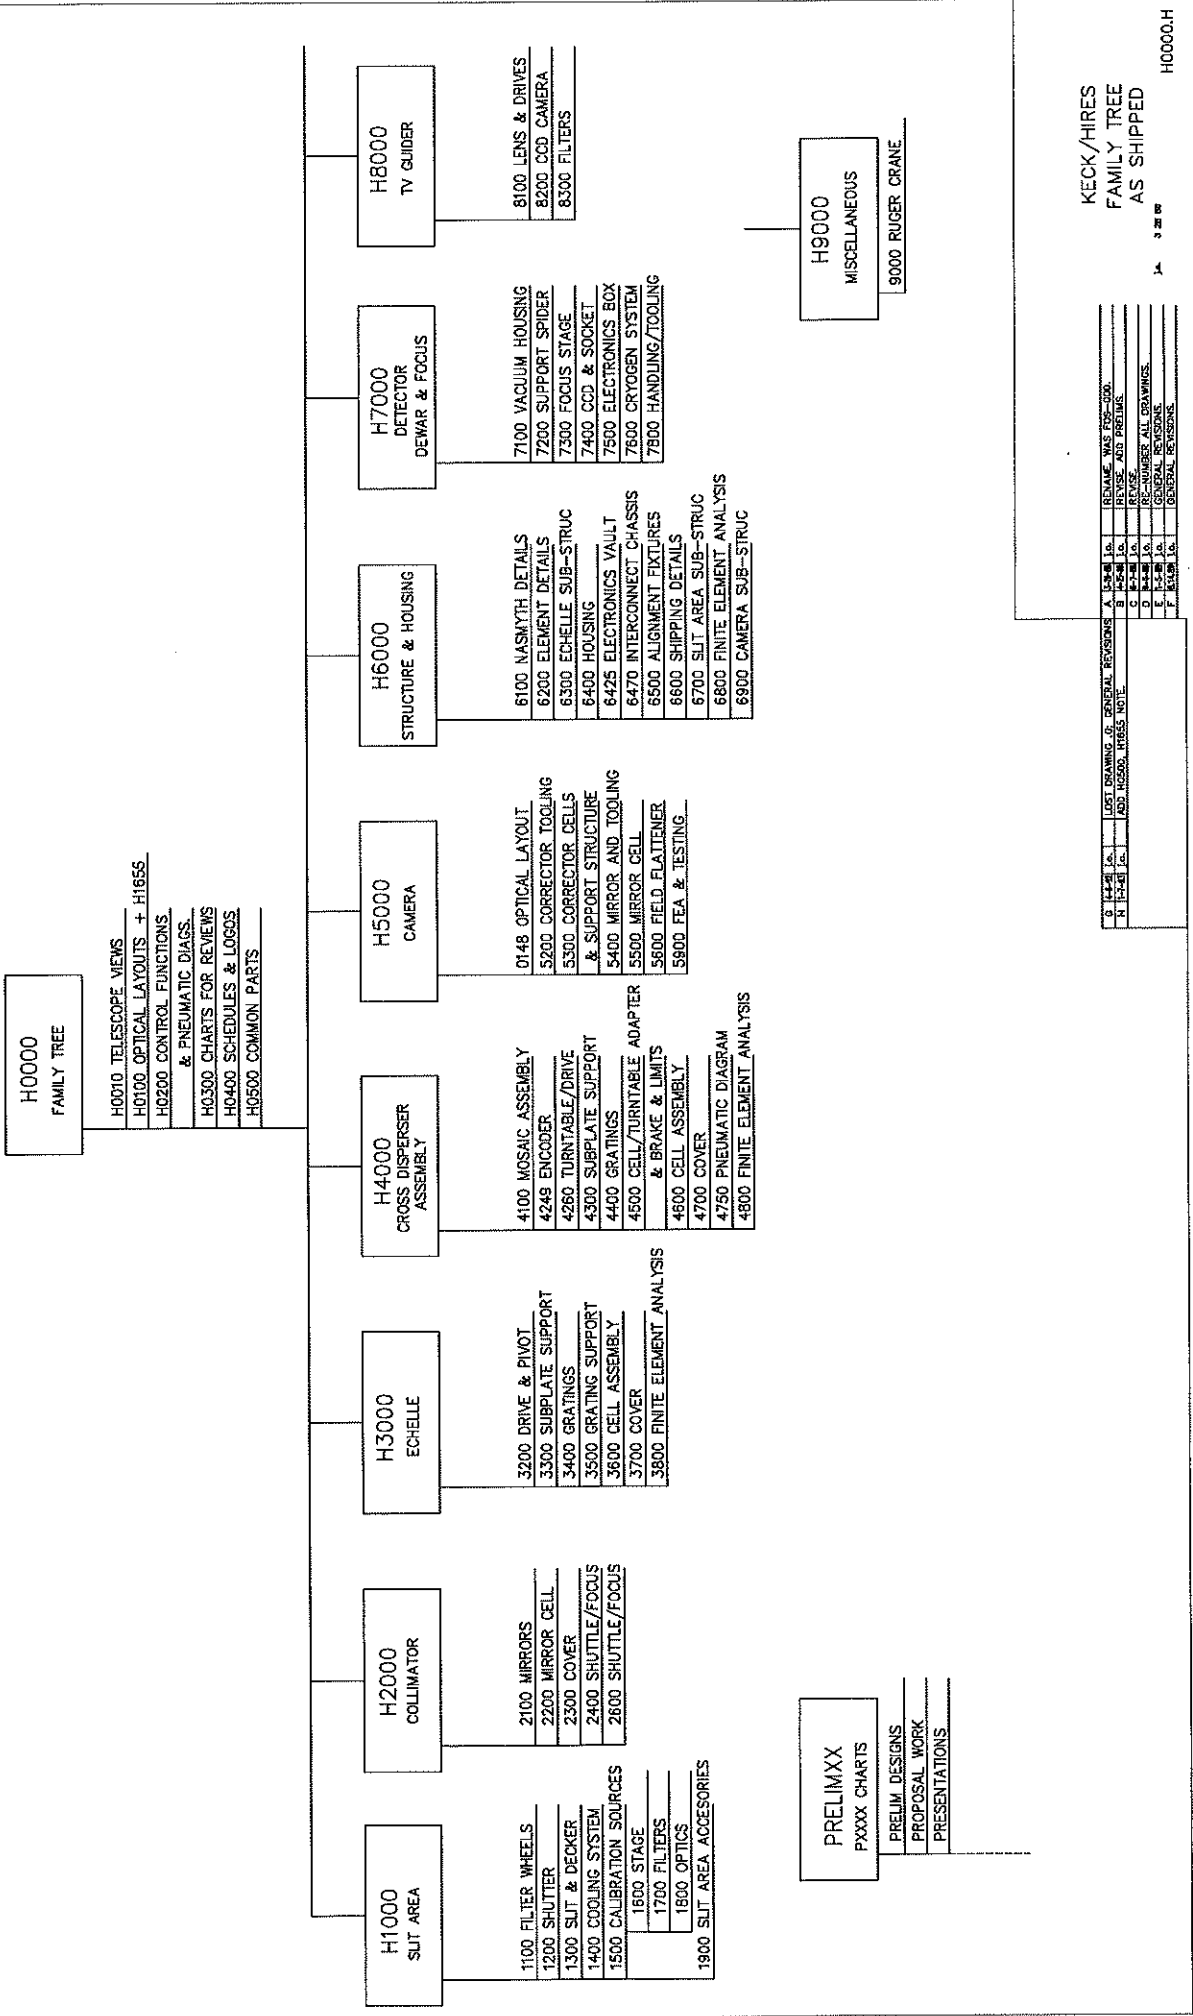

KECK/HIRES
FAMILY TREE
AS SHIPPED

H0000.H

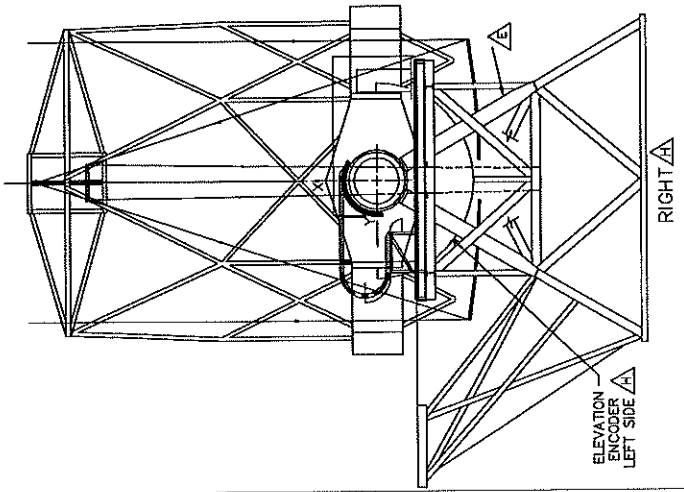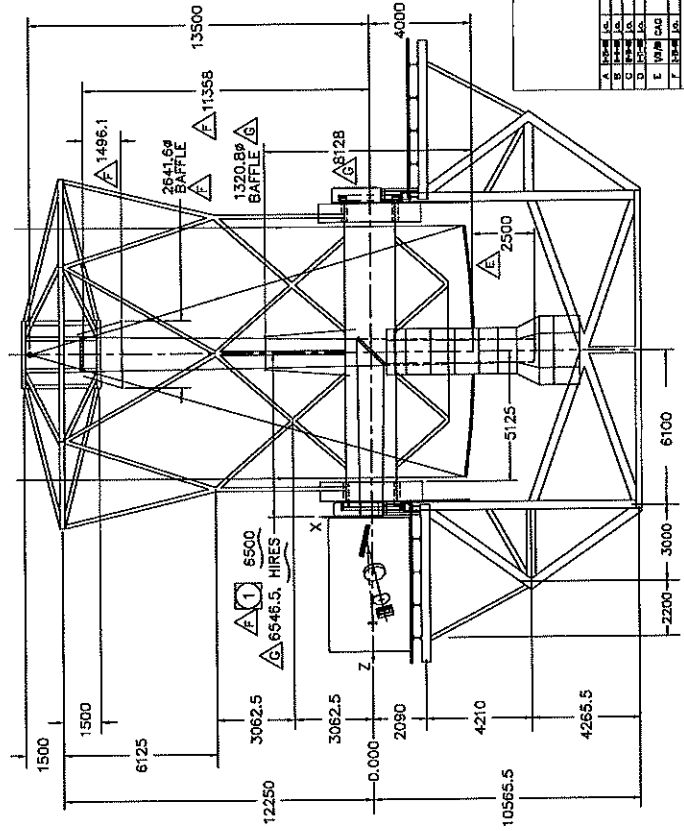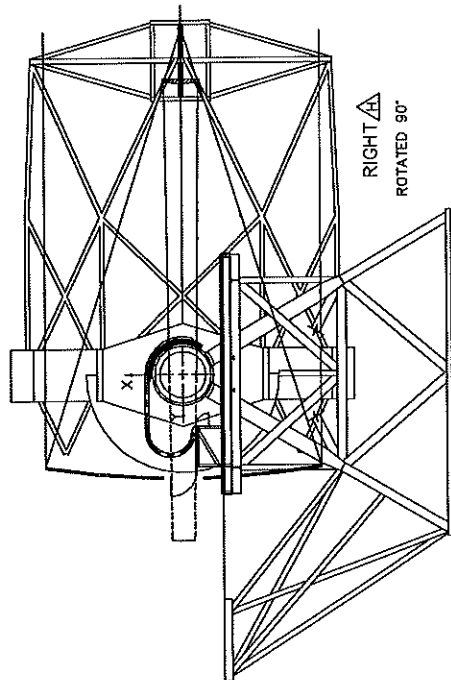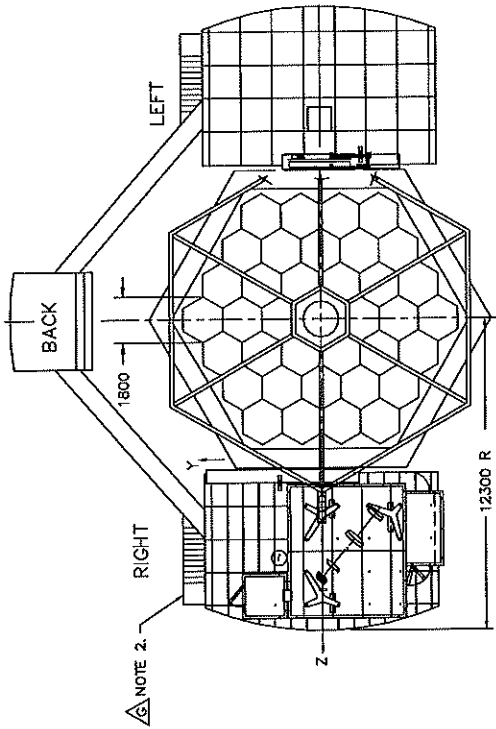

GENERAL ASSEMBLY

NOTES:

- 1 6500 IS NOMINAL FOCUS.
- 2 LANDING AND STAIR, AS NOTED BY STEVE VOGT, 3-21-92.

ALL DIMENSIONS ARE MM




3RD ANGLE PROJECTION

0.0125

KECK/HIRES
GENERAL ASSEMBLY

H0010.H

A	1000.00	1000.00	1000.00
B	1000.00	1000.00	1000.00
C	1000.00	1000.00	1000.00
D	1000.00	1000.00	1000.00
E	1000.00	1000.00	1000.00
F	1000.00	1000.00	1000.00
G	1000.00	1000.00	1000.00
H	1000.00	1000.00	1000.00
I	1000.00	1000.00	1000.00
J	1000.00	1000.00	1000.00
K	1000.00	1000.00	1000.00
L	1000.00	1000.00	1000.00
M	1000.00	1000.00	1000.00
N	1000.00	1000.00	1000.00
O	1000.00	1000.00	1000.00
P	1000.00	1000.00	1000.00
Q	1000.00	1000.00	1000.00
R	1000.00	1000.00	1000.00
S	1000.00	1000.00	1000.00
T	1000.00	1000.00	1000.00
U	1000.00	1000.00	1000.00
V	1000.00	1000.00	1000.00
W	1000.00	1000.00	1000.00
X	1000.00	1000.00	1000.00
Y	1000.00	1000.00	1000.00
Z	1000.00	1000.00	1000.00

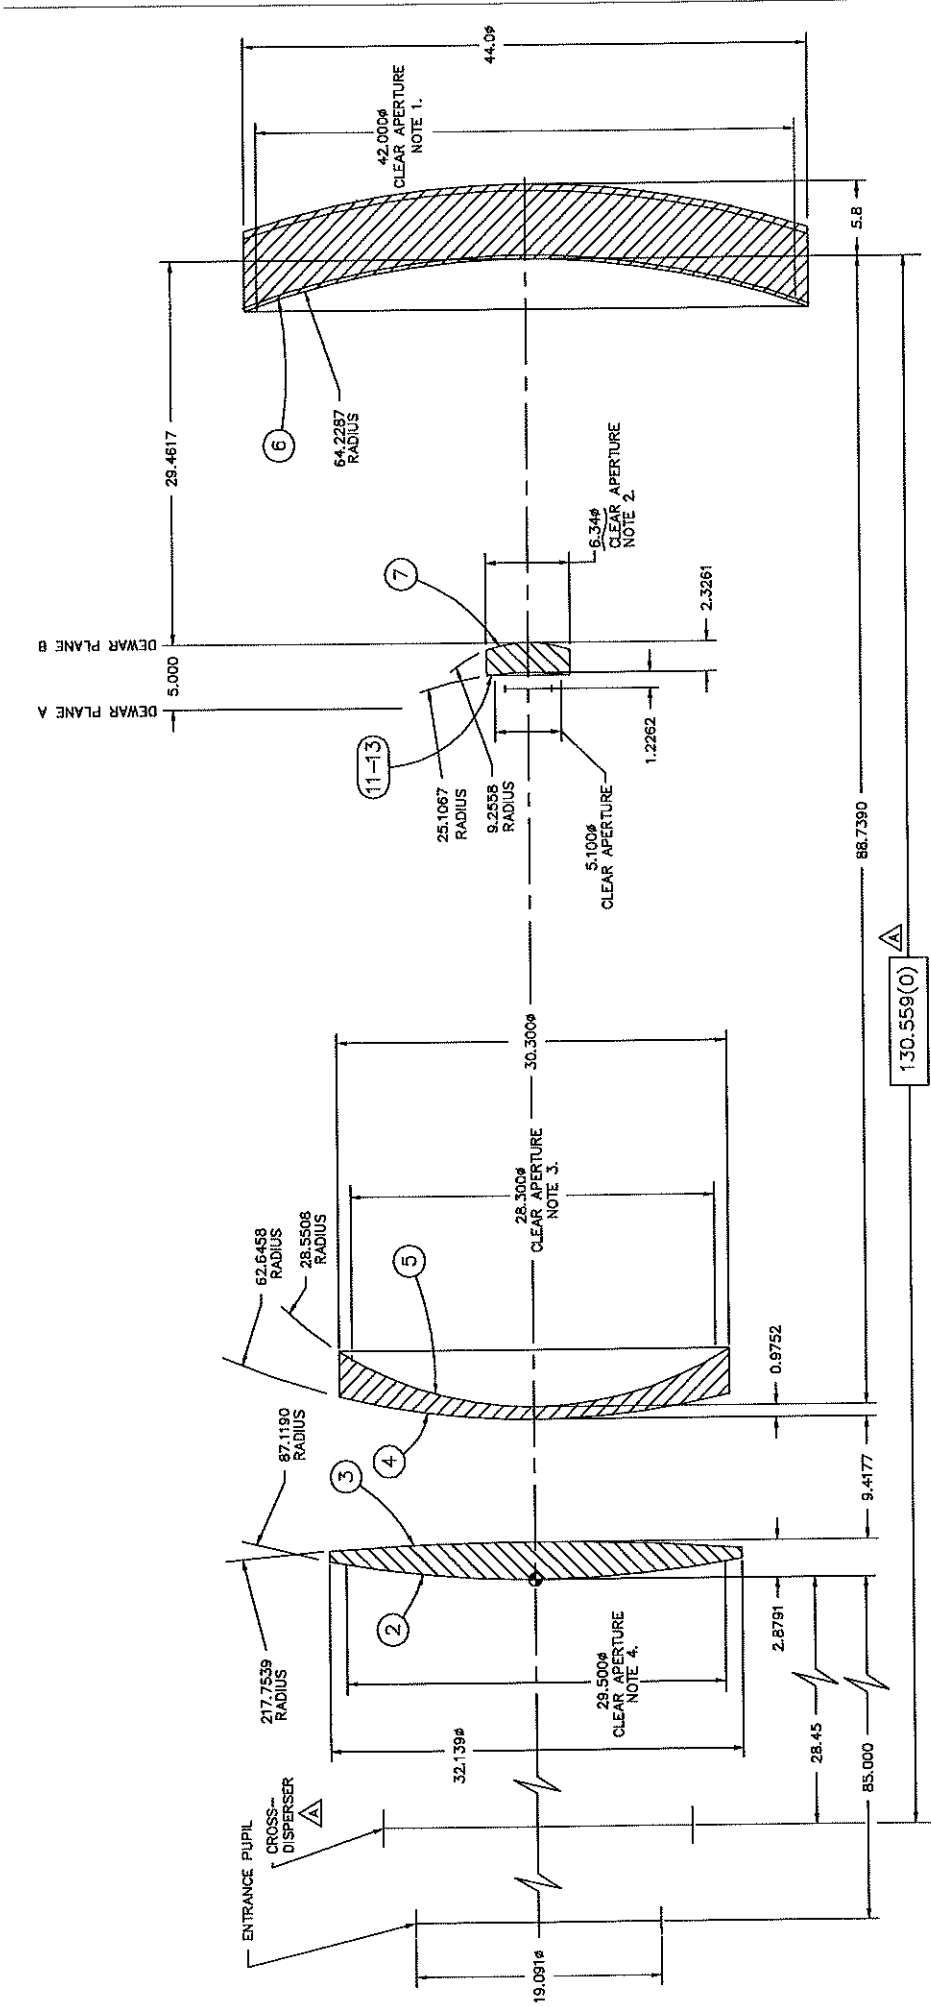

- NOTES:
1. 37.603% CLEAR APERTURE FOR THIS CCD. SEE H5400-H5403, H5415, H0144 FOR DETAILS
 2. 6.349 C.A. FROM 6.449 BLANK SEE H7181 FOR LENS DETAIL
 3. 25.906 C.A. SEE H0136, H0142, H0145, H0147
 4. 27.739 C.A. SEE H0136, H0141, H0145


① EPPS DESIGN #4052 (6/3/92)

FINAL "AS-BUILT" PRESCRIPTION
 USE WITH R=65.0" CONVEX TEK CCD
 T = 0°C
 THIS DRAWING REPLACES H0135, SUPER-DUPER II
 WHICH WAS EPPS DESIGN #7465 (11/15/90)
 THE FLAT FIELD VERSION #4753 IS DRAWING H0149.
 ⚠ 6.7° FOV (FIELD OF VIEW)

1/4

A	11/16" Dia	AS SHOWN TO ORDER APPROX.
B	11/16" Dia	AS SHOWN TO ORDER APPROX.

KECK/HIRES
 SUPER-DUPER CAMERA III
 AS-BUILT "CURVED FIELD"
 EPPS # 12
 JK # 8 # 2
 H0148.B

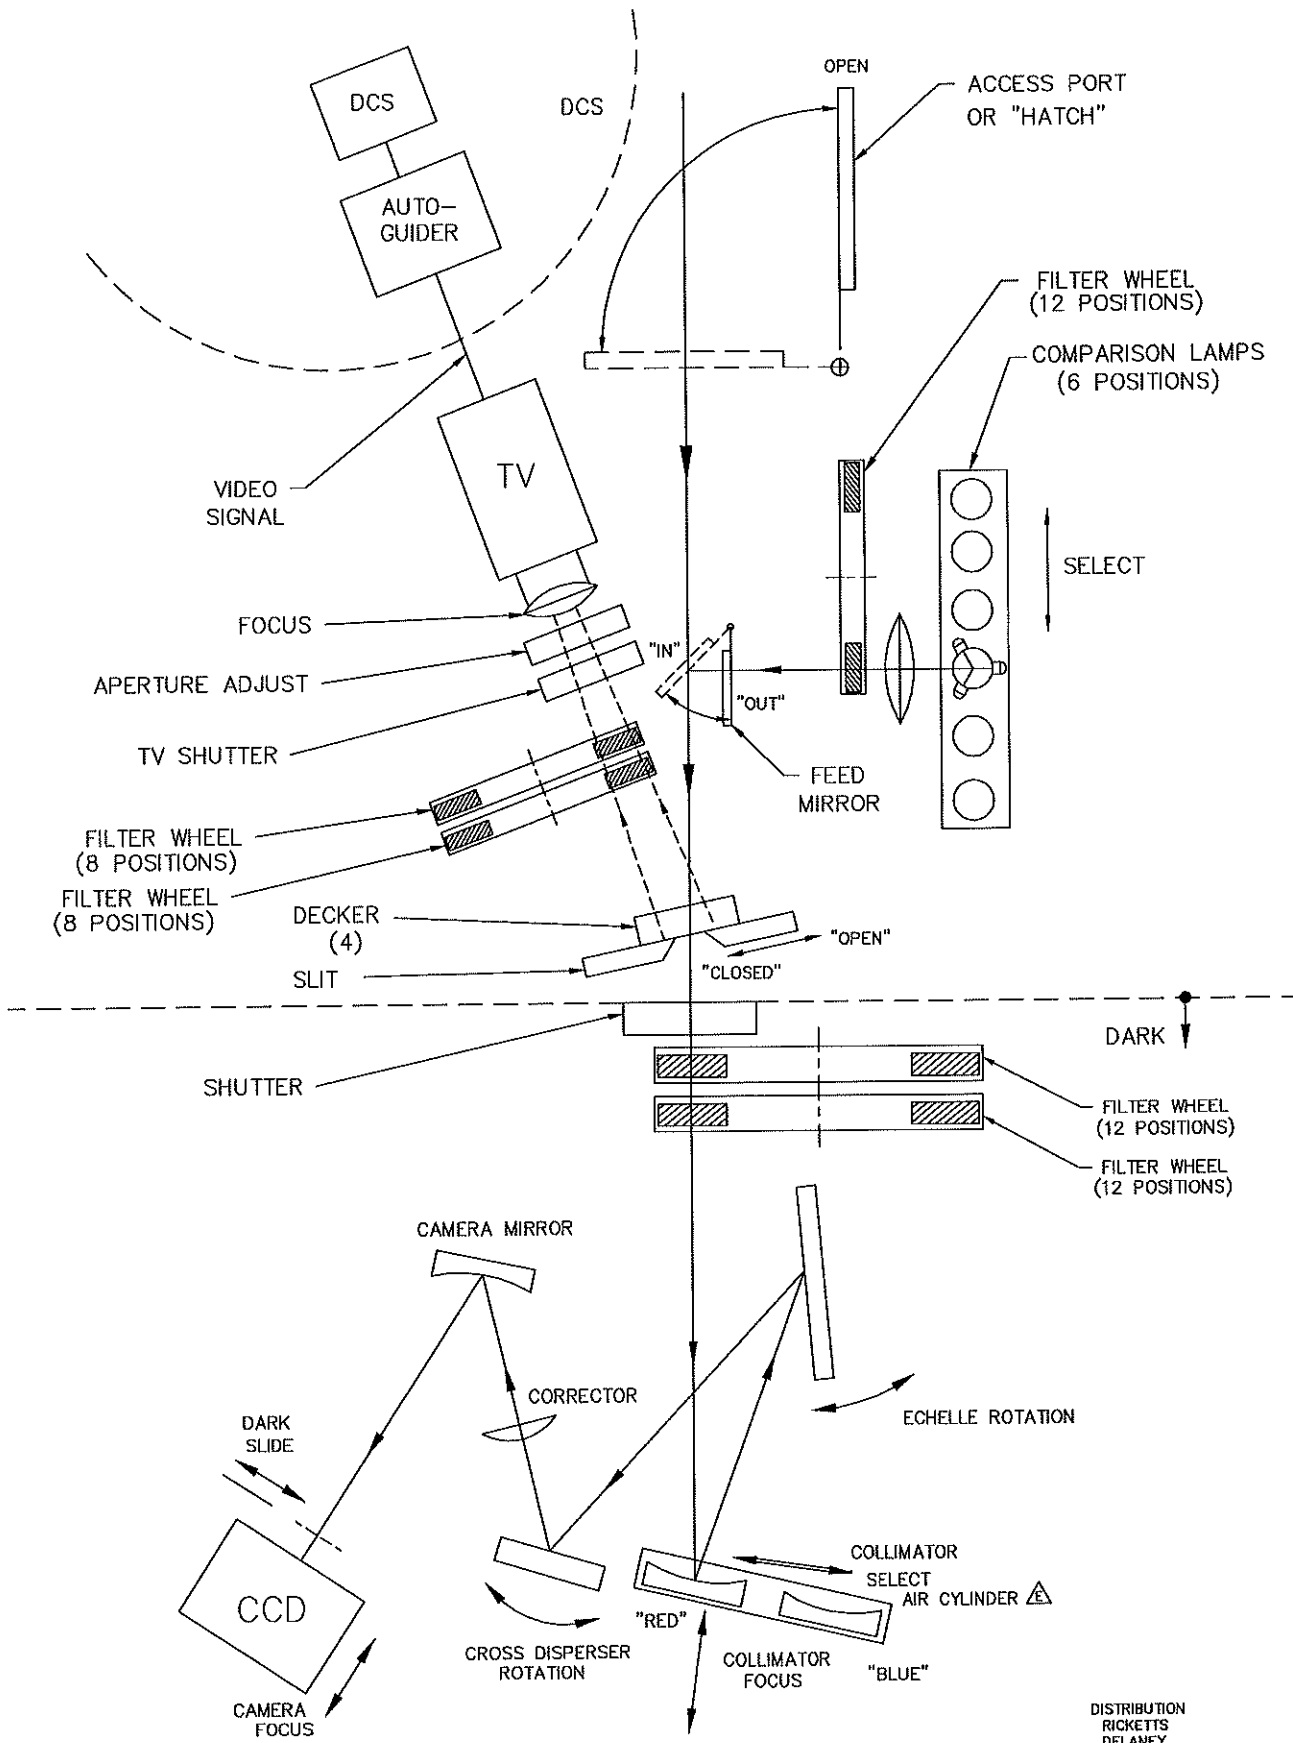

CONTROL FUNCTIONS
 /LOEN/DWG/H/H0200E.DWG
 NOT TO SCALE 6-18-90

DISTRIBUTION
 RICKETTS
 DELANEY
 FILE (OSBORNE)
 JERN
 KIBRICK
 VOGT
 BIGELOW
 BRESEE
 TUCKER

Appendix C List of Drawings — Collimators

1. H2005 Locating Tree
2. H2000 Collimator Assembly
3. H2206 Spring Pad Assembly
4. H2209 Support Detail (and Temperature Compensator)
5. H2401 Transfer Mechanism (Shuttle)
6. H2415 Shuttle Pneumatic Diagram
7. H2460 Stage Locks
8. H2600 Rear View of Cell
9. H2610 Focus Drive Schematic
10. H2620 Drive Detail
11. H2623 Focus Drive Motor
12. H2660 Motor/Gearbox Assembly



H2000	COLLIMATOR ASSEMBLY		H2600	COLLIMATOR FOCUS		
H2001	COL TOP PLATE DET		H2601	" " DETAIL		
H2100	RED MIRROR	H2401	H2602	" " DETAIL		
H2110	BLUE MIRROR	H2404	H2610	" " DRIVE SCHEMATIC		
H2200	COLLIMATOR CELL ASSY	H2405	H2620	" " DRIVE BLOCK ASSY		
H2201	" " DETAIL	H2406	H2621	" " DETAIL		
H2202	" " DETAIL	H2407	H2622	" " DETAIL		
H2203	" " DETAIL	H2408	H2623	" " MOTOR		
H2204	" " DETAIL	H2410	H2624	" " BELT TENSIONER ASSY		
H2205	" " DETAIL	H2411	H2625	" " DETAIL		
H2206	SPRING PAD ASSY	H2412	H2627	" " BRAKE MOD.		
H2207	" " DETAIL	H2413	H2628	" " BRAKE ASSYS		
H2208	TOOL	H2415	H2629	" " BRAKE DETAILS		
H2209	RADIAL SUPPORT ASSY	H2416	H2630	" " LIMITS		
H2210	" " DETAIL	H2417	H2631	" " DETAIL		
H2300	COVER ASSEMBLY AND AIR SCHEMATIC DIAGRAM	H2420	H2632	" " DETAIL		
H2301	COVER/CYLINDER LAYOUT	H2421	H2633	" " DETAIL		
H2302	AIR CYLINDER & DOOR	H2422	H2603	ALIGNMENT FIXTURE		
H2303	SPEED CONTROL MOD.	H2423	H2604	" " DETAIL		
H2304	" " DETAIL	H2460	H2605	" " DETAIL		
		H2461				
		H2462				
		H2463				
		H2450				
		H2451				
		H2452				
		H2453				

H2634	COLLIMATOR FOCUS	SPRING ASSY
H2635	COLLIMATOR FOCUS	SPRING ASSY
H2636	" "	SPRING DETAIL
H2637	" "	" "
H2638	" "	" "
H2639	" "	DETAIL
H2640	DIAL INDICATORS ASSY	
H2641	" "	DETAIL
H2645	MOTOR GUARD DETAIL	
H2650	COLLIMATOR FOCUS	SHUTTLE DETAIL
H2651	" "	" "
H2652	" "	" "
H2653	" "	" "
H2654	" "	" "
H2655	" "	" "
H2656	" "	" "
H2657	" "	" "
H2658	" "	" "
H2660	" "	GEAR REDUCER
H2661	" "	" " ADAPTER
H2450	COLLIMATOR JUNCTION BOX ("AC STAGE")	
H2451	" "	DETAIL
H2452	COL FOCUS BOX	
H2453	" "	DETAIL

KECK/HIRES
COLLIMATOR
LOCATING TREE

Job. 828

H2005.A

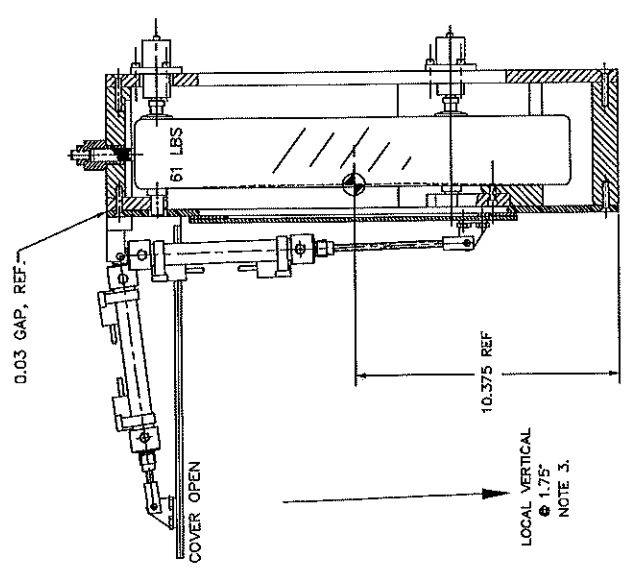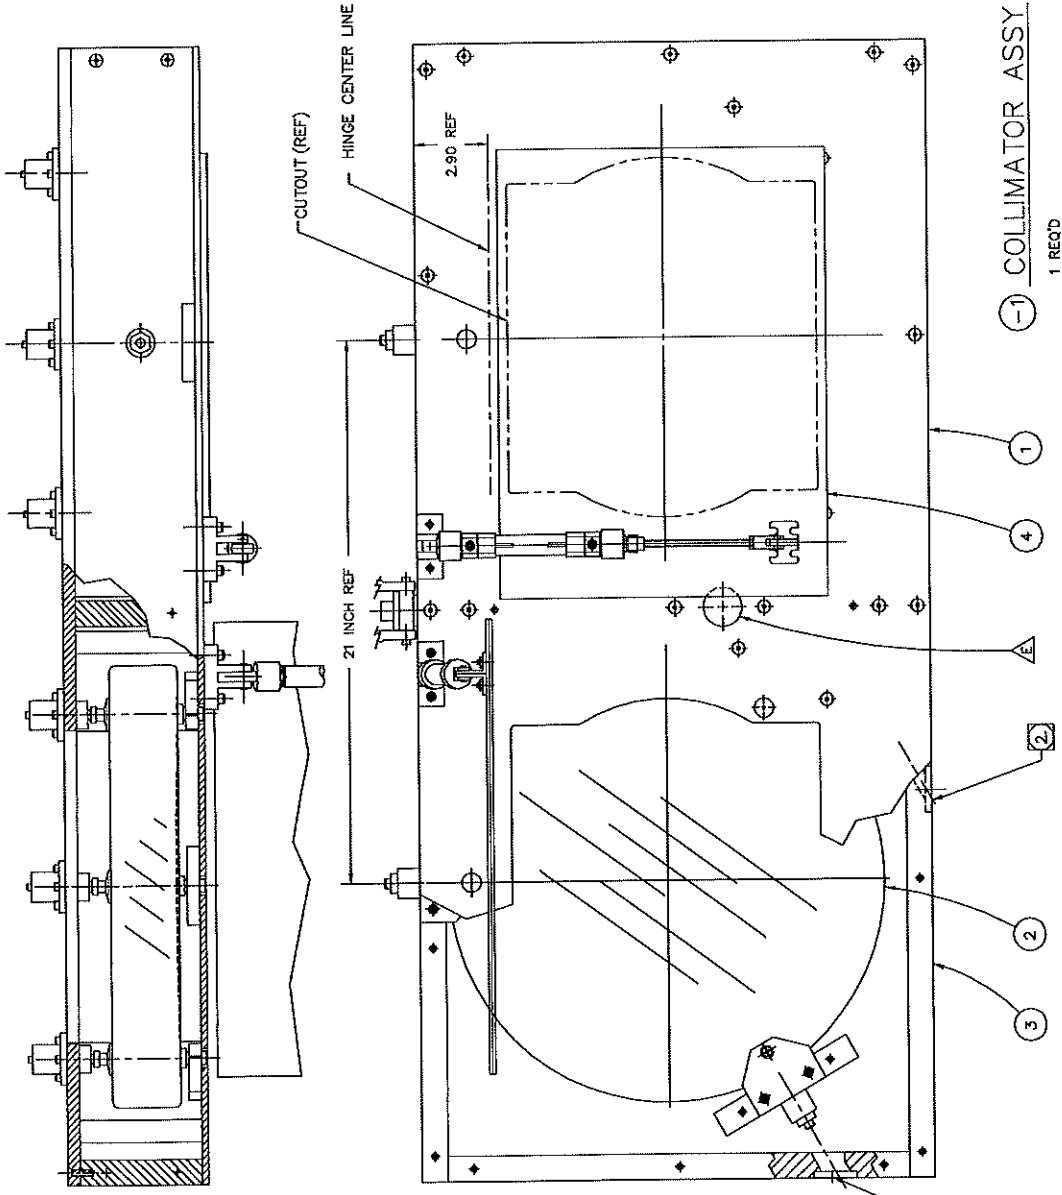

H2300-1	4	2	COVER ASSY
H2301-1	3	1	MIRROR CELL ASSY
H2400-1	2	2	COLLIMATOR MIRROR
H2500-1	1	1	TOP PLATE
			PREP
			ALUM

1/2

KECK/HIRES
COLLIMATOR
ASSEMBLY


H2000.E

A	10-10-88	J.A.	DESIGN REVIEW CHANGES
B	11-12-88	J.P.	UPDATE TO AS-BUILT
C	12-21-88	J.S.	ISSUE CHANGES AND CHL. MOUNTS
D	01-15-89	J.S.	ISSUE CHANGES AND CHL. MOUNTS
E	02-15-89	J.S.	ADD USA MOUNTING HOLE NOTE

- 1 REQ'D
- NOTES:
- REF H2301, COVER/CYLINDER DIMENSIONS.
 - COLLIMATOR ACCESS HOLE (5 PLACES).
 - MIRROR IS MOUNTED SQUARE TO THE CELL.
THE CELL IS TILTED 1.75° FROM VERTICAL.

COLLIMATOR ASSY

J.A. 10 01 88
C.A.G. 11 22 88

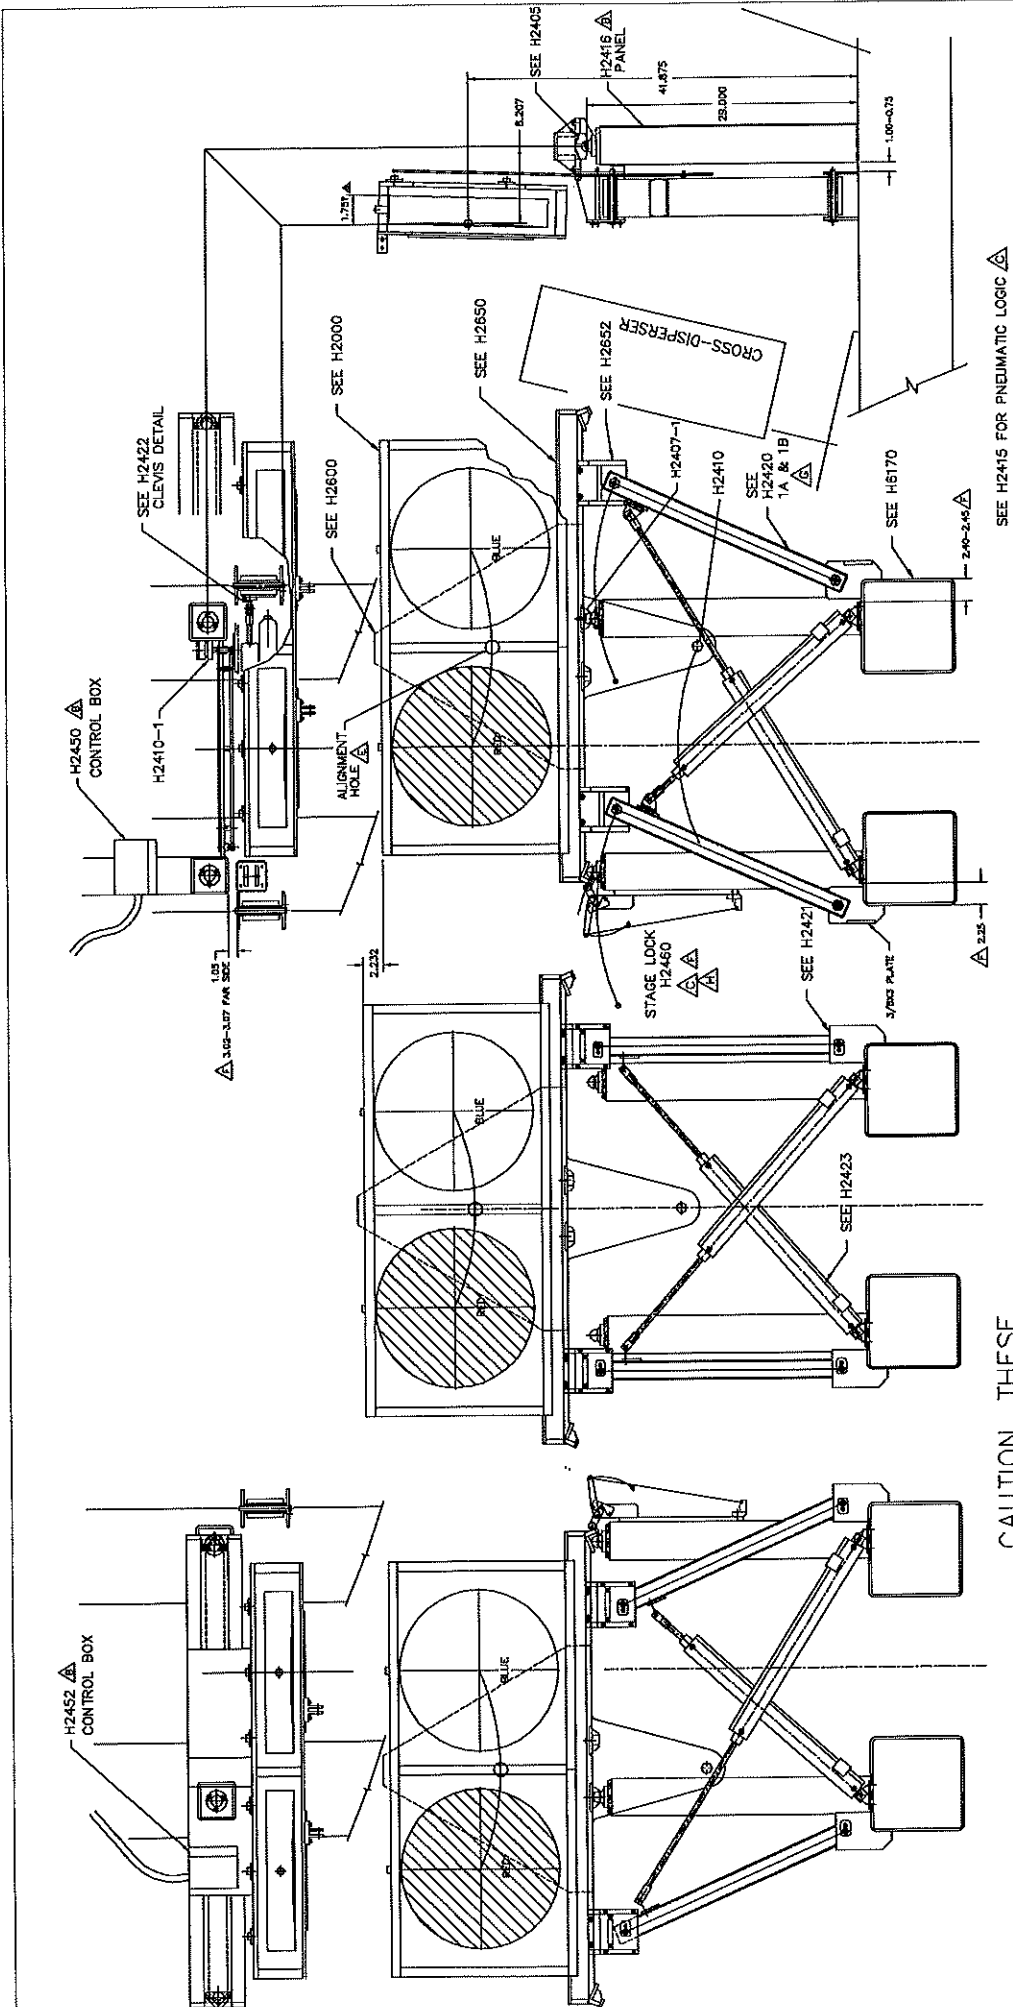

CAUTION, THESE
2 VIEWS ARE NOT
CORRECT

SEE H2415 FOR PNEUMATIC LOGIC


NA

KECK/HIRES
COLLIMATOR MIRRORS
TRANSFER MECHANISM
H2401.H

A	1-4-69	10	COMPLETE THE DRAWING AFTER SEE REVZ
B	1-25-69	10	ADD CENTER POINT & PANEL
C	1-25-69	10	ADD CENTER POINT & PANEL
D	1-25-69	10	ADD CENTER POINT & PANEL
E	1-11-69	10	ADD ALIGNMENT HOLE
F	1-28-69	10	ADD CENTER POINT


G	10-1-69	10	VERIFY DIMENSIONS (ADD RELI)
H	10-2-69	10	VERIFY DIMENSIONS (ADD RELI)
I	10-2-69	10	VERIFY DIMENSIONS (ADD RELI)
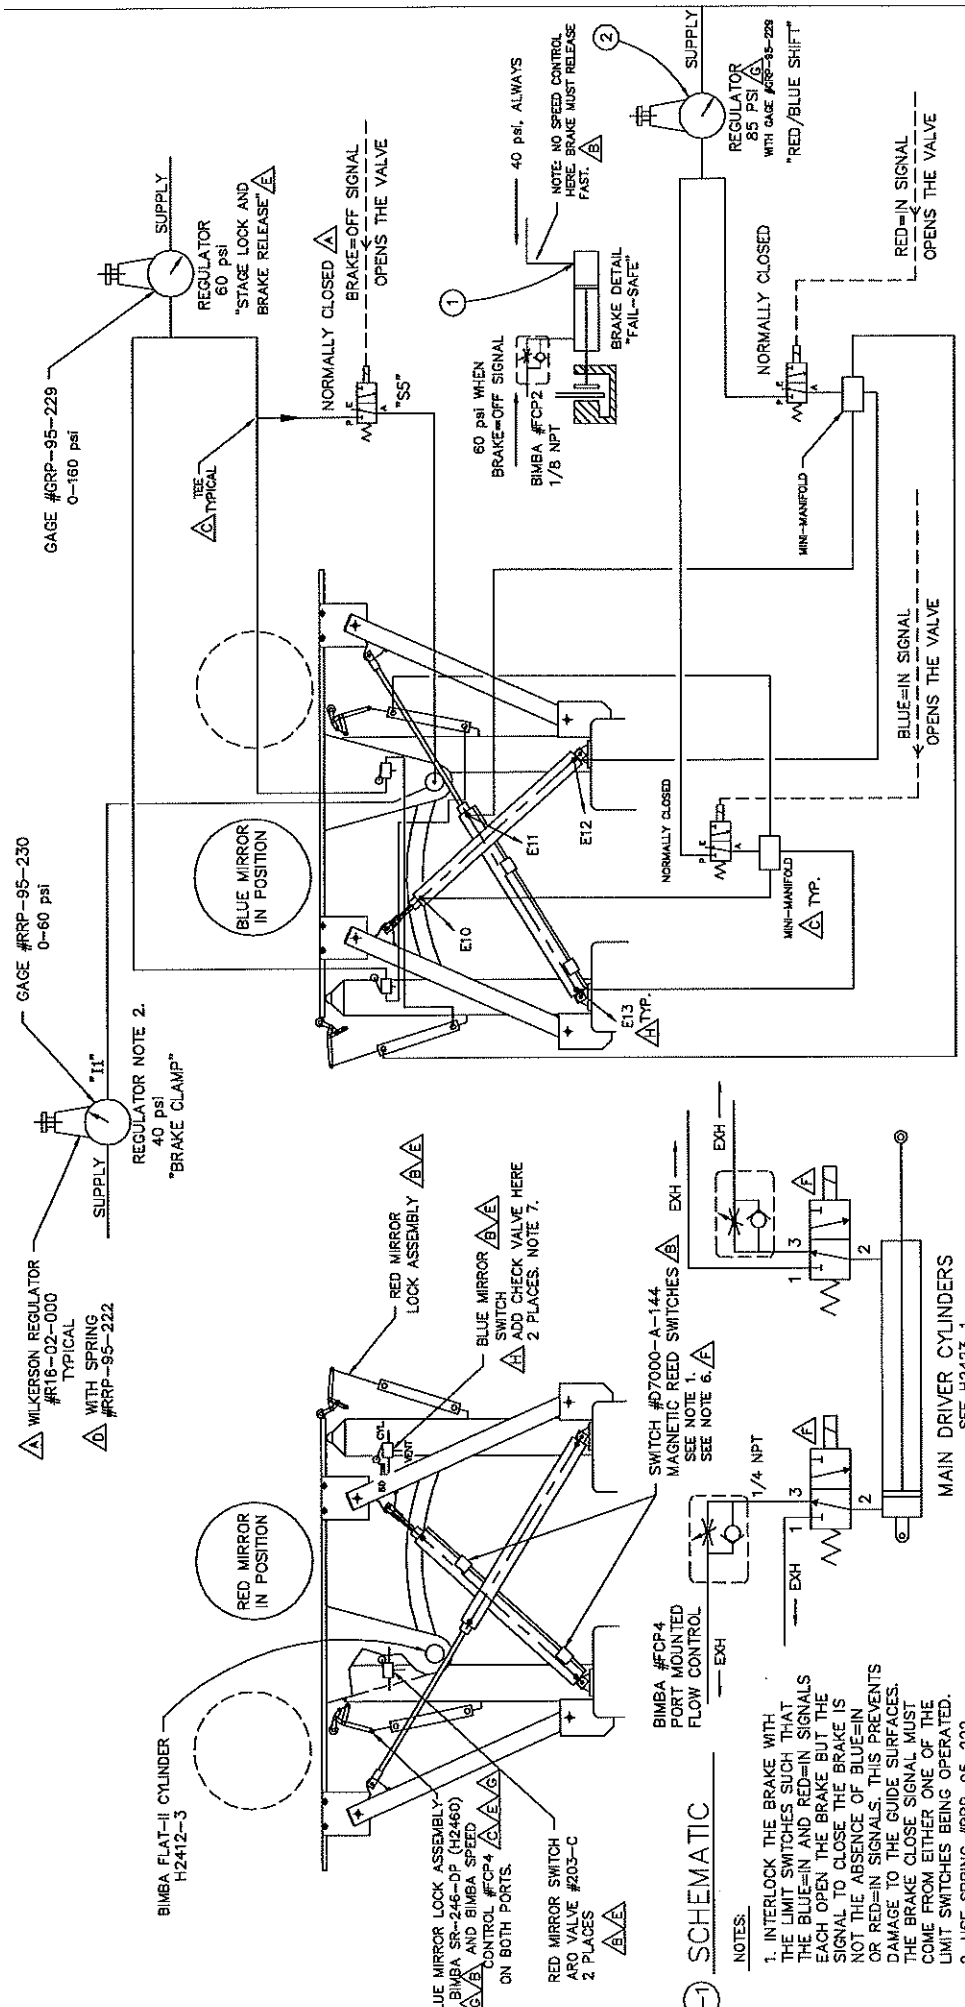


SCHEMATIC

- NOTES:**
- INTERLOCK THE BRAKE WITH THE LIMIT SWITCHES SUCH THAT THE BLUE=IN AND RED=IN SIGNALS EACH OPEN THE BRAKE BUT THE SIGNAL TO CLOSE THE BRAKE IS NOT THE ABSENCE OF BLUE=IN OR RED=IN SIGNALS. THIS PREVENTS DAMAGE TO THE GUIDE SURFACES. THE BRAKE CLOSE SIGNAL MUST COME FROM EITHER ONE OF THE LIMIT SWITCHES BEING OPERATED.
 - SWAGELOK #B-400-1-2 (1/8 NPT)
 - SWAGELOK #B-400-1-4 (1/4 NPT)
 - ALL EXHAUST PORTS MUST BE CONNECTED TO EXHAUST MANIFOLD TO BE VENTED OUTSIDE OF THE HIRES HOUSING.
 - THESE SWITCHES ALSO VENT THE MAIN DRIVE CYLINDERS AFTER TOUCHDOWN.
 - NUPRO B-202-1, WITH 1 PSI SPRING. 1/8 NPT. ADAPTS WITH SWAGELOK B-400-7-2 FEMALE 1/8 NPT TO 1/4" TUBE.

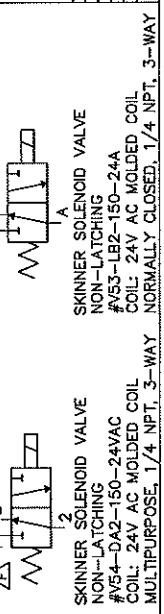

FITTING	FITTING	2 1/4 NPT 1/4 TUBE TO 1/8 NPT	NOTE 5
A	1/8 NPT	1/4 TUBE TO 1/8 NPT	NOTE 3
B	1/8 NPT	1/4 TUBE TO 1/8 NPT	NOTE 3
C	1/8 NPT	1/4 TUBE TO 1/8 NPT	NOTE 3
D	1/8 NPT	1/4 TUBE TO 1/8 NPT	NOTE 3
E	1/8 NPT	1/4 TUBE TO 1/8 NPT	NOTE 3

KECK/HIRES
 COLLIMATOR CHANGER
 PNEUMATIC DIAGRAM
 J.P. 8380
 H2415.H

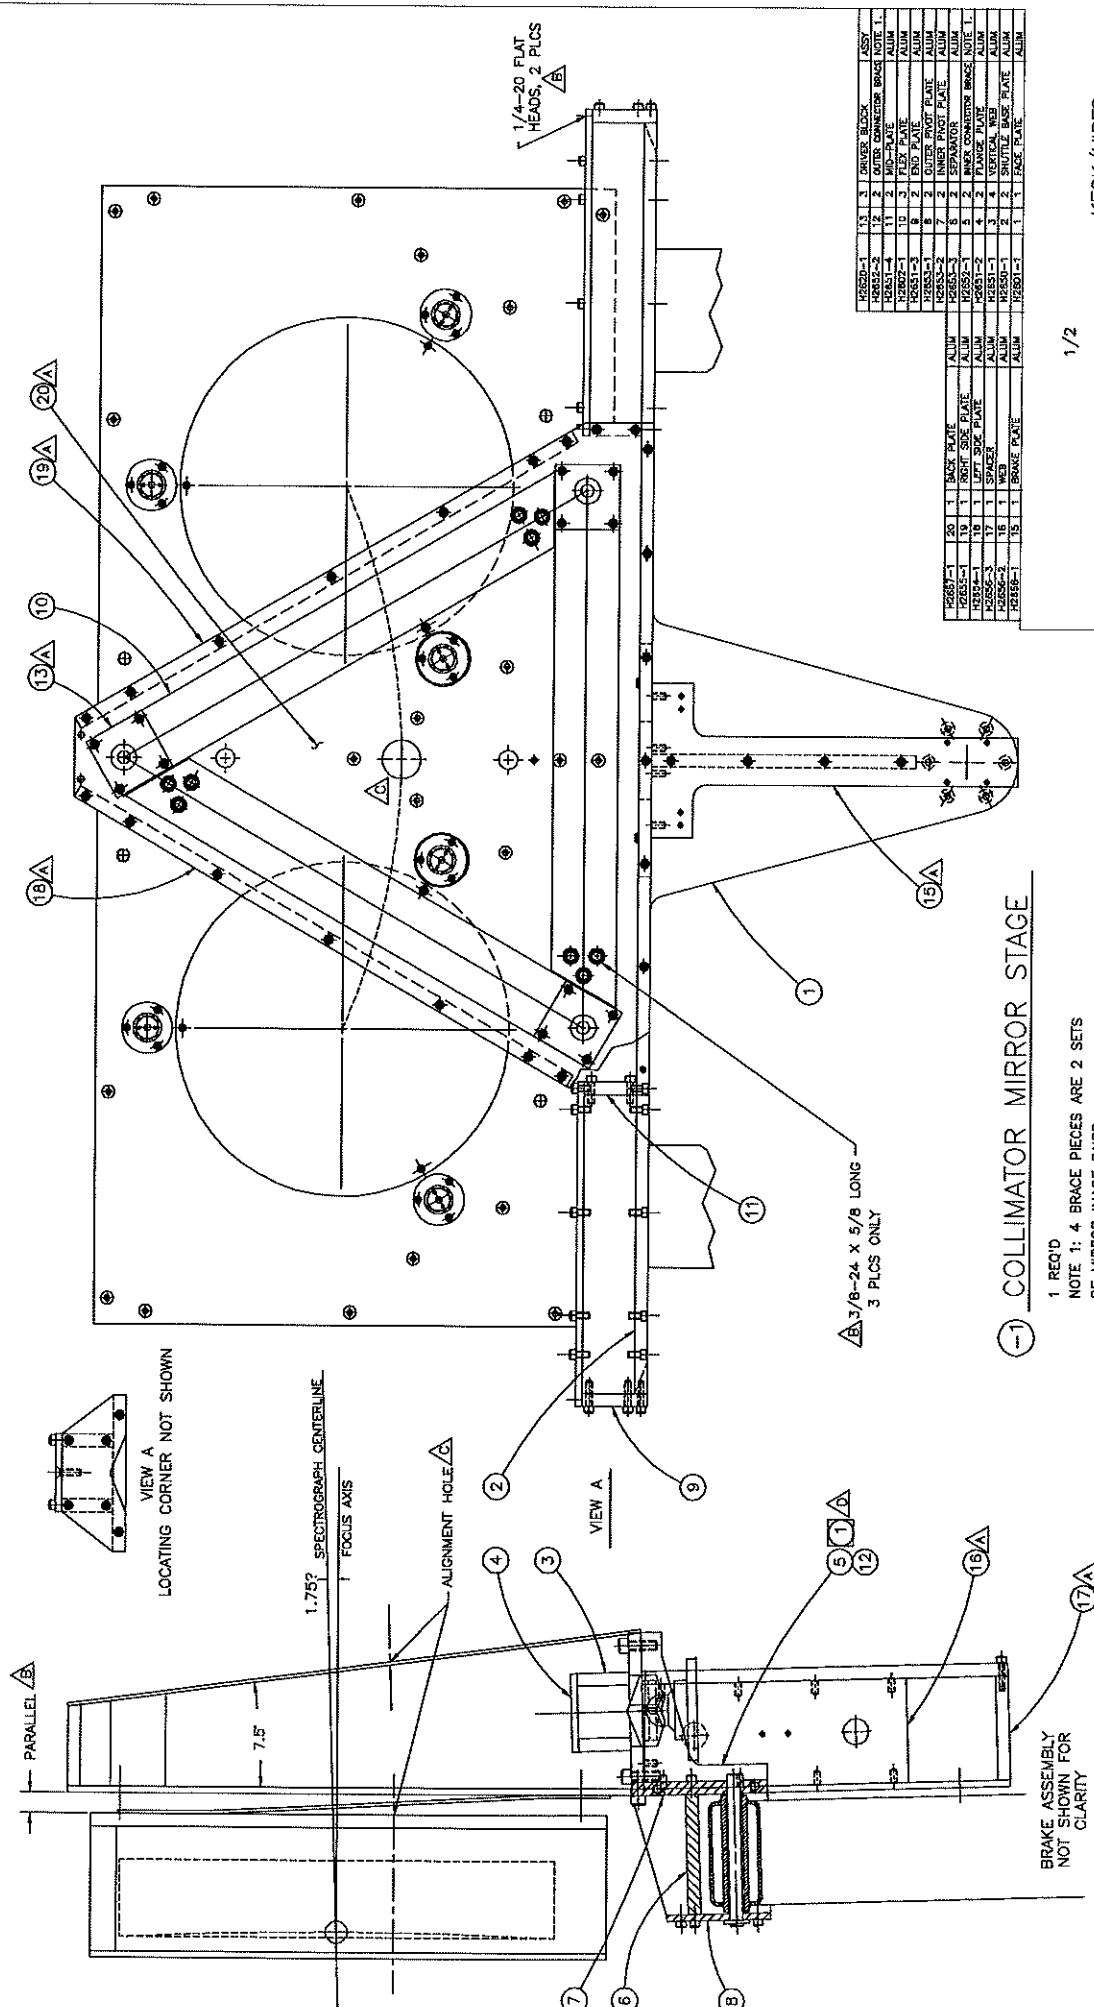

PARALLEL Δ

7.5"

1.75" SPECTROGRAPH CENTERLINE
FOCUS AXIS

VIEW A
LOCATING CORNER NOT SHOWN

ALIGNMENT HOLE Δ

VIEW A

1/4"-20 FLAT HEADS, 2 PLCS Δ

COLLIMATOR MIRROR STAGE

1 REQ'D
NOTE 1: 4 BRACE PIECES ARE 2 SETS
OF MIRROR IMAGE PAIRS.

1/2


BRACE ASSEMBLY
NOT SHOWN FOR
CLARITY

THIS VIEW IS TIPPED
1.75° FROM VERTICAL Δ

12852-1	20	1	BACK PLATE	ALUM
12852-2	19	1	RIGHT SIDE PLATE	ALUM
12852-3	18	1	LEFT SIDE PLATE	ALUM
12852-4	17	1	SPACER	ALUM
12852-5	16	1	SPACER	ALUM
12852-6	15	1	BRACE PLATE	ALUM
12852-7	14	1	BRACE PLATE	ALUM
12852-8	13	1	BRACE PLATE	ALUM
12852-9	12	1	BRACE PLATE	ALUM
12852-10	11	1	BRACE PLATE	ALUM
12852-11	10	2	FLAT PLATE	ALUM
12852-12	9	2	OUTER PROOT PLATE	ALUM
12852-13	8	2	INNER CONDUCTOR BRASE	NOTE 1
12852-14	7	2	EXPANSION PLATE	ALUM
12852-15	6	2	SPACER	ALUM
12852-16	5	2	SPACER	ALUM
12852-17	4	2	VERTICAL WEB	ALUM
12852-18	3	2	VERTICAL WEB	ALUM
12852-19	2	2	BRACE PLATE	ALUM
12852-20	1	2	BRACE PLATE	ALUM
12852-21	1	2	DRIVER BLOCK	ASSY
12852-22	1	2	CONDUCTOR BRASE	NOTE 1
12852-23	1	2	MID-PLATE	ALUM
12852-24	1	2	FLAT PLATE	ALUM
12852-25	1	2	END PLATE	ALUM
12852-26	1	2	OUTER PROOT PLATE	ALUM
12852-27	1	2	INNER CONDUCTOR BRASE	NOTE 1
12852-28	1	2	EXPANSION PLATE	ALUM
12852-29	1	2	SPACER	ALUM
12852-30	1	2	SPACER	ALUM
12852-31	1	2	VERTICAL WEB	ALUM
12852-32	1	2	VERTICAL WEB	ALUM
12852-33	1	2	BRACE PLATE	ALUM
12852-34	1	2	BRACE PLATE	ALUM

KECK/HIRES
COLLIMATOR FOCUS
CELL VIEW, FAR SIDE
14 6 20 90
H26000.D


A	1/4"-20	1/2"	ADD DIMS. 13 THRU 21 INCLUDES AND NOTES.
B	1/4"-20	1/2"	ADD DIMS. 13 THRU 21 INCLUDES AND NOTES.
C	1/4"-20	1/2"	ADD DIMS. 13 THRU 21 INCLUDES AND NOTES.
D	1/4"-20	1/2"	ADD DIMS. 13 THRU 21 INCLUDES AND NOTES.

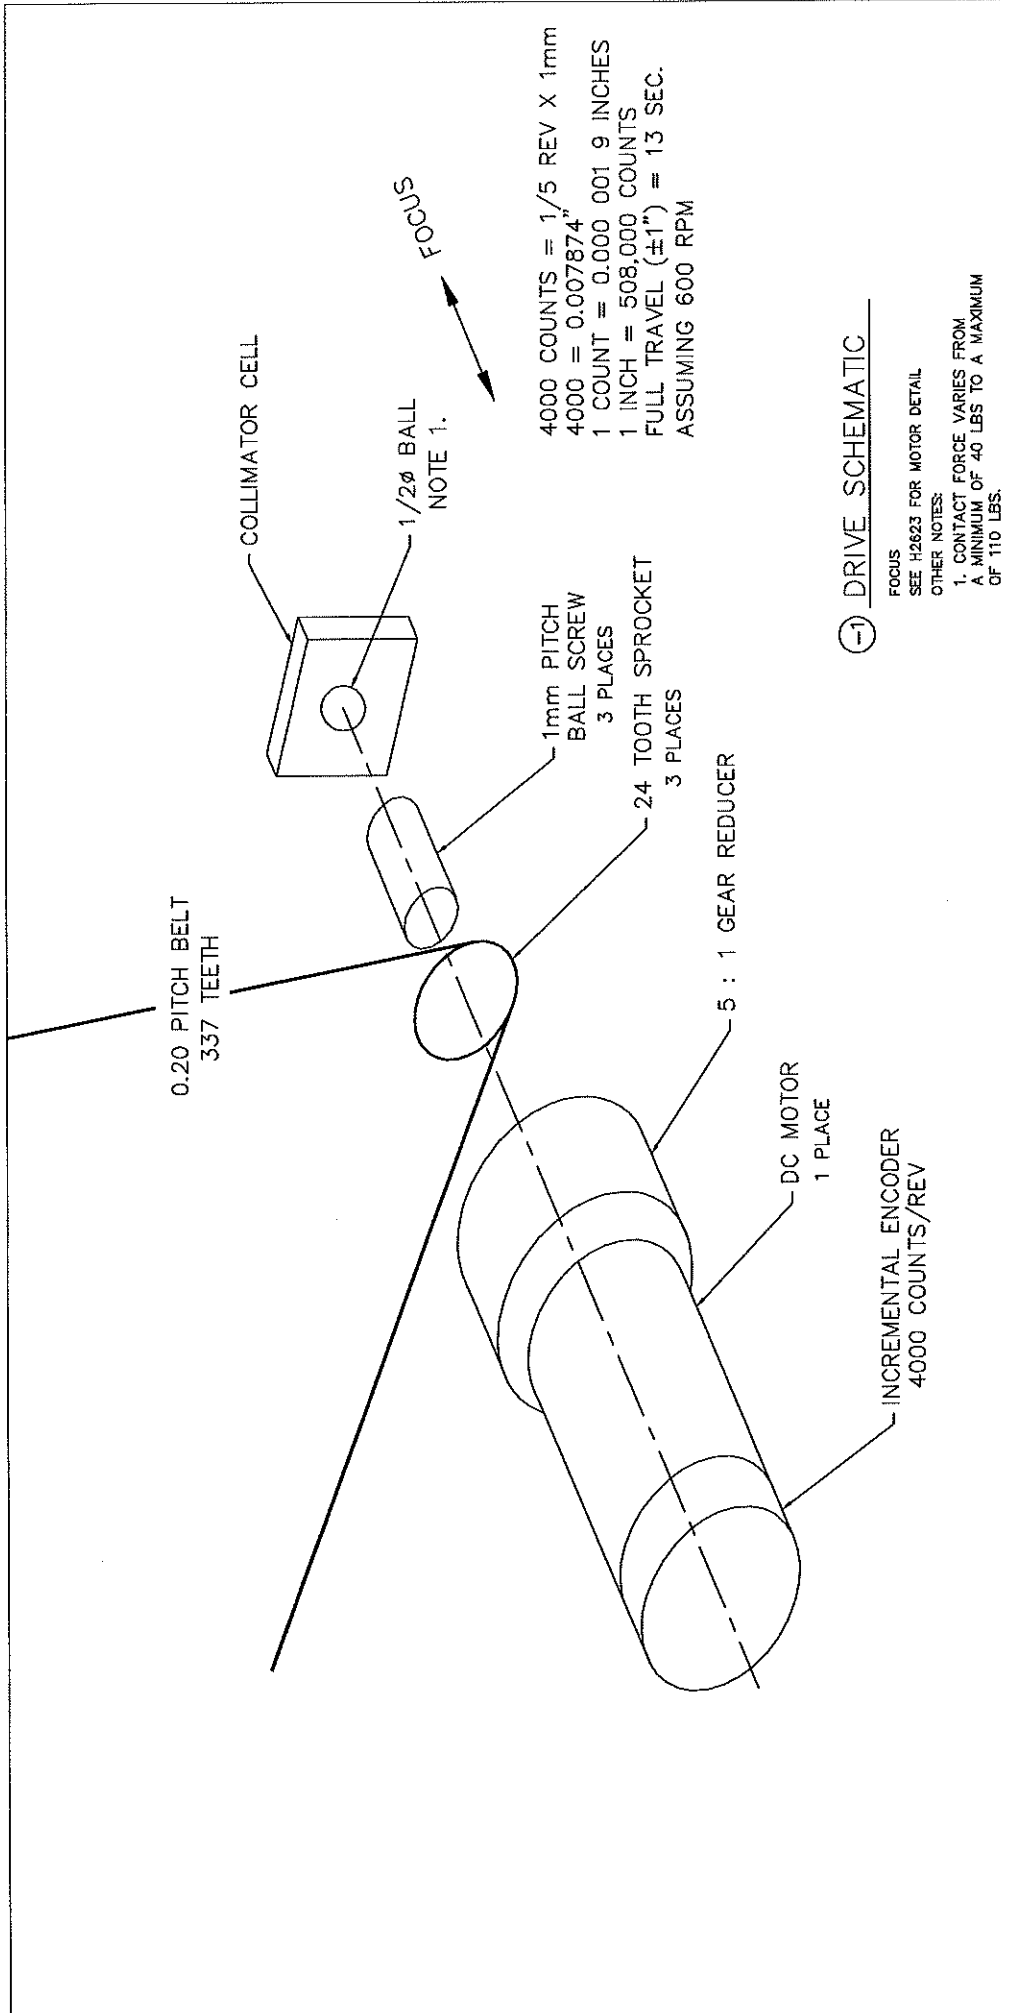

4000 COUNTS = 1/5 REV X 1mm
 4000 = 0.007874"
 1 COUNT = 0.000 001 9 INCHES
 1 INCH = 508,000 COUNTS
 FULL TRAVEL (±1") = 13 SEC.
 ASSUMING 600 RPM

⊖ DRIVE SCHEMATIC

FOCUS
 SEE H2623 FOR MOTOR DETAIL
 OTHER NOTES:
 1. CONTACT FORCE VARIES FROM
 A. MINIMUM OF 40 LBS TO A MAXIMUM
 OF 110 LBS.

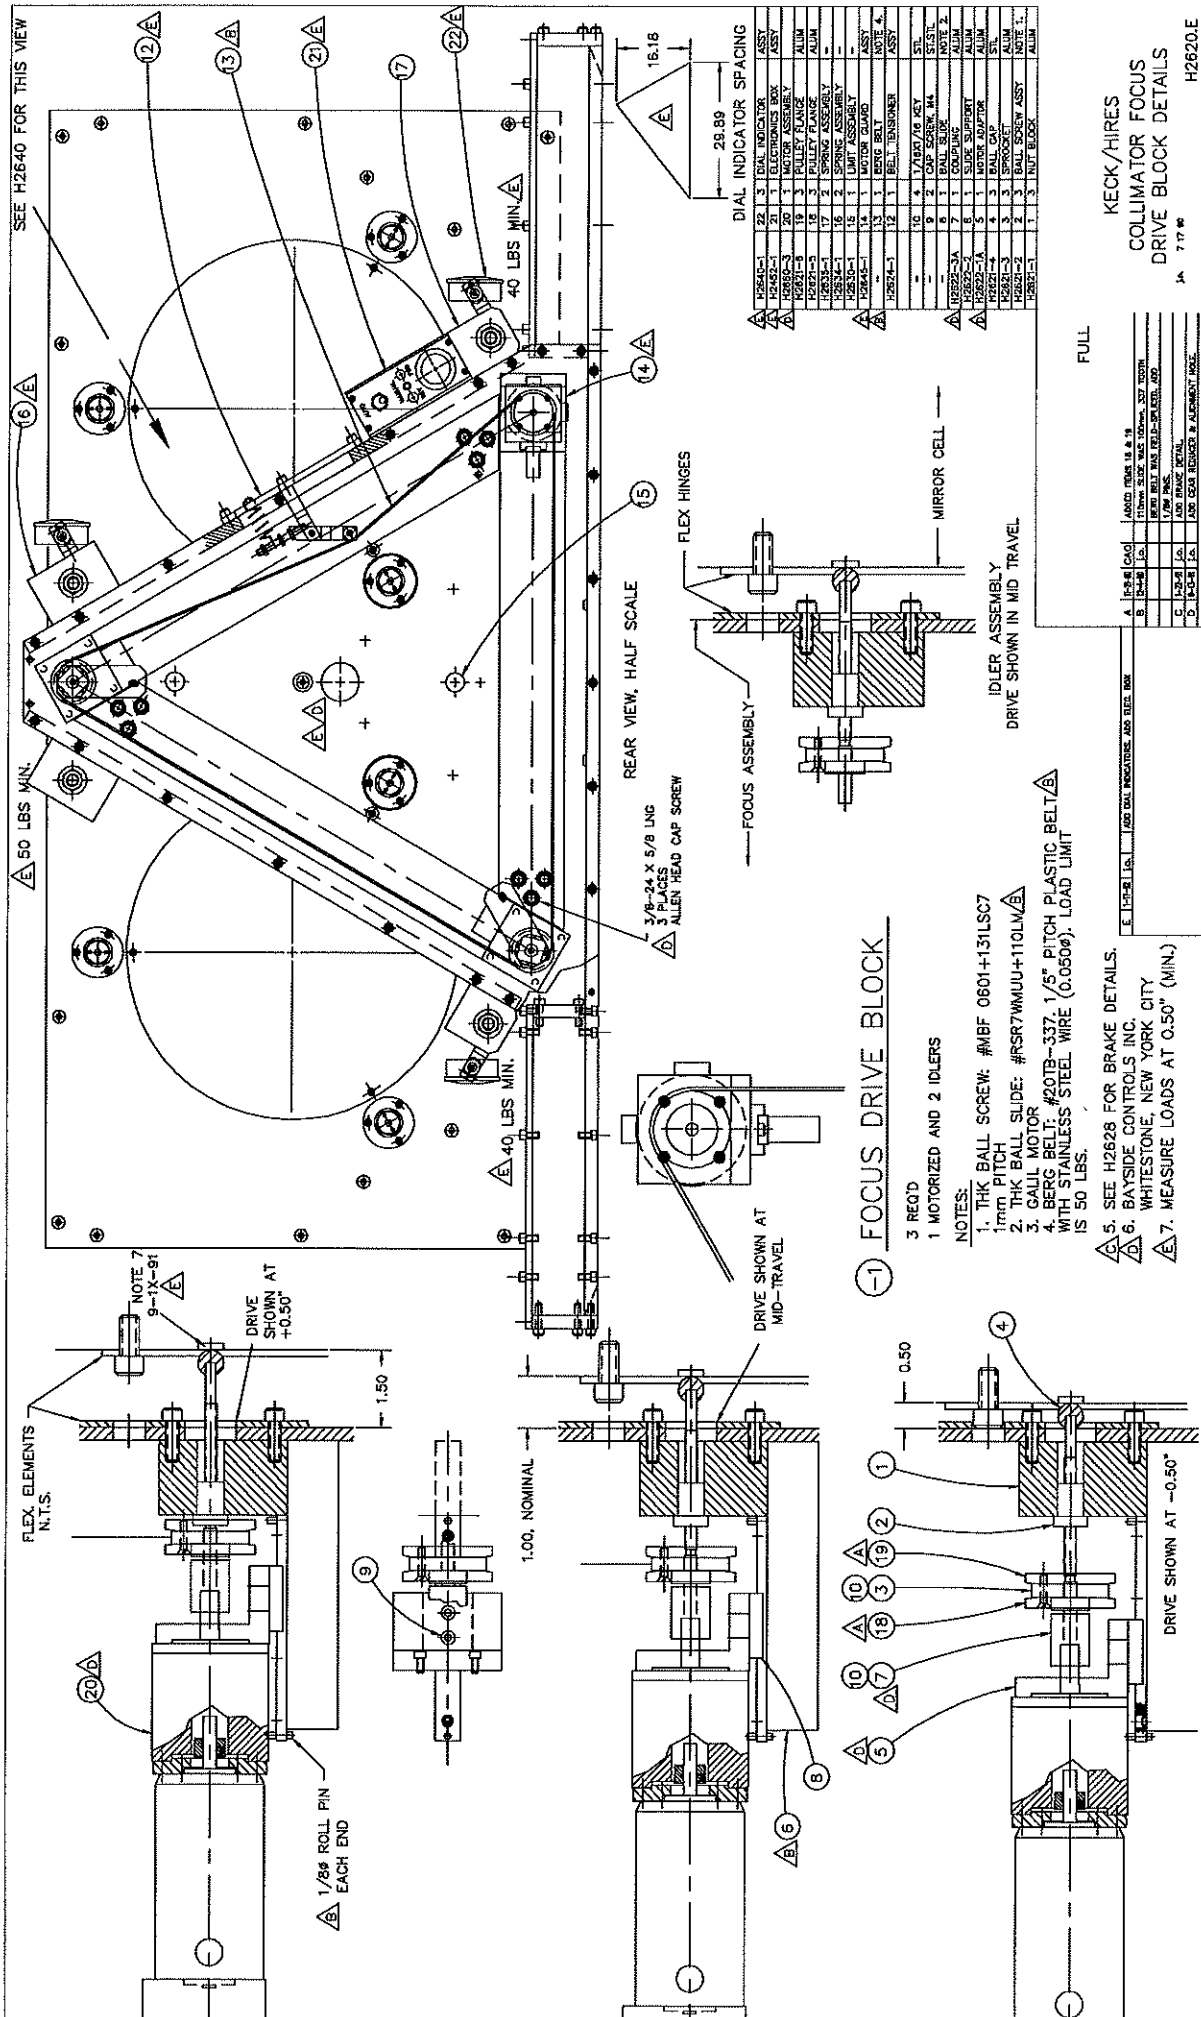

SEE H2640 FOR THIS VIEW

△ 50 LBS MIN.

FLEX ELEMENTS
N.T.S.

△ 1/8" ROLL PIN
EACH END

△ 40 LBS MIN.

△ 16.18

△ 22

△ 21

△ 20

△ 19

△ 18

△ 17

△ 16

△ 15

△ 14

△ 13

△ 12

△ 11

△ 10

△ 9

△ 8

△ 7

△ 6

△ 5

△ 4

△ 3

△ 2

△ 1

△ 20

△ 19

△ 18

△ 17

△ 16

△ 15

△ 14

△ 13

△ 12

△ 11

△ 10

△ 9

△ 8

△ 7

△ 6

△ 5

△ 4

△ 3

△ 2

△ 1

△ 20

△ 19

△ 18

△ 17

△ 16

△ 15

△ 14

△ 13

△ 12

△ 11

△ 10

△ 9

△ 8

△ 7

△ 6

△ 5

△ 4

△ 3

△ 22

△ 21

△ 20

△ 19

△ 18

△ 17

△ 16

△ 15

△ 14

△ 13

△ 12

△ 11

△ 10

△ 9

△ 8

△ 7

△ 6

△ 5

△ 4

△ 3

△ 2

△ 1

△ 20

△ 19

△ 18

△ 17

△ 16

△ 15

△ 14

△ 13

△ 12

△ 11

△ 10

△ 9

△ 8

△ 7

△ 6

△ 5

△ 4

△ 3

△ 2

△ 1

△ 20

△ 19

△ 18

△ 17

△ 16

△ 15

△ 14

△ 13

△ 12


△ 11

△ 10

△ 9


PITTMAN HIGH ALTITUDE
BRUSHES, TREATED
#60-47-4
PITTMAN
HARLEYSVILLE, PA

KEYSEAT FOR 1/16 KEY
MUST BE ADDED

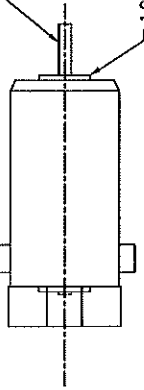


1.008 x 0.10 SHOULDER

#6-32 SCREWS
4 PLACES

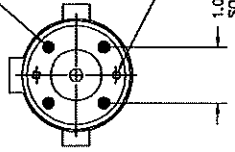

#6-32 HOUSING SCREWS
2 PL ON 1.5658 BC

1.083
SQUARE

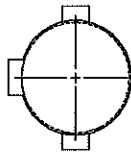

MOTOR

GALL #MOTOR-50-1000
GALLIL MOTION CONTROL INC
PALO ALTO, CALIFORNIA
(415) 964-6494

MOTOR:
14204-B352 WDG#4
30.3 VOLTS
15.1 AMPS
10.8 IN-OZ/AMP
205 IN-OZ PEAK STALL TORQUE
3670 RPM NO LOAD SPEED

MOTOR SPECIFICATIONS:
PITTMAN #14204-B352
AND HEWLETT-PACKARD ENCODER
SERIES #HEDS-6010

THIS MOTOR IS NOW CUSTOM-MOUNTED
TO HP HEDS ENCODER; 10 WEEK DELIVERY

MOTOR ALSO COMES WITH BEI
ENCODER ATTACHED.
DO NOT USE THIS MOTOR. TEMPERATURE
RANGE IS ONLY +80C TO -10C.

ENCODER:
HEDS-6010 ENCODER
1000 LINE DISC WITH
TIMES-4 LOGIC
COUNTS PER REV. 4000
INDEX PULSE ALSO
ENCODER IS GLUED TO MOTOR
BY GALLIL
TEMPERATURE RANGE: +83C TO -20C
LED LIGHT SOURCE

BEI ENCODER
MODEL MX 212-25-1000
SAN MARCOS, CA
TEMPERATURE RANGE: +80C TO -10C
LED LIGHT SOURCE


NOTE: THIS MOTOR IS USED
IN THE FOLLOWING ASSEMBLY
DRAWINGS:

- H2620, COLLIMATOR FOCUS
- H1110, FILTER WHEEL, PRIMARY
- H1324, SLIT
- H1378, SLIT ACCESSORY SERVER
- H6705, COMPARISON SOURCES
- H7100, CCD FOCUS
- H4264, CROSS-DISPERSER DRIVE
- H7512, CCD FOCUS

FULL


KECK/HIRES
COLLIMATOR FOCUS
DRIVE MOTOR

A	14204	14204-B352 WDG#4
B	14204	14204-B352 WDG#4
C	14204	14204-B352 WDG#4
D	14204	14204-B352 WDG#4

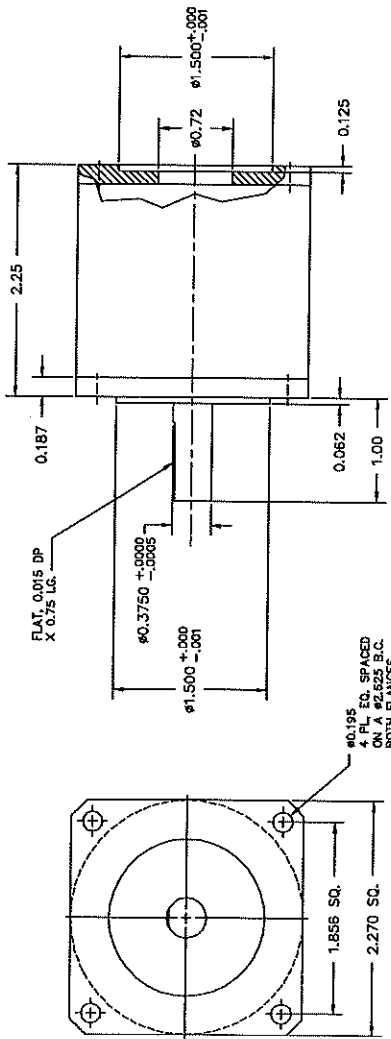


-1 GEARHEAD

1 REQ'D
 PART NO. NE23-05
 RATIO - 5:1
 BAYSIDE CONTROLS, INC.
 20-02 UTOPIA PARKWAY
 WHITESTONE, NEW YORK 11357
 (718) 352-8300
 FAX (718) 353-1398

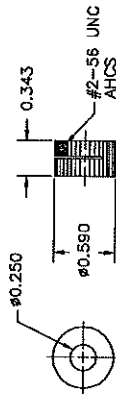

-2 CLAMP-ON GEAR

1 REQ'D
 BAYSIDE CONTROLS, INC.
 20-02 UTOPIA PARKWAY
 WHITESTONE, NEW YORK 11357
 (718) 352-8300
 FAX (718) 353-1398

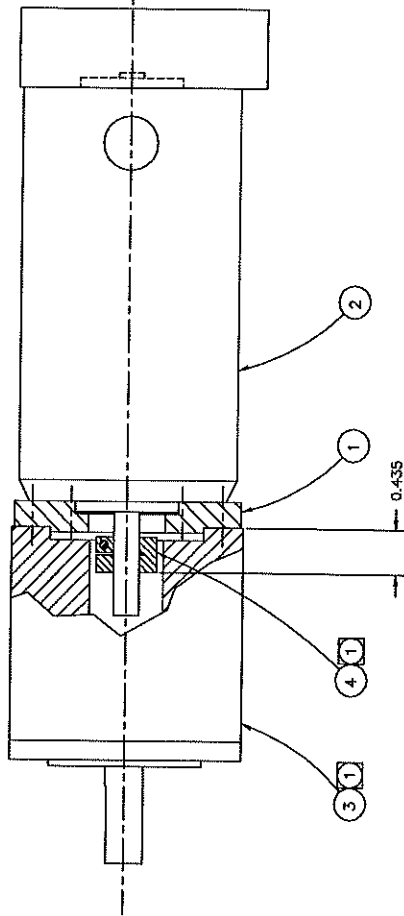

-3 COLLIMATOR FOCUS MOTOR ASSEMBLY

1 REQ'D
 NOTES:
 1 ITEMS 3 & 4 PURCHASED AS A SET.


PROB-2	4	1	CLAMP-ON GEAR
PROB-1	3	1	GEARHEAD ASSY
PROB-4	2	1	MOTOR
PROB-1	1	1	1 GEAR REDUCER, ASPTER ALUM


2/1

KECK/HIRES
 COLLIMATOR FOCUS
 MOTOR DETAILS & ASSEMBLY
 H2660


Appendix D List of Drawings — Echelle Mosaic

1. H3005 Locating Tree
2. H3040 Glue Procedure and Test Assembly
3. H3061 Mosaic Test Setup
4. H3100 Mosaic Assembly on Subplate
5. H3200 Echelle Drive Assembly and Schematic
6. H3240 Echelle Pivot Assembly
7. H3244 Alignment Mirror — Echelle Pivot
8. H3300 Subplate Support, Column
9. H3340 Subplate Support, Lateral Support
10. H3345 Lateral Support Detail
11. H3425 Echelle Grating Blaze Detail
12. H3454 Echelle Grating and Side Pad Assembly
13. H3470 Subplate
14. H3500 Grating Back Support Assembly
15. H3510 Grating Side Support, Type 1
16. H3511 Side Support Detail, Flex Rod
17. H3520 Side Support, Type 2
18. H3600 Echelle Cell Assembly
19. H3603 Testing, Interferometer Layout
20. H3700 Cover Assembly
21. H3703 Air Control Panel
22. H3801 Subplate Finite Element Analysis Results
23. H7300 Encoder Assembly and Drive
24. H7330 Limits, Drive

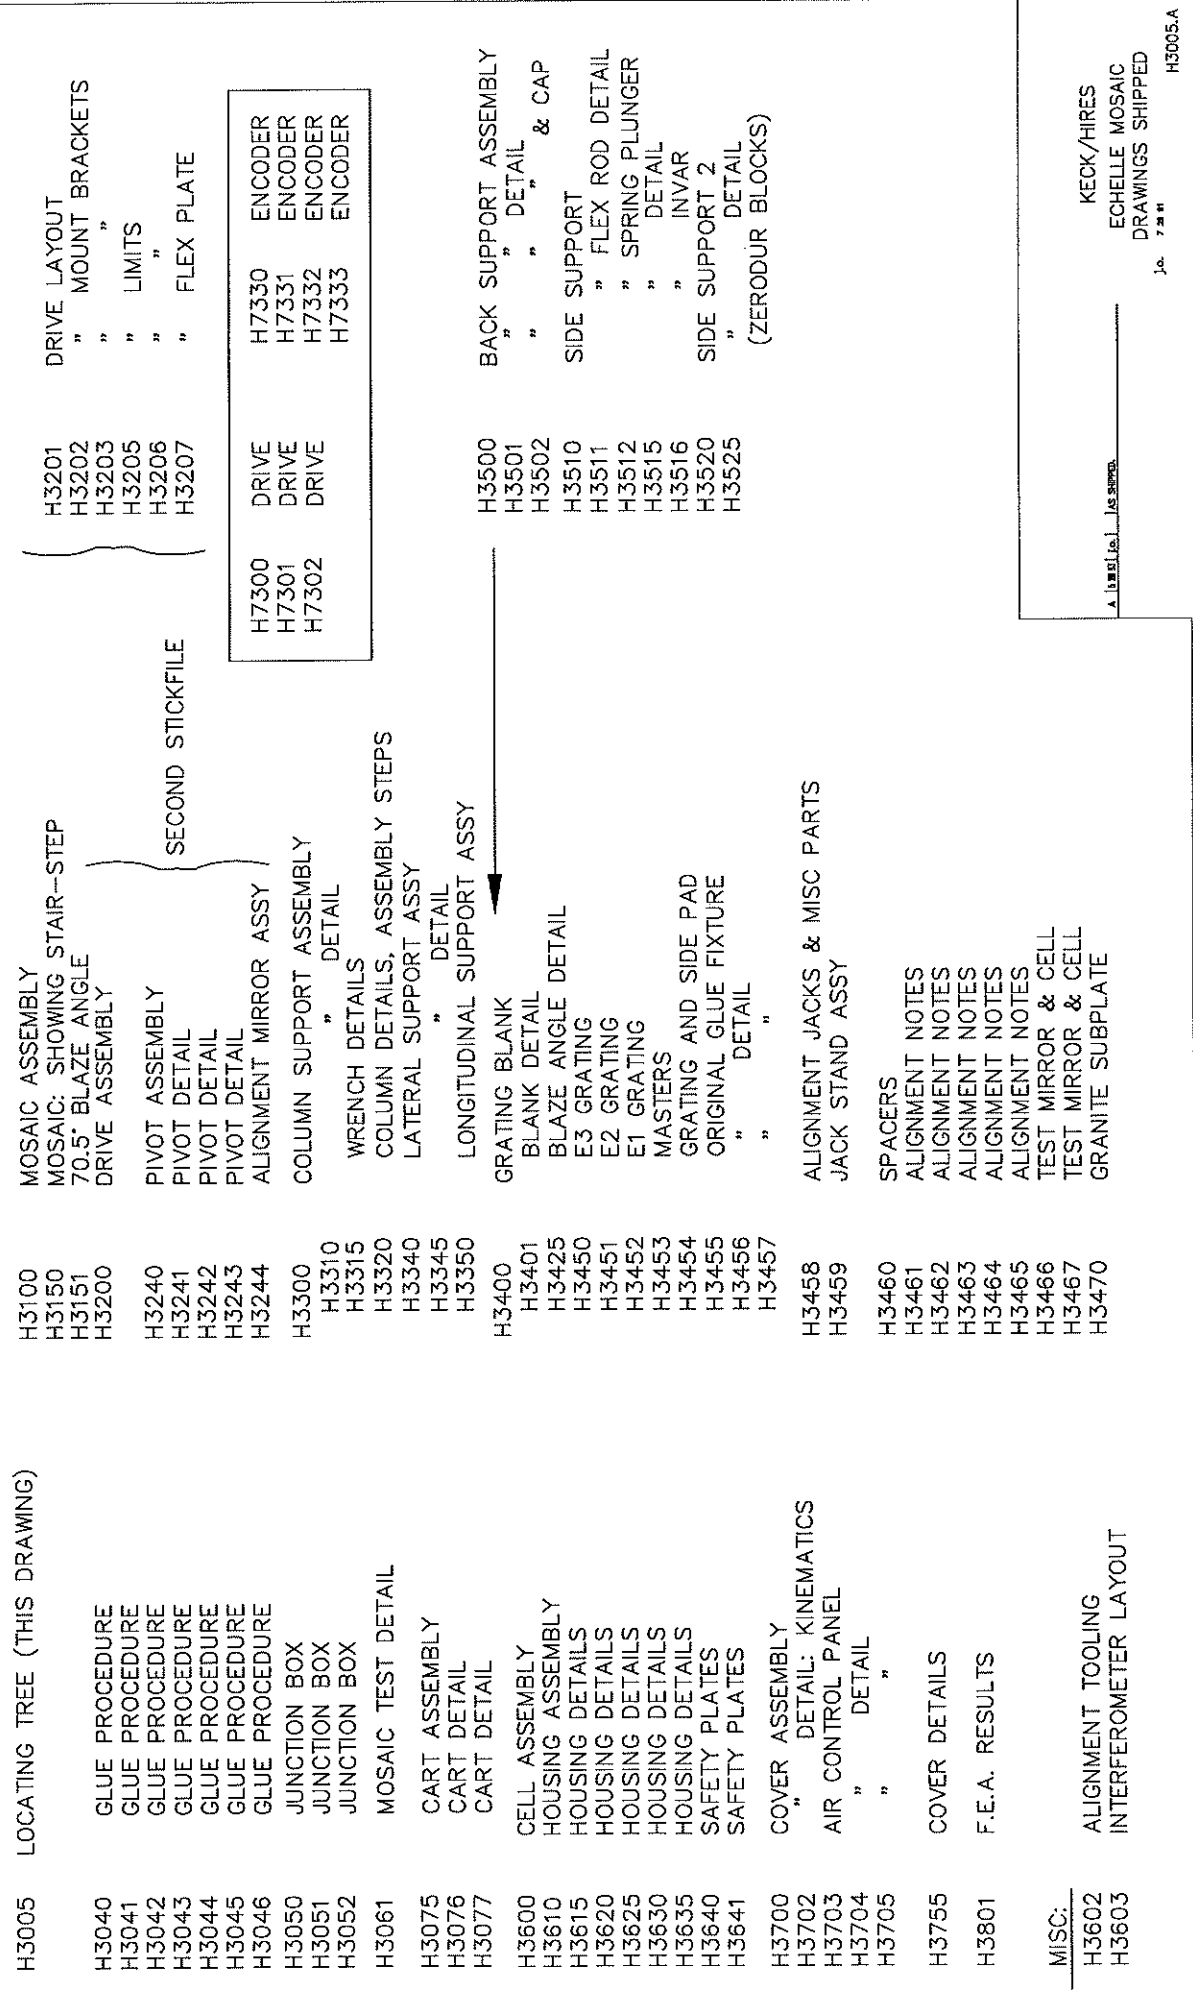

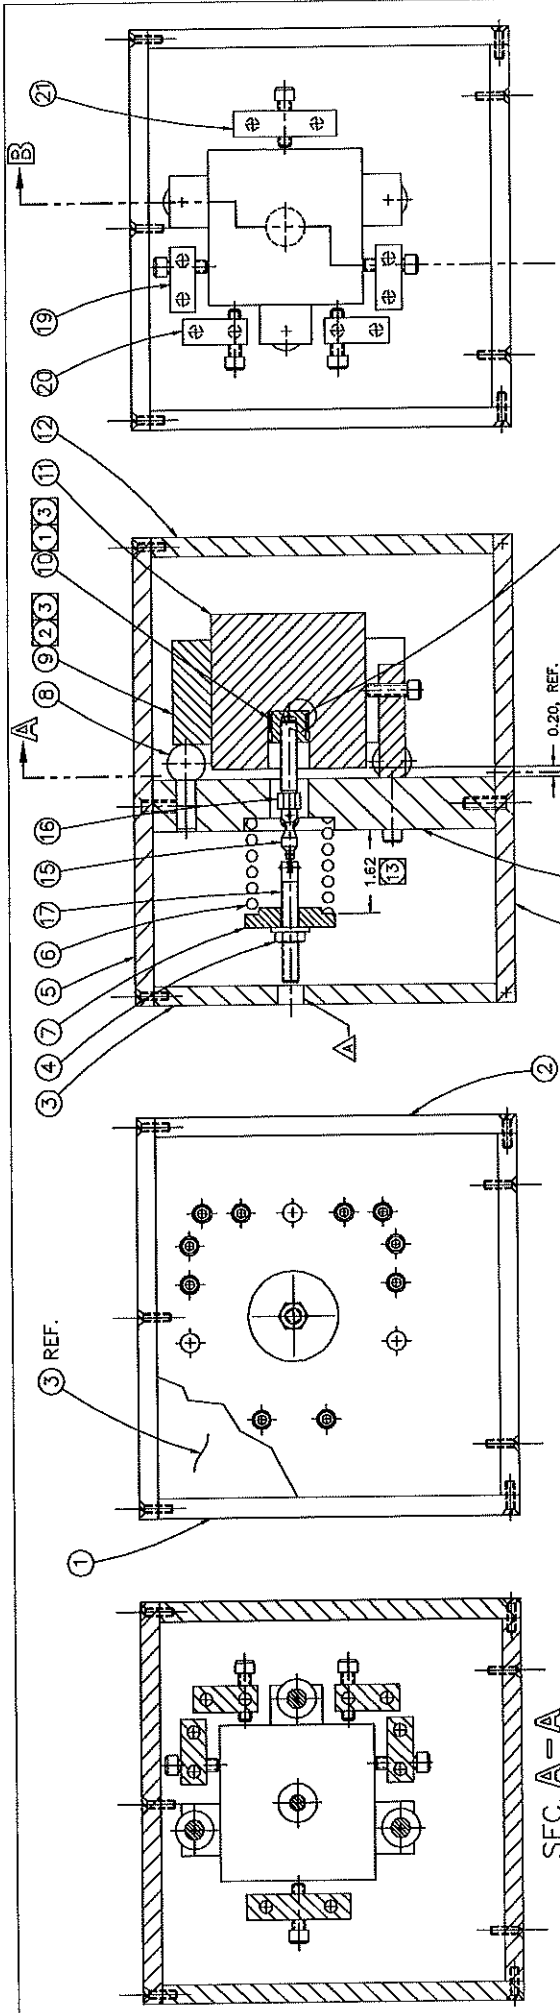

1	LOCATOR	2	ALUM
2	LOCATOR	3	ALUM
3	LOCATOR	4	ALUM
4	LOCATOR	5	ALUM
5	LOCATOR	6	ALUM
6	LOCATOR	7	ALUM
7	LOCATOR	8	ALUM
8	LOCATOR	9	ALUM
9	LOCATOR	10	ALUM
10	LOCATOR	11	ALUM
11	LOCATOR	12	ALUM
12	LOCATOR	13	ALUM
13	LOCATOR	14	ALUM
14	LOCATOR	15	ALUM
15	LOCATOR	16	ALUM
16	LOCATOR	17	ALUM
17	LOCATOR	18	ALUM
18	LOCATOR	19	ALUM
19	LOCATOR	20	ALUM
20	LOCATOR	21	ALUM

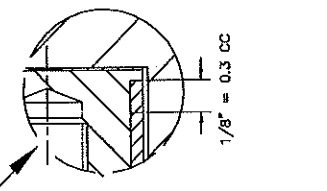

TEST BLOCK
 1 REQ'D
 STORE IN A MARKED BOX INSIDE HIRES
 LABEL:
 HIRES TEST INSERT
 AND SIDE BLOCKS
 JULY, 1991

GENERAL NOTES:
 10. GLUE GAP IS TO BE 0.010" THICK;
 USE 1/80 PAD(S) OF EPOXY ON BOTTOM OF PART.
 11. REFERENCE: KECK OBSERVATORY PMSS
 BY ANDY DUBOIS DATED 11/26/90
 "EPOXY BONDS FOR SEGMENT INSERTS"
 12. SOLVENT IS METHYLENE CHLORIDE
 13. SPRING DATA:
 LEE SPRING #LHC-218T-1
 K = 228 LBS/INCH
 2.5" = 0 LBS
 2.123" = 86 LBS (LONG TERM TEST)
 1.62" = 200 LBS
 1.42" = SOLD HEIGHT
 0.2168" WIRE
 14. SWIVEL: SEE H3500 FOR DETAIL.
 15. HYSOL EA9313 EPOXY RESIN
 VENDOR: EV ROBERTS & ASSOC.
 8500 STELLER
 CULVER CITY, CA 90232
 (213) 870-9561


PROCEDURE NOTES:
 1. CLEANING PROCEDURE - INVAR:
 ACETONE WASH, BEADELAST DRY
 NITROGEN CLEAN AND ALCOHOL RINSE.
 2. CLEANING PROCEDURE - ZERODUR:
 DIAMOND TOOL BORING IS FOLLOWED BY
 3-DAY AMMONIUM BIFLUORIDE ETCH, THEN
 WATER RINSE AND ALCOHOL RINSE.
 3. GLUING PROCEDURE:
 A. HYSOL EA9313 MIXED 4:1 BY
 WEIGHT OR 3.5:1 BY VOLUME IN
 A CLEAN PLASTIC CONTAINER.
 B. USE A 1 CC SYRINGE AND
 PRE-DEPOSIT 0.3 CC IN HOLE.
 C. INSERT IS PLACED WITH 2 TFE GUIDES
 D. CURE TIME IS 5 DAYS AT 75F.
 4. TEST AT 5X DESIGN LOAD (200 LBS)
 USE A BUCKET WITH 200 LBS LEAD SHOT
 SPRING LOAD.
 5. STORE AT 2X DESIGN LOAD (86 LBS)
 6. DESIGN LOAD FOR INSERT IS 43 LBS

KECK/HIRES
ECHELLE GLUE PROCEDURE
AND TEST BLOCK
 1A 7 2 8 8
 H3040.A

FULL
 A. 13449 [Pa.] UPDATE AND NOTES 3 DAY WAS 3 DAY



USEABLE TEMP. RANGE: ROOM TEMP TO -40F.
 HUMIDITY AND CONDENSATION TOLERANT.
 5 DAY CURE AT 75F/A

POT LIFE 60 MIN.
 TENSILE STRENGTH 6300 PSI
 SHEAR STRENGTH 4000 PSI

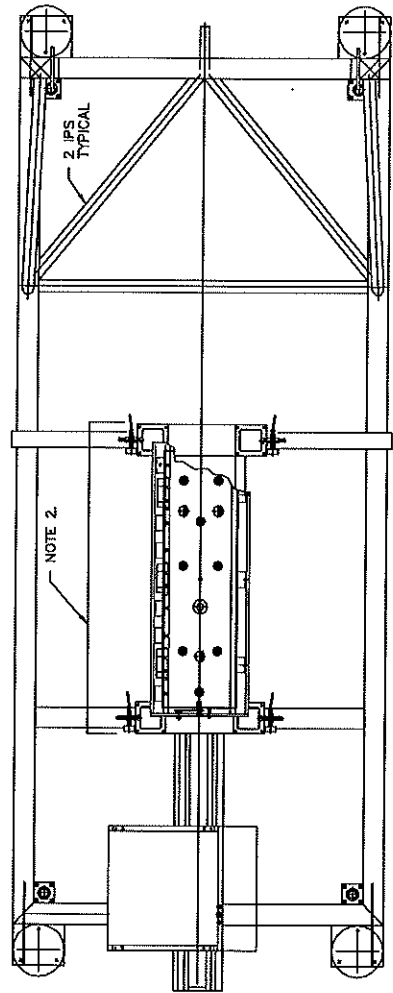

SYM	QTY	DESCRIPTION	UNIT
KTB-1	16	SUPPORT POST	ASST
KTB-1	14	LASER SUPPORT	ASST
KTB-1	12	INTERFEROMETER	NOTE 3
KTB-2	1	ADAPTER	NOTE 2
KTB-2	1	ADAPTER	NOTE 2
NEWPART	9	TABLE & SUPPORT	NOTE 2
KTA-1	7	TABLE & SUPPORT	NOTE 2
KTA-1	4	FOOT SUPPORT WEB	NOTE 2
KTA-1	6	SUPPORT WALK	NOTE 4
KTA-1	5	SCHEDULE MOSAIC	NOTE 4
KTA-1	4	MIRROR AND CELL	NOTE 4

THIS STRUCTURE WAS USED FOR TESTING THE KECK SECONDARY MIRROR. Δ

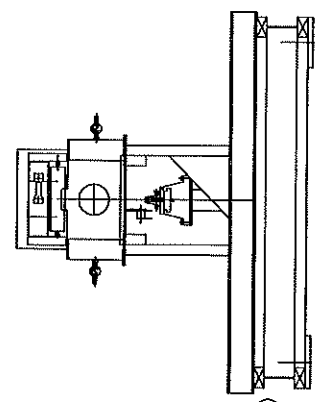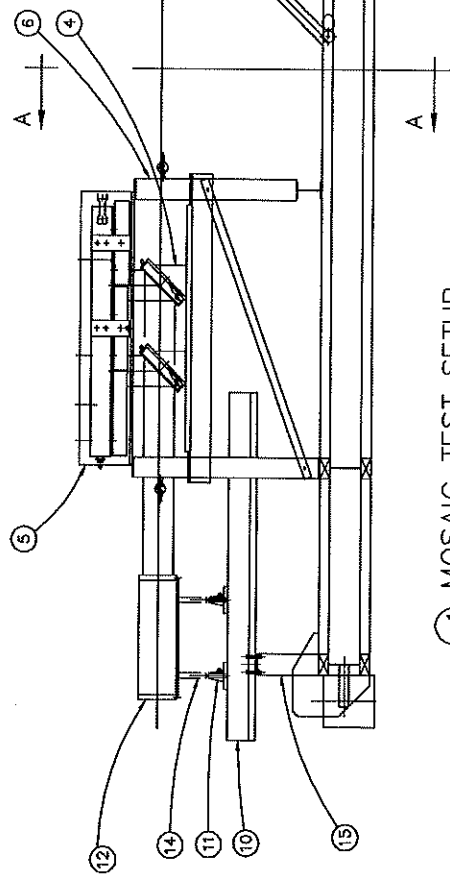

SEC A-A

MOSAIC TEST SETUP

SIMILAR TO DRAWING KTI

NOTES:

- Δ 1. SUPPORT JACKS RESTED ON 1" THICK POLYETHYLENE PLATE. 2 FLUORESCENT LIGHT FIXTURES WERE ARRANGED BELOW THIS PLATE. THE PNEUMATIC-TIRED DOLLY SUPPORTED THE LIGHTS AND PLASTIC PLATE.
- Δ 2. AN OUTRIGGER WAS ARRANGED SO THAT THE GRATINGS COULD BE MOVED OUT FROM UNDER THE CELL ON THE LAB JACKS.
- Δ 3. SEE ALSO H3603 FOR TILTED MOSAIC (10.5')


1/10

A. HUBBARD [Signature] [Date]

KECK/HIRES
MOSAIC TEST SETUP
DETAILS

J.C. 10 3 78


H3061.A

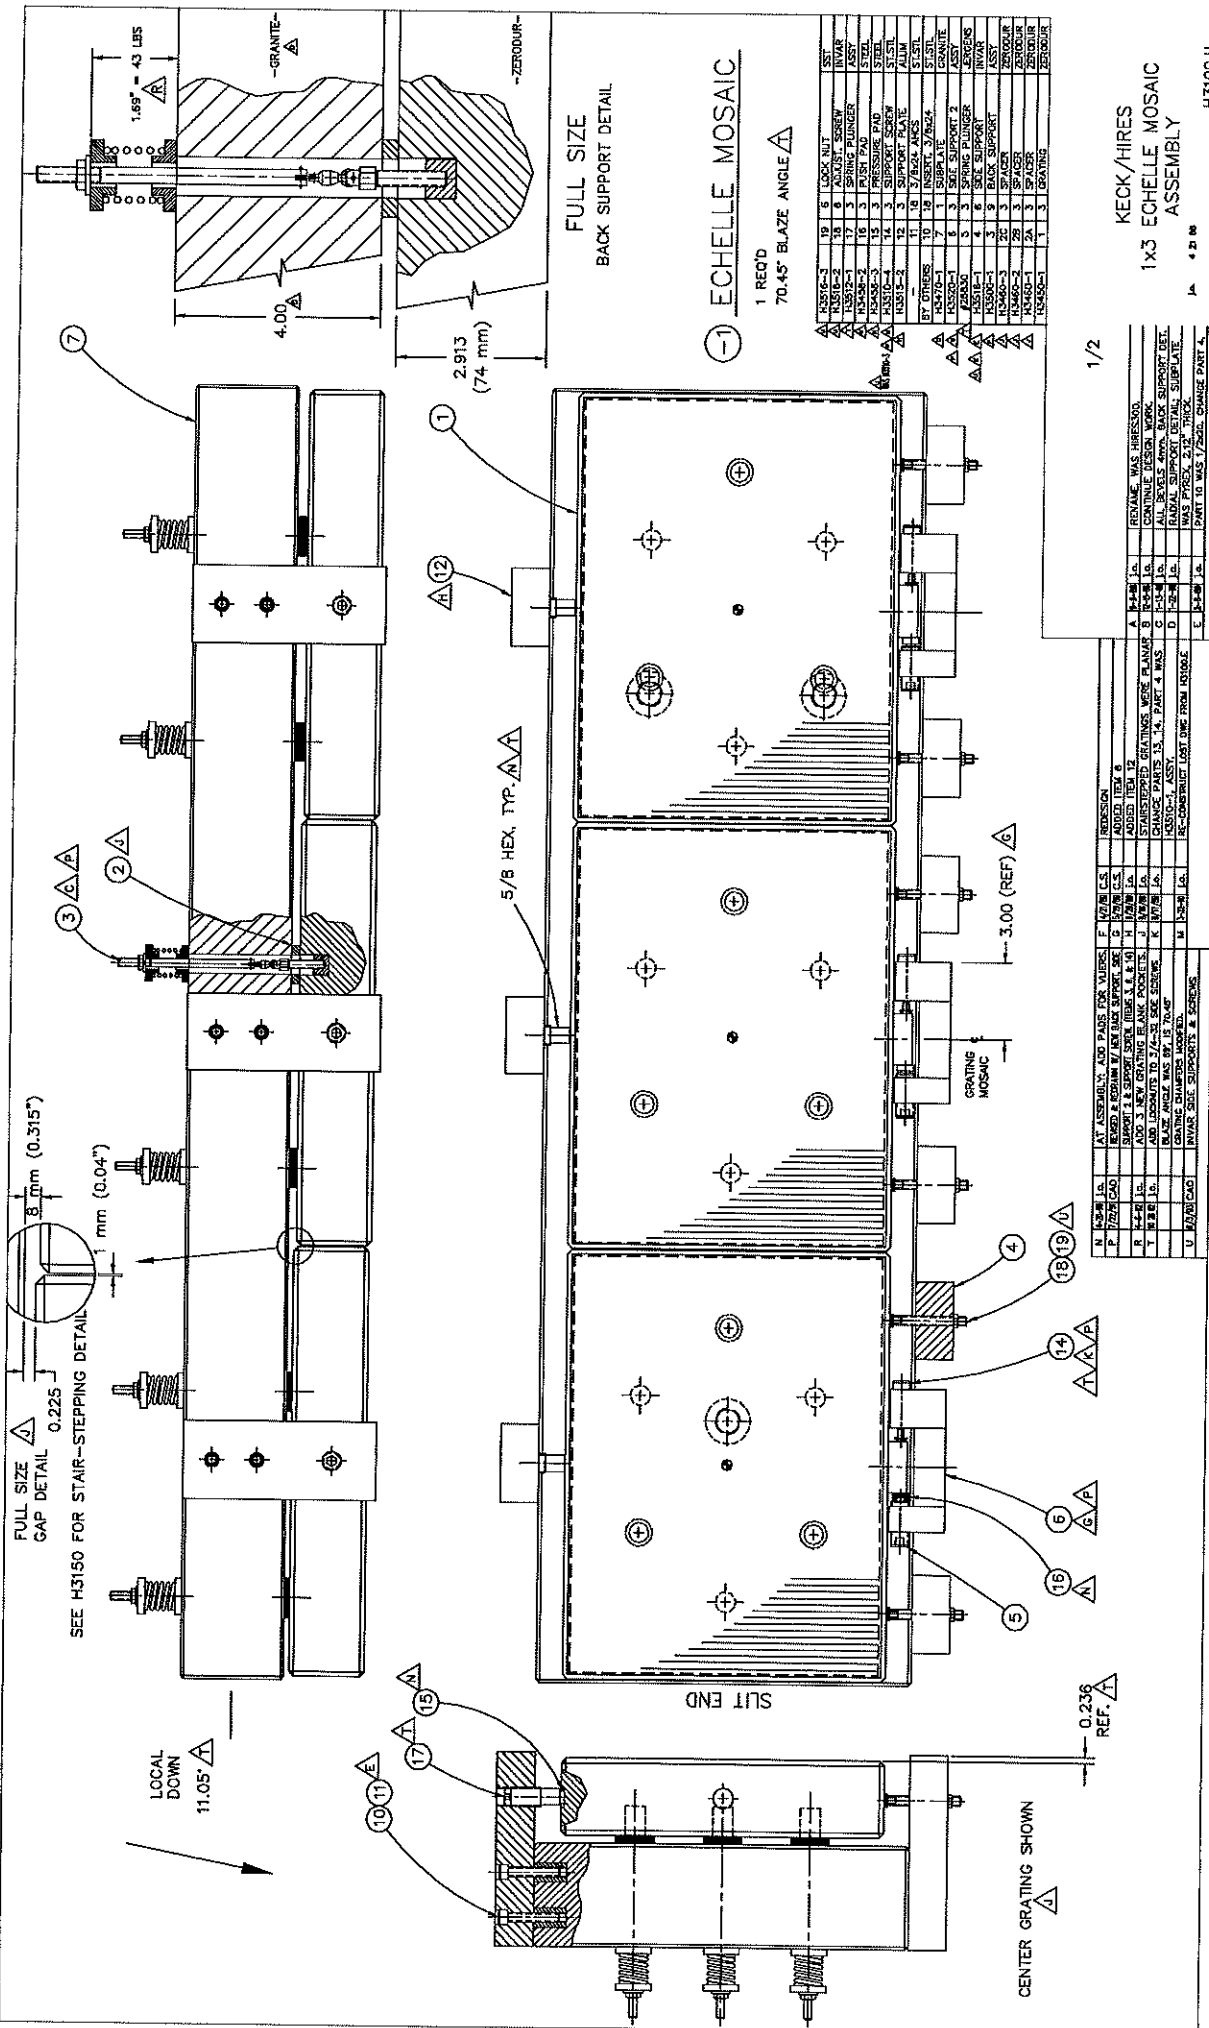

19	6	LOCK NUT	SST
18	1	WASHER	INVAR
17	3	SPRING BUSHING	STAINLESS
16	3	PLUSH PAD	STEEL
15	3	PRESSURE PAD	STEEL
14	3	SUPPORT SCREW	ST-STEEL
13	3	3/16" ALUM. PLATE	ALUM.
12	3	3/16" ALUM. PLATE	ALUM.
11	3	3/16" ALUM. PLATE	ALUM.
10	18	INSERT, 3/16" DIA.	STAINLESS
9	1	SUBPLATE	GRANITE
8	3	SPACER	GRANITE
7	3	SPACER	GRANITE
6	3	SPACER	GRANITE
5	3	SPACER	GRANITE
4	3	SPACER	GRANITE
3	3	SPACER	GRANITE
2	3	SPACER	GRANITE
1	3	SPACER	GRANITE

N	10-28	10	AT ASSEMBLY, ADD PAIRS FOR MIRRORS	E	1/2" IN U.S.	REVISION
P	1/2" IN U.S.	6	REMED & REDRAW BY NEW BACK SUPPORT, SEE	F	1/2" IN U.S.	ADDED ITEM 6
R	1/2" IN U.S.	12	ADDED ITEM 12	G	1/2" IN U.S.	ADDED ITEM 12
S	1/2" IN U.S.	12	ADDED ITEM 12	H	1/2" IN U.S.	ADDED ITEM 12
T	1/2" IN U.S.	12	ADDED ITEM 12	I	1/2" IN U.S.	ADDED ITEM 12
U	1/2" IN U.S.	12	ADDED ITEM 12	J	1/2" IN U.S.	ADDED ITEM 12
				K	1/2" IN U.S.	ADDED ITEM 12
				L	1/2" IN U.S.	ADDED ITEM 12
				M	1/2" IN U.S.	ADDED ITEM 12
				N	1/2" IN U.S.	ADDED ITEM 12
				O	1/2" IN U.S.	ADDED ITEM 12
				P	1/2" IN U.S.	ADDED ITEM 12
				Q	1/2" IN U.S.	ADDED ITEM 12
				R	1/2" IN U.S.	ADDED ITEM 12
				S	1/2" IN U.S.	ADDED ITEM 12
				T	1/2" IN U.S.	ADDED ITEM 12
				U	1/2" IN U.S.	ADDED ITEM 12

KECK/HIRES
 1x3 ECHELLE MOSAIC
 ASSEMBLY

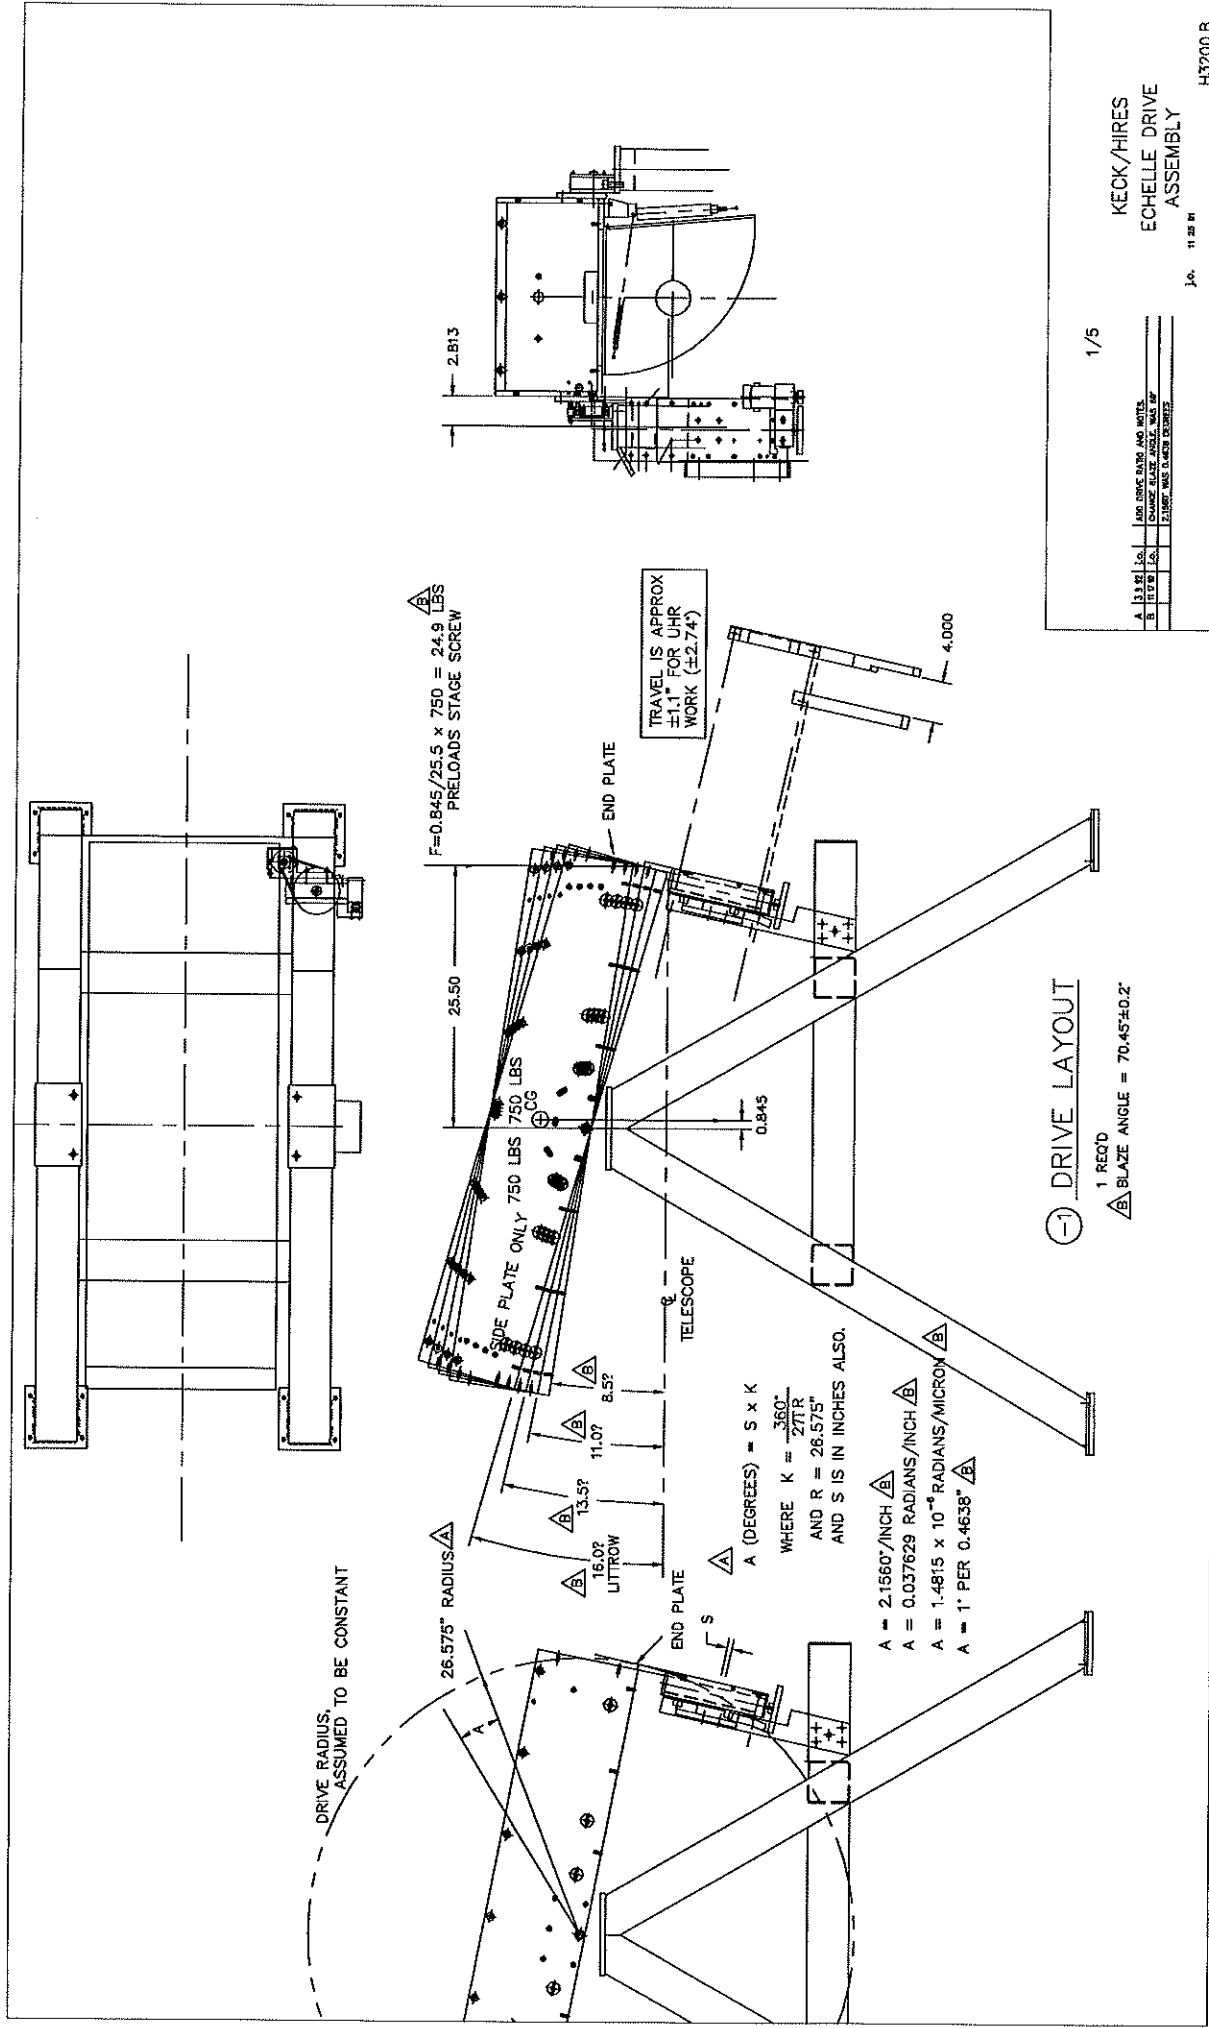

DRIVE RADIUS, ASSUMED TO BE CONSTANT

F=0.845/25.5 x 750 = 24.9 LBS
PRELOADS STAGE SCREW

TRAVEL IS APPROX ±1.1\"/>

A (DEGREES) = S x K
WHERE $K = \frac{360}{2\pi R}$
AND R = 26.575"
AND S IS IN INCHES ALSO.

- A = 2.1560"/INCH Δ
- A = 0.037629 RADIANS/INCH Δ
- A = 1.4815 x 10⁻⁶ RADIANS/MICRON Δ
- A = 1" PER 0.4638" Δ

(-1) DRIVE LAYOUT
1 REQD
 Δ BLAZE ANGLE = 70.45±0.2


1/5

KECK/HIRES
ECHELLE DRIVE
ASSEMBLY

A	13.42	1.00	DRIVE SHAFT AND NUTS
B	10.00	1.00	CHANGE BLAZE ANGLE, WAS 80°
			FLIGHT WAS 0.4638" DISTANCE

J.C. 11-28-71




H5200.B

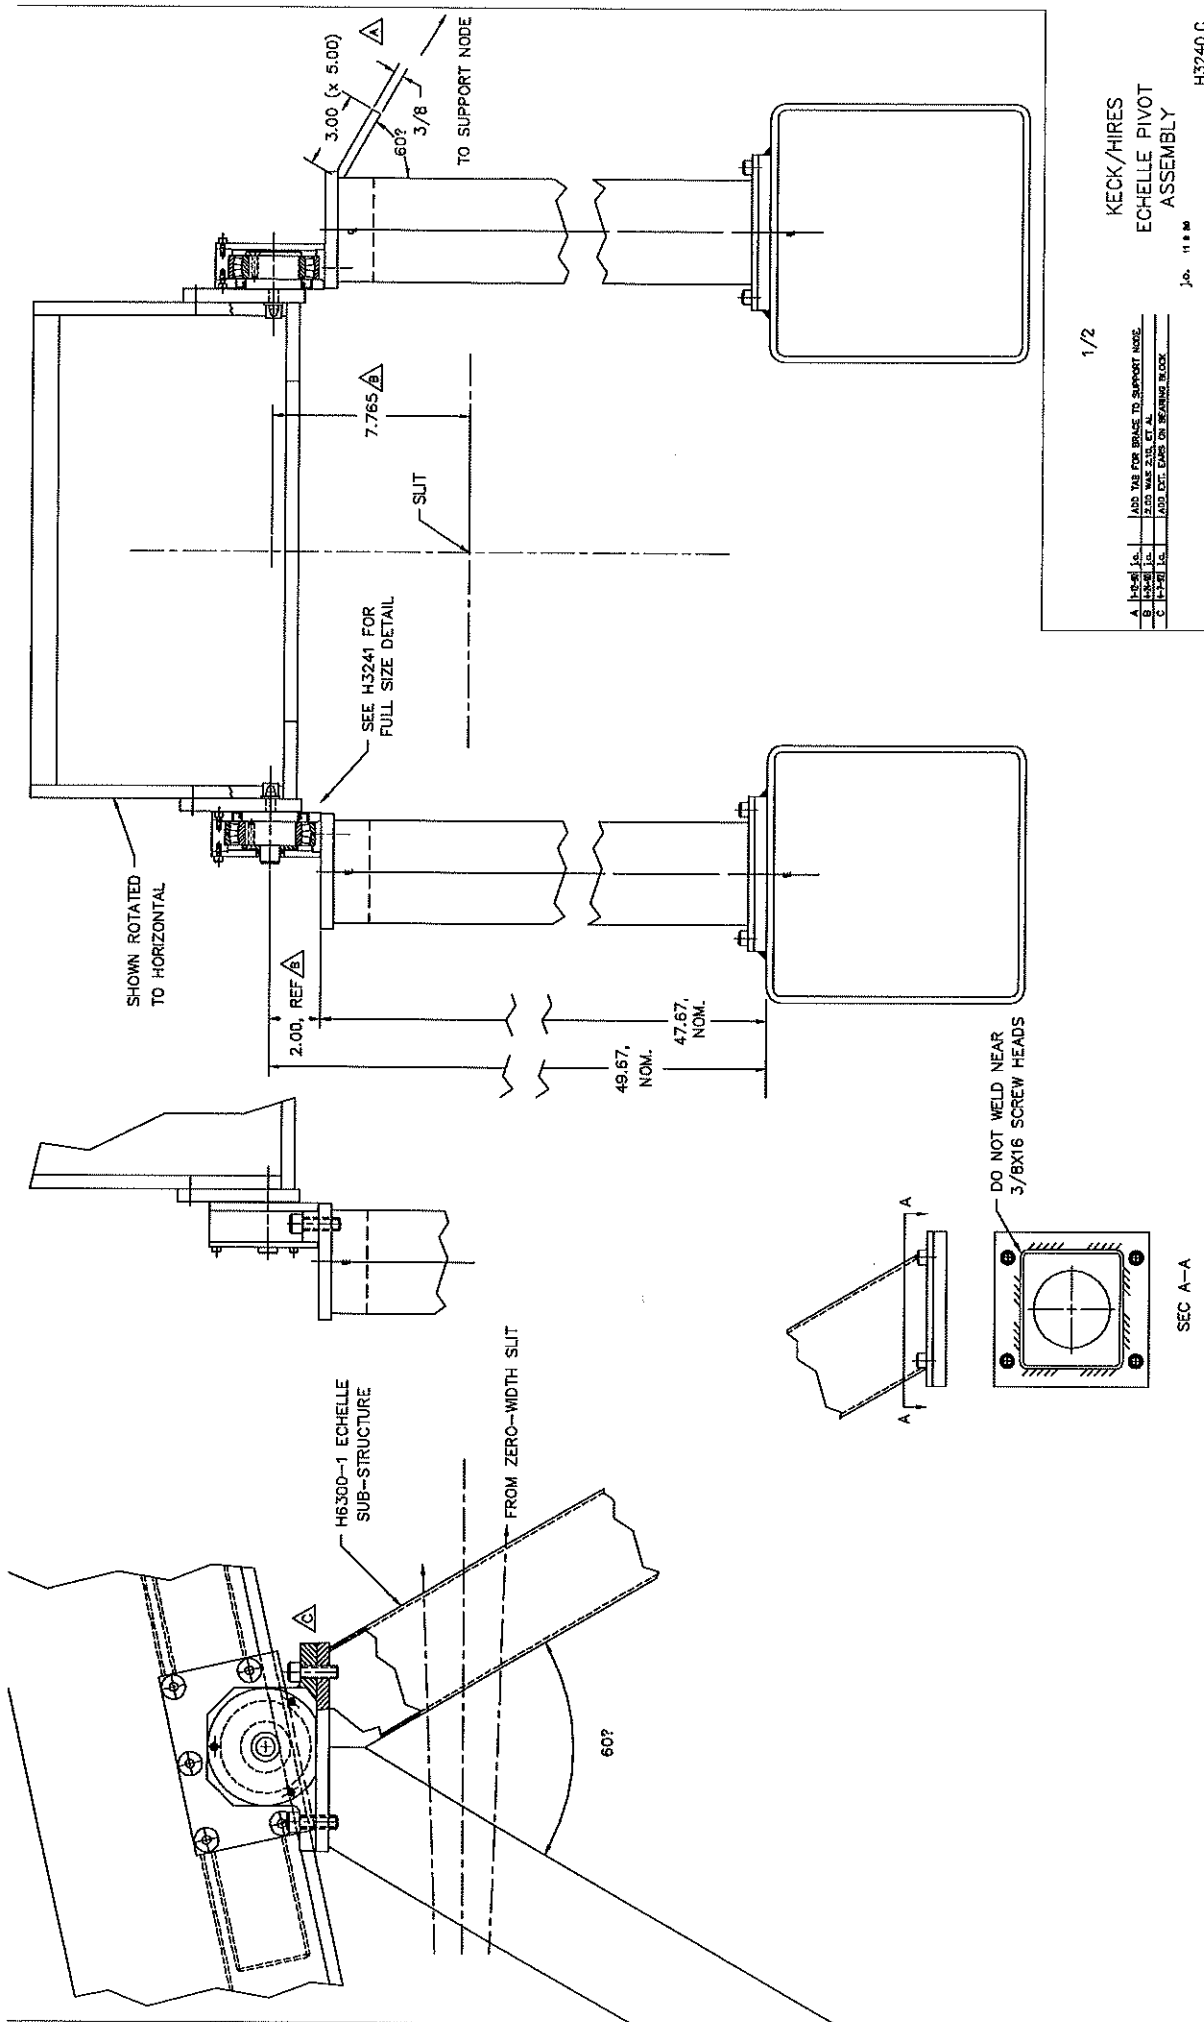

A	1/2" Lg.	ADD 1/2" FOR BRASS TO SUPPORT NODE.
B	1/2" Lg.	ADD 1/2" FOR BRASS TO SUPPORT NODE.
C	1/2" Lg.	ADD EXT. BRASS TO BEARING BLOCK.

KECK/HIRES
 ECHELLE PIVOT
 ASSEMBLY
 Job. 1181M

H3240.C

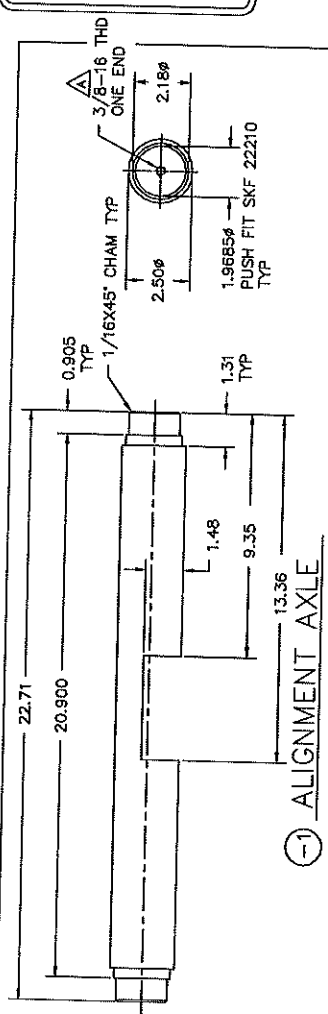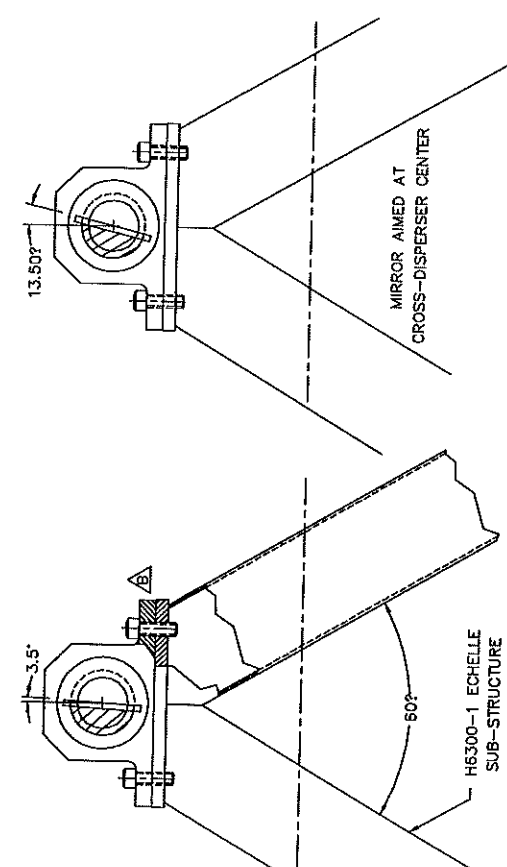
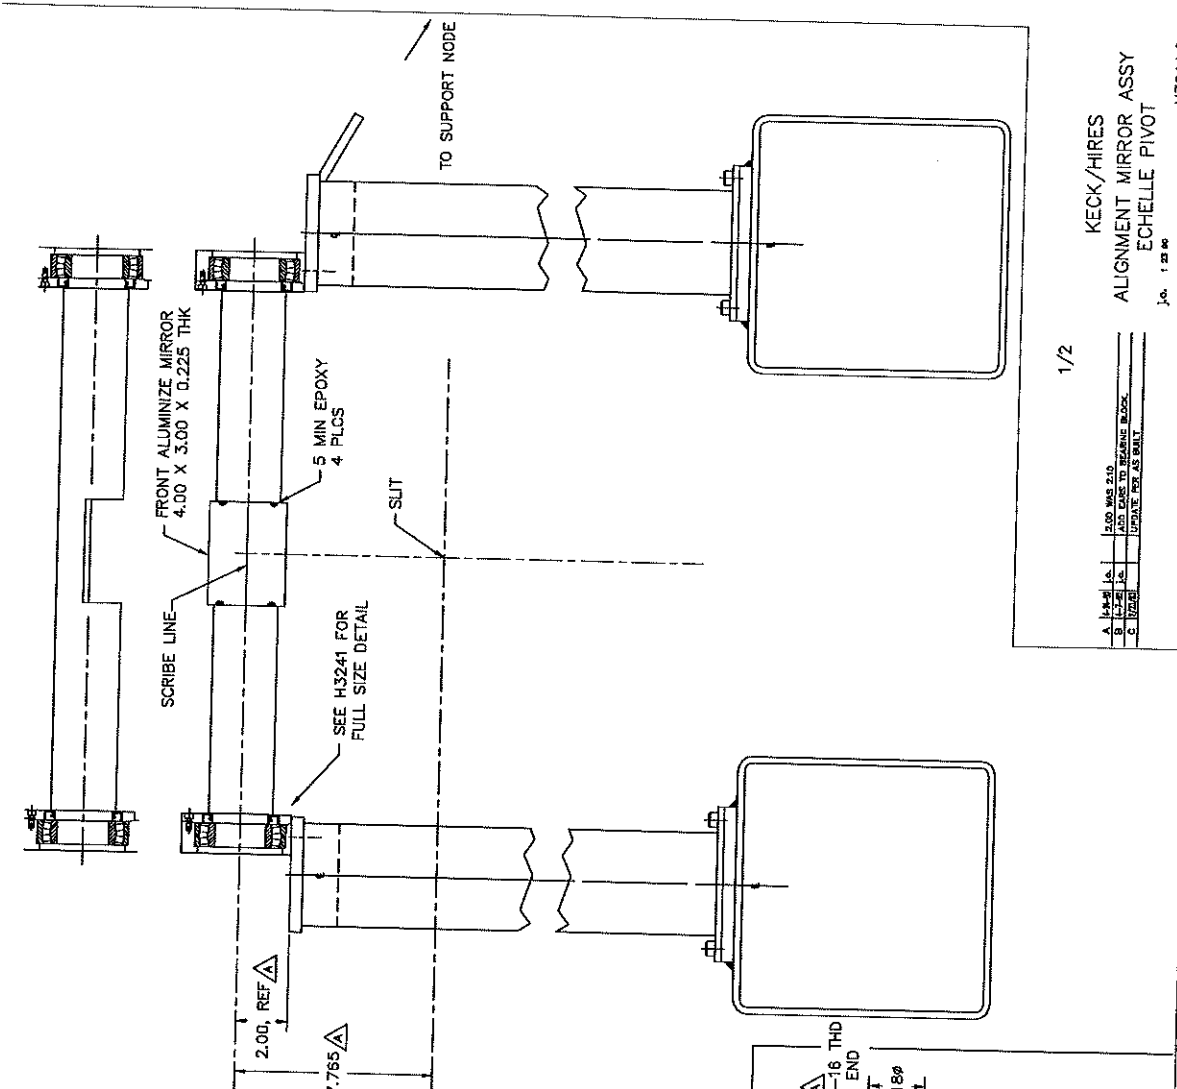


1 REQ'D
 ALUM 6061-T6 2.5φ
 NOTE: NOTCH IS TO FIT FLAT
 MIRROR WHICH IS 0.225 THK

1/2

KECK/HIRES
 ALIGNMENT MIRROR ASSY
 ECHELLE PIVOT
 J.A. 1 28 86
 H3244.C

A	1.4.86	J.A.	2.00 WAS 2.10
B	1.7.86	J.A.	ADD PART TO BEARING BLOCK
C	1.22.86	J.A.	UPDATE FOR AS BUILT

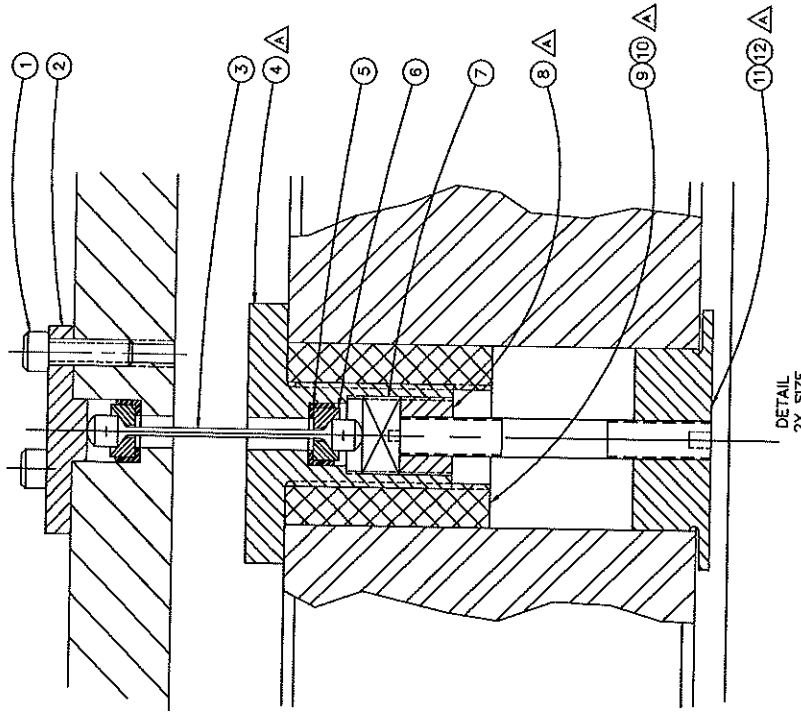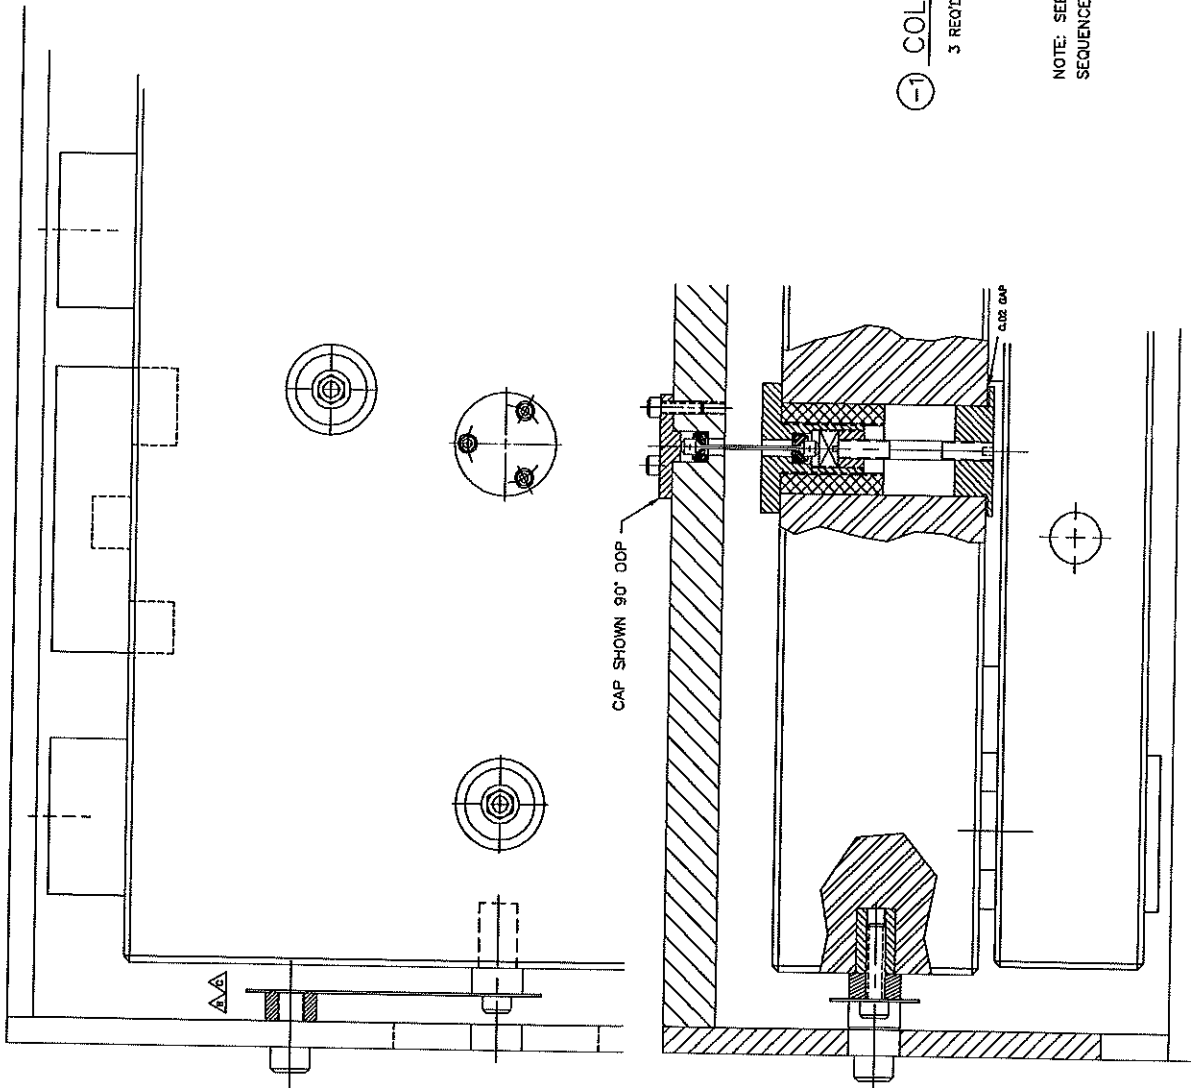

① COLUMN SUPPORT
3 REVD

ASSTG-3	12	1	17/32" x 1/2" STUD	ST. STL.
ASSTG-5	12	1	1/2" x 1/2" NUT	ST. STL.
BY OTHERS	10	1	1/4" x 1/2" INSERT	ST. STL.
ASSTG-4	9	1	1/2" x 1/2" LOCK	ST. STL.
ASSTG-3	7	1	1/2" x 1/2" PLUG COLLAR	17-4-PR
ASSTG-2	6	2	1/2" x 1/2" WASHER	17-4-PR
H3320-2	4	1	1/2" x 1/2" HEADER	ST. STL.
H3320-1	3	1	1/2" x 1/2" COLUMN	17-4-PR
H3320-1	2	1	1/2" x 1/2" CAP	ST. STL.
H3320-1	1	3	1/2" x 1/2" RISE	ST. STL.








NOTE: SEE H3320 FOR ASSEMBLY SEQUENCE.

FULL

KECK/HIRES
ECHELLE SUBPLATE
COLUMN SUPPORT

H3300.D

A	1-2-3	JA	MODIFY PARTS 4,8,11 FOR INSERT.
B	1-2-3	CS	LINK RESPONSIBLE FOR DESIGN REVIEW.
C	1-2-3	JA	STA WAS UPZ TO AS-BUILT CONDN.
D	1-2-3	JA	SEPARATE CROSS-DISPOSED SUPPORT.

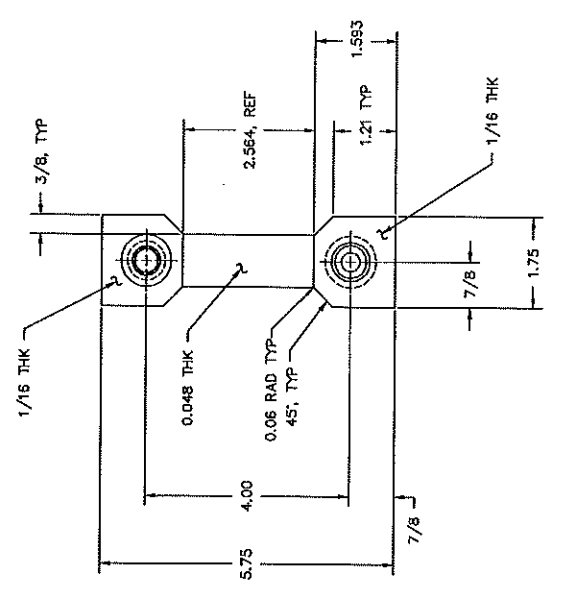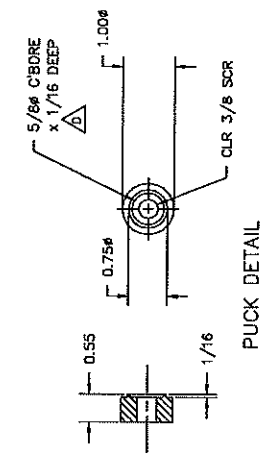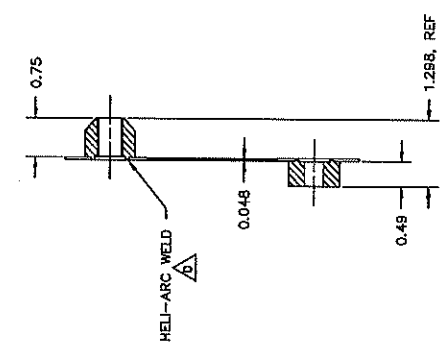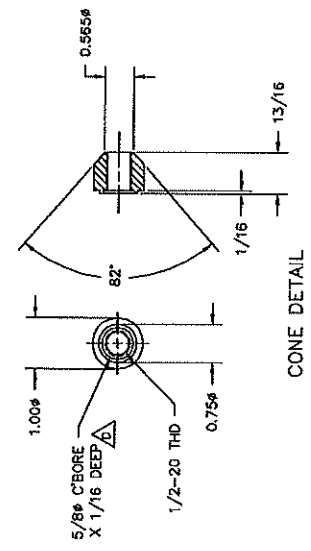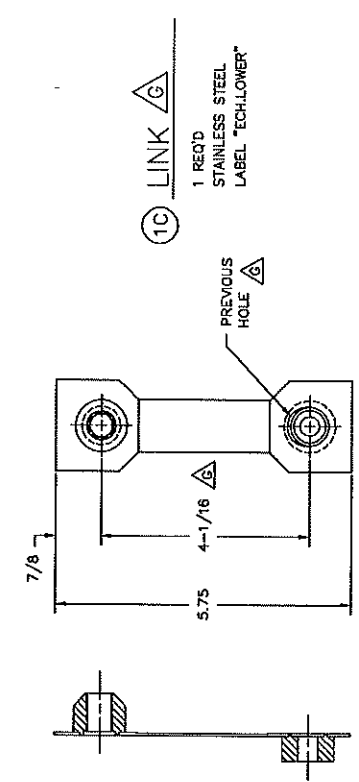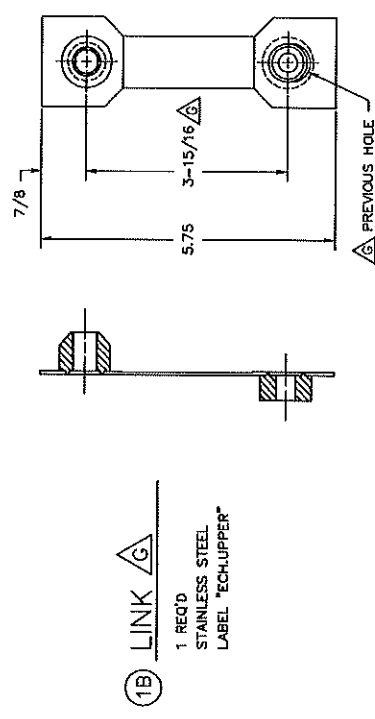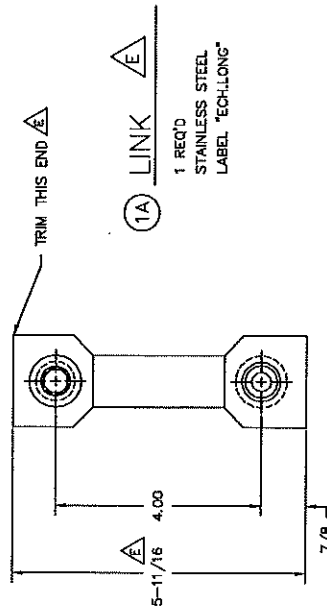


LINK $\triangle G$

3 REQ'D FOR ECHELLE: MODIFIED $\triangle A$ $\triangle G$
3 REQ'D FOR CROSS-DISPERSER
STAINLESS STEEL


FULL

A	1-1-81	J.A.	3 REQ WAS OK
B	1-1-81	J.A.	CONSOLE BY DESIGN REVIEW
C	1-1-81	J.A.	REDRAWN LINK AND PART - 2
D	1-1-81	J.A.	WELD LINK WAS NEVER SOLDER
E	1-1-81	J.A.	DOT AND LABEL ONE LINK "ECH-LONG"
F	1-1-81	J.A.	UPDATE PER DESIGN REVIEW 3/90

KECK/HIRES
ECHELLE SUBPLATE
LATERAL SUPPORT DETAIL
1-1-81
H3345.G

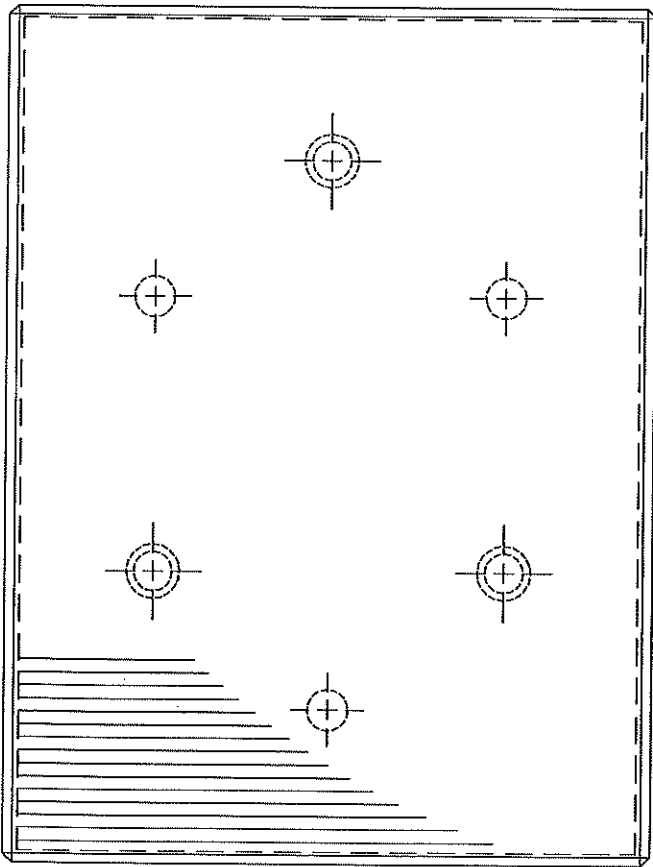


VIEW LOOKING AT RULED SURFACE

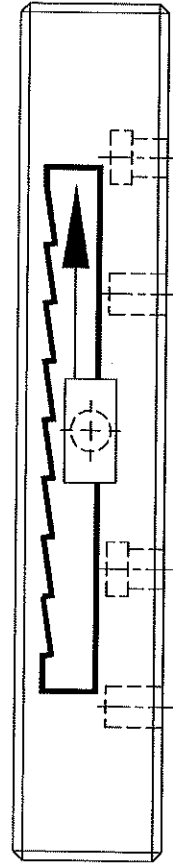

MARKINGS ON SURFACE "A"

$$\text{DEPTH} = \text{PITCH} \cdot \sin 19.55^\circ \cdot \cos 19.55^\circ = 0.0002336$$

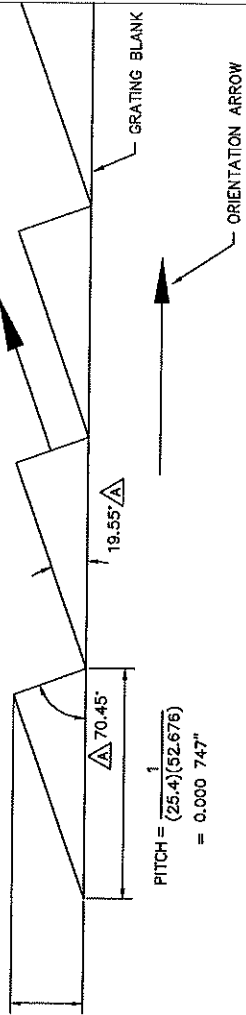

① BLAZE DETAIL

CORE VERSION OF HIRES NOTES:




1. 52.676 LINES/mm
2. BLAZE ANGLE IS 70.45° (6238 Å)
3. R-2.6 ECHELLE GRATING




FULL

KECK/HIRES
GRATING BLAZE
ECHELLE


H3425.A

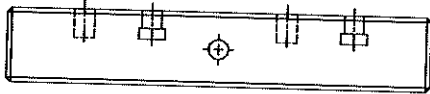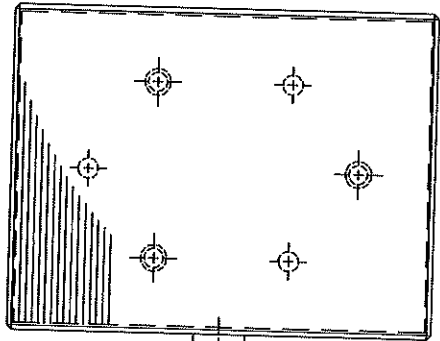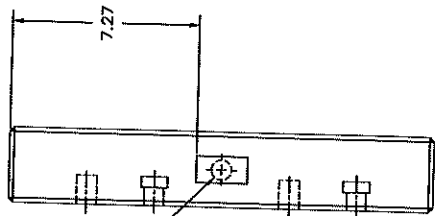


TOP VIEW
RULING SURFACE

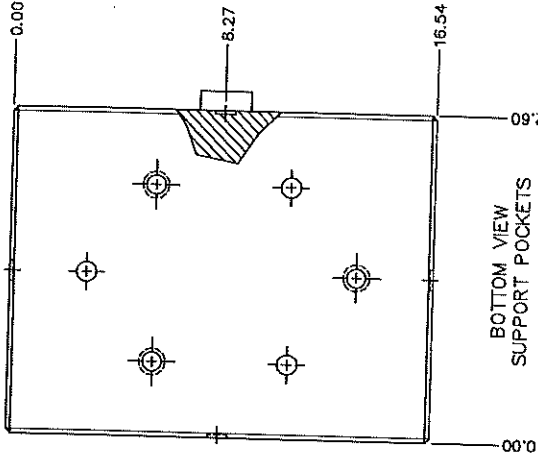

BOTTOM VIEW
SUPPORT POCKETS

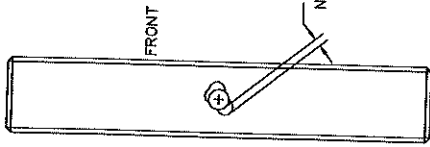

SIDE VIEW
BEFORE GLUEING

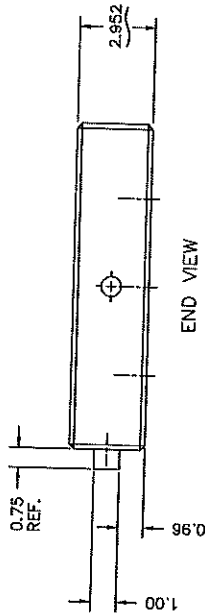

END VIEW

⊖ GRATING AND PAD ASSEMBLY

3 REVD

NOTES:



1. ZEROOUR PADS ARE H3525-2
2. GRATING E3 SHOWN. SEE H3450.1,2 FOR OTHER GRATING DETAILS.
3. GLUE NOTES ON H3040.A; HYSOL EA 9313 EPOXY RESIN; 5 DAY CURE TIME.
4. FILL POCKET WITH RTV BEFORE GLUEING.

1/2

A. 1.5.81 [s.] TIME CHANGE


KECK/HIRES
EHELLE GRATING
AND PAD ASSEMBLY

H3454.A

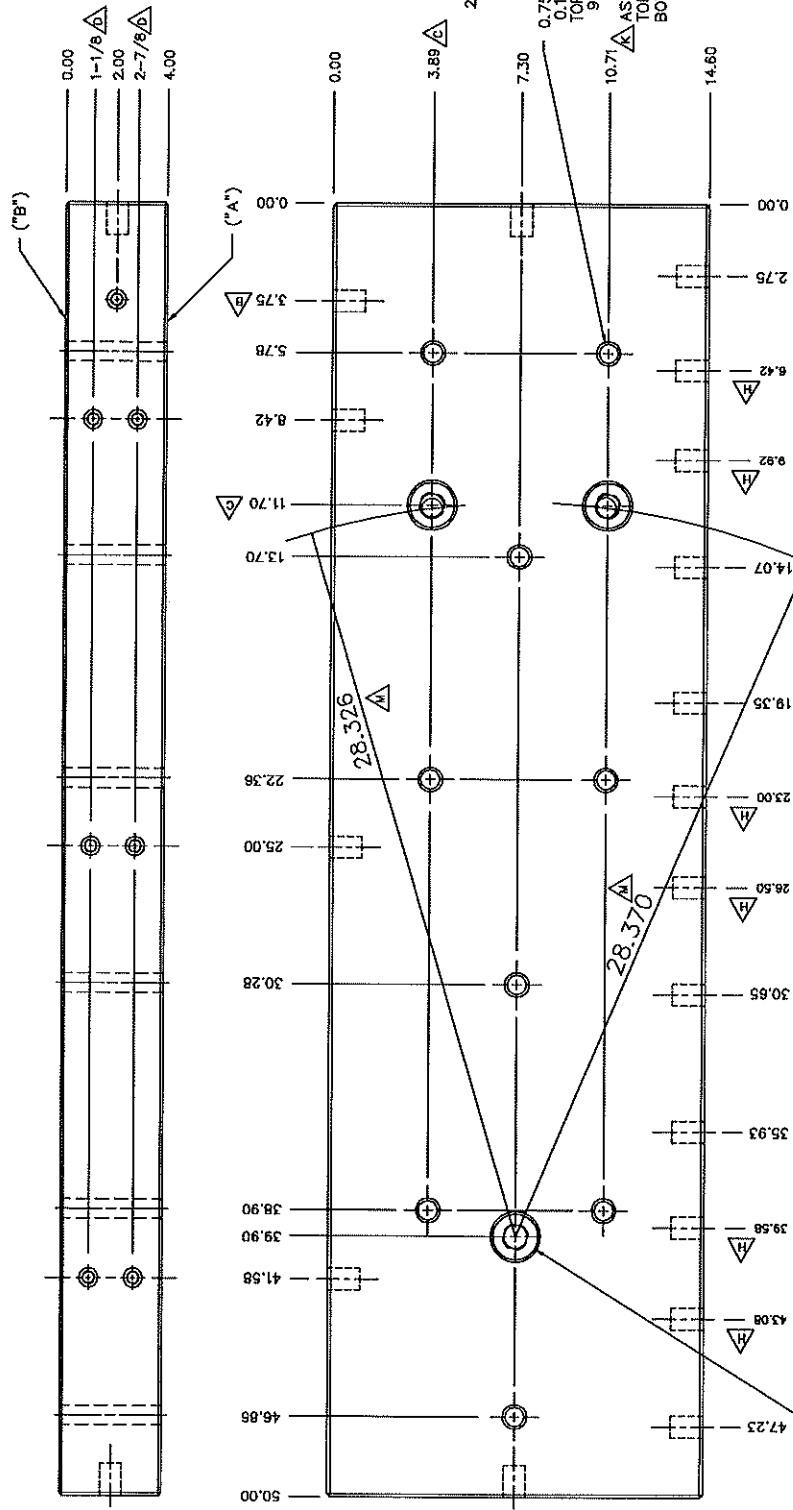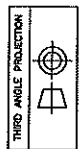

VIEW OF GRATING MOUNTING SURFACE - "A"

1-7/8" THRU &
1x14 THREADED
INSERT, 3 PLCS
GLUE GAP ABOUT 0.008"

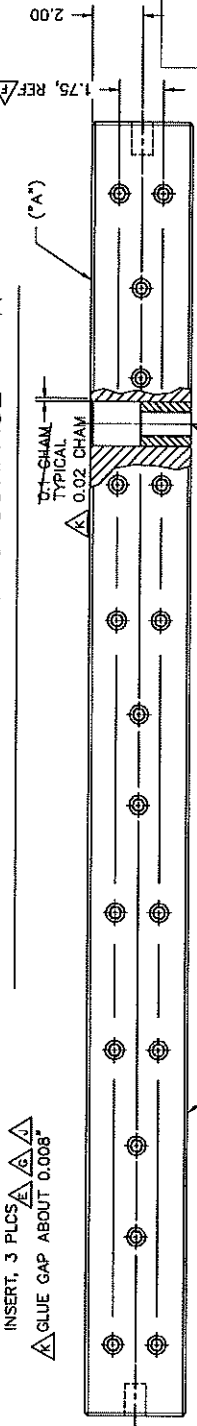

1x14 THD INSERT, 3 PLCS -
INSERT TO BE FLUSH WITH SIDE "B"
AS RECEIVED:
TILT = 0 - 0.6"
RECESS = 0 - 0.09"

1 REQ'D
GRANITE
E=12x10⁶PSI
310 POUNDS







- NOTES:
1. BREAK ALL CORNERS AND EDGES 0.1" TYPICAL.
 2. GRIND SIDE "A" SMOOTH.
 3. ALL INSERTS TO BE STAINLESS STEEL.

1/2



REV	DATE	DESCRIPTION
A	10-15-88	ISSUE FOR FABRICATION
B	11-15-88	ISSUE FOR FABRICATION
C	12-15-88	ISSUE FOR FABRICATION
D	1-15-89	ISSUE FOR FABRICATION
E	2-15-89	ISSUE FOR FABRICATION
F	3-15-89	ISSUE FOR FABRICATION
G	4-15-89	ISSUE FOR FABRICATION
H	5-15-89	ISSUE FOR FABRICATION
I	6-15-89	ISSUE FOR FABRICATION
J	7-15-89	ISSUE FOR FABRICATION
K	8-15-89	ISSUE FOR FABRICATION
L	9-15-89	ISSUE FOR FABRICATION
M	10-15-89	ISSUE FOR FABRICATION
N	11-15-89	ISSUE FOR FABRICATION
O	12-15-89	ISSUE FOR FABRICATION
P	1-15-90	ISSUE FOR FABRICATION
Q	2-15-90	ISSUE FOR FABRICATION
R	3-15-90	ISSUE FOR FABRICATION
S	4-15-90	ISSUE FOR FABRICATION
T	5-15-90	ISSUE FOR FABRICATION
U	6-15-90	ISSUE FOR FABRICATION
V	7-15-90	ISSUE FOR FABRICATION
W	8-15-90	ISSUE FOR FABRICATION
X	9-15-90	ISSUE FOR FABRICATION
Y	10-15-90	ISSUE FOR FABRICATION
Z	11-15-90	ISSUE FOR FABRICATION
AA	12-15-90	ISSUE FOR FABRICATION
AB	1-15-91	ISSUE FOR FABRICATION
AC	2-15-91	ISSUE FOR FABRICATION
AD	3-15-91	ISSUE FOR FABRICATION
AE	4-15-91	ISSUE FOR FABRICATION
AF	5-15-91	ISSUE FOR FABRICATION
AG	6-15-91	ISSUE FOR FABRICATION
AH	7-15-91	ISSUE FOR FABRICATION
AI	8-15-91	ISSUE FOR FABRICATION
AJ	9-15-91	ISSUE FOR FABRICATION
AK	10-15-91	ISSUE FOR FABRICATION
AL	11-15-91	ISSUE FOR FABRICATION
AM	12-15-91	ISSUE FOR FABRICATION
CL	3-15-96	ISSUE FOR FABRICATION
CM	4-15-96	ISSUE FOR FABRICATION
CN	5-15-96	ISSUE FOR FABRICATION
CO	6-15-96	ISSUE FOR FABRICATION
CP	7-15-96	ISSUE FOR FABRICATION
CQ	8-15-96	ISSUE FOR FABRICATION
CR	9-15-96	ISSUE FOR FABRICATION
CS	10-15-96	ISSUE FOR FABRICATION
CT	11-15-96	ISSUE FOR FABRICATION
CU	12-15-96	ISSUE FOR FABRICATION
CV	1-15-97	ISSUE FOR FABRICATION
CU	12-15-96	ISSUE FOR FABRICATION

KECK/HIRES
ECHELLE MOSAIC
SUBPLATE DETAIL
12 20 88

H3470.M

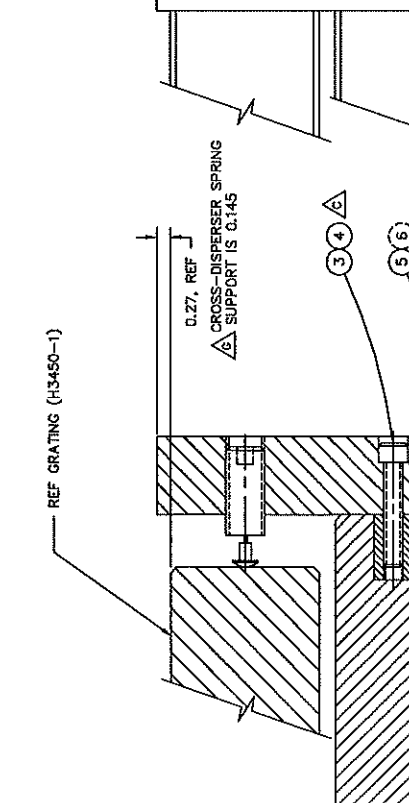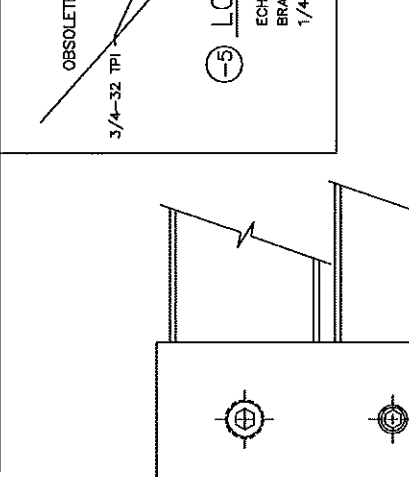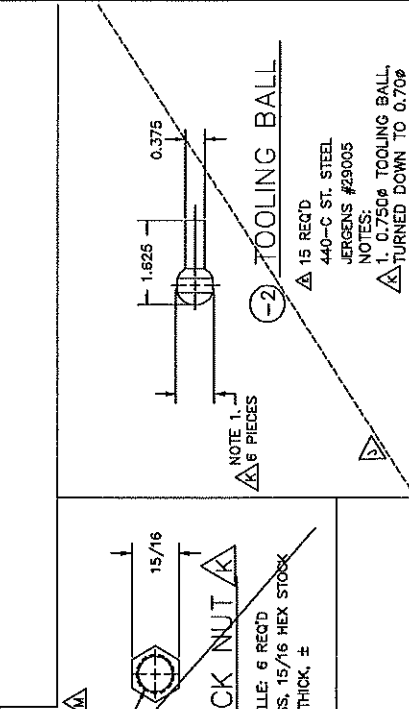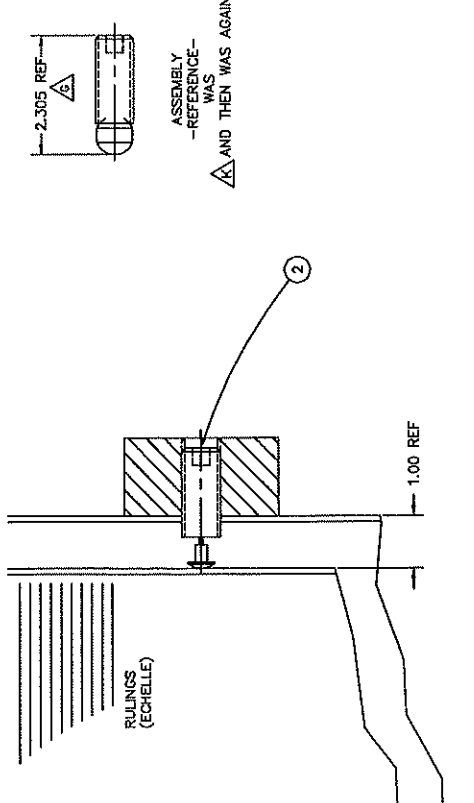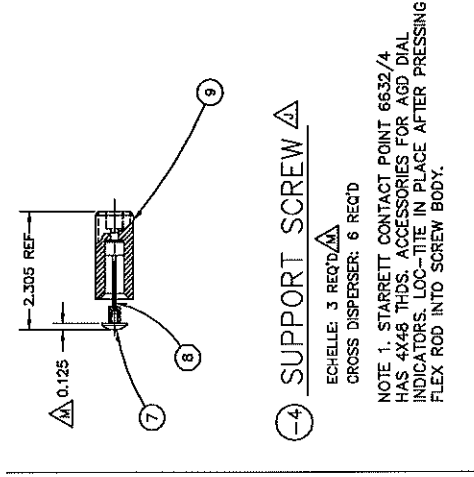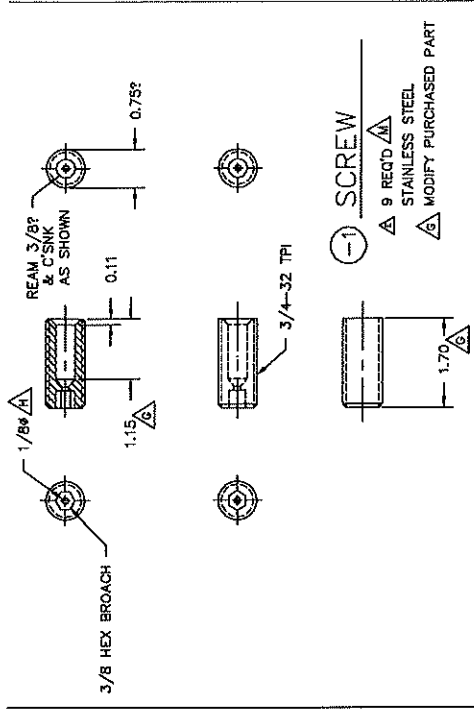



REVISION	1	1.8	SCREW	ST. STEEL
REVISION	2	1.6	TOOLING BALL	ST. STEEL
REVISION	3	1.6	CONTACT POINT	NOTE 1
REVISION	4	1.6	CONTACT POINT	NOTE 1
REVISION	5	1.6	SUPPORT SCREW	ALUM.
REVISION	6	1.6	INSERT	ST. STEEL
REVISION	7	1.6	INSERT	ST. STEEL
REVISION	8	1.6	INSERT	ST. STEEL
REVISION	9	1.6	INSERT	ST. STEEL
REVISION	10	1.6	INSERT	ST. STEEL
REVISION	11	1.6	INSERT	ST. STEEL
REVISION	12	1.6	INSERT	ST. STEEL
REVISION	13	1.6	INSERT	ST. STEEL
REVISION	14	1.6	INSERT	ST. STEEL
REVISION	15	1.6	INSERT	ST. STEEL
REVISION	16	1.6	INSERT	ST. STEEL
REVISION	17	1.6	INSERT	ST. STEEL
REVISION	18	1.6	INSERT	ST. STEEL
REVISION	19	1.6	INSERT	ST. STEEL
REVISION	20	1.6	INSERT	ST. STEEL

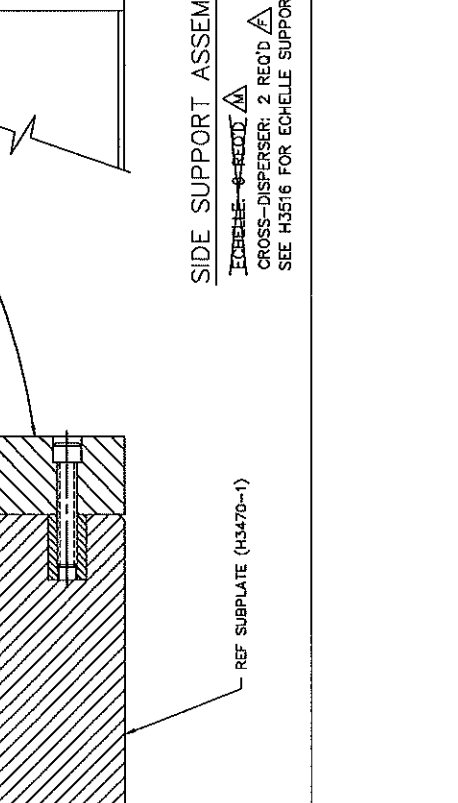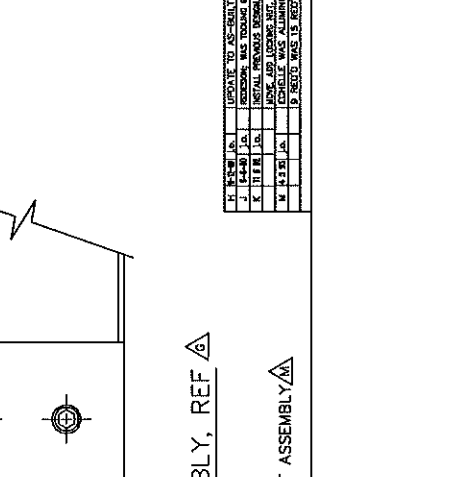

KECK/HIRES
ECCHELLE MOSAIC
SIDE SUPPORT ASSEMBLY
H3510.M

REV	DATE	BY	CHKD	DESCRIPTION
1	11/18/15	JA	JA	UPDATE TO AS-BUILT CONDITION
2	11/18/15	JA	JA	REWORK FOR BIDDING
3	11/18/15	JA	JA	REWORK FOR BIDDING
FULL
ECCHELLE-8 REQ'D
CROSS-DISPERSER: 2 REQ'D
SEE H3516 FOR ECCHELLE SUPPORT ASSEMBLY

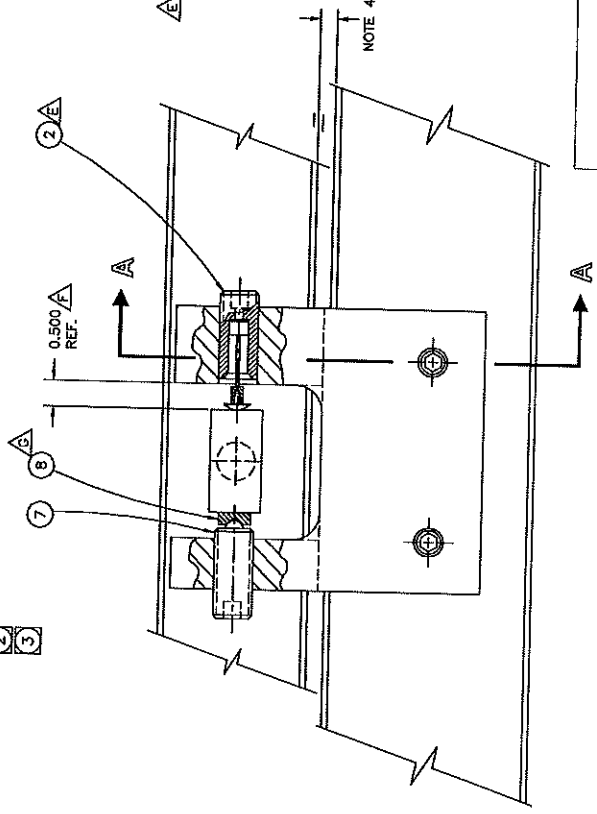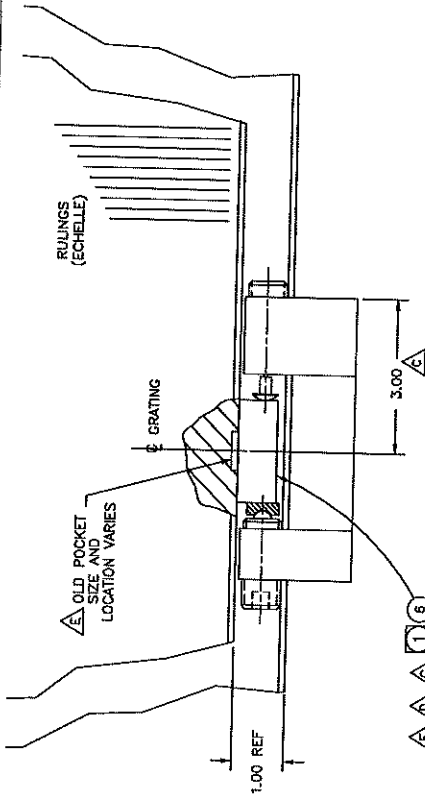

① SIDE SUPPORT 2


- 3 REQ'D (FOR ECHELLE SUPPORT)
- 4 REQ (FOR CROSS-DISPERSE SUP)
- 2 AS SHOWN AND 2 MIRROR IMAGE
- 1 SEE H3040 FOR GLUE DESCRIPTION.
- 2 THEN RULINGS ARE PUT ON.
- 3 THEN GLUE PADS BACK ON.
- 4. 0.31" (5 mm), 0.22", AND 0.40" GAPS

13438-2	8	3	PAD	ST
13438-3	9	4	GLUE	ST
13438-4	1	1	ECHELLE	ST
13438-5	2	1	SPRING PLUNGER	ST
13438-6	3	1	SPRING PLUNGER	ST
13438-7	4	1	SPRING PLUNGER	ST
13438-100	97	1	SPRING PLUNGER	ST

FULL


A	13438-2	8	3	PAD	ST
B	13438-3	9	4	GLUE	ST
C	13438-4	1	1	ECHELLE	ST
D	13438-5	2	1	SPRING PLUNGER	ST
E	13438-6	3	1	SPRING PLUNGER	ST
F	13438-7	4	1	SPRING PLUNGER	ST
G	13438-8	5	1	SPRING PLUNGER	ST
H	13438-9	6	1	SPRING PLUNGER	ST
I	13438-10	7	1	SPRING PLUNGER	ST
J	13438-11	8	1	SPRING PLUNGER	ST
K	13438-12	9	1	SPRING PLUNGER	ST
L	13438-13	10	1	SPRING PLUNGER	ST
M	13438-14	11	1	SPRING PLUNGER	ST
N	13438-15	12	1	SPRING PLUNGER	ST
O	13438-16	13	1	SPRING PLUNGER	ST
P	13438-17	14	1	SPRING PLUNGER	ST
Q	13438-18	15	1	SPRING PLUNGER	ST
R	13438-19	16	1	SPRING PLUNGER	ST
S	13438-20	17	1	SPRING PLUNGER	ST
T	13438-21	18	1	SPRING PLUNGER	ST
U	13438-22	19	1	SPRING PLUNGER	ST
V	13438-23	20	1	SPRING PLUNGER	ST
W	13438-24	21	1	SPRING PLUNGER	ST
X	13438-25	22	1	SPRING PLUNGER	ST
Y	13438-26	23	1	SPRING PLUNGER	ST
Z	13438-27	24	1	SPRING PLUNGER	ST
AA	13438-28	25	1	SPRING PLUNGER	ST
AB	13438-29	26	1	SPRING PLUNGER	ST
AC	13438-30	27	1	SPRING PLUNGER	ST
AD	13438-31	28	1	SPRING PLUNGER	ST
AE	13438-32	29	1	SPRING PLUNGER	ST
AF	13438-33	30	1	SPRING PLUNGER	ST
AG	13438-34	31	1	SPRING PLUNGER	ST
AH	13438-35	32	1	SPRING PLUNGER	ST
AI	13438-36	33	1	SPRING PLUNGER	ST
AJ	13438-37	34	1	SPRING PLUNGER	ST
AK	13438-38	35	1	SPRING PLUNGER	ST
AL	13438-39	36	1	SPRING PLUNGER	ST
AM	13438-40	37	1	SPRING PLUNGER	ST
AN	13438-41	38	1	SPRING PLUNGER	ST
AO	13438-42	39	1	SPRING PLUNGER	ST
AP	13438-43	40	1	SPRING PLUNGER	ST
AQ	13438-44	41	1	SPRING PLUNGER	ST
AR	13438-45	42	1	SPRING PLUNGER	ST
AS	13438-46	43	1	SPRING PLUNGER	ST
AT	13438-47	44	1	SPRING PLUNGER	ST
AU	13438-48	45	1	SPRING PLUNGER	ST
AV	13438-49	46	1	SPRING PLUNGER	ST
AW	13438-50	47	1	SPRING PLUNGER	ST
AX	13438-51	48	1	SPRING PLUNGER	ST
AY	13438-52	49	1	SPRING PLUNGER	ST
AZ	13438-53	50	1	SPRING PLUNGER	ST
BA	13438-54	51	1	SPRING PLUNGER	ST
BB	13438-55	52	1	SPRING PLUNGER	ST
BC	13438-56	53	1	SPRING PLUNGER	ST
BD	13438-57	54	1	SPRING PLUNGER	ST
BE	13438-58	55	1	SPRING PLUNGER	ST
BF	13438-59	56	1	SPRING PLUNGER	ST
BG	13438-60	57	1	SPRING PLUNGER	ST
BH	13438-61	58	1	SPRING PLUNGER	ST
BI	13438-62	59	1	SPRING PLUNGER	ST
BJ	13438-63	60	1	SPRING PLUNGER	ST
BK	13438-64	61	1	SPRING PLUNGER	ST
BL	13438-65	62	1	SPRING PLUNGER	ST
BM	13438-66	63	1	SPRING PLUNGER	ST
BN	13438-67	64	1	SPRING PLUNGER	ST
BO	13438-68	65	1	SPRING PLUNGER	ST
BP	13438-69	66	1	SPRING PLUNGER	ST
BQ	13438-70	67	1	SPRING PLUNGER	ST
BR	13438-71	68	1	SPRING PLUNGER	ST
BS	13438-72	69	1	SPRING PLUNGER	ST
BT	13438-73	70	1	SPRING PLUNGER	ST
BU	13438-74	71	1	SPRING PLUNGER	ST
BV	13438-75	72	1	SPRING PLUNGER	ST
BW	13438-76	73	1	SPRING PLUNGER	ST
BX	13438-77	74	1	SPRING PLUNGER	ST
BY	13438-78	75	1	SPRING PLUNGER	ST
BZ	13438-79	76	1	SPRING PLUNGER	ST
CA	13438-80	77	1	SPRING PLUNGER	ST
CB	13438-81	78	1	SPRING PLUNGER	ST
CC	13438-82	79	1	SPRING PLUNGER	ST
CD	13438-83	80	1	SPRING PLUNGER	ST
CE	13438-84	81	1	SPRING PLUNGER	ST
CF	13438-85	82	1	SPRING PLUNGER	ST
CG	13438-86	83	1	SPRING PLUNGER	ST
CH	13438-87	84	1	SPRING PLUNGER	ST
CI	13438-88	85	1	SPRING PLUNGER	ST
CJ	13438-89	86	1	SPRING PLUNGER	ST
CK	13438-90	87	1	SPRING PLUNGER	ST
CL	13438-91	88	1	SPRING PLUNGER	ST
CM	13438-92	89	1	SPRING PLUNGER	ST
CN	13438-93	90	1	SPRING PLUNGER	ST
CO	13438-94	91	1	SPRING PLUNGER	ST
CP	13438-95	92	1	SPRING PLUNGER	ST
CQ	13438-96	93	1	SPRING PLUNGER	ST
CR	13438-97	94	1	SPRING PLUNGER	ST
CS	13438-98	95	1	SPRING PLUNGER	ST
CT	13438-99	96	1	SPRING PLUNGER	ST
CU	13438-100	97	1	SPRING PLUNGER	ST

A	13438-2	8	3	PAD	ST
B	13438-3	9	4	GLUE	ST
C	13438-4	1	1	ECHELLE	ST
D	13438-5	2	1	SPRING PLUNGER	ST
E	13438-6	3	1	SPRING PLUNGER	ST
F	13438-7	4	1	SPRING PLUNGER	ST
G	13438-8	5	1	SPRING PLUNGER	ST
H	13438-9	6	1	SPRING PLUNGER	ST
I	13438-10	7	1	SPRING PLUNGER	ST
J	13438-11	8	1	SPRING PLUNGER	ST
K	13438-12	9	1	SPRING PLUNGER	ST
L	13438-13	10	1	SPRING PLUNGER	ST
M	13438-14	11	1	SPRING PLUNGER	ST
N	13438-15	12	1	SPRING PLUNGER	ST
O	13438-16	13	1	SPRING PLUNGER	ST
P	13438-17	14	1	SPRING PLUNGER	ST
Q	13438-18	15	1	SPRING PLUNGER	ST
R	13438-19	16	1	SPRING PLUNGER	ST
S	13438-20	17	1	SPRING PLUNGER	ST
T	13438-21	18	1	SPRING PLUNGER	ST
U	13438-22	19	1	SPRING PLUNGER	ST
V	13438-23	20	1	SPRING PLUNGER	ST
W	13438-24	21	1	SPRING PLUNGER	ST
X	13438-25	22	1	SPRING PLUNGER	ST
Y	13438-26	23	1	SPRING PLUNGER	ST
Z	13438-27	24	1	SPRING PLUNGER	ST
AA	13438-28	25	1	SPRING PLUNGER	ST
AB	13438-29	26	1	SPRING PLUNGER	ST
AC	13438-30	27	1	SPRING PLUNGER	ST
AD	13438-31	28	1	SPRING PLUNGER	ST
AE	13438-32	29	1	SPRING PLUNGER	ST
AF	13438-33	30	1	SPRING PLUNGER	ST
AG	13438-34	31	1	SPRING PLUNGER	ST
AH	13438-35	32	1	SPRING PLUNGER	ST
AI	13438-36	33	1	SPRING PLUNGER	ST
AJ	13438-37	34	1	SPRING PLUNGER	ST
AK	13438-38	35	1	SPRING PLUNGER	ST
AL	13438-39	36	1	SPRING PLUNGER	ST

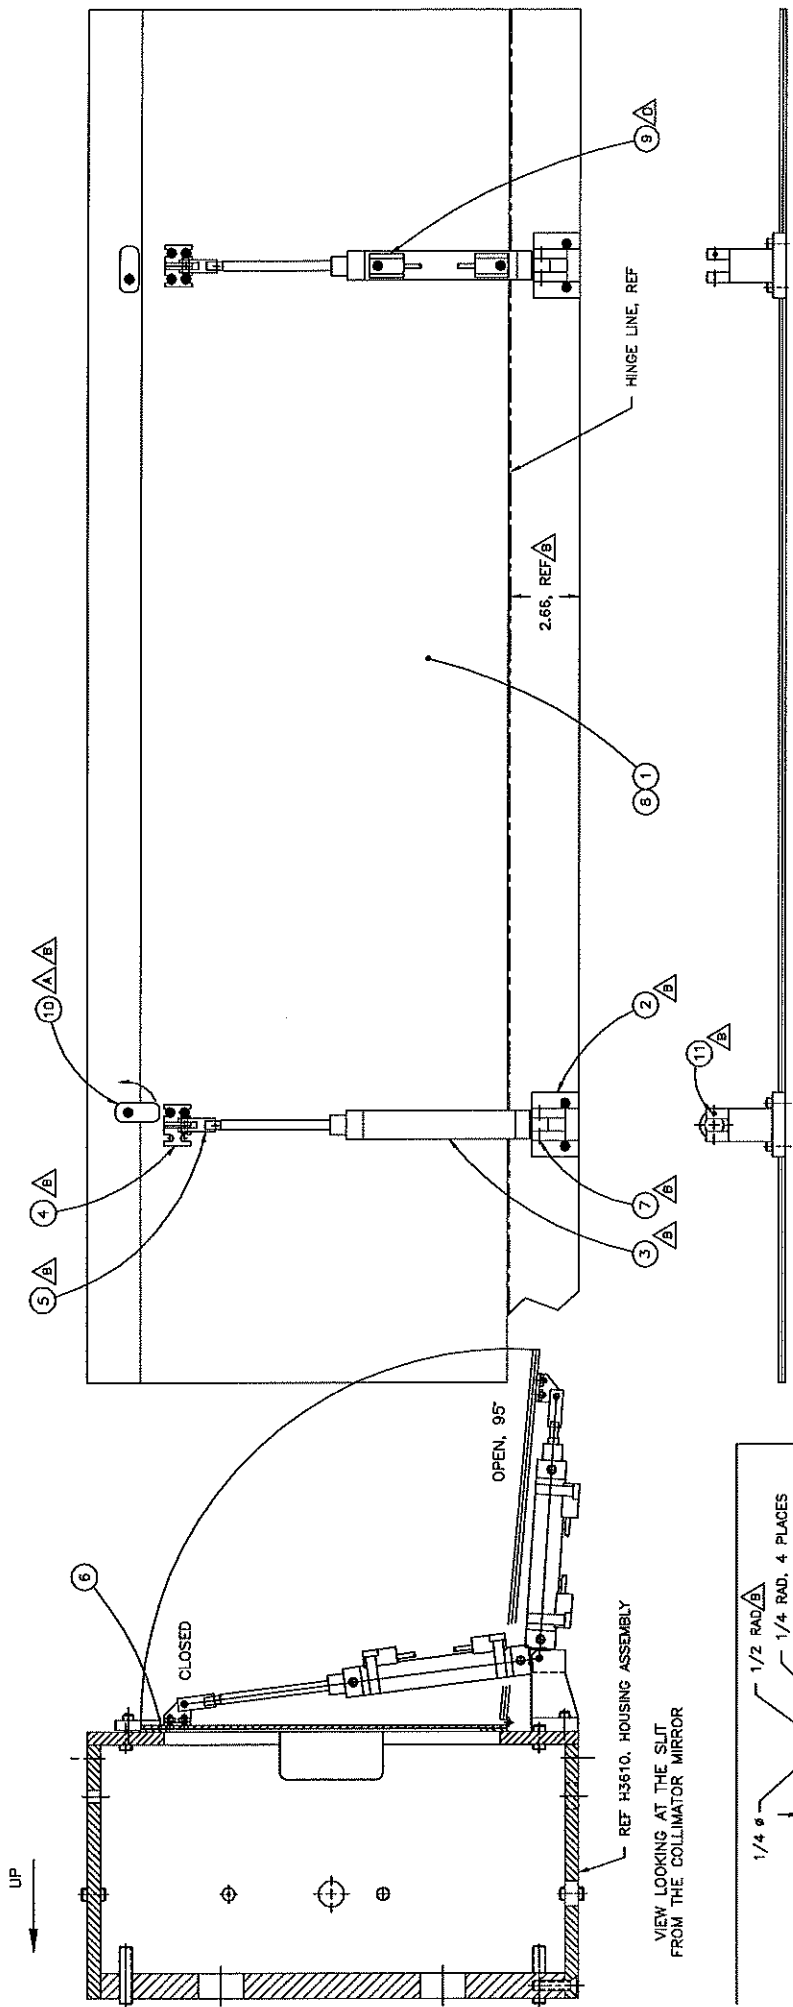

-1 COVER ASSEMBLY

- 1 REQ'D
- NOTE: ONLY ONE CYLINDER WILL HAVE LIMIT SWITCHES ATTACHED.
- NOTE 1: PIVOT BRACKET #D-8321-A
- NOTE 2: CLEVIS #D-8309-A
- NOTE 3: USE CONTACT CEMENT TO BOND TO COVER PLATE. PLACE SMOOTH SIDE AGAINST COVER. CELLULAR URETHANE, #4701-01-20125-1604 WITH ADCHEM #256 ADHESIVE.

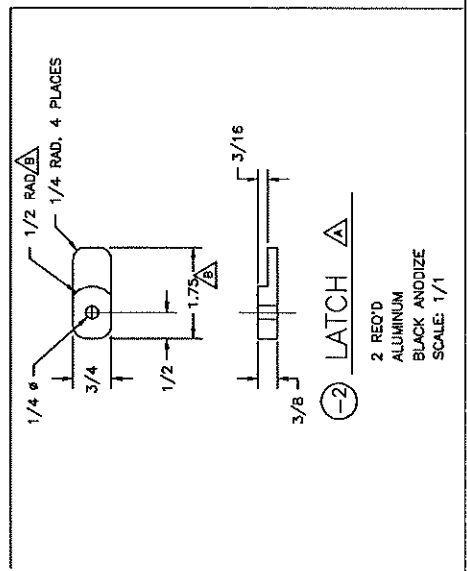

-2 LATCH

- 2 REQ'D
- ALUMINUM
- BLACK ANODIZE
- SCALE: 1/1

11	2	LAST SWITCH, #E-32	ST. STL.
12	1	PIVOT BRACKET, #D-8321-A	ALUM.
13	1	PIVOT BRACKET, #D-8321-A	ALUM.
1/2

KECK/HIRES
ECHELLE MOSAIC
COVER ASSY


ASSEMBLY
LIMIT SWITCHES
LIMIT SWITCHES
LIMIT SWITCHES

2209 FAIRVIEW DR.
CERES, CA 95307

SCALE: 1/1

DATE: 3-17-88

H3700.D

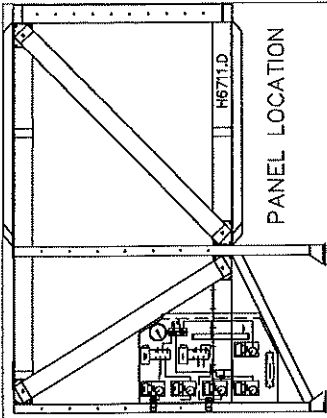


PANEL ASSEMBLY

1 REQ'D

- NOTES:
 1. WILKERSON REGULATOR #R16-02-000 COMES WITH 0-160 PSI SPRING USE GAGE #GRP-95-228
 2. WILKERSON REGULATOR #R16-02-000 WITH SPRING #RRP-95-222 FOR 0-60 PSI RANGE. USE GAGE #RRP-95-230
 3. SKINNER MAGNELATCH 4-WAY VALVE. #H35RBM2150-24A. 24VAC COIL. 1/4" NPT PORTS. ALUMINUM HOUSING W/SS SLEEVE. BUNA-N SEALS, 1/2" NPT CONDUIT OUTLET.
 5. JERGENS #61802. ALUMINUM, 8 1/4" NPT PORTS AND 2 3/8" NPT PORTS (ENDS).
 6. JERGENS #61801. ALUMINUM, 4 1/4" NPT PORTS AND 2 3/8" NPT PORTS (ENDS).
 8. GAGE: McMASTER-CARR #4023K35, 0-160PSI

13	1	90° BEND UP	NOTE 8
12	1	CLAMP 1/2" BARS	NOTE 6
11	1	4-PORT MANIFOLD	NOTE 5
10	1	8-PORT MANIFOLD	NOTE 5
9	1	WILKERSON MAGNELATCH	NOTE 3
8	1	WILKERSON REGULATOR	NOTE 1
7	2	LATCHING SOLENOID	NOTE 3
6	1	WILKERSON MAGNELATCH	NOTE 3
5	4	REGULATOR	NOTE 1
4	1	SOLENOID	NOTE 3
3	1	SOLENOID	NOTE 3
2	1	SOLENOID	NOTE 3
1	1	SOLENOID	NOTE 3

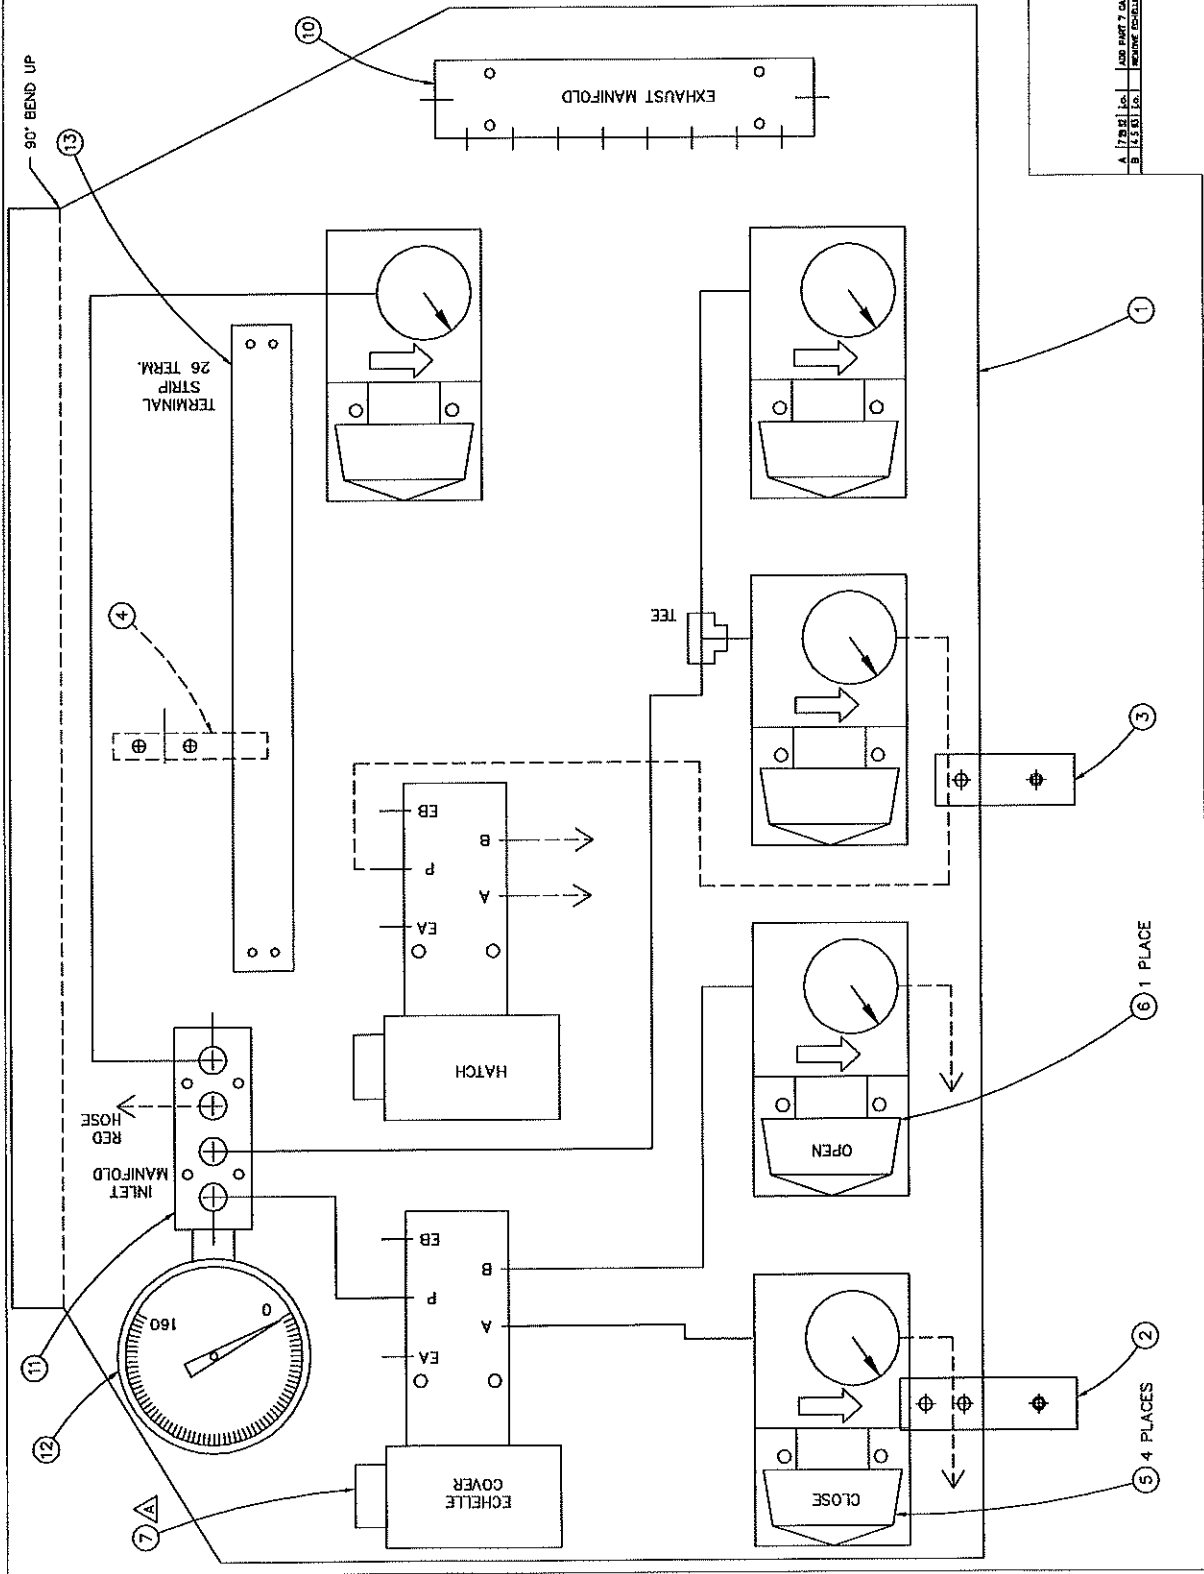



FULL

KECK/HIRES
 ECHELLE AIR CONTROL
 MOUNTING PANEL
 Jc. 2 14 81

H3703.B

1. 1/8" DIA. 1/4" L. 1/8" DIA. 1/4" L. 1/8" DIA. 1/4" L.
 2. 1/8" DIA. 1/4" L. 1/8" DIA. 1/4" L. 1/8" DIA. 1/4" L.
 3. 1/8" DIA. 1/4" L. 1/8" DIA. 1/4" L. 1/8" DIA. 1/4" L.

17	1	BRUSH COVER	ALUM	17350-3	8	3	ROUND SPACER	STEEL	17350-3	8	3	ROUND SPACER	STEEL
18	1	SHIM PLATE	ALUM	17350-2	7	4	1/4" DOWEL PIN	STEEL	17350-2	7	4	1/4" DOWEL PIN	STEEL
19	1	MOTOR ASSEMBLY	ALUM	17350-1	6	1	SCANNING HEAD MOUNT	ALUM	17350-1	6	1	SCANNING HEAD MOUNT	ALUM
20	1	SPROCKET, 18T	STEEL	17350-1	5	1	FRONT MOUNT PLATE	ALUM	17350-1	5	1	FRONT MOUNT PLATE	ALUM
21	1	SPROCKET, 18T	STEEL	17350-1	4	1	REAR MOUNT PLATE	ALUM	17350-1	4	1	REAR MOUNT PLATE	ALUM
22	1	SPROCKET, 18T	STEEL	17350-1	3	2	1/8" X 1/4" SCREW	STEEL	17350-1	3	2	1/8" X 1/4" SCREW	STEEL
23	1	SPROCKET, 18T	STEEL	17350-1	2	1	SPROCKET, 18T	STEEL	17350-1	2	1	SPROCKET, 18T	STEEL
24	1	SPROCKET, 18T	STEEL	17350-1	1	1	SPROCKET, 18T	STEEL	17350-1	1	1	SPROCKET, 18T	STEEL
25	1	SPROCKET, 18T	STEEL	17350-1	1	1	SPROCKET, 18T	STEEL	17350-1	1	1	SPROCKET, 18T	STEEL
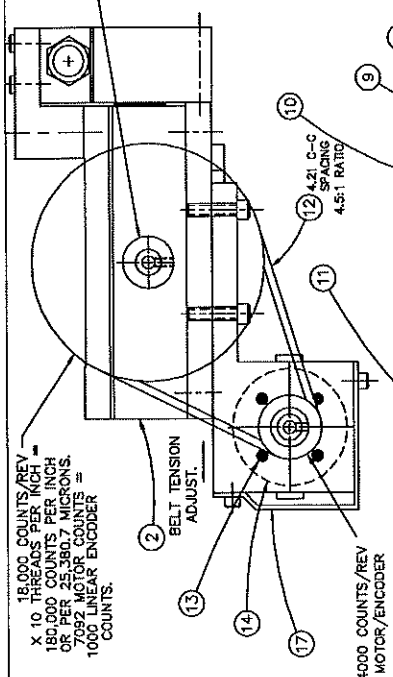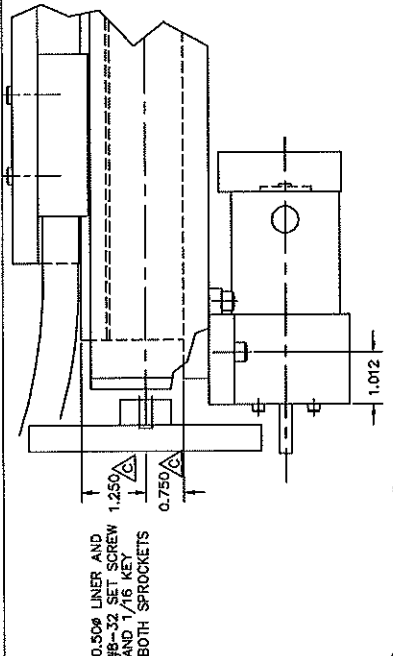


TEST SETUP

- HEIDENHAIN LS 101 LINEAR ENCODER # 5 MICRON ACCURACY, 140 mm TRAVEL (5.5") AND INDEX EVERY 50 mm (1.97") WITH HEIDENHAIN EXE-602-D BOX (X5 LOGIC) FOR 0.5 MICRON RESOLUTION
- DAEDAL LINEAR TABLE P/N 106061C-10E TRAVEL WITH CROSS ROLLERS (200 LB CAPACITY) 0.1" /REV DRIVE SCREW, 10 TPI

VENDOR:
 OR/EL SECOND ENCODER
 H.S.S. MACHINE TOOL
 RETROFITTING, INC
 BUENA PARK, CA 90621
 (714) 522-1430
 SANTA CLARA, CA 95050
 980-8809

- LOCATE PART 5 SUCH THAT TIR IS LESS THAN 0.003" AND PIN WITH 1/4" DOWEL PINS.
- LOCATE PART 6 SUCH THAT HEAD RUNNOUT IS LESS THAN 0.003" AND PIN WITH 1/4" DOWEL PINS.
- 3.1 IN-LB FRICTION TORQUE AT DRIVE SCREW SHAFT.
7. GEAR: 72XLO37
8. GEAR: 18XLO37
9. BELT: 180XL037 (90 TEETH)

TEST PROCEDURE:
 1. ASSEMBLE STAGE AND ENCODER.
 2. VERIFY FUNCTION OF ENCODER IN BOTH DIRECTIONS AND INDEX-COUNTING.
 3. PLACE ASSEMBLY IN FREEZER AND REPEAT TESTS. (-22C, -4F)

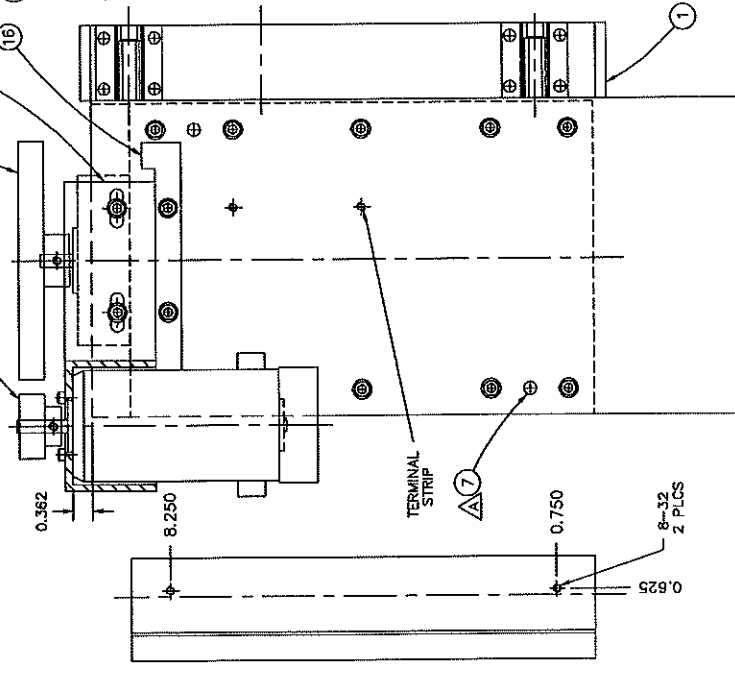

17	1	BRUSH COVER	ALUM	17350-3	8	3	ROUND SPACER	STEEL	17350-3	8	3	ROUND SPACER	STEEL
18	1	SHIM PLATE	ALUM	17350-2	7	4	1/4" DOWEL PIN	STEEL	17350-2	7	4	1/4" DOWEL PIN	STEEL
19	1	MOTOR ASSEMBLY	ALUM	17350-1	6	1	SCANNING HEAD MOUNT	ALUM	17350-1	6	1	SCANNING HEAD MOUNT	ALUM
20	1	SPROCKET, 18T	STEEL	17350-1	5	1	FRONT MOUNT PLATE	ALUM	17350-1	5	1	FRONT MOUNT PLATE	ALUM
21	1	SPROCKET, 18T	STEEL	17350-1	4	1	REAR MOUNT PLATE	ALUM	17350-1	4	1	REAR MOUNT PLATE	ALUM
22	1	SPROCKET, 18T	STEEL	17350-1	3	2	1/8" X 1/4" SCREW	STEEL	17350-1	3	2	1/8" X 1/4" SCREW	STEEL
23	1	SPROCKET, 18T	STEEL	17350-1	2	1	SPROCKET, 18T	STEEL	17350-1	2	1	SPROCKET, 18T	STEEL
24	1	SPROCKET, 18T	STEEL	17350-1	1	1	SPROCKET, 18T	STEEL	17350-1	1	1	SPROCKET, 18T	STEEL
25	1	SPROCKET, 18T	STEEL	17350-1	1	1	SPROCKET, 18T	STEEL	17350-1	1	1	SPROCKET, 18T	STEEL
FULL

A	12-94	1	UPDATE TO AS-BUILT CONDITION.
B	12-94	1	ADD DIMENSIONS TO DRAWING FOR IDENTIFY SERIAL AND
C	12-94	1	ADD DIMENSIONS TO DRAWING FOR IDENTIFY SERIAL AND

KECK/HIRES
 ENCODER ASSEMBLY
 CCD FOCUS / TEST
 4-89

H7300.C

① LIMIT SWITCH ASSEMBLY

1 REQD FOR ENCODER TESTING


NOTES:

1. TO REVERSE THE SENSE OF THE OPTICAL INTERRUPTER, RE-LOCATE HERE.
2. "HARD" OR FINAL LIMITS: MICROSWITCH #DT-2RV22-A7
3. "SOFT" OR LOGIC LIMITS: MICROSWITCH #B7-2RWB22-A2
4. OPTEK #OPB-970-T55.

VENDOR:

BELL INDUSTRIES
1161 N. FAIROAKS AVE
SUNNYVALE, CA 94086

△ 5. THIS ASSEMBLY WAS MODIFIED AND MOVED TO H3201 AS PART OF THE ECHELLE MOSAIC DRIVE ASSEMBLY.

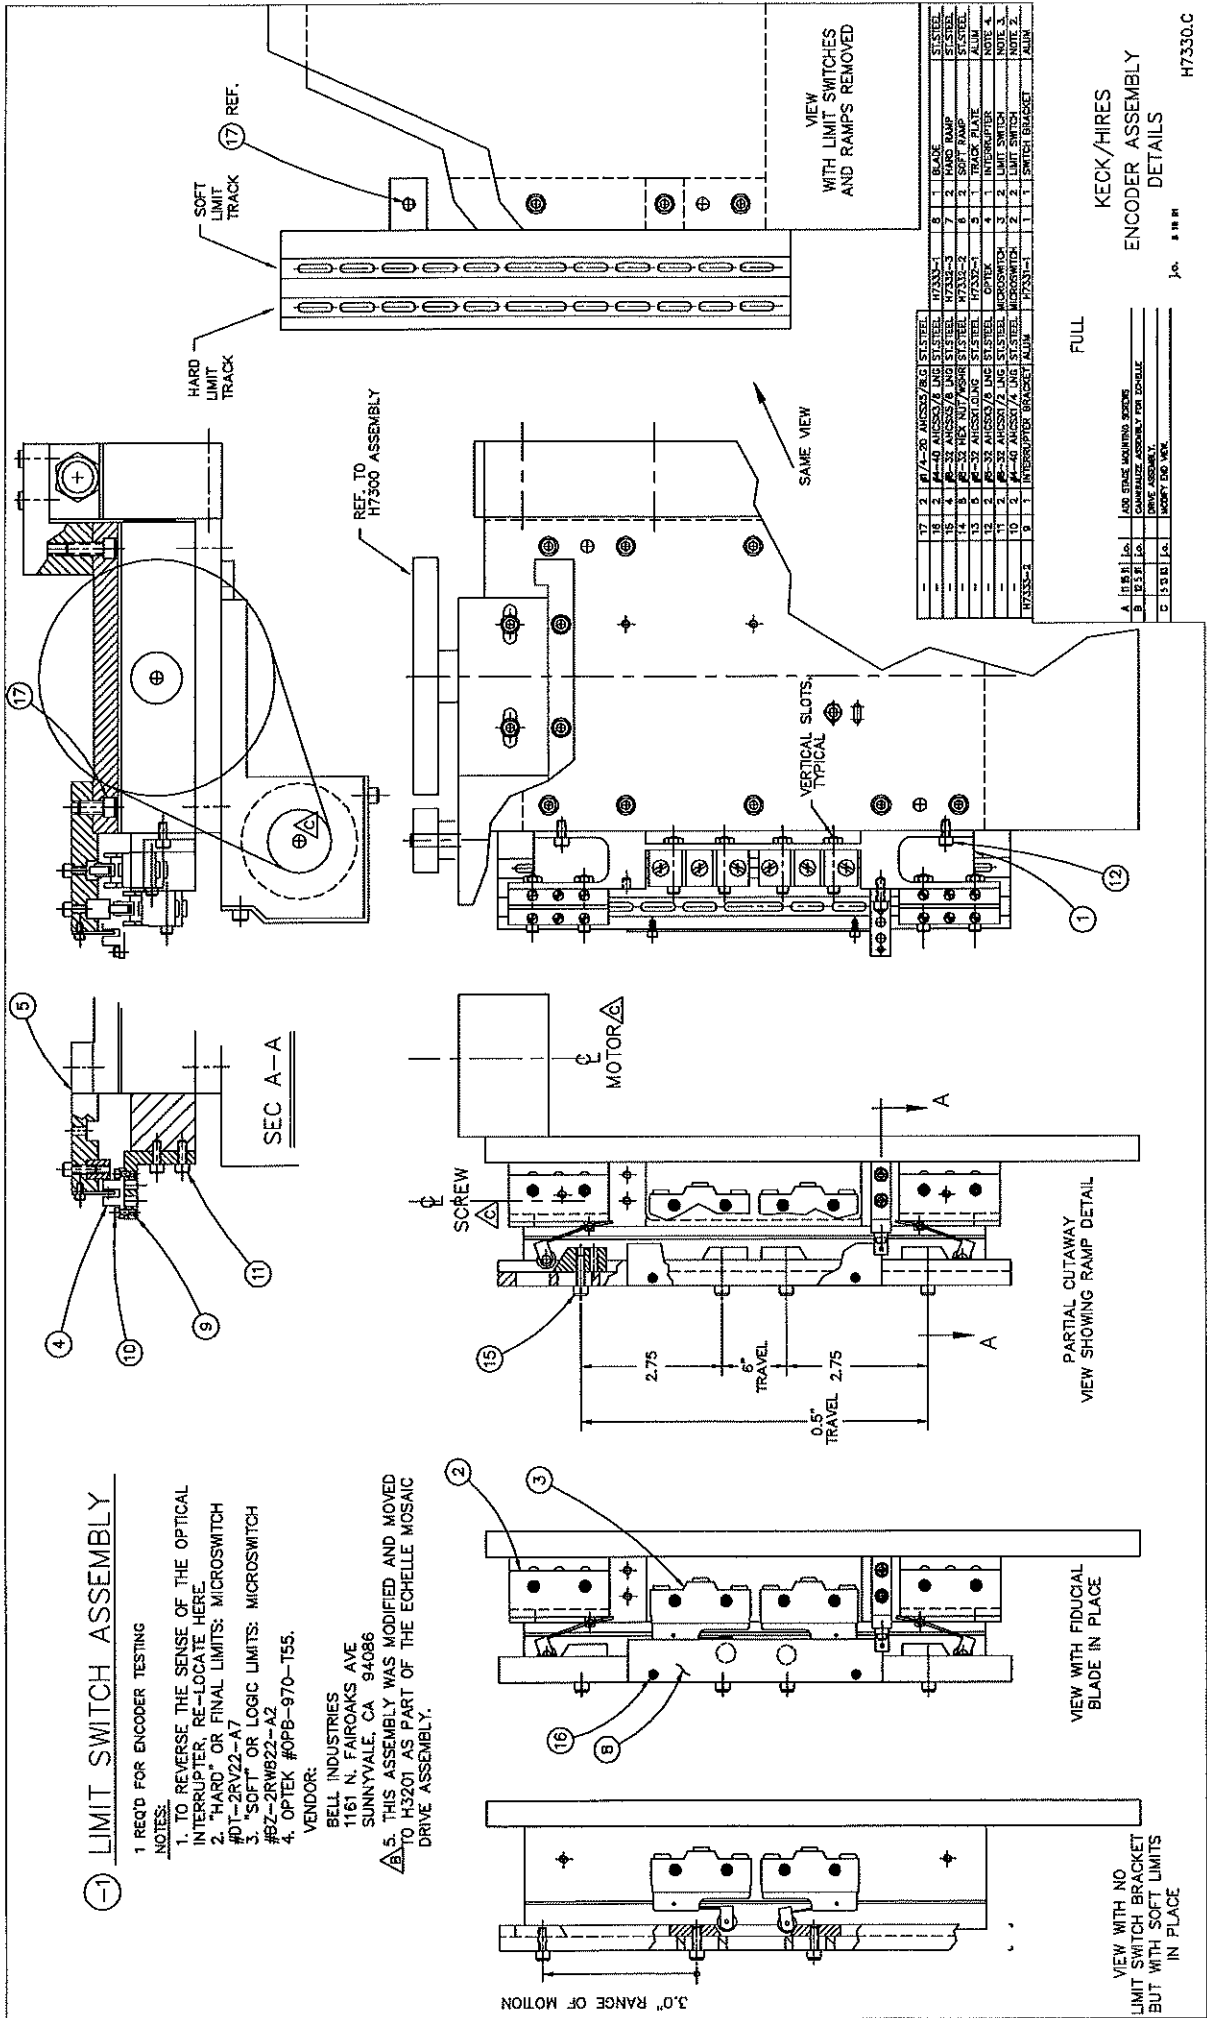

17	2	1/2-20	ALUMINUM	SCREW	1
18	2	1/2-20	ALUMINUM	SCREW	1
19	2	1/2-20	ALUMINUM	SCREW	1
FULL

KECK/HIRES
ENCODER ASSEMBLY
DETAILS

H7330.C

A	10.0	1/2	1/2	1/2	1/2
B	10.0	1/2	1/2	1/2	1/2
C	10.0	1/2	1/2	1/2	1/2

10. 8 11 14

ADD STAGE MOUNTING SCREWS
WHERE APPROPRIATE FOR ASSEMBLY
MOUNT FOR VAR.

3.0" RANGE OF MOTION

VIEW WITH NO
LIMIT SWITCH BRACKET
BUT WITH SOFT LIMITS
IN PLACE

PARTIAL CUTAWAY
VIEW SHOWING RAMP DETAIL

VIEW WITH FIDUCIAL
BLADE IN PLACE

SAME VIEW

VERTICAL SLOTS,
TYPICAL

MOTOR

REF. TO
H7300 ASSEMBLY

SEC A-A

VIEW
WITH LIMIT SWITCHES
AND RAMPS REMOVED

SOFT
LIMIT
TRACK

HARD
LIMIT
TRACK

17

5

4

10

9

11

2

3

16

B


1

12

17 REF.

Appendix E List of Drawings — Cross-Disperser Mosaic

1. H4005 Locating Tree
2. H4000 Cross Disperser Assembly and Cell
3. H4026 Optical Detail and Blaze
4. H4210 Alignment Fixture for Turntable Mounting
5. H4251 Encoder Assembly
6. H4264 Worm Drive Assembly
7. H4281 Drive Assembly and Schematic
8. H4300 Subplate Column Support Assembly
9. H4421 Alignment Notes
10. H4424 Alignment Notes
11. H4450 Grating Detail
12. H4454 Grating and Side Pads
13. H4470 Subplate
14. H4511 Turntable Preload
15. H4530 Turntable Drive Limits
16. H4534 Turntable Brake Assembly
17. H4740 Cell Carrier Assembly
18. H4750 Cell Doors Pneumatic Diagram
19. H4751 Pneumatic Details
20. H4802 Subplate Finite Analysis Results

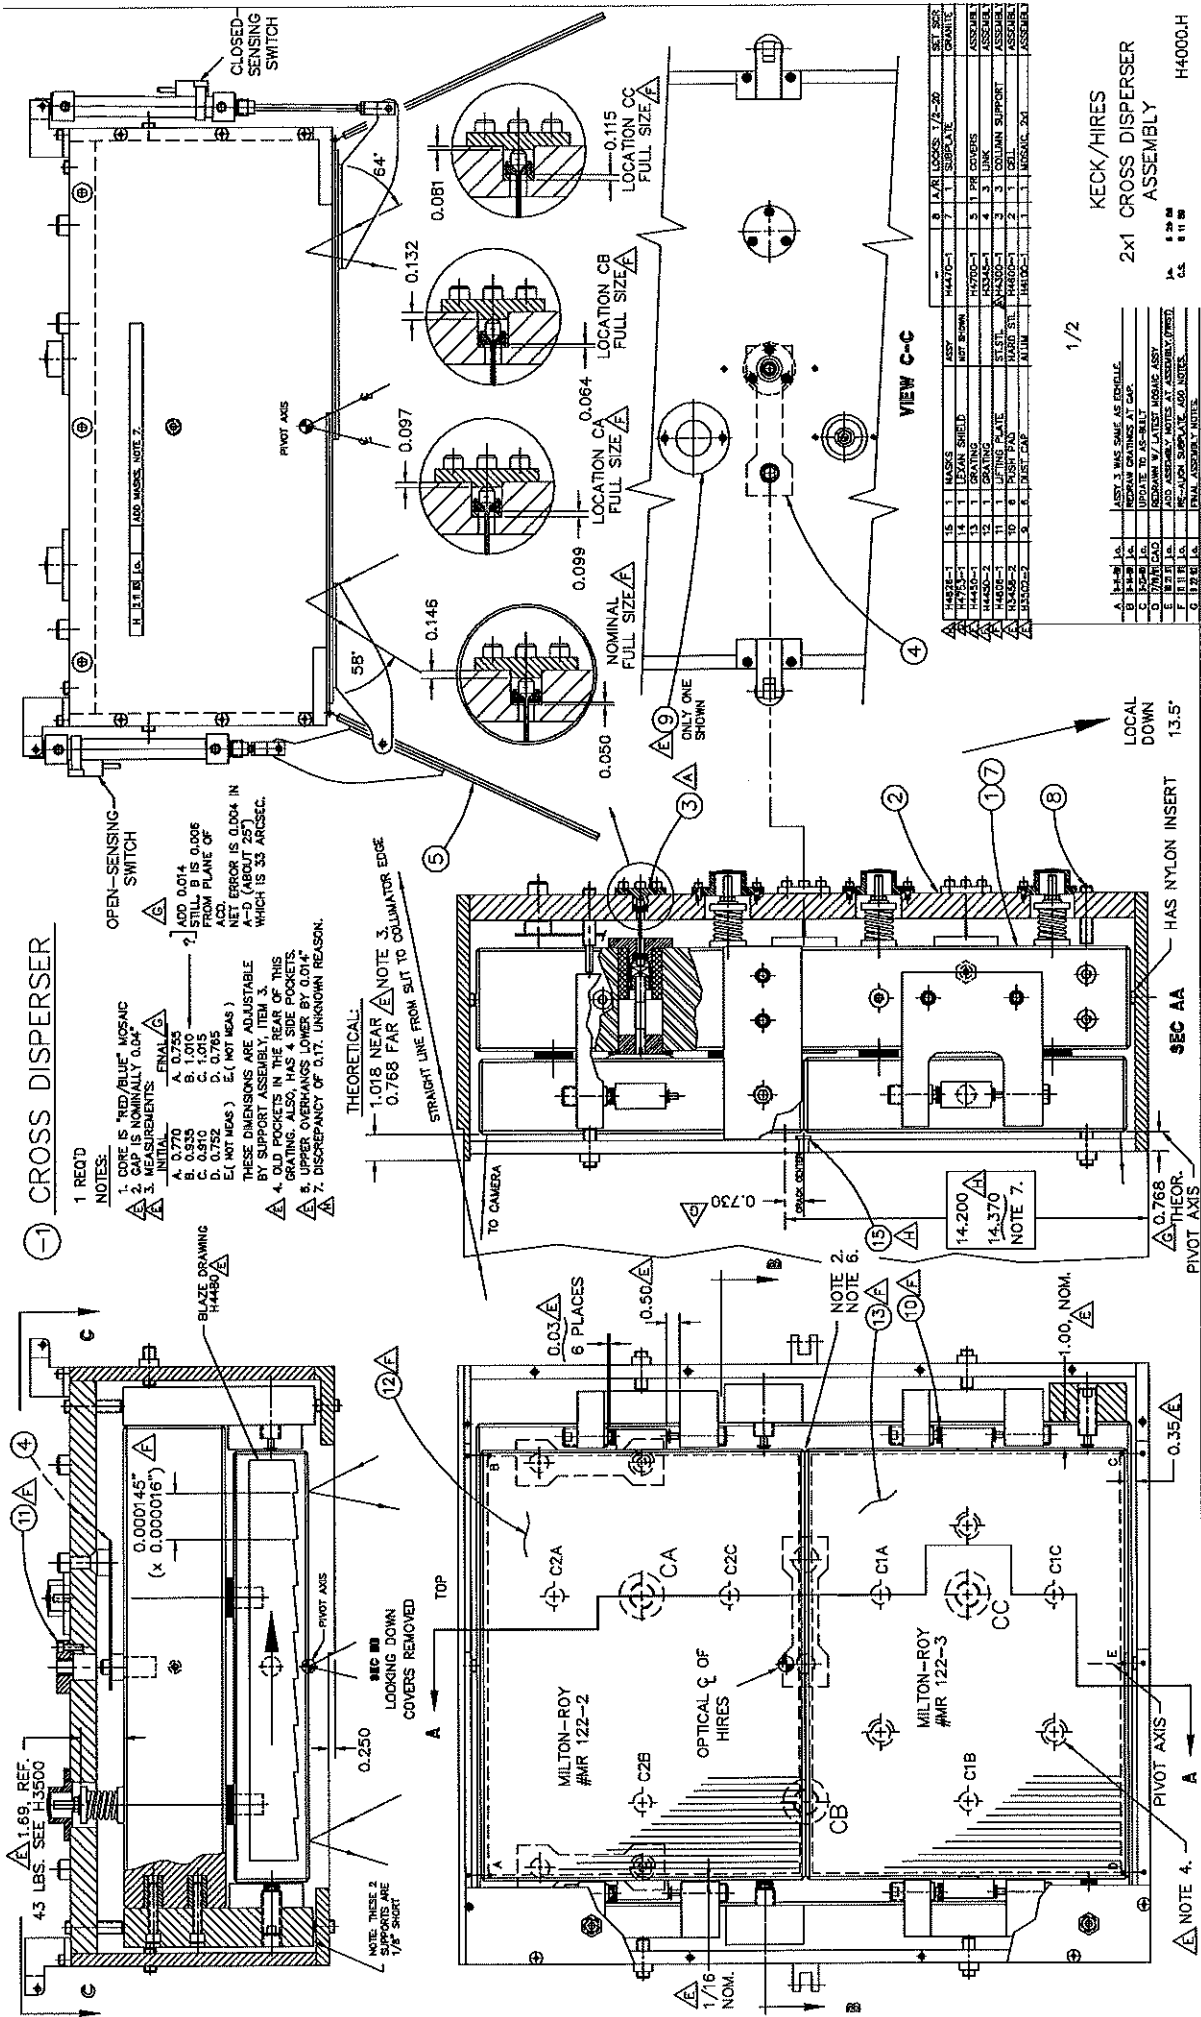

1 CROSS DISPERSER

- 1 RECD NOTES:
 1. CORE IS "RED/BLUE" MOSAIC
 2. GAP IS NOMINALLY 0.04"
 3. MEASUREMENTS:
 INITIAL FINAL
 A. 0.770 0.775
 B. 0.415 0.415
 C. 0.410 0.415
 D. 0.752 0.785
 E. (NOT MEAS)
 THESE DIMENSIONS ARE ADJUSTABLE BY SUPPORT ASSEMBLY, ITEM 3. OLD POCKETS IN THE REAR OF THIS GRATING, ALSO, HAS 4 SIDE POCKETS.
 4. UPPER OVERHANGS LOWER BY 0.014"
 5. DISCREPANCY OF 0.17. UNKNOWN REASON.
 6. ADD 0.014
 7. STILL B IS 0.006 FROM PLANE OF NET. ERROR IS 0.004 IN A-D (ABOUT 25°) WHICH IS 33 ARCSEC.


THEORETICAL:

- 1.018 NEAR NOTE 3, ILLUMINATOR EDGE
 0.768 FAR NOTE 3, ILLUMINATOR EDGE
 STRAIGHT LINE FROM SLIT TO ILLUMINATOR EDGE

ITEM	QTY	DESCRIPTION	UNIT	REVISION
1	1	CROSS DISPERSER ASSEMBLY	ASSEMBLY	1
2	1	MILTON-ROY #MR 122-2	COMPONENT	1
3	1	MILTON-ROY #MR 122-3	COMPONENT	1
4	1	OPTICAL Q OF HIRES	COMPONENT	1
5	1	OPEN-SENSING SWITCH	COMPONENT	1
6	1	CLOSED-SENSING SWITCH	COMPONENT	1
7	1	PIVOT AXIS	COMPONENT	1
8	1	TO CAMERA	COMPONENT	1
9	1	LOCAL DOWN	COMPONENT	1
10	1	HAS NYLON INSERT	COMPONENT	1
11	1	THEOR. AXIS	COMPONENT	1
12	1	THEOR. AXIS	COMPONENT	1
13	1	NOTE 1	COMPONENT	1
14	1	NOTE 2	COMPONENT	1
15	1	NOTE 3	COMPONENT	1
100	1	NOTE 88	COMPONENT	1

KECK/HIRES
 2x1 CROSS DISPERSER
 ASSEMBLY
 H4000.H
 1/2

NOTE 1: USE SAME AS ORIGINAL
 NOTE 2: REPAIR CRACKS AT GAO
 NOTE 3: UPDATE TO AS-BUILT
 NOTE 4: REPAIR W/ LATEST MOSAIC ASST
 NOTE 5: ADD ASSEMBLY NOTES AT ASSEMBLY/TEST
 NOTE 6: ADD ASSEMBLY/TEST
 NOTE 7: ADD ASSEMBLY/TEST
 NOTE 8: ADD ASSEMBLY/TEST
 NOTE 100: ADD ASSEMBLY/TEST

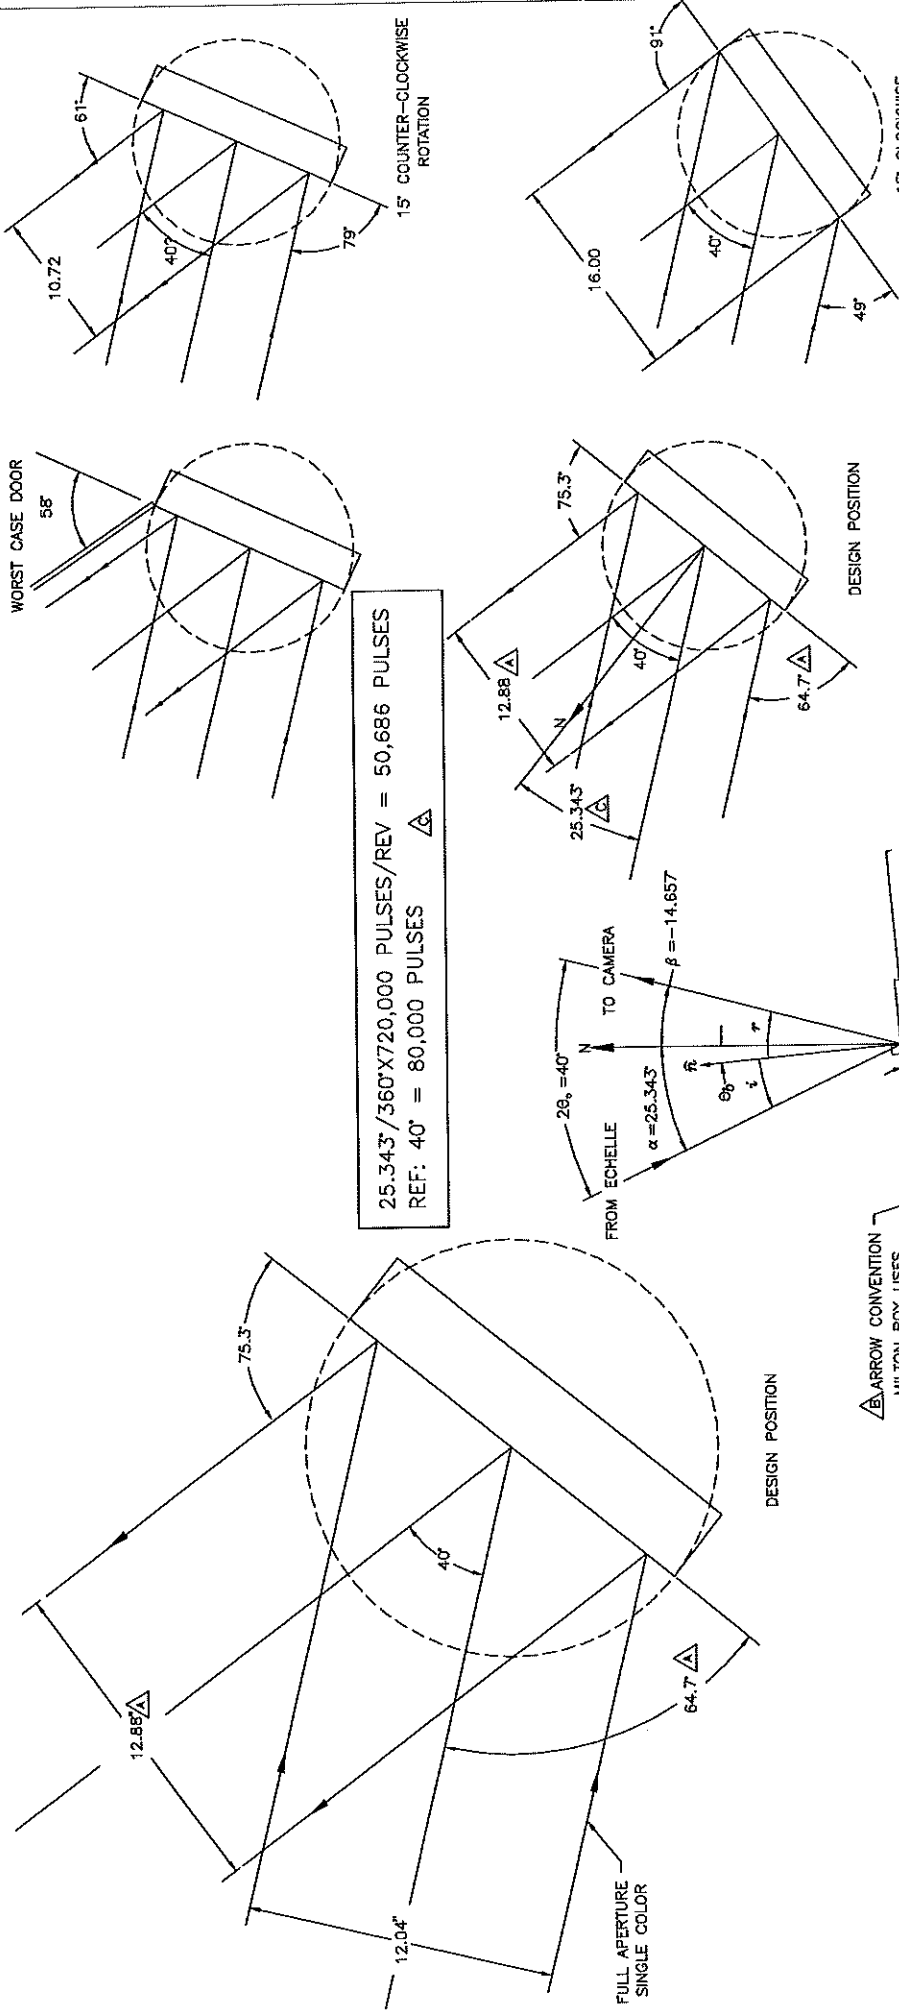

25.343/360° X 720,000 PULSES/REV = 50,686 PULSES
 REF: 40° = 80,000 PULSES

RED/BLUE CROSS DISPERSER

- 1 REQ'D 2x1 GRATING MOSAIC
- 250 LINES/MM

RED/BLUE
 $\theta_b = 5.343^\circ$
 $\text{ALPHA} = 25.3428^\circ$
 $\text{BETA} = -14.6571^\circ$
 $\lambda_b = 7000 \text{ \AA}$
 $m = 1$

ARROW CONVENTION
 MILTON ROY USES THE PROJECTION OF THE FACET OF INTEREST TO LOCATE THIS ARROW. NOT THE "USE" DIRECTION, WHICH MIGHT CHANGE. SEE H4480 FOR PATTERN

GRATING DERIVATIONS
 $\theta_b = \alpha \pm \beta$

$\alpha = \sin^{-1} \left[\frac{m\lambda}{2r \cos \theta_0} \right] + \theta_0$ = angle of incidence for diffraction into direction of camera axis
 $\beta_0 = \alpha - 2\theta_0$ = angle of diffraction in direction of camera axis
 GROOVE SPACING IS 1/250 MM (=0.004MM, OR 0.0001574")


- NOTES:**
- 250 GROOVES/MM WAS SELECTED.
 - BLAZE ANGLE IS DETERMINED FROM 7000 ANGSTROM FIRST ORDER AND 40° COLLIMATOR-TO-CAMERA ANGLE. STEVE CALCULATED 5.343°.

1/2




REV	DATE	BY	CHKD	APP	DESCRIPTION
A	10/28/80	KECK	HIRS	KECK	DATE FOR 3.0007 REVIEW
B	11/12/80	KECK	HIRS	KECK	DATE FOR 3.0007 REVIEW
C	11/12/80	KECK	HIRS	KECK	DATE FOR 3.0007 REVIEW

KECK/HIRS
 CROSS DISPERSER
 OPTICAL DETAIL

H4026.C

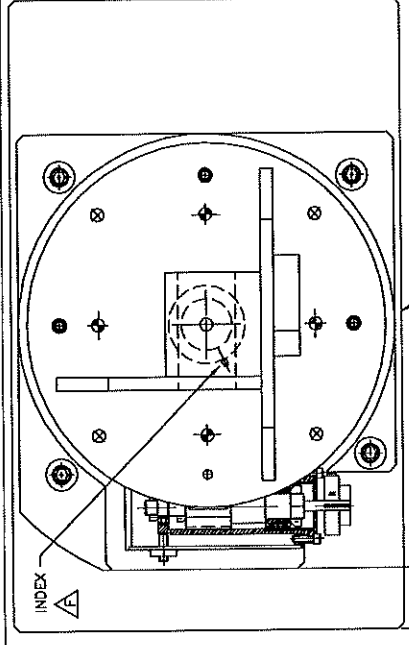

HIRES MAINFRAME
ADAPTER PLATE H4515-1
AND PRELOAD DRUM, H4520-1 NOT
SHOWN

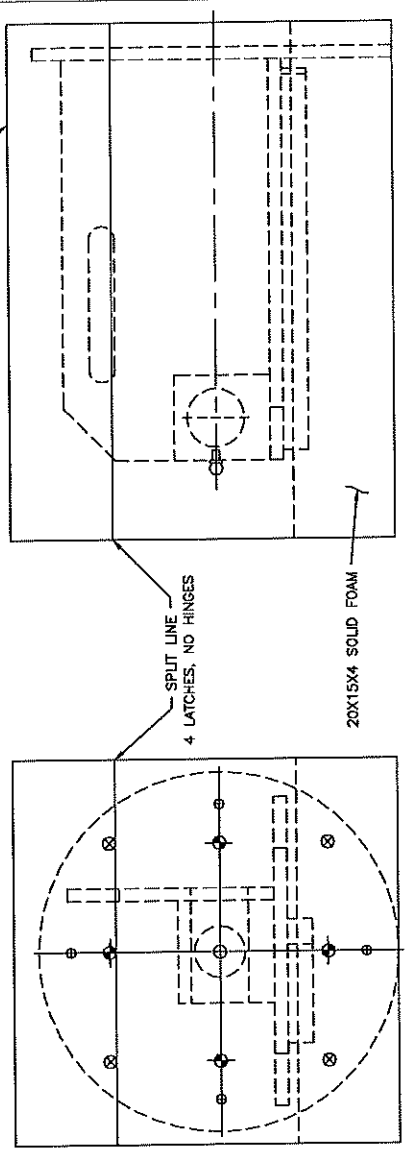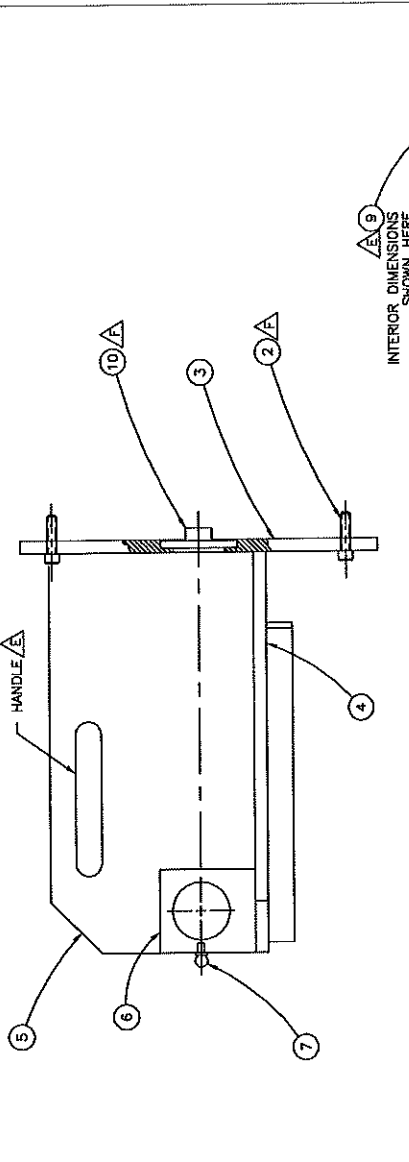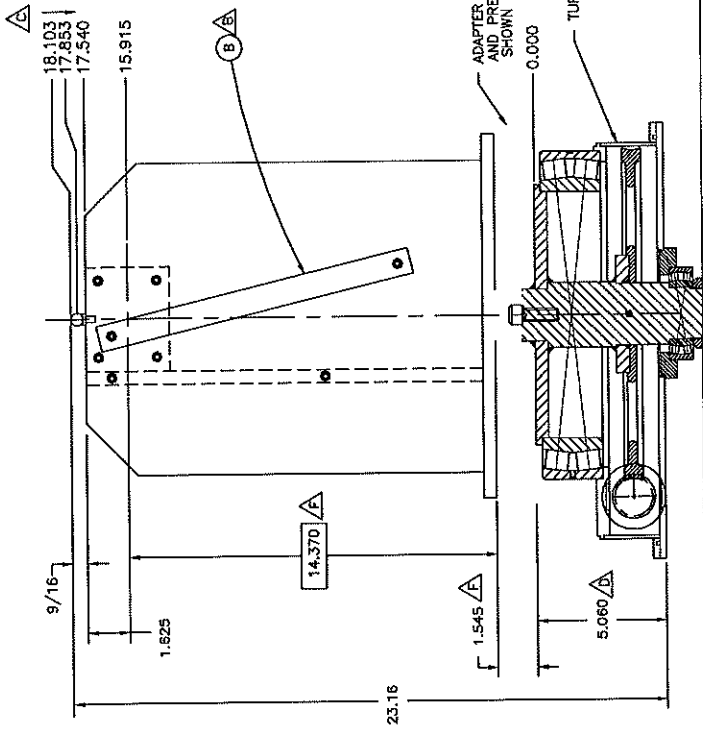

⊖ AUTO-COLLIMATOR HOLDER

- 1 REQ'D TURNTABLE: REF H4260/A
- NOTES:
 - 1. DAVIDSON OPTRONICS DZ75 ALIGNMENT TELESCOPE, AUTOCOLLIMATING.
 - 2. RED ANODIZE ALL PARTS.
 - 3. SCHRY-WAY CASE: MDS0-20X15X11-4


VENDOR:
SCHRY-WAY CASES
ONE WEST MOUNTAIN ST
PASADENA, CA
818 798-1166

A	H4212-1	10	1	PILOT	ALUM
B	H4211-5	9	1	LOCK	NOTE 3
C	H4211-5	9	1	LEVEL REST	ALUM
D	H4211-5	9	1	LEVEL REST	ALUM
E	H4211-5	9	1	BUSSING BLOCK	ALUM
F	H4211-5	9	1	BRIDGE	ALUM
G	H4211-5	9	1	BRIDGE	ALUM
H	H4211-5	9	1	BRIDGE PLATE	ALUM
I	H4211-5	9	1	BRIDGE PLATE	ALUM
1/2
KECK/HIRES
ALIGNMENT FIXTURE
CROSS-DISPERSER
H4210.F

A	1-1/2" I.D.	AND AUTOCOLLIMATOR WIRE
B	1-1/2" I.D.	AND WIRE AT END OF LOCK CHAIN
C	1-1/2" I.D.	AND WIRE AT END OF LOCK CHAIN
SHOWN BY 1.544 MOVES TO TOP OF
CONTING ADAPTER PLATE, H4210-1

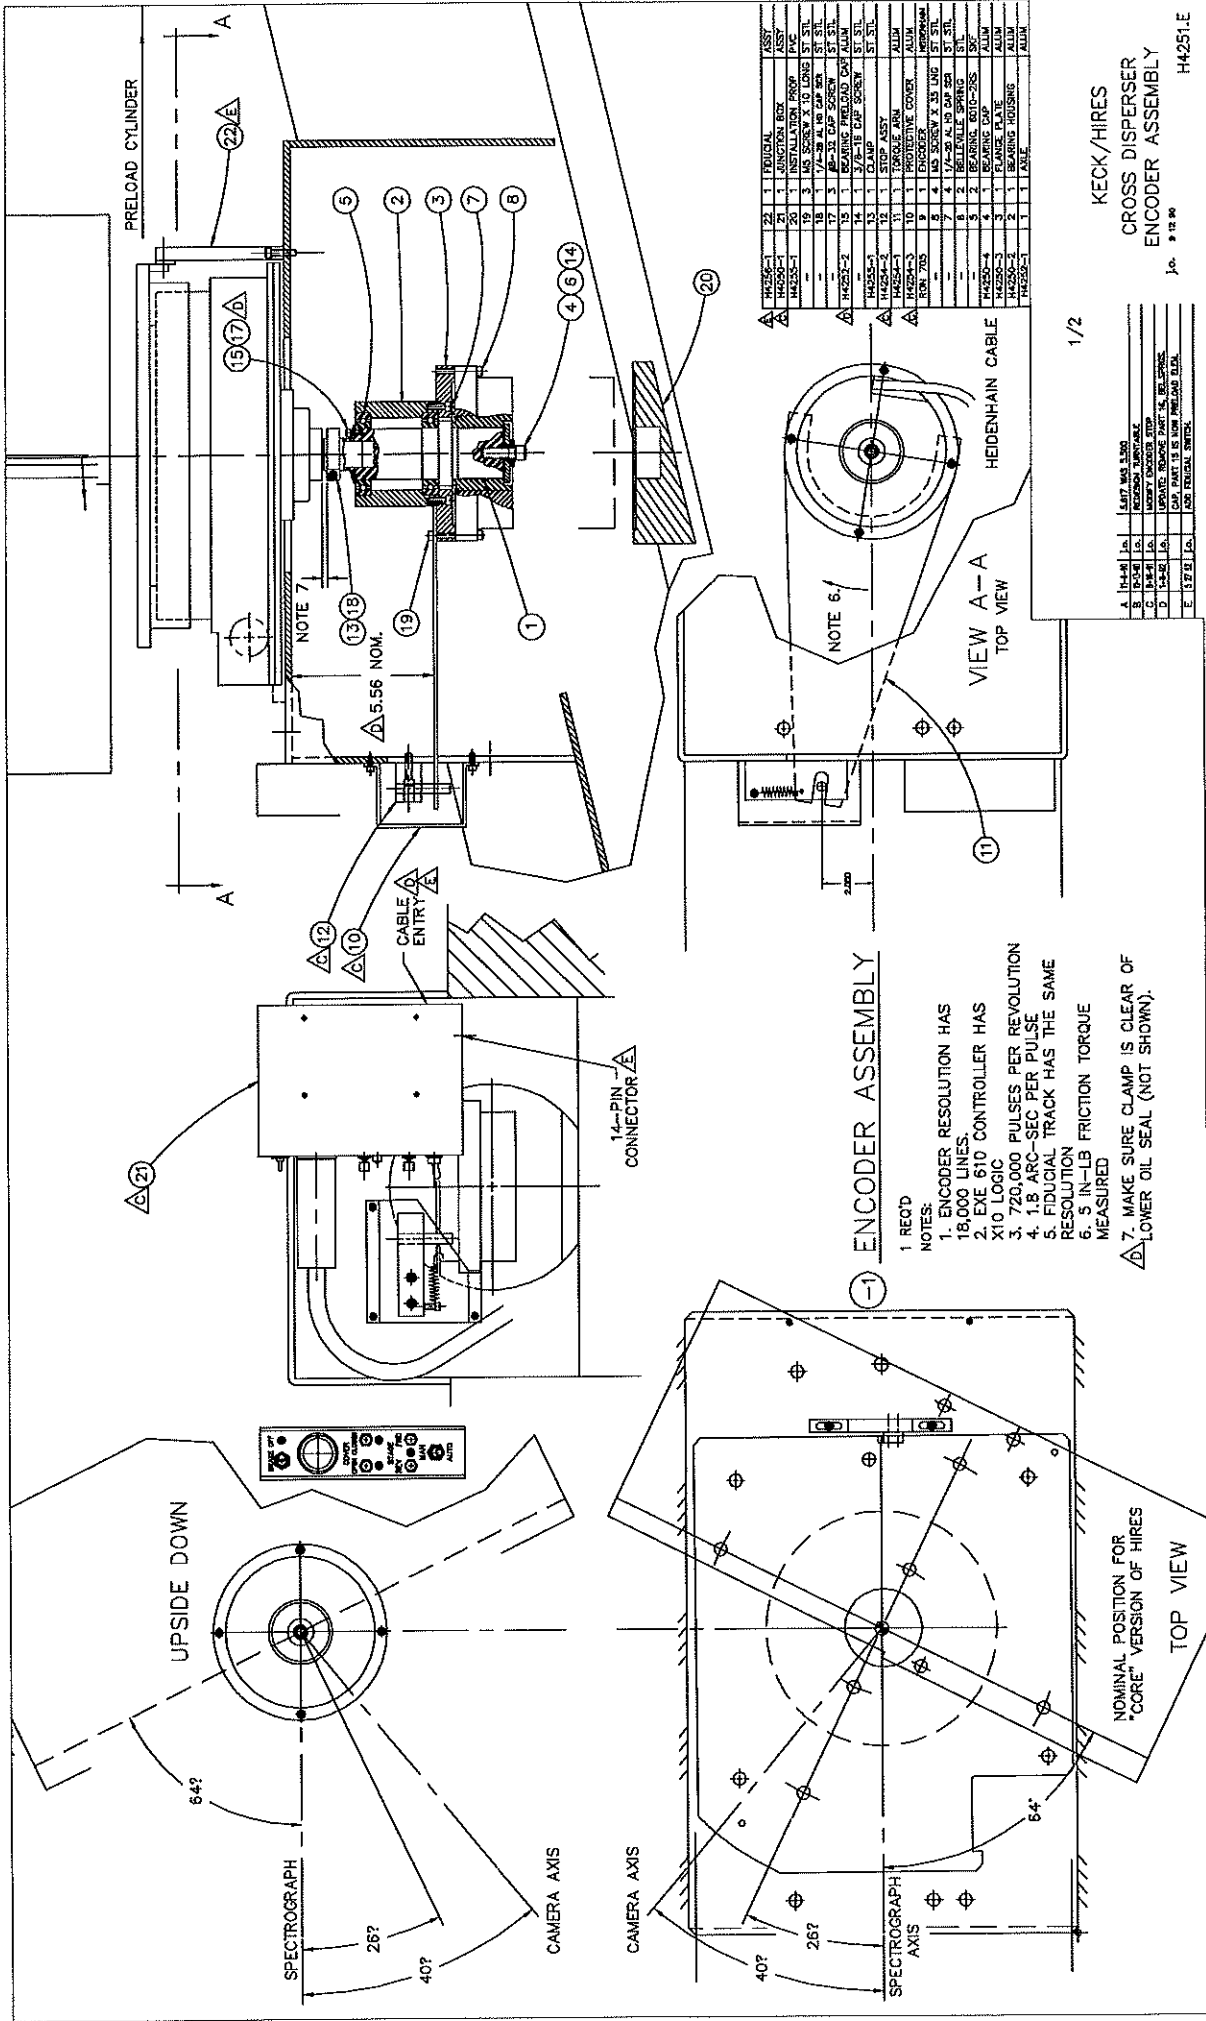

ENCODER ASSEMBLY

- 1 REQ'D
- NOTES:
1. ENCODER RESOLUTION HAS 18,000 LINES.
 2. EXE 610 CONTROLLER HAS X10 LOGIC
 3. 720,000 PULSES PER REVOLUTION
 4. 1.8 ARC-SEC PER PULSE
 5. FIDUCIAL TRACK HAS THE SAME RESOLUTION
 6. 5 IN.-LB FRICTION TORQUE MEASURED
 7. MAKE SURE CLAMP IS CLEAR OF LOWER OIL SEAL (NOT SHOWN).


QTY	DESCRIPTION	ASSY
1	PRELOAD ROLLER	ASSY
1	FUNCTION ROLLER	ASSY
1	INSTALLATION PROP	FACE
3	LNK. SCREW X 10 LONG	ST. STL.
1	1/2-20 X 1/2 CAP. SCW	ST. STL.
1	BEARING PRELOAD CAP	ALUM.
1	1/2-20 X 1/2 CAP. SCW	ST. STL.
1	CLAMP	ASSY
1	STOP ASST	ASSY
1	ENCODER HOUSING	ALUM.
1	ENCODER COVER	ALUM.
1	ENCODER	ALUM.
4	LNK. SCREW X 35 LONG	ST. STL.
4	1/2-20 X 1/2 CAP. SCW	ST. STL.
2	BEARING CAP	ALUM.
2	BEARING	ALUM.
1	FLANGE PLATE	ALUM.
1	BEARING HOUSING	ALUM.
1	TABLE	ALUM.

KECK/HIRES
 CROSS DISPERSER
 ENCODER ASSEMBLY
 Jc. 9 12 80
 H4251.E

REV	DATE	BY	CHKD	DESCRIPTION
A	11-4-80	Jc.		1.877 MAT. 3.000
B	1-24-81	Jc.		1.877 MAT. 3.000
C	1-24-81	Jc.		1.877 MAT. 3.000
D	1-24-81	Jc.		1.877 MAT. 3.000
E	1-24-81	Jc.		1.877 MAT. 3.000

1/2

NOMINAL POSITION FOR
 "CORE" VERSION OF HIRES
 TOP VIEW

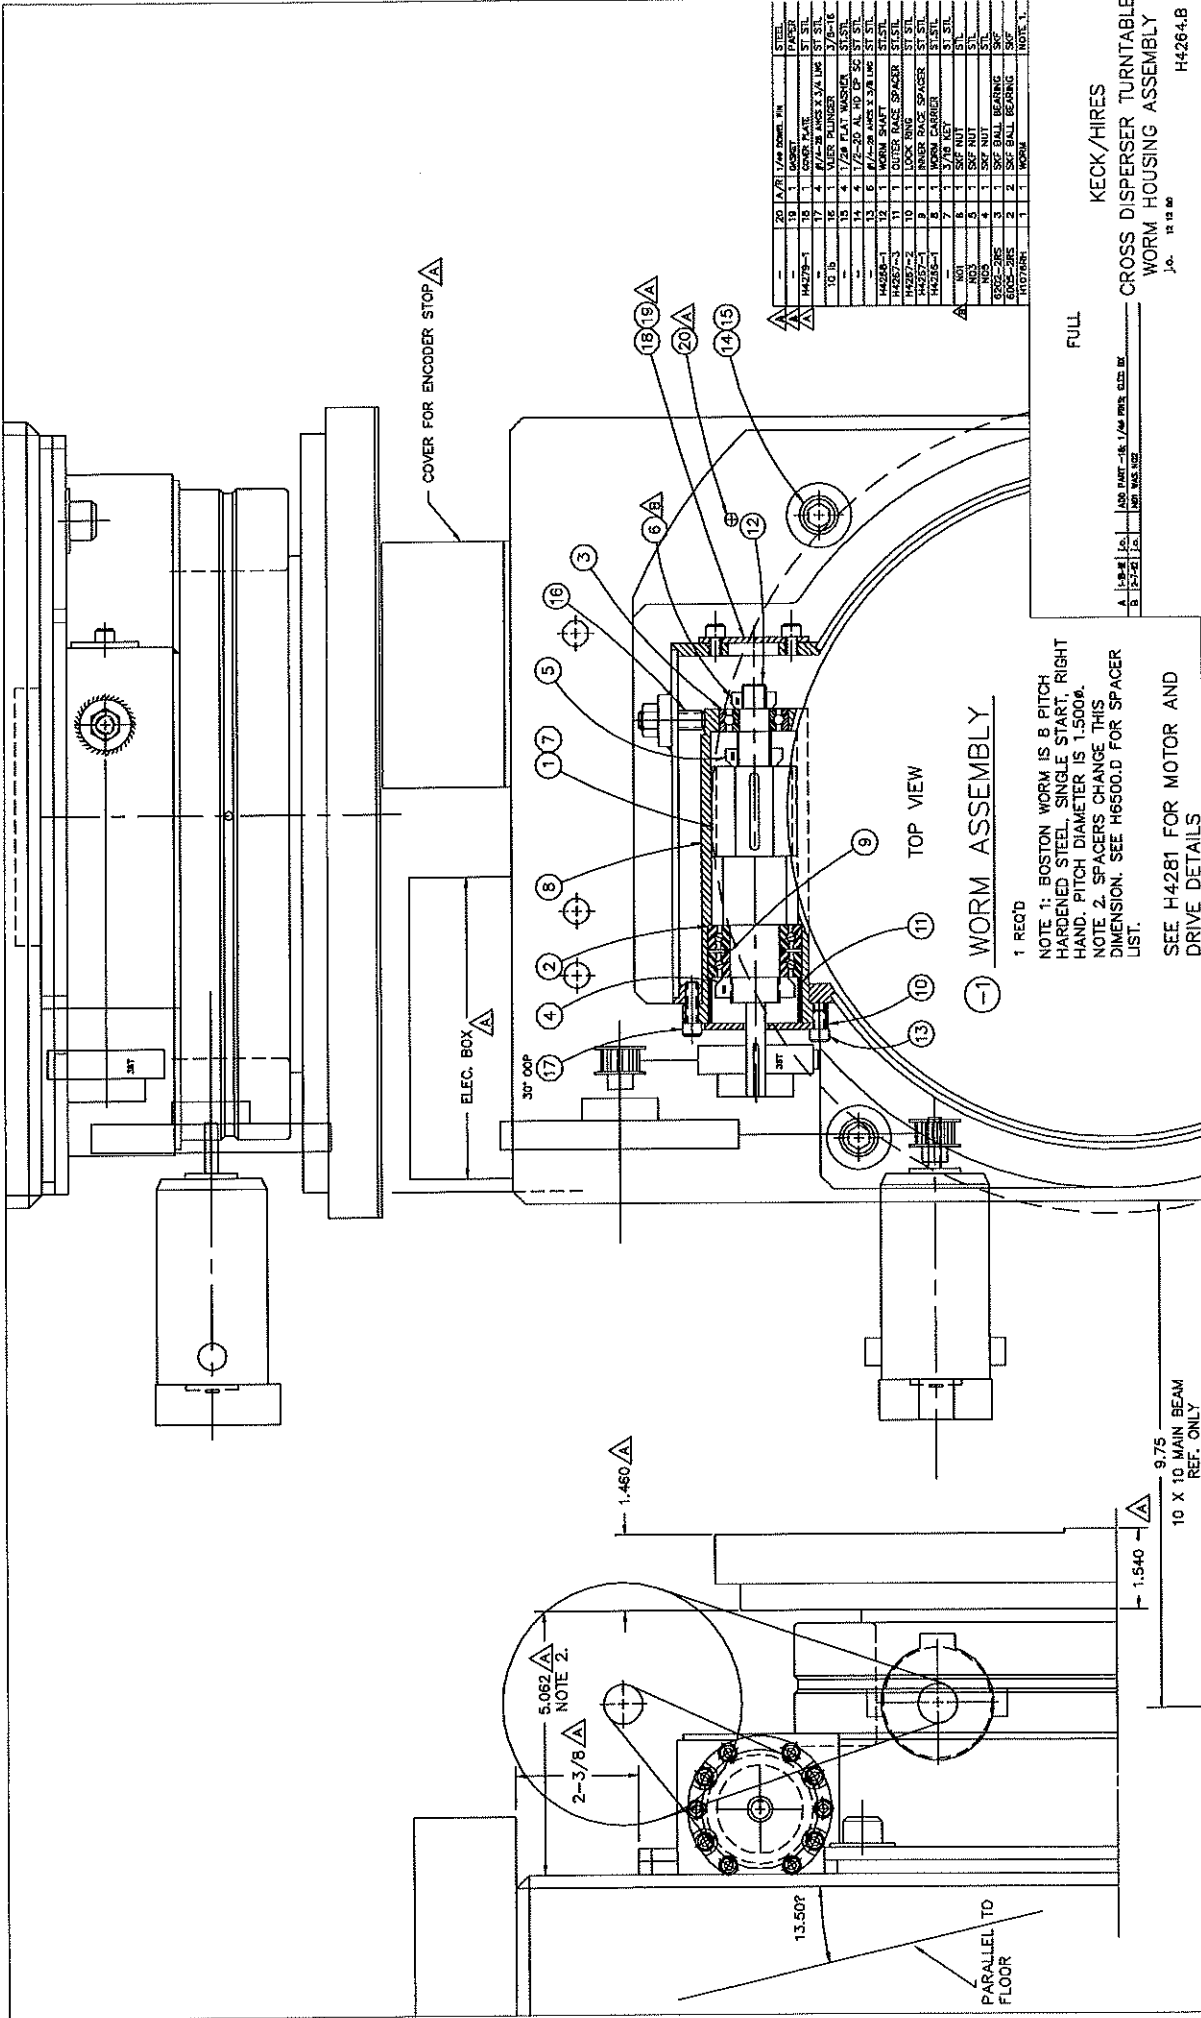

COVER FOR ENCODER STOP

ELEC. BOX

30" ODP

TOP VIEW

WORM ASSEMBLY




1 REQ'D

NOTE 1: BOSTON WORM IS 8 PITCH HARDENED STEEL, SINGLE START, RIGHT HAND. PITCH DIAMETER IS 1.5000.
NOTE 2: SPACERS CHANGE THIS DIMENSION. SEE H6500.D FOR SPACER LIST.

SEE H4281 FOR MOTOR AND DRIVE DETAILS

FULL

A 1/8" DIA. 1/4" DIA. 1/2" DIA. 3/4" DIA. 1" DIA. 1 1/2" DIA. 2" DIA. 3" DIA. 4" DIA. 5" DIA. 6" DIA. 8" DIA. 10" DIA. 12" DIA. 14" DIA. 16" DIA. 18" DIA. 20" DIA. 24" DIA. 30" DIA. 36" DIA. 42" DIA. 48" DIA. 54" DIA. 60" DIA. 72" DIA. 84" DIA. 96" DIA. 108" DIA. 120" DIA. 144" DIA. 168" DIA. 192" DIA. 216" DIA. 240" DIA. 288" DIA. 336" DIA. 384" DIA. 432" DIA. 480" DIA. 576" DIA. 672" DIA. 768" DIA. 864" DIA. 960" DIA. 1080" DIA. 1200" DIA. 1344" DIA. 1488" DIA. 1632" DIA. 1776" DIA. 1920" DIA. 2160" DIA. 2400" DIA. 2700" DIA. 3000" DIA. 3360" DIA. 3744" DIA. 4128" DIA. 4512" DIA. 4896" DIA. 5280" DIA. 5760" DIA. 6240" DIA. 5

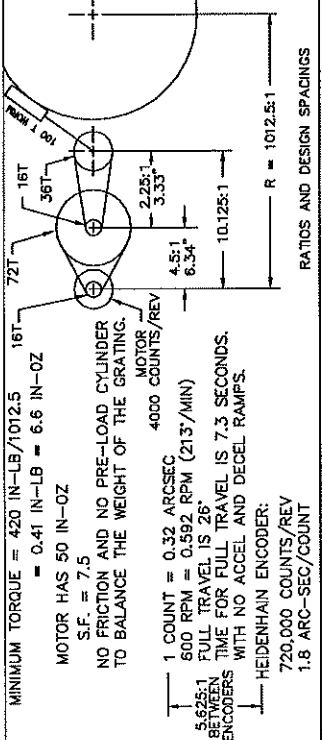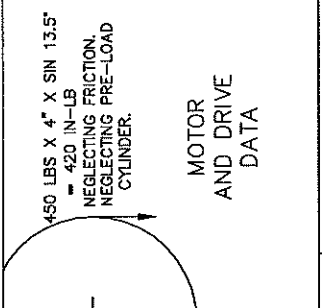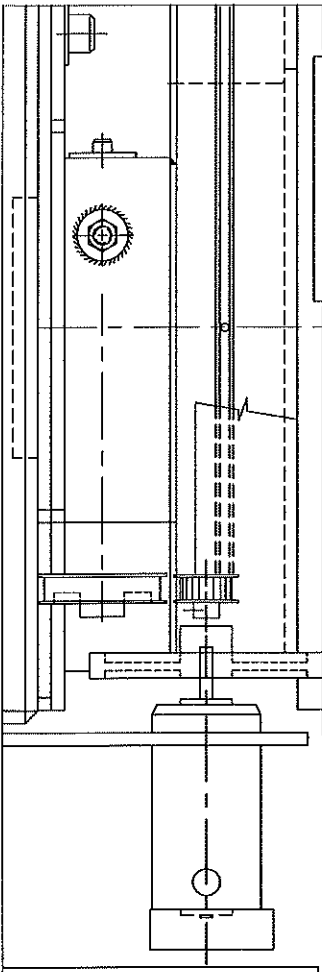


DRIVE ASSEMBLY


1. RECD

NOTES:

- 0.25 AT THIS SLOT IS 0.145 AT JACKSHAFT.
- SEE H4289 FOR OUTLINE DWG
- SPACERS ADDED FOR SPROCKET CLEARANCE.

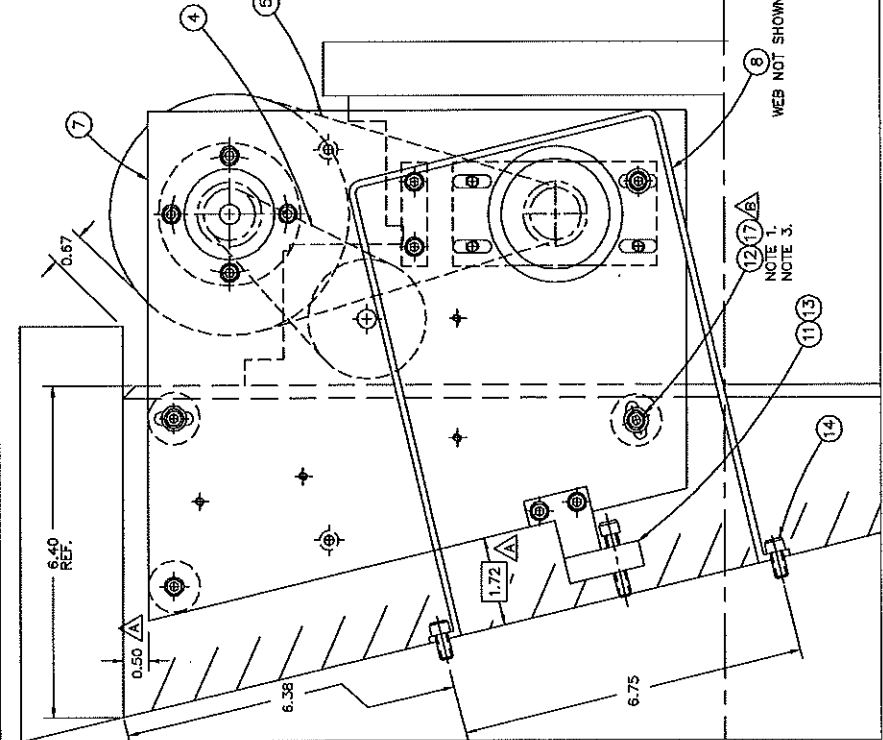

17	3	5/16 THK SPROCKET	18	ALUM
18	1	5/16 ASY	19	STL
19	1	5/16 ASY	20	STL
20	1	1/4-28 AL HD CP SS	21	STL
21	3	1/4-28 ADJUST. SCR	22	STL
22	3	1/4-28 AL HD CP SS	23	STL
23	3	1/4-28 ADJUST. SCR	24	STL
24	3	1/4-28 AL HD CP SS	25	STL
25	3	1/4-28 ADJUST. SCR	26	STL
26	3	1/4-28 AL HD CP SS	27	STL
27	3	1/4-28 ADJUST. SCR	28	STL
28	3	1/4-28 AL HD CP SS	29	STL
29	3	1/4-28 ADJUST. SCR	30	STL
30	3	1/4-28 AL HD CP SS	31	STL
31	3	1/4-28 ADJUST. SCR	32	STL
32	3	1/4-28 AL HD CP SS	33	STL
33	3	1/4-28 ADJUST. SCR	34	STL
34	3	1/4-28 AL HD CP SS	35	STL
35	3	1/4-28 ADJUST. SCR	36	STL
36	3	1/4-28 AL HD CP SS	37	STL
37	3	1/4-28 ADJUST. SCR	38	STL
38	3	1/4-28 AL HD CP SS	39	STL
39	3	1/4-28 ADJUST. SCR	40	STL
40	3	1/4-28 AL HD CP SS	41	STL
41	3	1/4-28 ADJUST. SCR	42	STL
42	3	1/4-28 AL HD CP SS	43	STL
43	3	1/4-28 ADJUST. SCR	44	STL
44	3	1/4-28 AL HD CP SS	45	STL
45	3	1/4-28 ADJUST. SCR	46	STL
46	3	1/4-28 AL HD CP SS	47	STL
47	3	1/4-28 ADJUST. SCR	48	STL
48	3	1/4-28 AL HD CP SS	49	STL
49	3	1/4-28 ADJUST. SCR	50	STL
50	3	1/4-28 AL HD CP SS	51	STL
51	3	1/4-28 ADJUST. SCR	52	STL
52	3	1/4-28 AL HD CP SS	53	STL
53	3	1/4-28 ADJUST. SCR	54	STL
54	3	1/4-28 AL HD CP SS	55	STL
55	3	1/4-28 ADJUST. SCR	56	STL
56	3	1/4-28 AL HD CP SS	57	STL
57	3	1/4-28 ADJUST. SCR	58	STL
58	3	1/4-28 AL HD CP SS	59	STL
59	3	1/4-28 ADJUST. SCR	60	STL
60	3	1/4-28 AL HD CP SS	61	STL
61	3	1/4-28 ADJUST. SCR	62	STL
62	3	1/4-28 AL HD CP SS	63	STL
63	3	1/4-28 ADJUST. SCR	64	STL
64	3	1/4-28 AL HD CP SS	65	STL
65	3	1/4-28 ADJUST. SCR	66	STL
242	3	1/4-28 AL HD CP SS	243	STL
243	3	1/4-28 ADJUST. SCR	244	STL
244	3	1/4-28 AL HD CP SS	245	STL
245	3	1/4-28 ADJUST. SCR	246	STL
246	3	1/4-28 AL HD CP SS	247	STL
247	3	1/4-28 ADJUST. SCR	248	STL
248	3	1/4-28 AL HD CP SS	249	STL
249	3	1/4-28 ADJUST. SCR	250	STL
250	3	1/4-28 AL HD CP SS	251	STL
251	3	1/4-28 ADJUST. SCR	252	STL
252	3	1/4-28 AL HD CP SS	253	STL
253	3	1/4-28 ADJUST. SCR	254	STL
254	3	1/4-28 AL HD CP SS	255	STL
255	3	1/4-28 ADJUST		

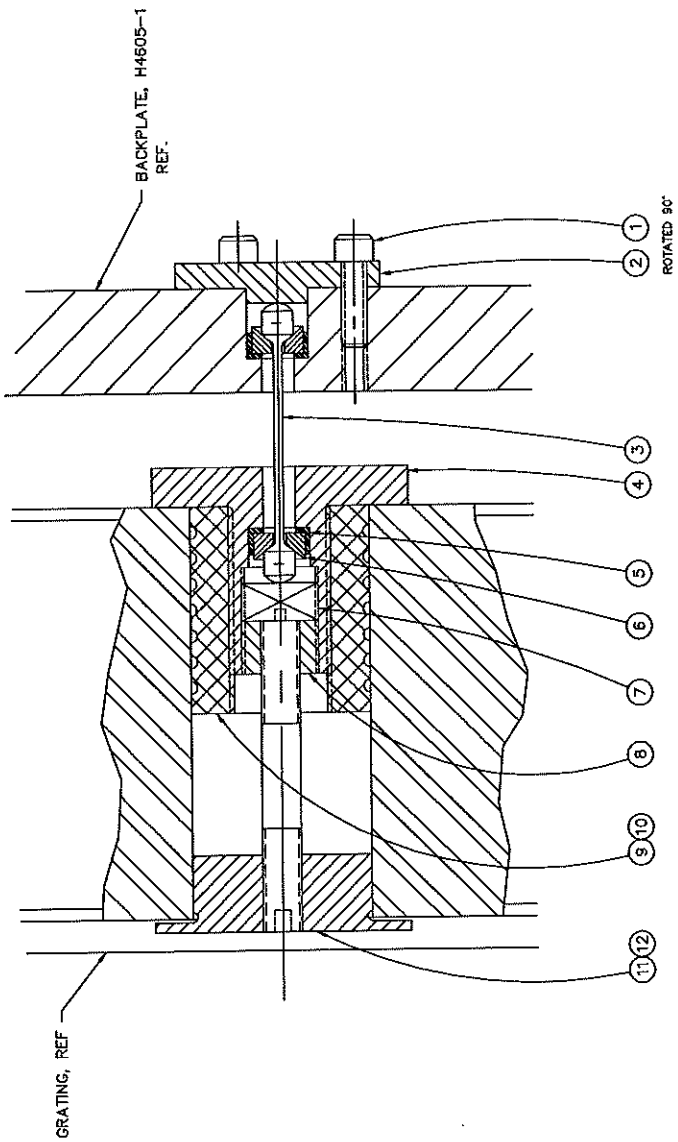


2X SIZE

H3310-8	12	1	3/7624	STL	ST STL
H3310-9	10	1	3/7624	STL	ST STL
H3310-10	10	1	3/7624	STL	ST STL
H3310-11	8	1	1/4" INSERT	ST STL	ST STL
H3310-12	8	1	LOCK	ST STL	ST STL
H3310-13	7	1	PLUG	ST STL	ST STL
H3310-14	8	2	RETAINER	ST STL	ST STL
H3310-15	4	1	WALWIER	ST STL	ST STL
H3310-16	2	1	COLUMN	ST STL	ST STL
H3310-17	2	1	CAP	ST STL	ST STL
H3310-18	1	1	1/4" 205	STL	ST STL


KECK/HIRES
 CROSS DISPERSER SUBPLATE
 COLUMN SUPPORT ASSY
 H4300

FULL
 REV

① COLUMN SUPPORT
 3 REQD
 FOR ASSY/DISASSY. SEE H3320

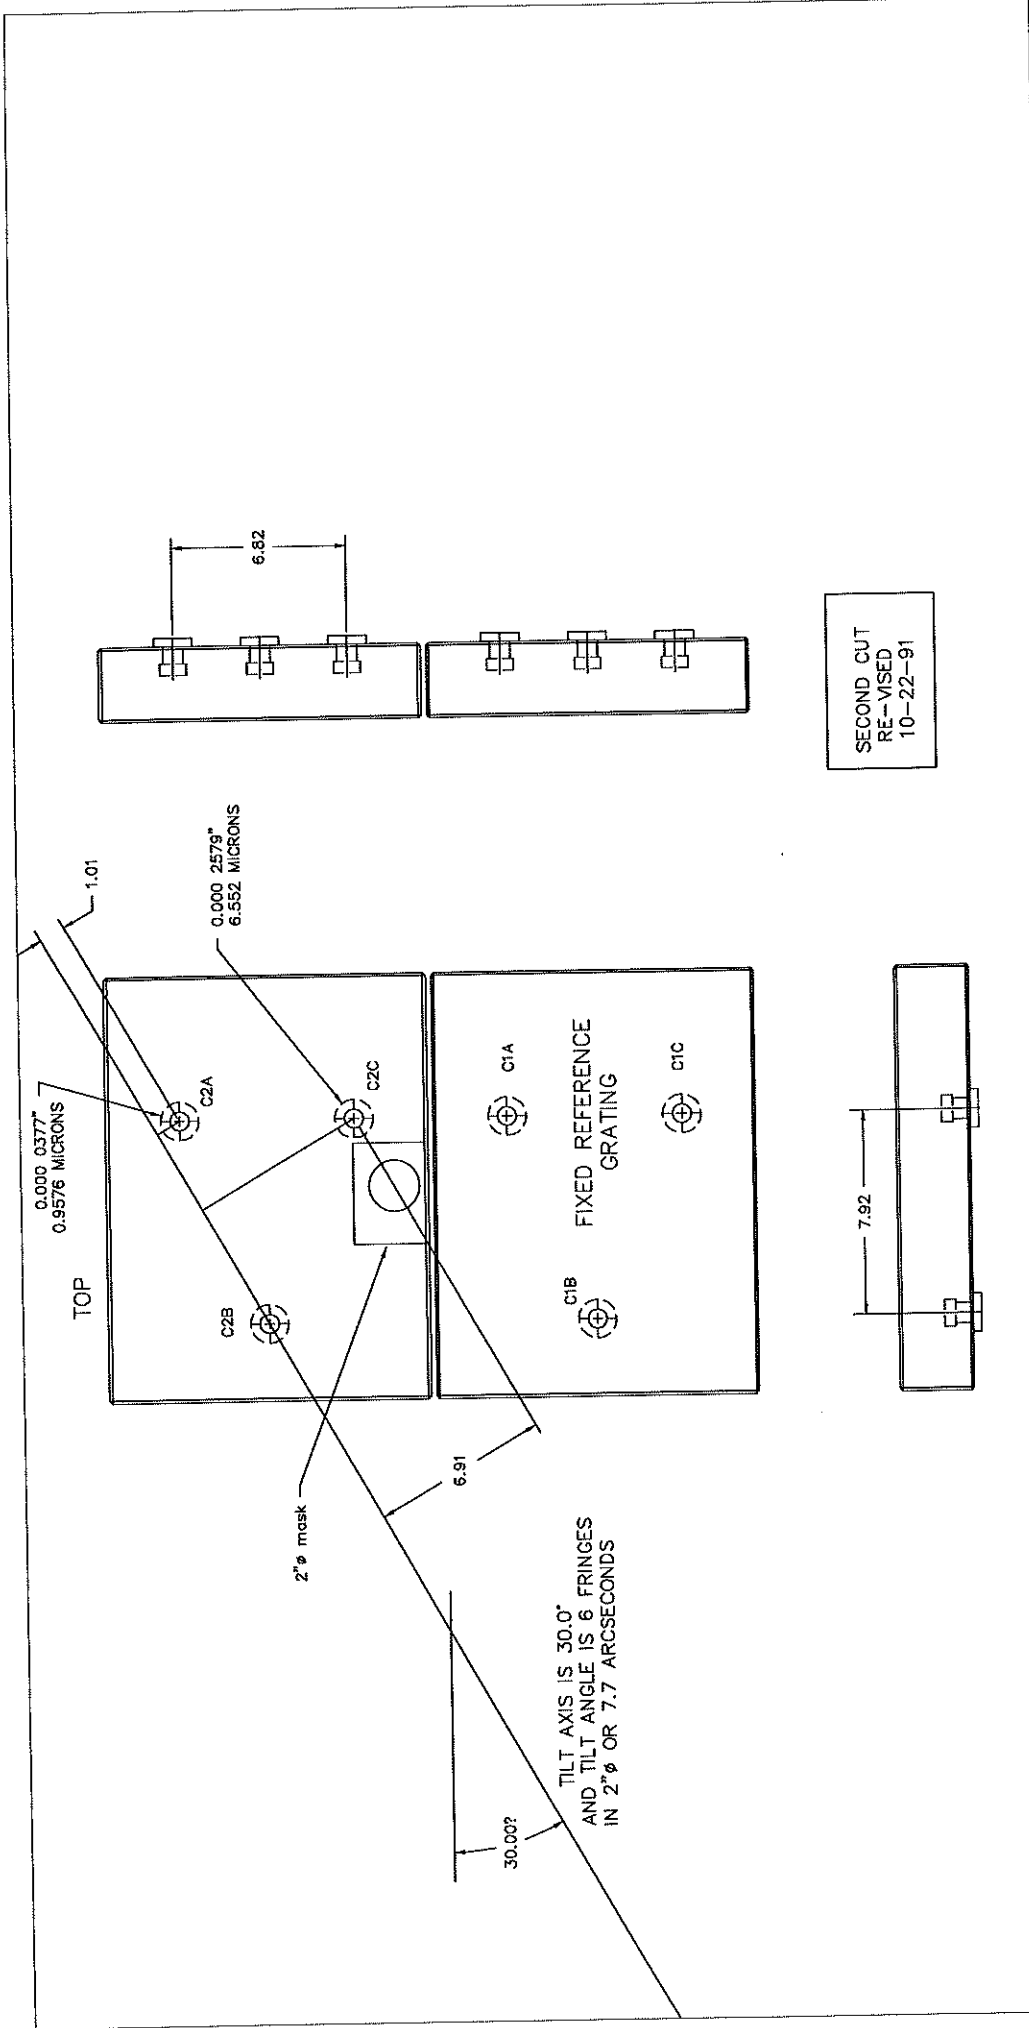

SECOND CUT
RE-VISED
10-22-91

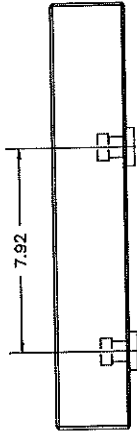

1/2

TILT AXIS IS 30.0°
AND TILT ANGLE IS 6 FRINGES
IN 2"φ OR 7.7 ARCSECONDS

30.00?

2"φ mask

TOP

0.000 0377"
0.9576 MICRONS

0.000 2579"
6.552 MICRONS

1.01

C2A

C2C

C2B

C1A


C1C

FIXED REFERENCE
GRATING


6.91

6.82

7.92

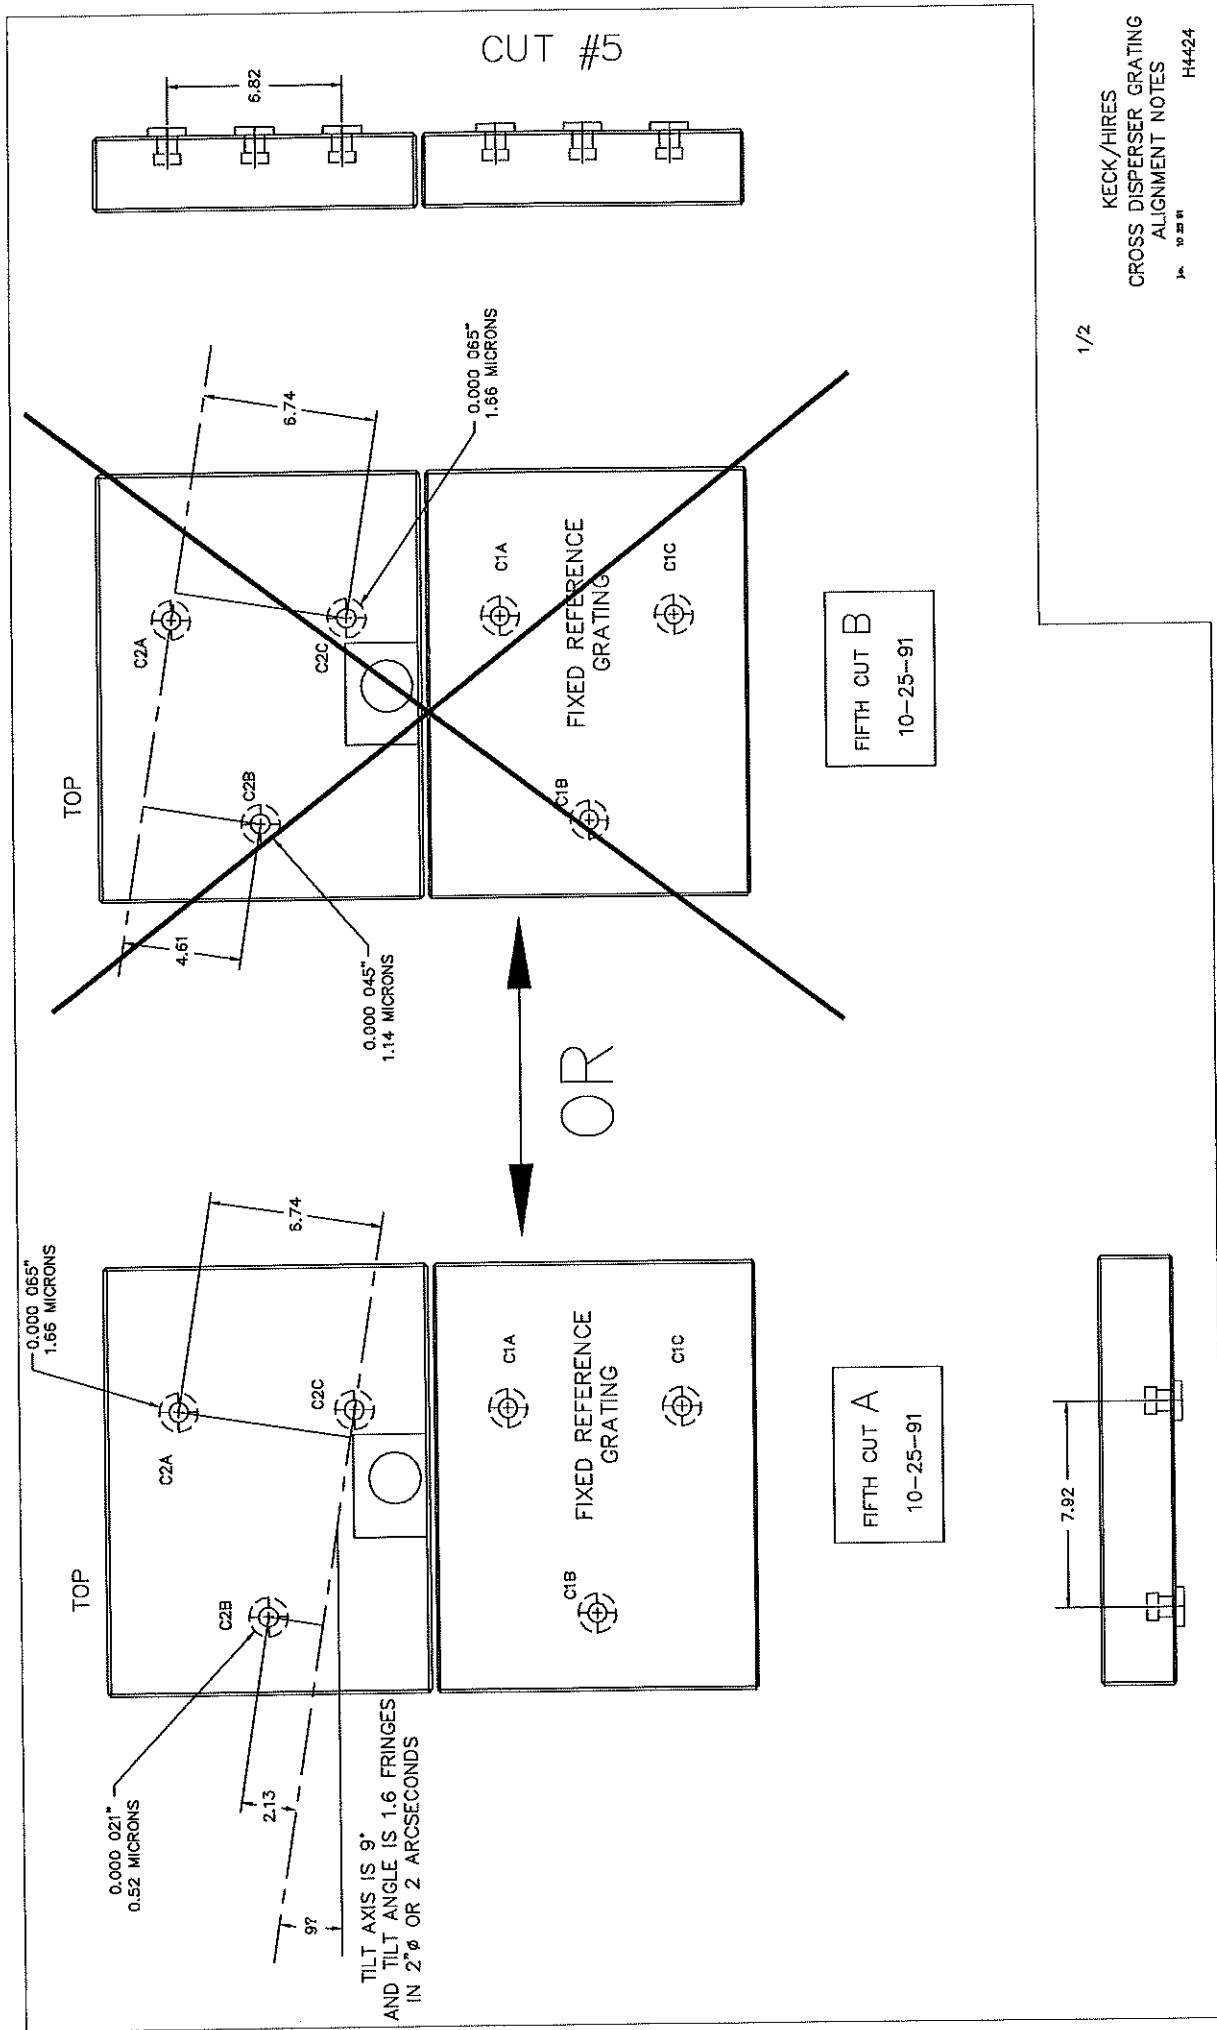


KECK/HIRES
 CROSS DISPERSER GRATING
 ALIGNMENT NOTES
 JAN 19 2 58 PM
 H44424

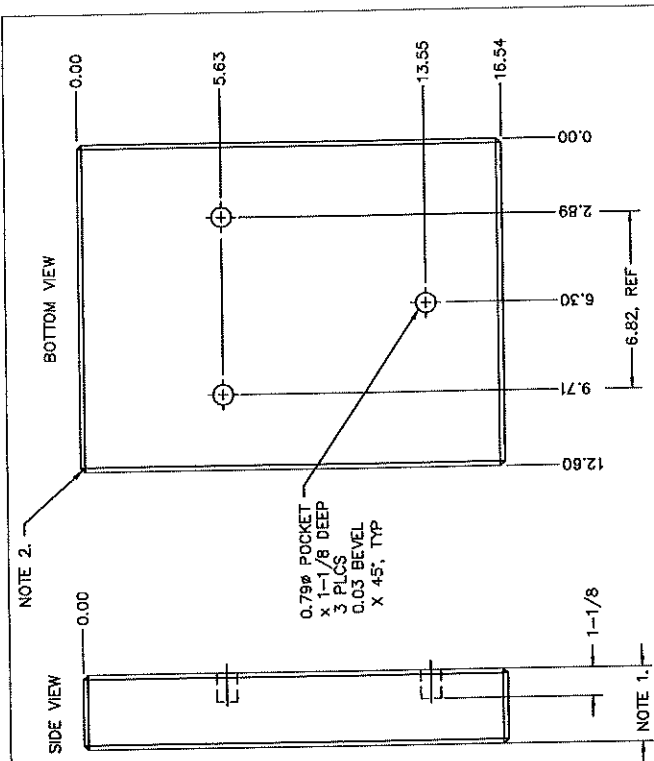

⊖ UPPER GRATING

1 RECD S/N 01 (ZYGO NAME)
ZERODUR
FINISH: POLISH FRONT, REAR
FINE GRIND EDGES, BEVELS
GRIND POCKETS
56 lb BLANK WEIGHT

NOTES:
⚠ 1. THIS GRATING IS THE SO-CALLED
REPLACEMENT BLANK. IT WAS NOT
PROCESSED WITH THE OTHER
6 BLANKS. IT IS 0.014" THICKER.
⚠ 2. SEE PART H4450-1 FOR
CHAMFER DETAIL
⚠ MILTON-ROY SERIAL NUMBER: MR 122-2

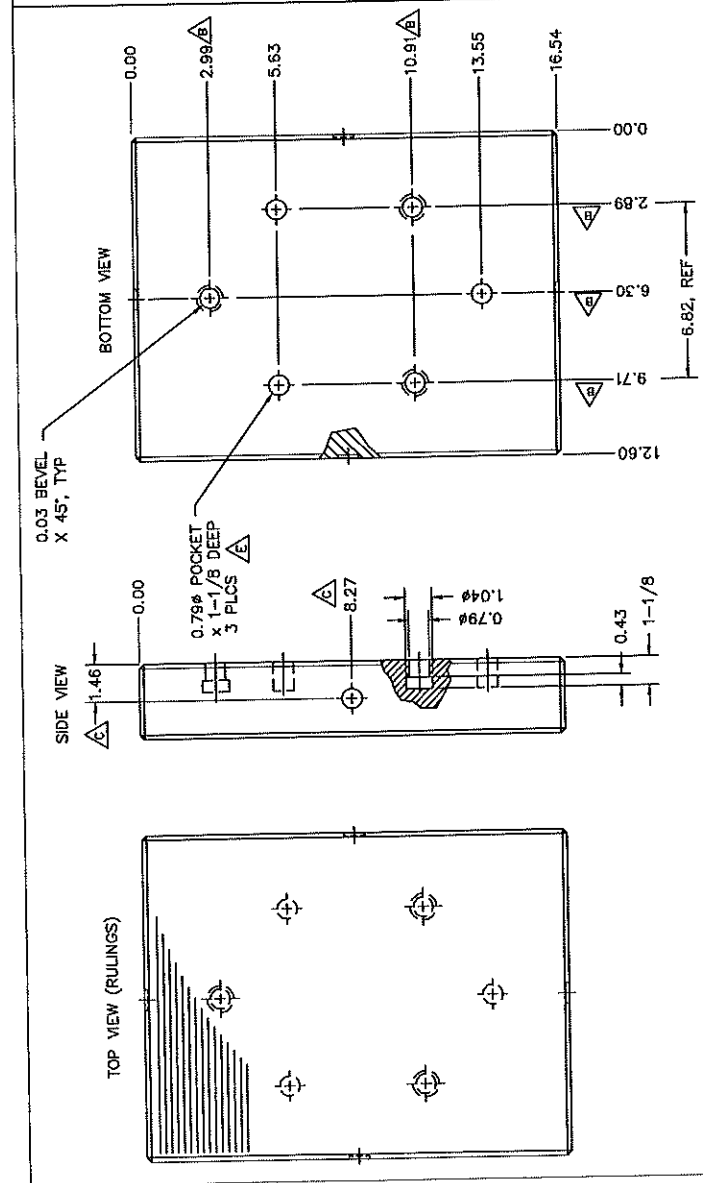


⊖ LOWER GRATING

1 RECD S/N 02 (ZYGO NAME)
ZERODUR
FINISH: POLISH FRONT, REAR
FINE GRIND EDGES, BEVELS
GRIND POCKETS
56 lb BLANK WEIGHT

⚠ MILTON-ROY SERIAL NUMBER: MR 122-3

0.79 ϕ x 1/8 DEEP
POCKETS, 4 PLACES

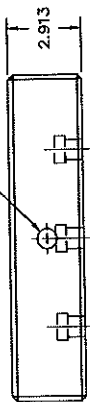

0.177 x 45° CHAMFER
ON ALL CORNERS



CHAMFER DETAIL
FULL SIZE

KECK/HIRES
CROSS DISPERSER GRATING
DETAILS



H4450.F

1/2

ITEM	QTY	DESCRIPTION
A	1	CHANGE CHAMFER WAS 0.10 TOP AND
B	1	0.03 BEVEL
C	1	AND MILTON-ROY SERIAL NUMBERS AND
D	1	REPLACE POCKET POCKETS
E	1	REPLACE POCKET POCKETS
F	1	RESUBMIT DRAWING
G	1	RESUBMIT DRAWING
H	1	RESUBMIT DRAWING
I	1	ITEM NUMBER FOR EACH GRATING

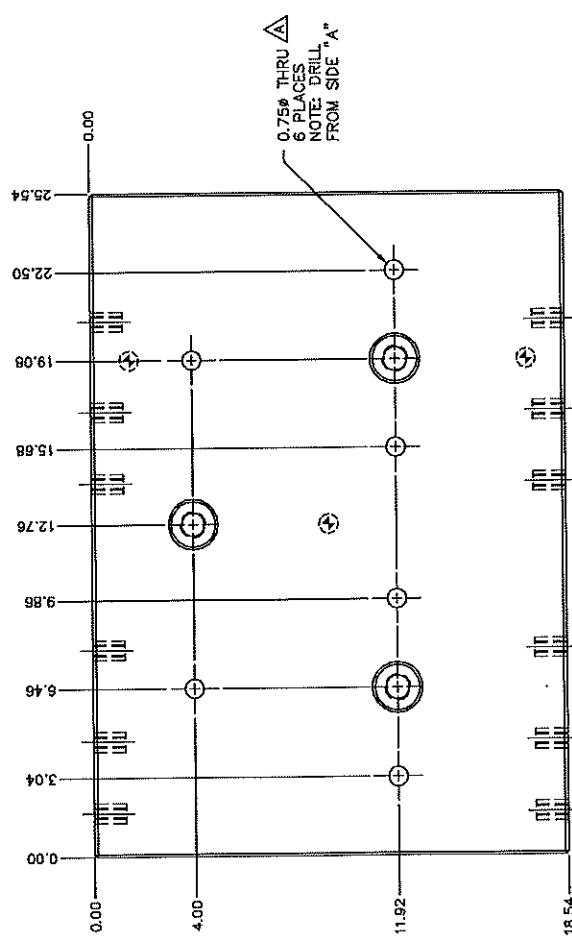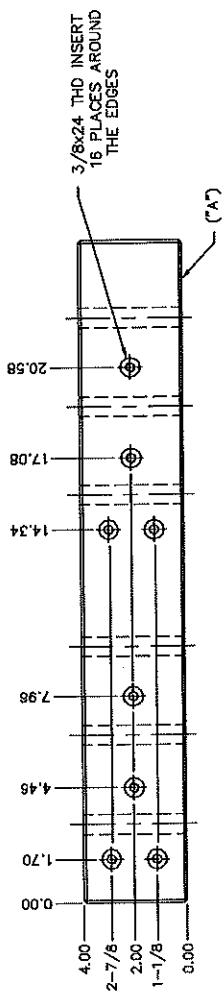

VIEW OF GRATING MOUNTING SURFACE - "A"

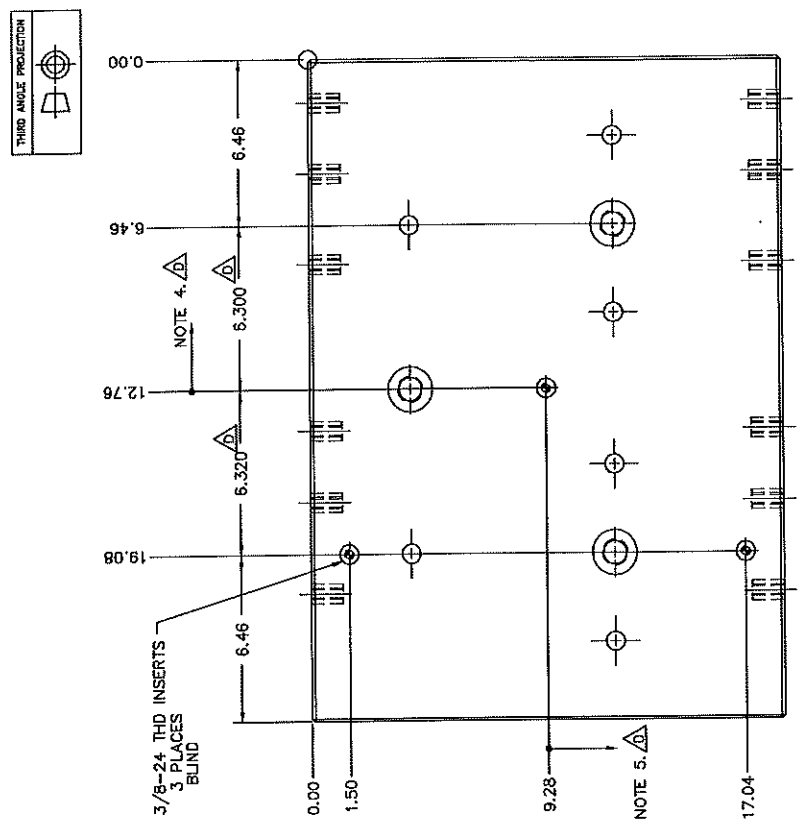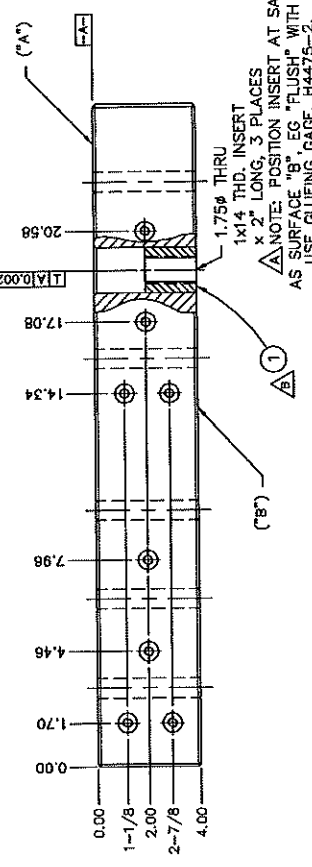

VIEW OF REAR SURFACE - "B"

① SUBPLATE


VENDOR: PYRAMID GRANITE GRANITE "BLACK GABRO" E=12x10³ PSI ESCONDIDO, CA 92025



- NOTES:
1. BREAK ALL CORNERS AND EDGES 0.1 TYPICAL.
 2. GRIND SIDE "A" SMOOTH.
 3. ALL INSERTS TO BE STAINLESS STEEL
 4. THESE FEATURES ARE OFFSET FROM CENTER BY 0.01. THIS WAS BY MISTAKE.
 5. THIS FEATURE IS OFFSET FROM CENTER BY 0.01. THIS WAS BY MISTAKE.
 6. WEIGHT = 206 LBS

1/2

KECK/HIRES
2x1 CROSS DISPERSER
SUBPLATE
H4470.D
K: 7 8 8
CL: 7 8 8

A. ITEM NO	QTY	UNIT	DESCRIPTION
1	1	EA	2x1 CROSS DISPERSER SUBPLATE
2	1	EA	3/8-24 THD INSERT
3	1	EA	1.75 THRU 1x1/4 THD. INSERT

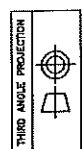

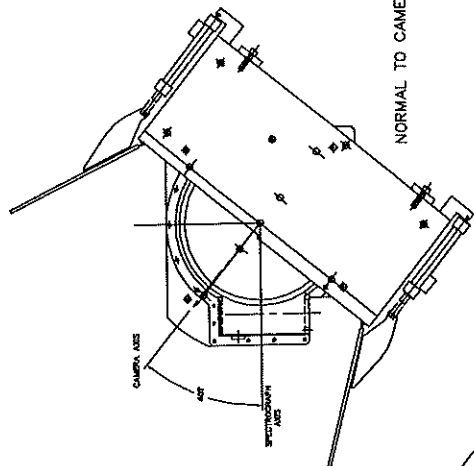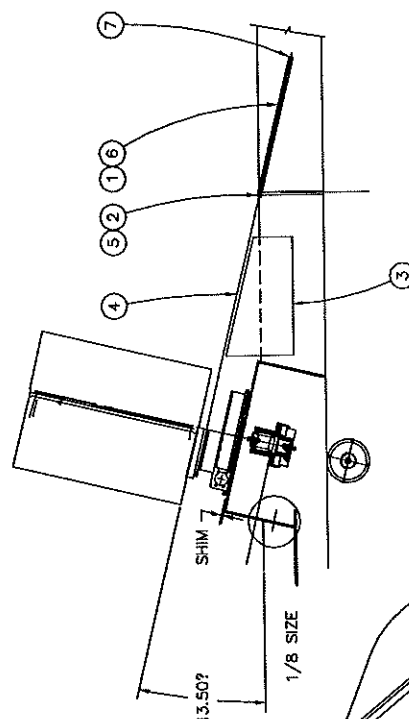

NORMAL TO CAMERA, ROTATED -13°

"MIRROR" MODE, ROTATED +6°

F = 54 LBS

CAMERA AXIS

SPECTROGRAPH AXIS

5-13489-A	7	1	PIVOT BRACKET	ALUM
5-13489-B	8	1	PIVOT BRACKET	ALUM
5-13489-C	9	1	PIVOT BRACKET	ALUM
5-13489-D	10	1	PIVOT BRACKET	ALUM
5-13489-E	11	1	PIVOT BRACKET	ALUM
5-13489-F	12	1	PIVOT BRACKET	ALUM
5-13489-G	13	1	PIVOT BRACKET	ALUM
5-13489-H	14	1	PIVOT BRACKET	ALUM
5-13489-I	15	1	PIVOT BRACKET	ALUM
5-13489-J	16	1	PIVOT BRACKET	ALUM
5-13489-K	17	1	PIVOT BRACKET	ALUM
5-13489-L	18	1	PIVOT BRACKET	ALUM
5-13489-M	19	1	PIVOT BRACKET	ALUM
5-13489-N	20	1	PIVOT BRACKET	ALUM
5-13489-O	21	1	PIVOT BRACKET	ALUM
5-13489-P	22	1	PIVOT BRACKET	ALUM
5-13489-Q	23	1	PIVOT BRACKET	ALUM
5-13489-R	24	1	PIVOT BRACKET	ALUM
5-13489-S	25	1	PIVOT BRACKET	ALUM
5-13489-T	26	1	PIVOT BRACKET	ALUM
5-13489-U	27	1	PIVOT BRACKET	ALUM
5-13489-V	28	1	PIVOT BRACKET	ALUM
5-13489-W	29	1	PIVOT BRACKET	ALUM
5-13489-X	30	1	PIVOT BRACKET	ALUM
5-13489-Y	31	1	PIVOT BRACKET	ALUM
5-13489-Z	32	1	PIVOT BRACKET	ALUM
5-13489-AA	33	1	PIVOT BRACKET	ALUM
5-13489-AB	34	1	PIVOT BRACKET	ALUM
5-13489-AC	35	1	PIVOT BRACKET	ALUM
5-13489-AD	36	1	PIVOT BRACKET	ALUM
5-13489-AE	37	1	PIVOT BRACKET	ALUM
5-13489-AF	38	1	PIVOT BRACKET	ALUM
5-13489-AG	39	1	PIVOT BRACKET	ALUM
5-13489-AH	40	1	PIVOT BRACKET	ALUM
5-13489-AI	41	1	PIVOT BRACKET	ALUM
5-13489-AJ	42	1	PIVOT BRACKET	ALUM
5-13489-AK	43	1	PIVOT BRACKET	ALUM
5-13489-AL	44	1	PIVOT BRACKET	ALUM
5-13489-AM	45	1	PIVOT BRACKET	ALUM
5-13489-AN	46	1	PIVOT BRACKET	ALUM
5-13489-AO	47	1	PIVOT BRACKET	ALUM
5-13489-AP	48	1	PIVOT BRACKET	ALUM
5-13489-AQ	49	1	PIVOT BRACKET	ALUM
5-13489-AR	50	1	PIVOT BRACKET	ALUM
5-13489-AS	51	1	PIVOT BRACKET	ALUM
5-13489-AN	98	1	PIVOT BRACKET	ALUM
5-13489-AO	99	1	PIVOT BRACKET	ALUM
5-13489-AP	100	1	PIVOT BRACKET	ALUM

(-1) TURNTABLE PRELOAD

54 LBS APPLIED ON 15" DRUM WILL BALANCE OFFSET GRATING MOSAIC. (IN THE NOMINAL POSITION ONLY)


- NOTES:
 1. BIMBA CYLINDER #0915-DXYW HAS 15" STROKE, 0.9 TIMES PRESSURE IS FORCE.
 1-1/16" BORE, DOUBLE ACTING, 1/8 NPT THDS.

NOMINAL POSITION FOR "CORE" VERSION OF HIRES


1/2

KECK/HIRES
 CROSS DISPERSER
 PRELOAD DETAIL

H4511.A

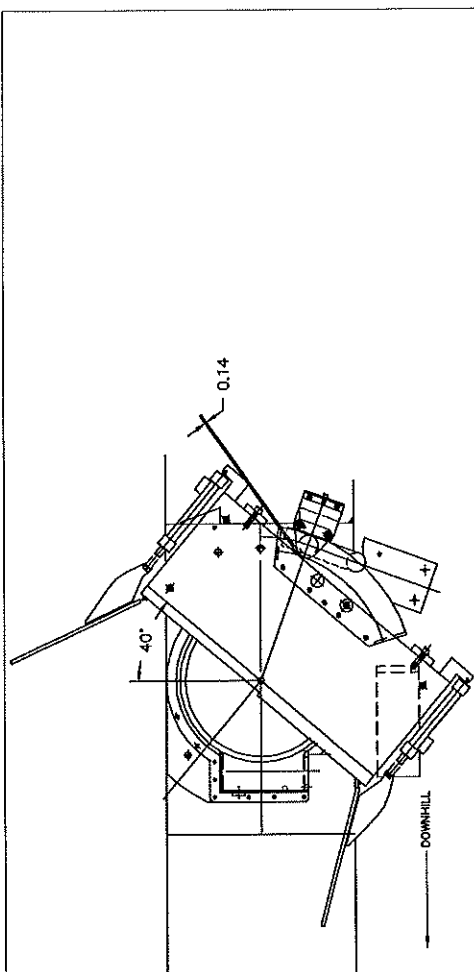

NORMAL TO CAMERA, ROTATED -14° FROM NOMINAL POSITION THIS IS A "HARD" LIMIT


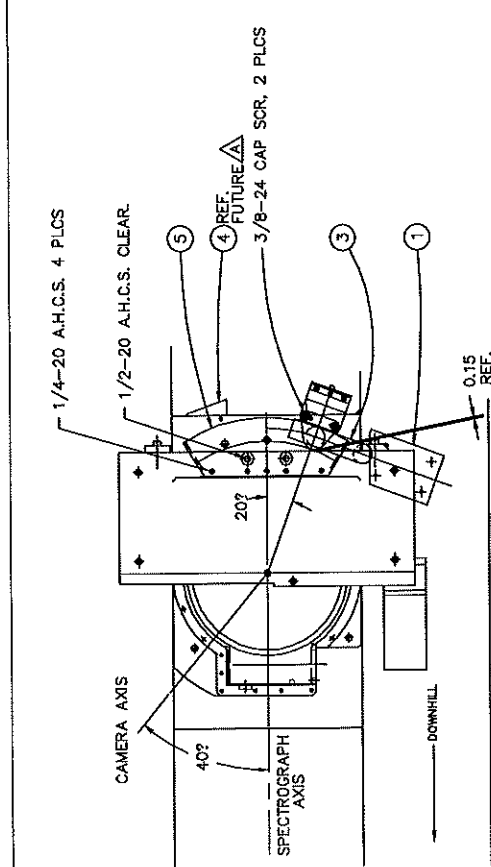


ROTATED +26° FROM NOMINAL THIS IS A "HARD" LIMIT COVERS ARE CLOSED

BRAKE

NOTES:




1. BRAKE FUNCTION IS "NORMALLY ON" THAT IS, WHENEVER THERE IS AIR PRESSURE IN THE HIRES ENCLOSURE, THE BRAKE WILL BE PREVENTING THE STAGE FROM ROTATING. A SIGNAL TO THE SOLENOID VALVE TO STOP THE AIR WILL BE PRESENT BEFORE DRIVING THE STAGE.
2. SEE ALSO H4533 FOR LIMITS
3. SKINNER #V55LB2150-23A, 3-WAY SOLENOID VALVE, 11 WATTS, 1/4NPT PORTS, SS BODY, 1/2NPT CONDUIT OUTLET.

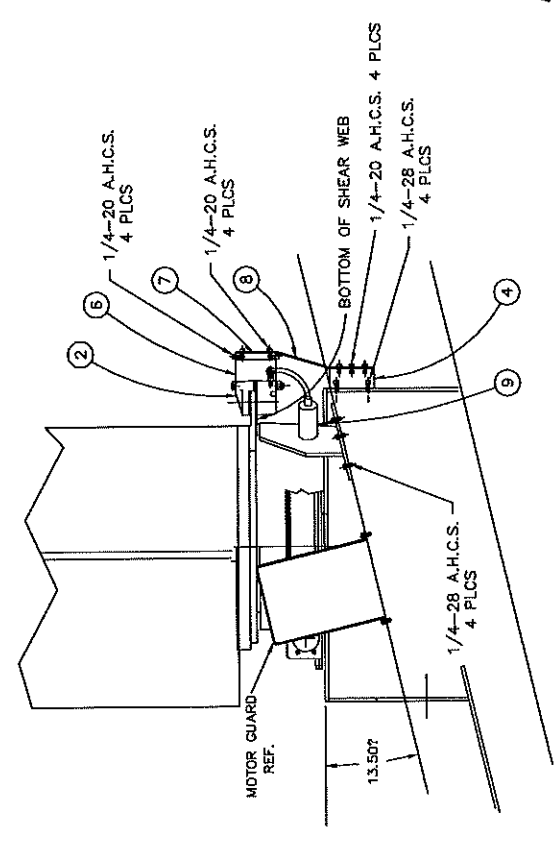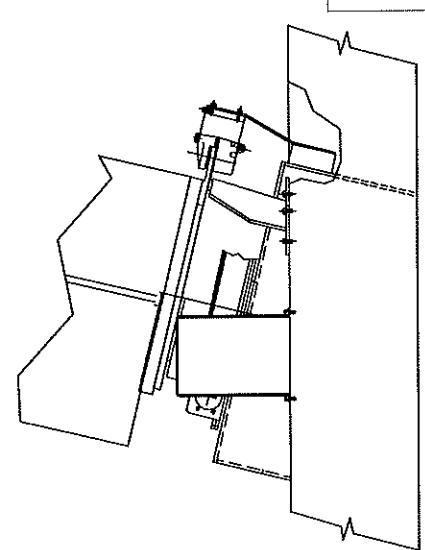

NOTE	QTY	DESCRIPTION	MATERIAL
1	1	SOLENOID VALVE	STEEL
2	1	BRACKET	STEEL
3	1	PLATE	ALUM
4	2	PLATE	STEEL
5	2	PLATE	STEEL
6	2	PLATE	ALUM
7	2	PLATE	ALUM
8	2	MOUNT BLOCK	ALUM
9	2	SPRING WEB	STEEL
10	2	1/4-28 A.H.C.S.	STEEL
11	2	1/4-20 A.H.C.S.	STEEL

KECK/HIRES
CROSS-DISPERSER
BRAKE SUPPORT ASSY
J.G. 3 20 82
H4534.B

A. 1/4-28 A.H.C.S.
B. 1/4-20 A.H.C.S.
C. 1/4-20 A.H.C.S.

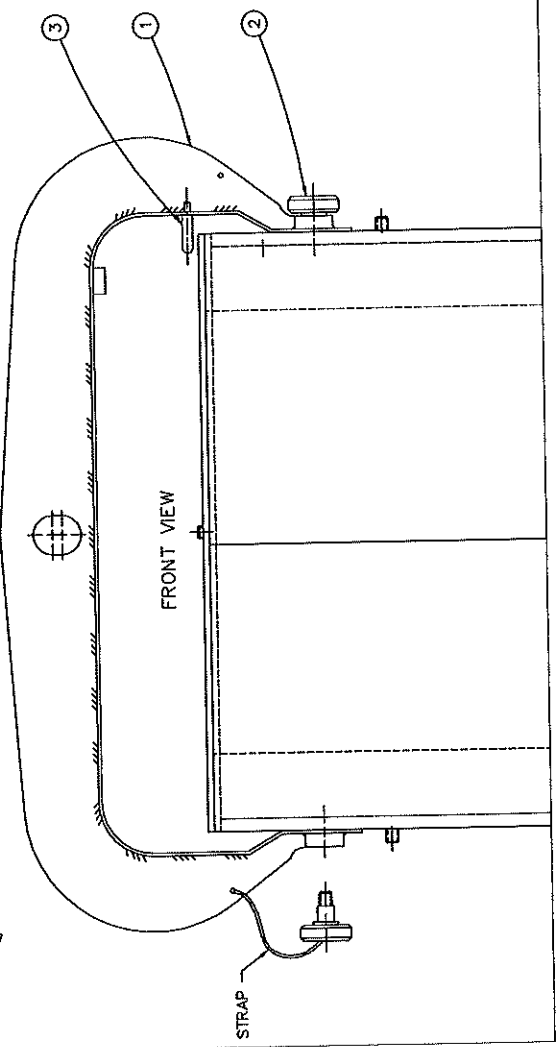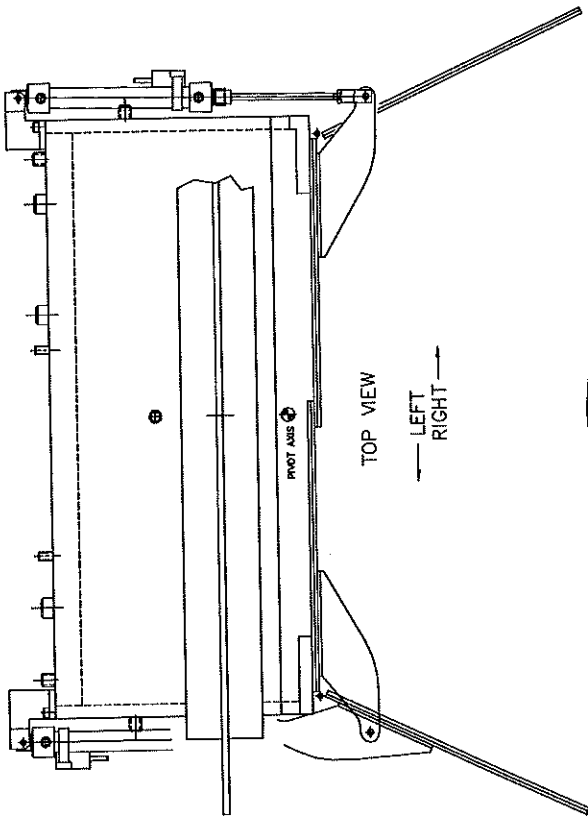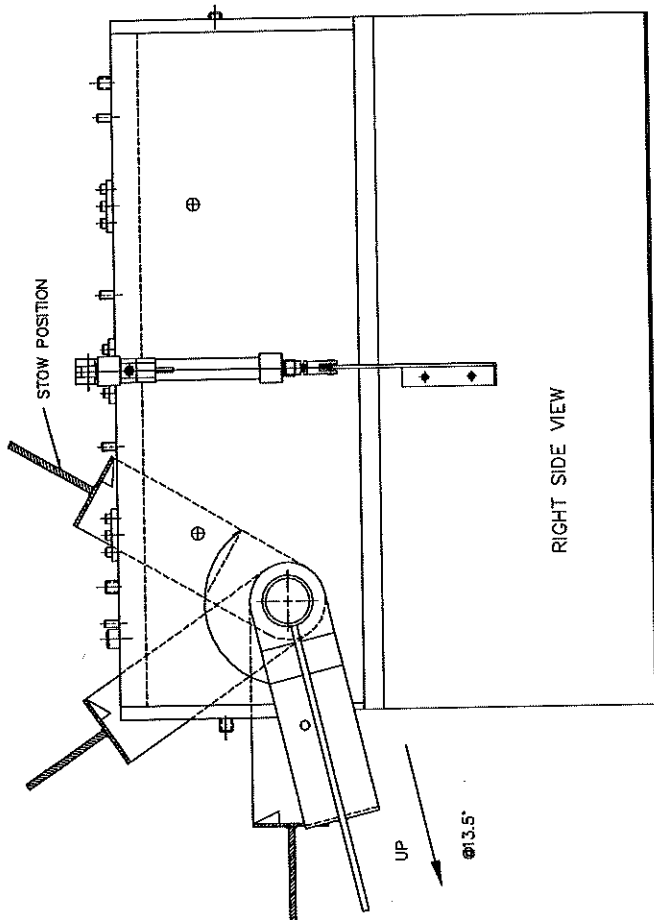



① CARRIER ASSEMBLY

1 REQ'D





NUMBER	QTY	DESCRIPTION
H4742-2	3	1 STOP
H4742-1	2	2 SCREW
H4741-1	1	1 BRIGGLE MOUNTMENT STL

1/2
A FABRICATED ASSEMBLY ITEM -3


KECK/HIRES
CROSS DISPERSER
CARRIER ASSEMBLY
H4740.A
Jc. 3-22-66

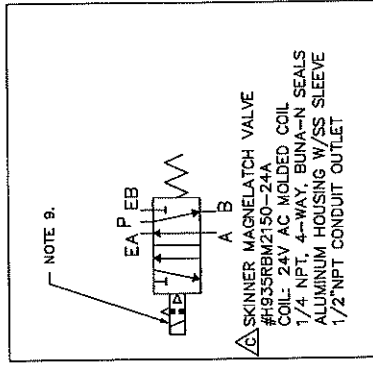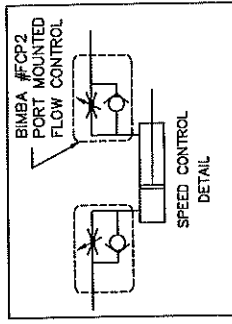

NOTES:
1. SEE COVER ASSEMBLY H4710.
2. REPLACEMENT SOLENOID: #CV5-LAAM-F24, SKINNER

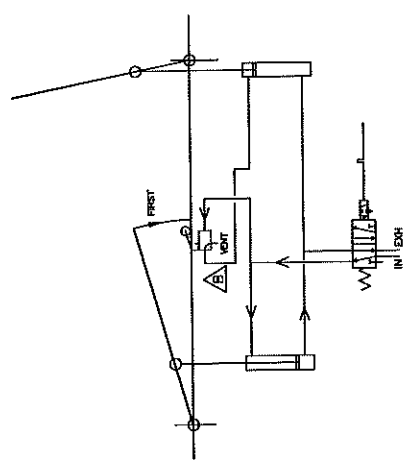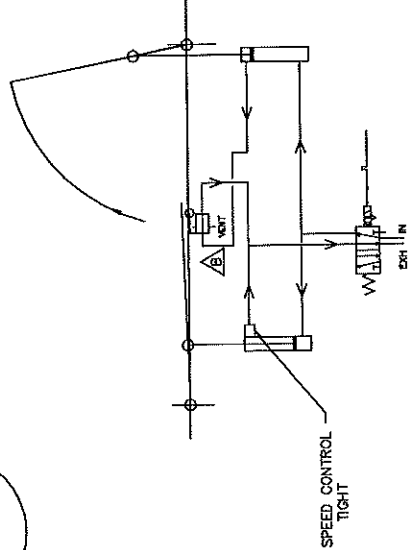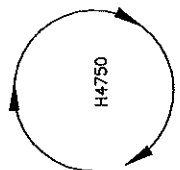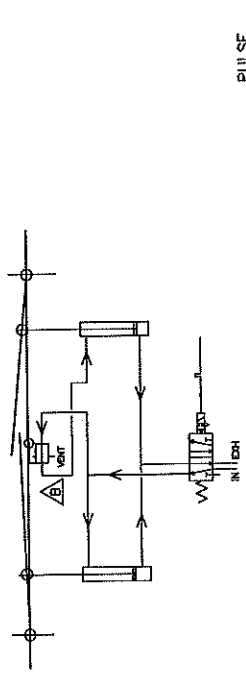

STATE 0
BOTH OPEN

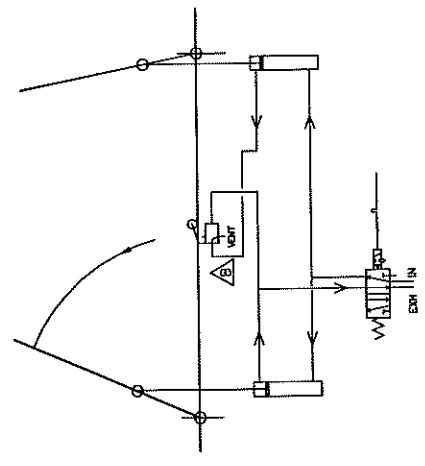

SEE H4751 FOR THIS DETAIL

SEQUENCE NOT CRITICAL HERE
SINCE SECOND DOOR MIGHT
ASSIST THE FIRST DOOR.




N/A

KECK/HIRES
CROSS DISPERSER
PNEUMATIC DIAGRAMS
J.C. 734

H4750.C

A	10/21/00	UPDATE PER DESIGN REVIEW 5/00
B	11/11/00	ADD SKINNER MAGNETLATCH VALVE
C	11/24/01	REVISED VALVE DETAIL

DEFLECTION IN MICRO-INCHES

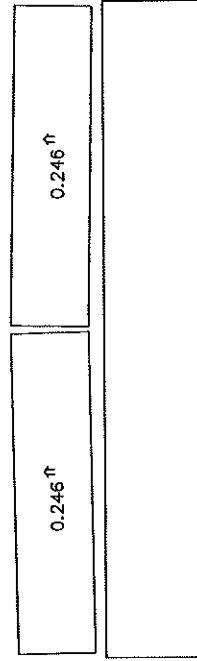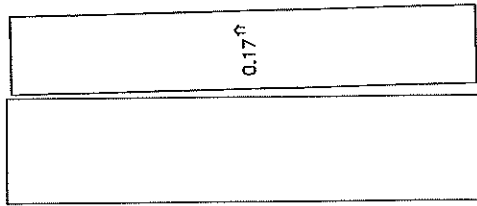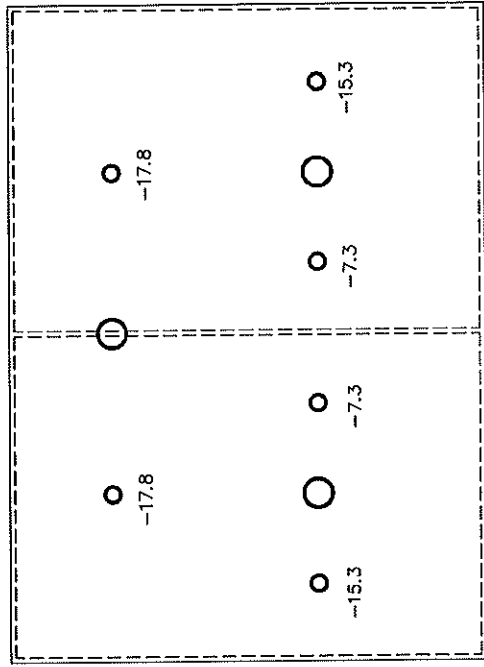

TILTS IN ARC-SECONDS

Appendix F List of Drawings — CCD Dewar

1. H7005 Locating Tree
2. H7130 CCD Dewar and Support Frame
3. H7131 CCD Dewar Inner Can and Support
4. H7161 CCD Cooling Detail
5. H7180 CCD Dewar Window (Field Flattener)
6. H7187 CCD Socket Alignment Tool Assembly
7. H7192 CCD and X-Y Stage Assembly
8. H7209 Dewar Support Frame Assembly
9. H7250 Dewar and Stage Assembly
10. H7260 Dewar With CCD and Echelle Format Layout
11. H7312 CCD Focus Drive Sub-Assembly
12. H7350 CCD Drive Schematic
13. H7500 CCD Electronics (Pre-Amp) Housing
14. H7600 Liquid Nitrogen Fill System
15. H7601 Liquid Nitrogen Level Sensor
16. H7800 Dewar Lifter and Cart
17. H7815 Dewar Cart Assembly
18. EL-1027-2S Ion Pump Modification

INNER CAN SUPPORT

2 REQ'D

NOTES:

1. LEE SPRING #LE-052D-6, STAINLESS STEEL, 3/8" X 14.5 LB/IN X 1.75 FREE LENGTH, DESIGN LENGTH = 2.75


2. H7120 FOR COLD FINGER ASSEMBLY.

3. ALL SCREWS TO BE VENTED.

#43 DRILL IN #10-32 SCREWS. Δ

ITEM NO.	DESCRIPTION	QTY	UNIT	MATERIAL
1	LEE SPRING #LE-052D-6	2	PCS	STAINLESS STEEL
2	INNER CAN SUPPORT	2	PCS	STAINLESS STEEL
3	SCREW #10-32 X 1.75	4	PCS	STAINLESS STEEL
4	SPRING	1	PCS	STAINLESS STEEL
5	WIRE LOOP #0.032	1	PCS	STAINLESS STEEL
6	WIRE LOOP #0.018	1	PCS	STAINLESS STEEL
7	WIRE LOOP #0.018	1	PCS	STAINLESS STEEL
8	WIRE LOOP #0.018	1	PCS	STAINLESS STEEL
9	WIRE LOOP #0.018	1	PCS	STAINLESS STEEL
10	WIRE LOOP #0.018	1	PCS	STAINLESS STEEL
11	WIRE LOOP #0.018	1	PCS	STAINLESS STEEL
12	WIRE LOOP #0.018	1	PCS	STAINLESS STEEL

QTY PER ASSEMBLY

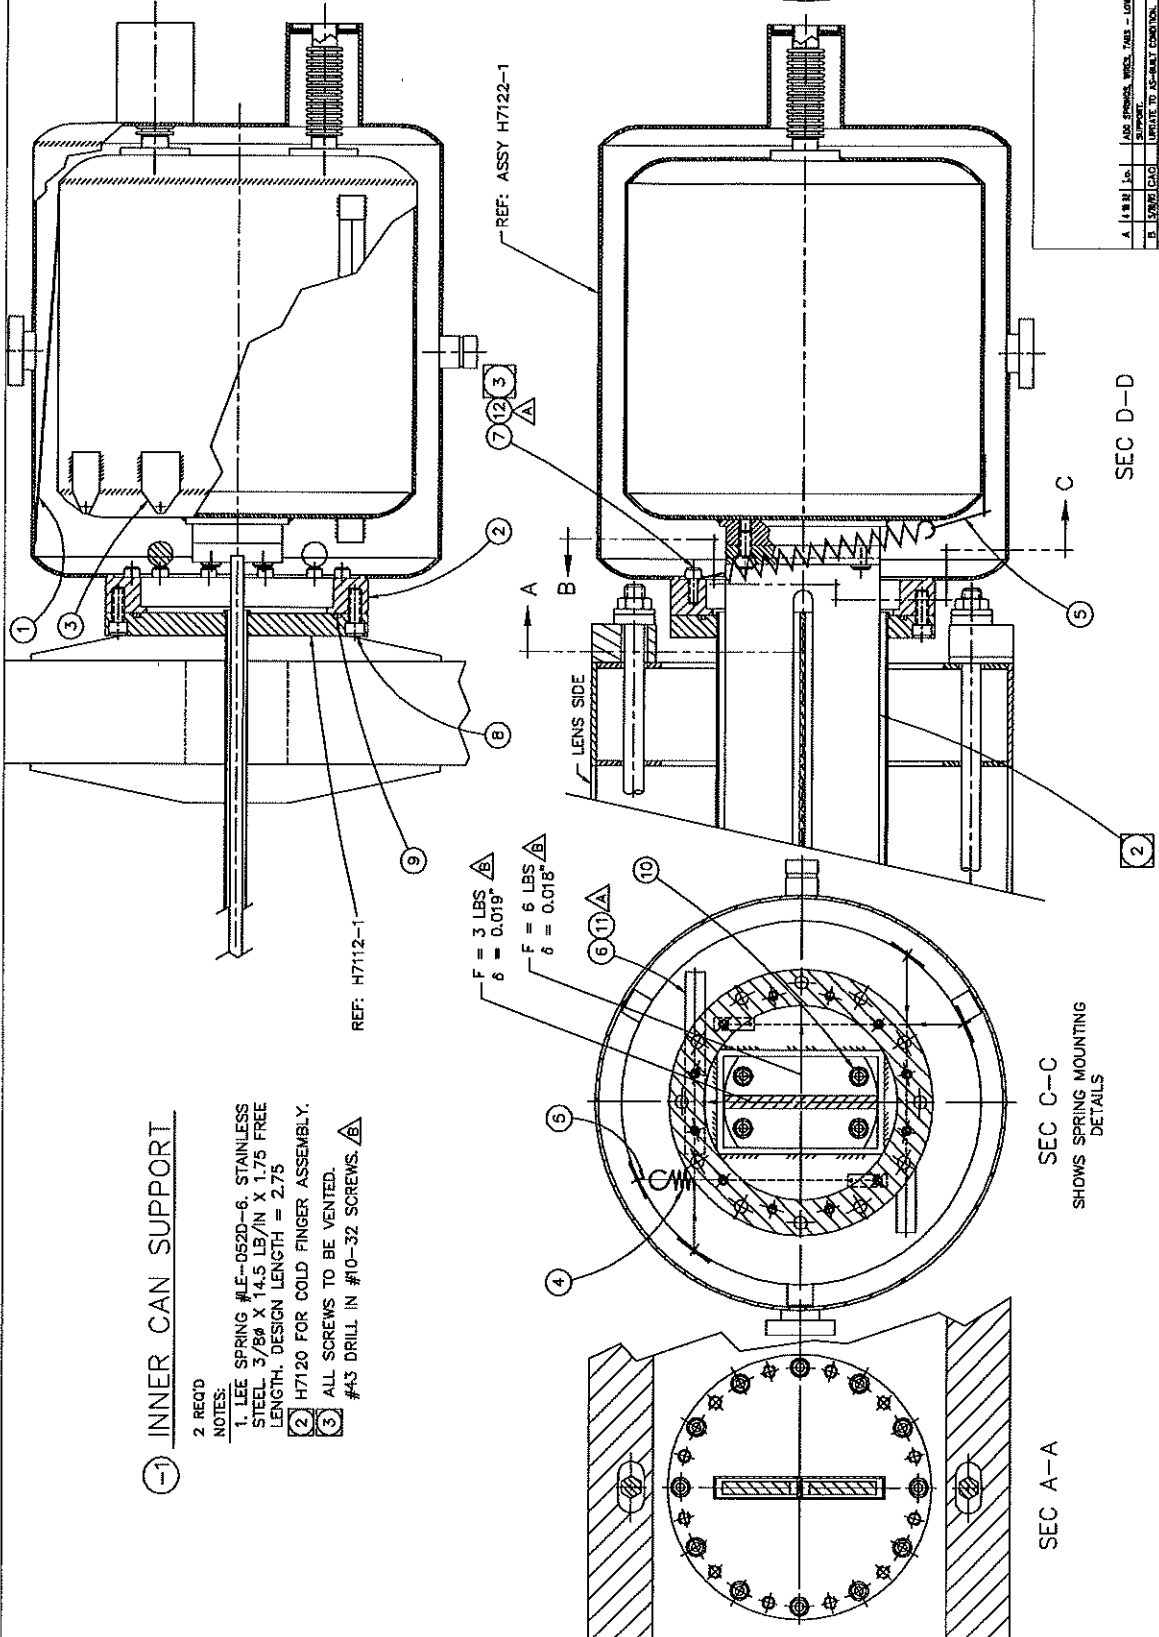

KECK/HIRES
 CCD DEWAR
 INNER CAN SUPPORT
 J.C. 3-5-61

H7131.B

FULL



ITEM NO.	DESCRIPTION	QTY	UNIT	MATERIAL
A	LEE SPRING #LE-052D-6	2	PCS	STAINLESS STEEL
B	INNER CAN SUPPORT	2	PCS	STAINLESS STEEL

SEC D-D


SEC C-C
 SHOWS SPRING MOUNTING
 DETAILS

SEC A-A

SEC B-B

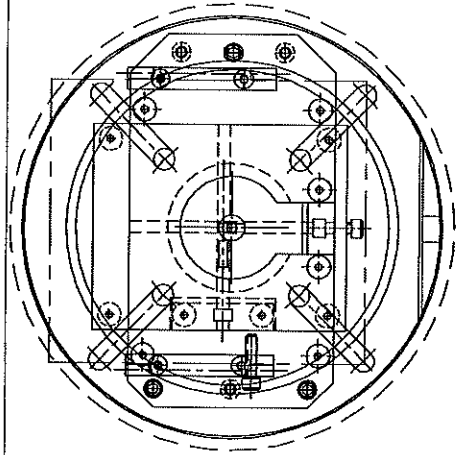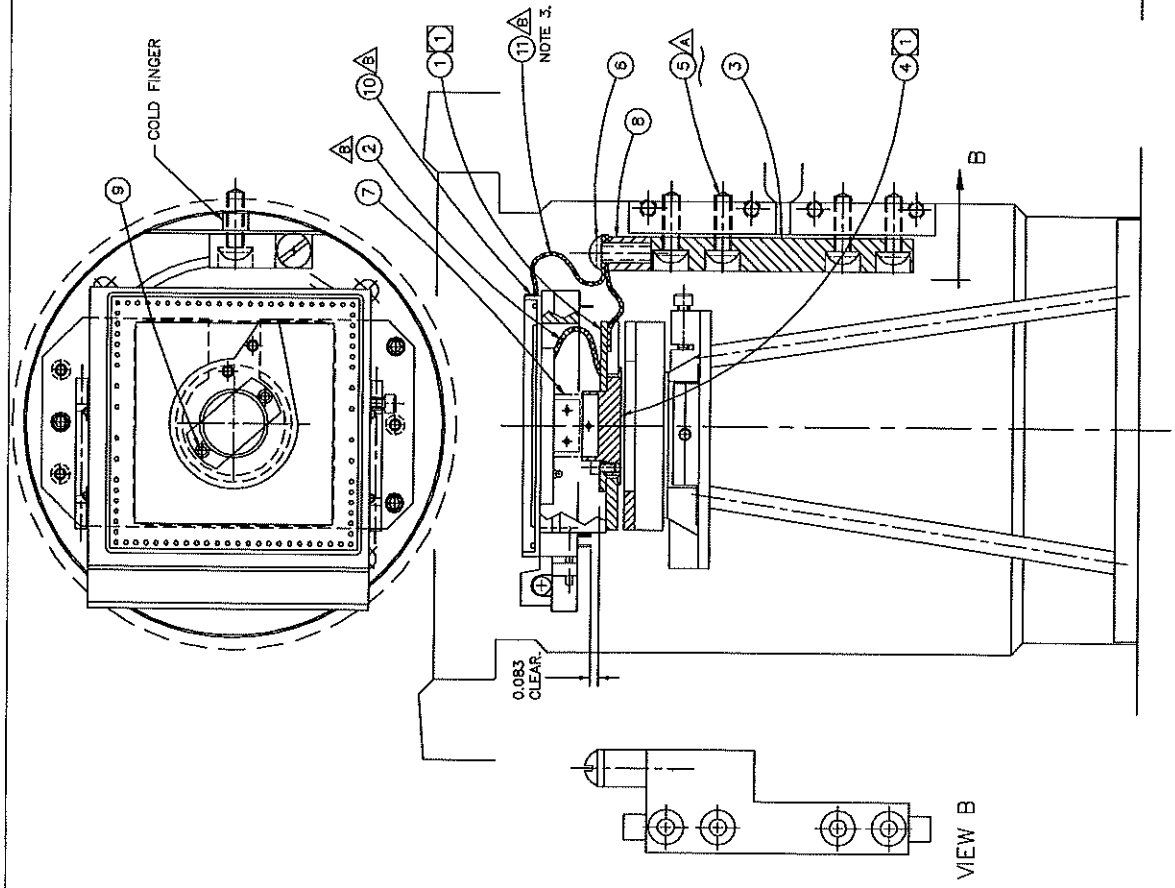

SEC A-A, PART 1 NOT SHOWN

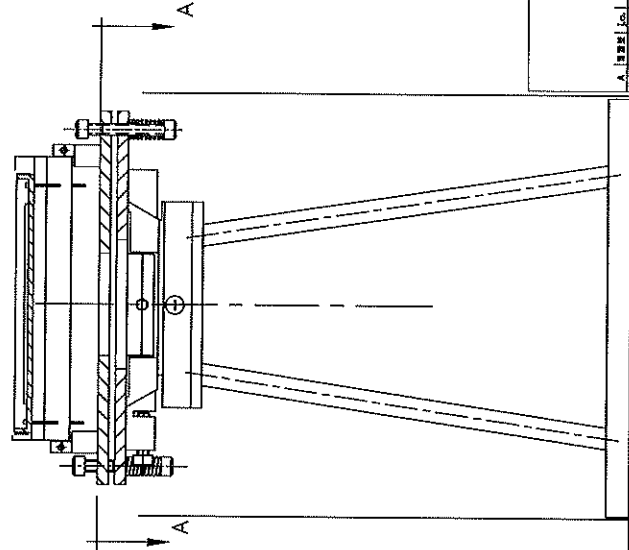

2:1

-1 COOLING CONNECTIONS

- NOTES:
- 1 ASSEMBLY SHOULD HAVE 0.02" VERTICAL CLANCE.
 - 2. THIS CONFIGURATION IS FOR A TEKTRONICS CCD
 - 3. SEE H7162 FOR COLD STRAP DETAIL


H7161-1	10	1	TOP COOLING CLAMP	ASSY
	9	2	AC-56 AL HD SCW	ST. STL
	8	1	SPACER	PTFE
H7162-3	6	1	SPACER	PTFE
	5	1	COLD STRAP	ALUM
	4	1	COLD STRAP	10-32
	3	4	MOUNTED SCREW 8-32	BRASS
H7161-1	2	4	FLANGED NUT	ALUM
H7162-2	3	1	COLD FINGER ADAPTER	PTFE
H7161-1	2	1	SPACER	PTFE
H7161-1	2	1	SPACER	PTFE

KECK/HIRES
CCD COOLING
DETAIL

JO. 7 27 84

H7161.B


A	11/8	10	PART-35, #3-35 WAS #10-32
B	11/8	10	MODIFY PART 1; ADD PART 10, NOTE 3
			NO. OF ALTERNATE PARTS

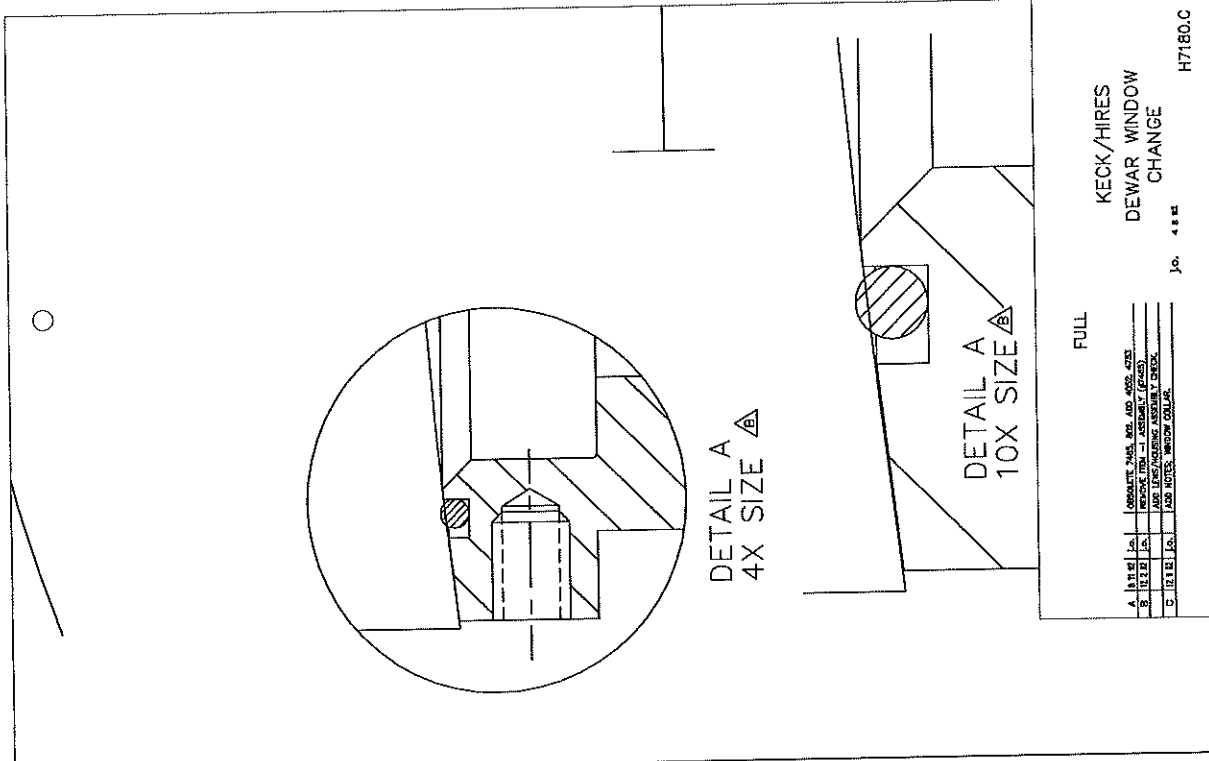


FULL

A	12.12	J.S.	REVISE	FOR	ADD	4052	2025
B	12.12	J.S.	REVISE	FOR	ADD	4052	2025
C	12.12	J.S.	ADD	NOTES	WIDEN	COLLAR	


KECK/HIRES
DEWAR WINDOW
CHANGE
J.G. 4.8.82

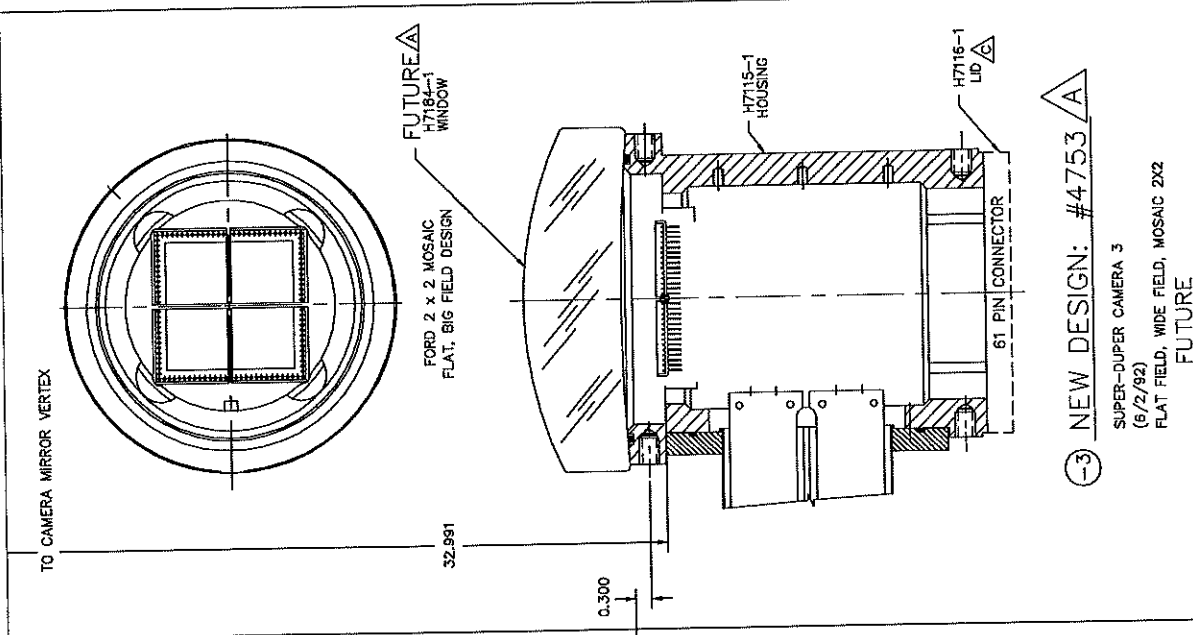

NEW DESIGN: #4753 A
SUPER-DUPER CAMERA 3
(6/2/92)
FLAT FIELD, WIDE FIELD, MOSAIC 2X2
FUTURE

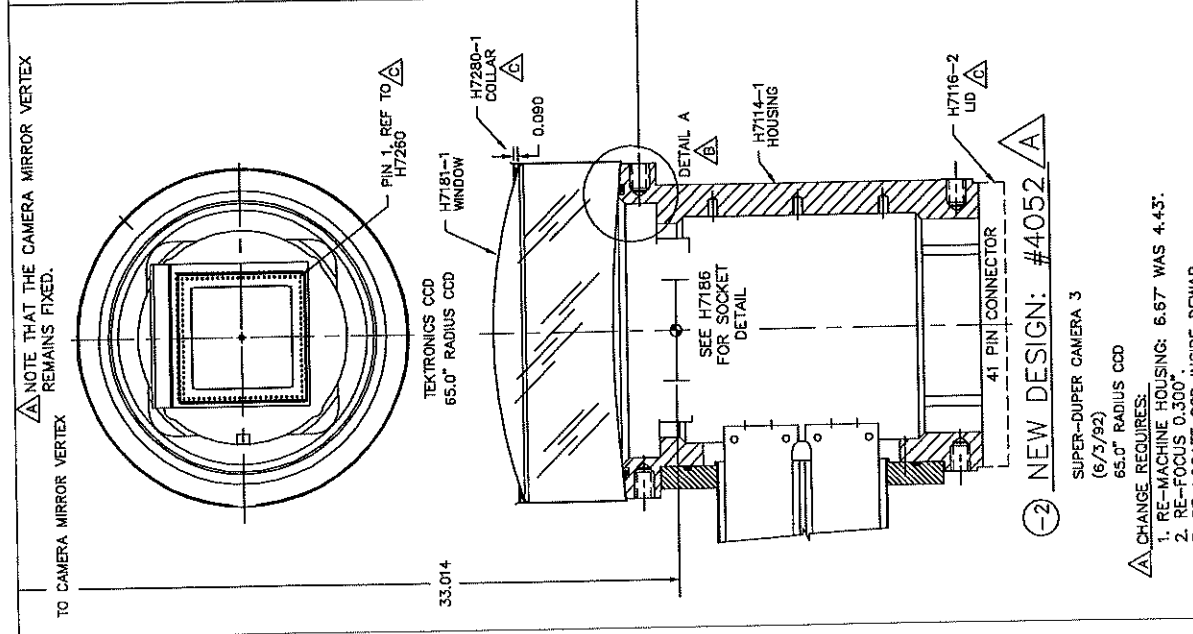

NEW DESIGN: #4052 A
SUPER-DUPER CAMERA 3
(6/3/92)
65.0" RADIUS CCD
CHANGE REQUIRES:
1. RE-MACHINE HOUSING: 6.67 WAS 4.43.
2. RE-FOCUS 0.300".
3. RE-LOCATE CCD INSIDE DEWAR.

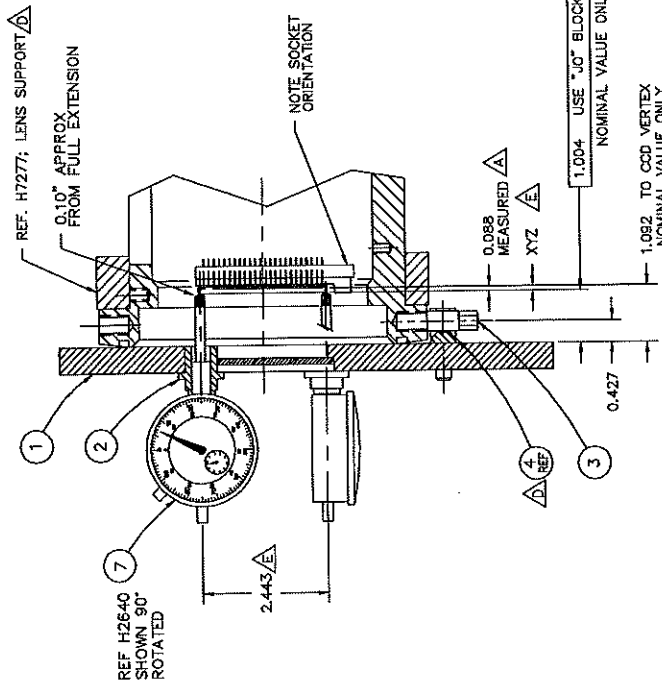


SOCKET ALIGNER


1 REQ'D ASSEMBLY

NOTES:

- 1 RTV WINDOW IN PLACE.
- 2 STORE IN SCHRY-WAY WOODEN CASE MD10 12X12X6
- 3 ENGINEERING GRADE DEVICE INSTALLED 12-2-92
- TEKTRONICS TK2048B3-E 806-7424-83
- SERIAL NO. 1428BR09-01
- 4 LRIS ENGINEERING GRADE DEVICE:

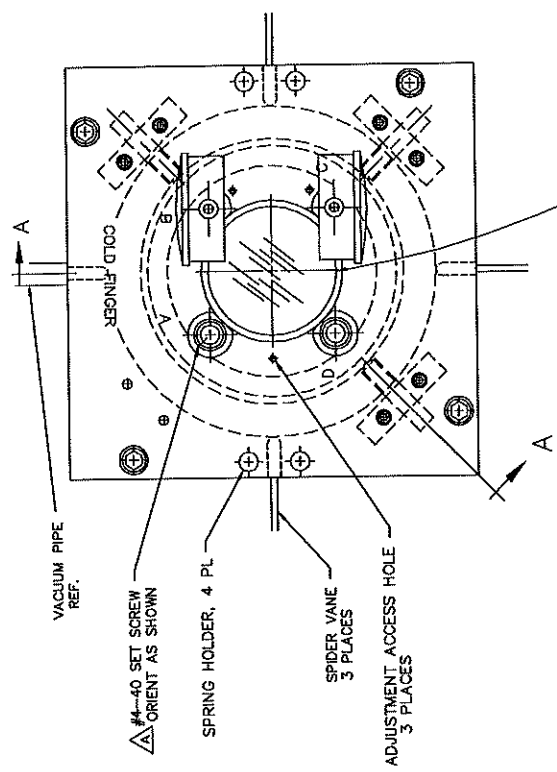

ONLY 2 DIAL INDICATORS SHOWN

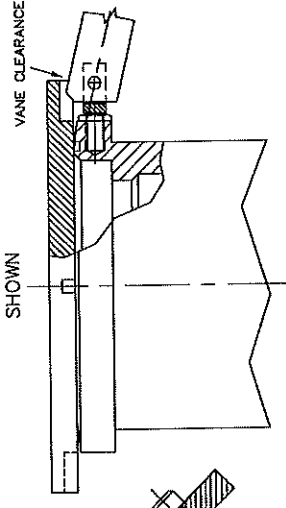

FIRST IMAGING CHIP

CORNER READINGS	1-12-93	2-10-93	3-11-93
"A"	1.0158	1.0000 - 0.0169 = 0.9831	1.0000 - 0.0137 = 0.9863
"B"	1.017	1.0000 - 0.016 = 0.9840	1.0000 - 0.0137 = 0.9863
"C"	1.0165	1.0000 - 0.025 = 0.9750	1.0000 - 0.0440 = 0.9560
"D"	1.0160	1.0000 - 0.044 = 0.9560	1.0000 - 0.0830 = 0.9170

SECOND IMAGING CHIP

CORNER READINGS	3-11-93
"A"	1.0000 - 0.0137 = 0.9863
"B"	1.0000 - 0.0137 = 0.9863
"C"	1.0000 - 0.0440 = 0.9560
"D"	1.0000 - 0.0830 = 0.9170

ITEM NO.	QTY	DESCRIPTION	MATERIAL
1	1	DIAL INDICATOR	METRODYE
2	1	RTV WINDOW	ALUM
3	1	ENGINEERING GRADE DEVICE	ALUM
4	1	LRIS ENGINEERING GRADE DEVICE	BRASS
5	1	ALIGNMENT PLATE	ALUM

REF. H7277; LENS SUPPORT

0.10" APPROX FROM FULL EXTENSION

NOTE SOCKET ORIENTATION

0.088 MEASURED XYZ

1.004 USE "JO" BLOCKS NOMINAL VALUE ONLY

1.092 TO CCD VERTEX NOMINAL VALUE ONLY

2.443


0.427

REF H2E40 SHOWN 90° ROTATED

KECK/HIRES
CCD ROUGH ALIGNER
ASSEMBLY

J.O. 7142
G.A.S. 7792
JA

H7187.F

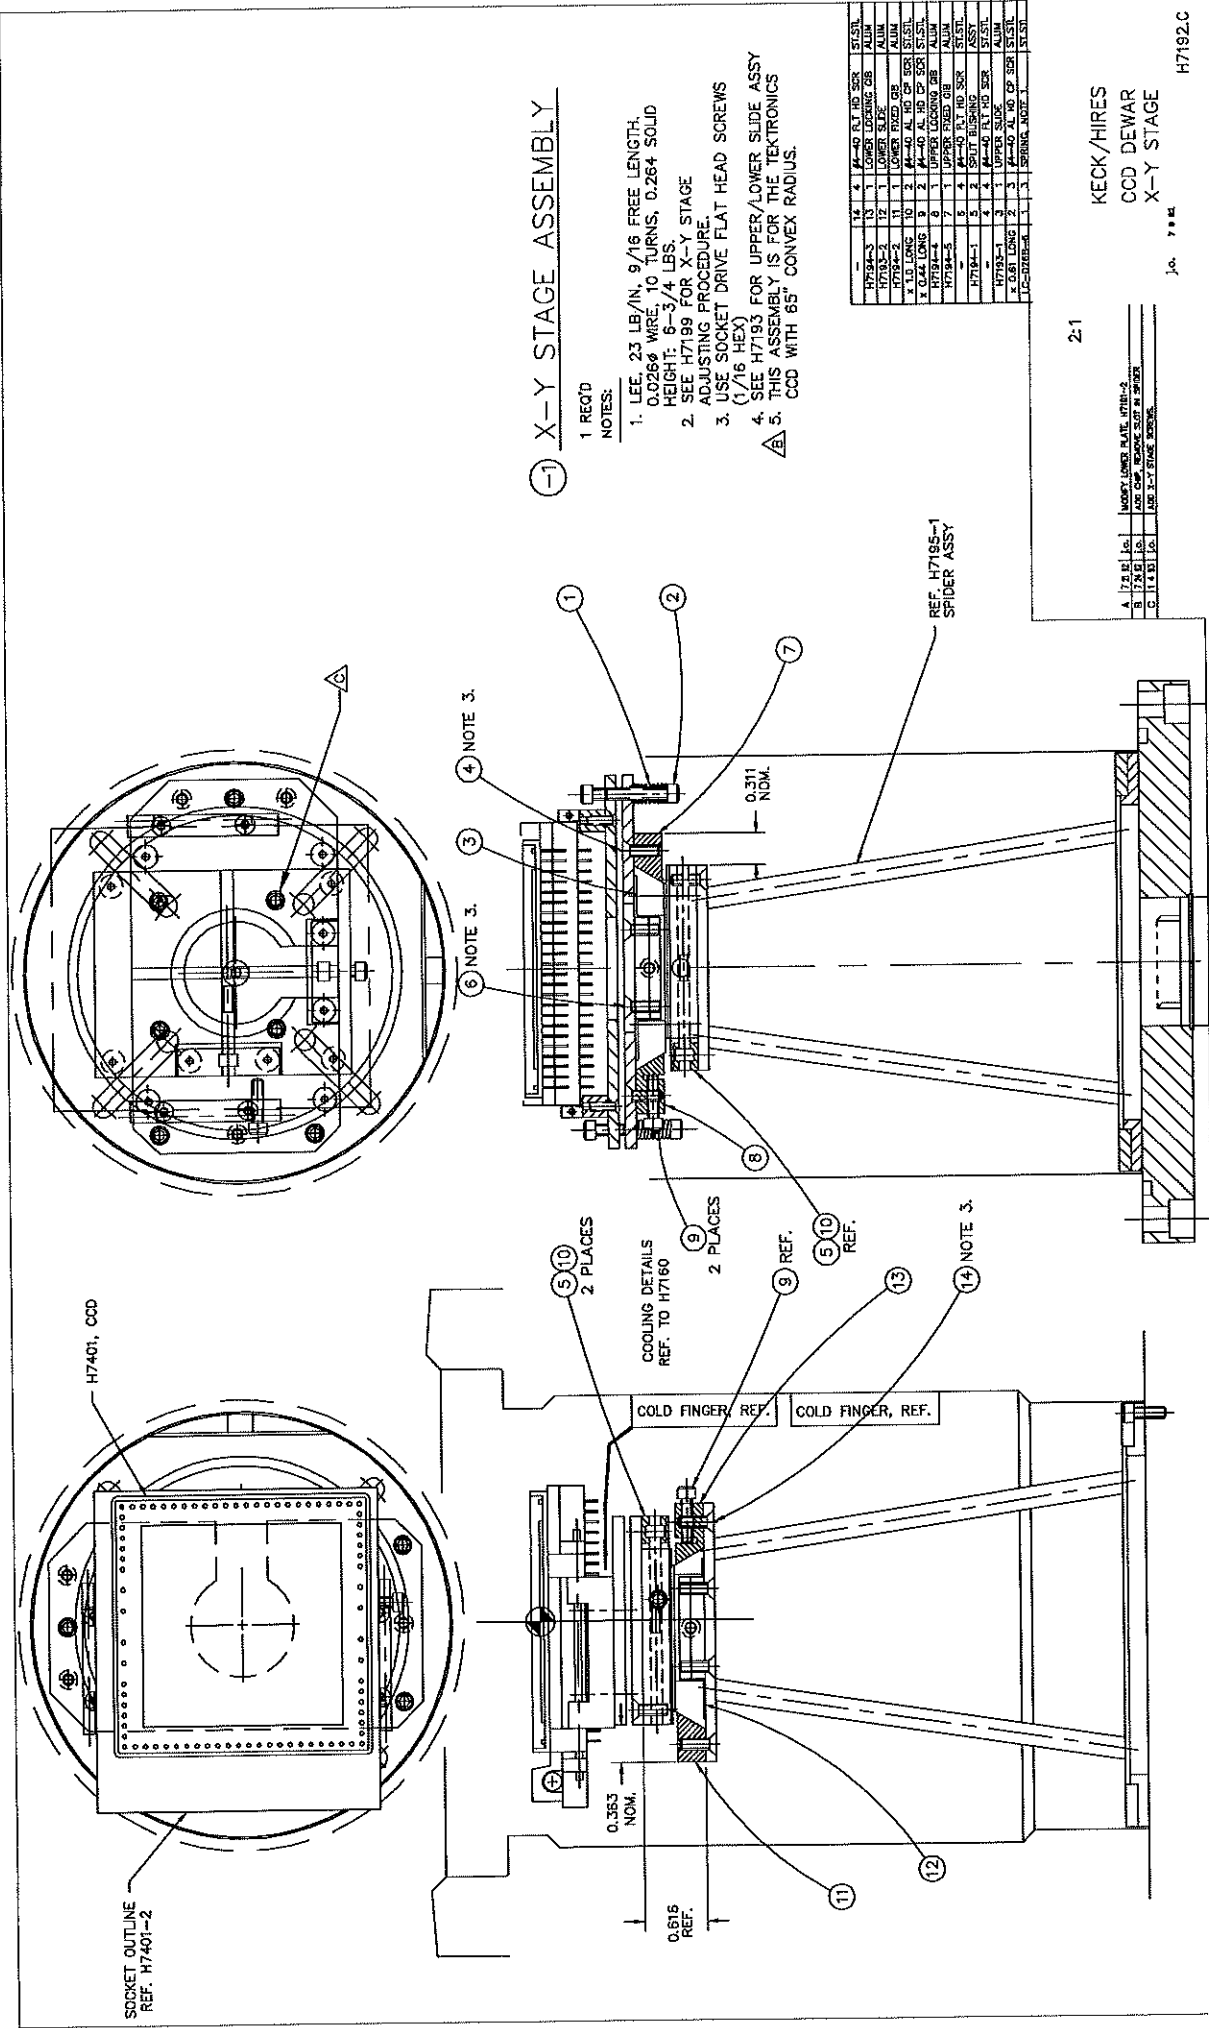

① X-Y STAGE ASSEMBLY

1 REQ'D
NOTES:

1. LEE, 23 LB/IN, 9/16 FREE LENGTH, 0.0269 WIRE, 10 TURNS, 0.264 SOLID HEIGHT; 8-3/4 LBS.
2. SEE H7199 FOR X-Y STAGE ADJUSTING PROCEDURE.
3. USE SOCKET DRIVE FLAT HEAD SCREWS (1/16 HEX)
4. SEE H7183 FOR UPPER/LOWER SLIDE ASSY
5. THIS ASSEMBLY IS FOR THE TEKTRONICS CCD WITH 65" CONVEX RADIUS.


14	4	4-40 RLT HD SCR	ST/STL
H7184-3	10	1 LOWER LOCKING CIB	ALUM
H7183-2	12	1 LOWER SLIDE	ALUM
H7184-2	11	1 LOWER FIXED CIB	ALUM
H7184-1	9	1 LOWER SLIDE	ALUM
X 0.4 LONG	2	2 4-40 AL HD CP SCR	ST/STL
H7184-4	8	1 UPPER LOCKING CIB	ALUM
H7184-5	7	1 UPPER FIXED CIB	ALUM
H7184-1	6	4 4-40 RLT HD SCR	ST/STL
H7184-1	5	2 4-40 RLT HD SCR	ST/STL
H7183-1	3	1 UPPER SLIDE	ALUM
X 0.61 LONG	2	2 4-40 AL HD CP SCR	ST/STL
1/2-1/2-1/2-1/2	1	1 SPRING ADJUST	ST/STL

2:1

KECK/HIRES
CCD DEWAR
X-Y STAGE

H7192LC

A	1/2 IN	1/2	MOCKY LOWER PLATE, WIRE-2
B	1/2 IN	1/2	NOT CHG. REMOVE SUP IN 9/83
C	1/2 IN	1/2	REF. X-Y STAGE ASSEMBLY

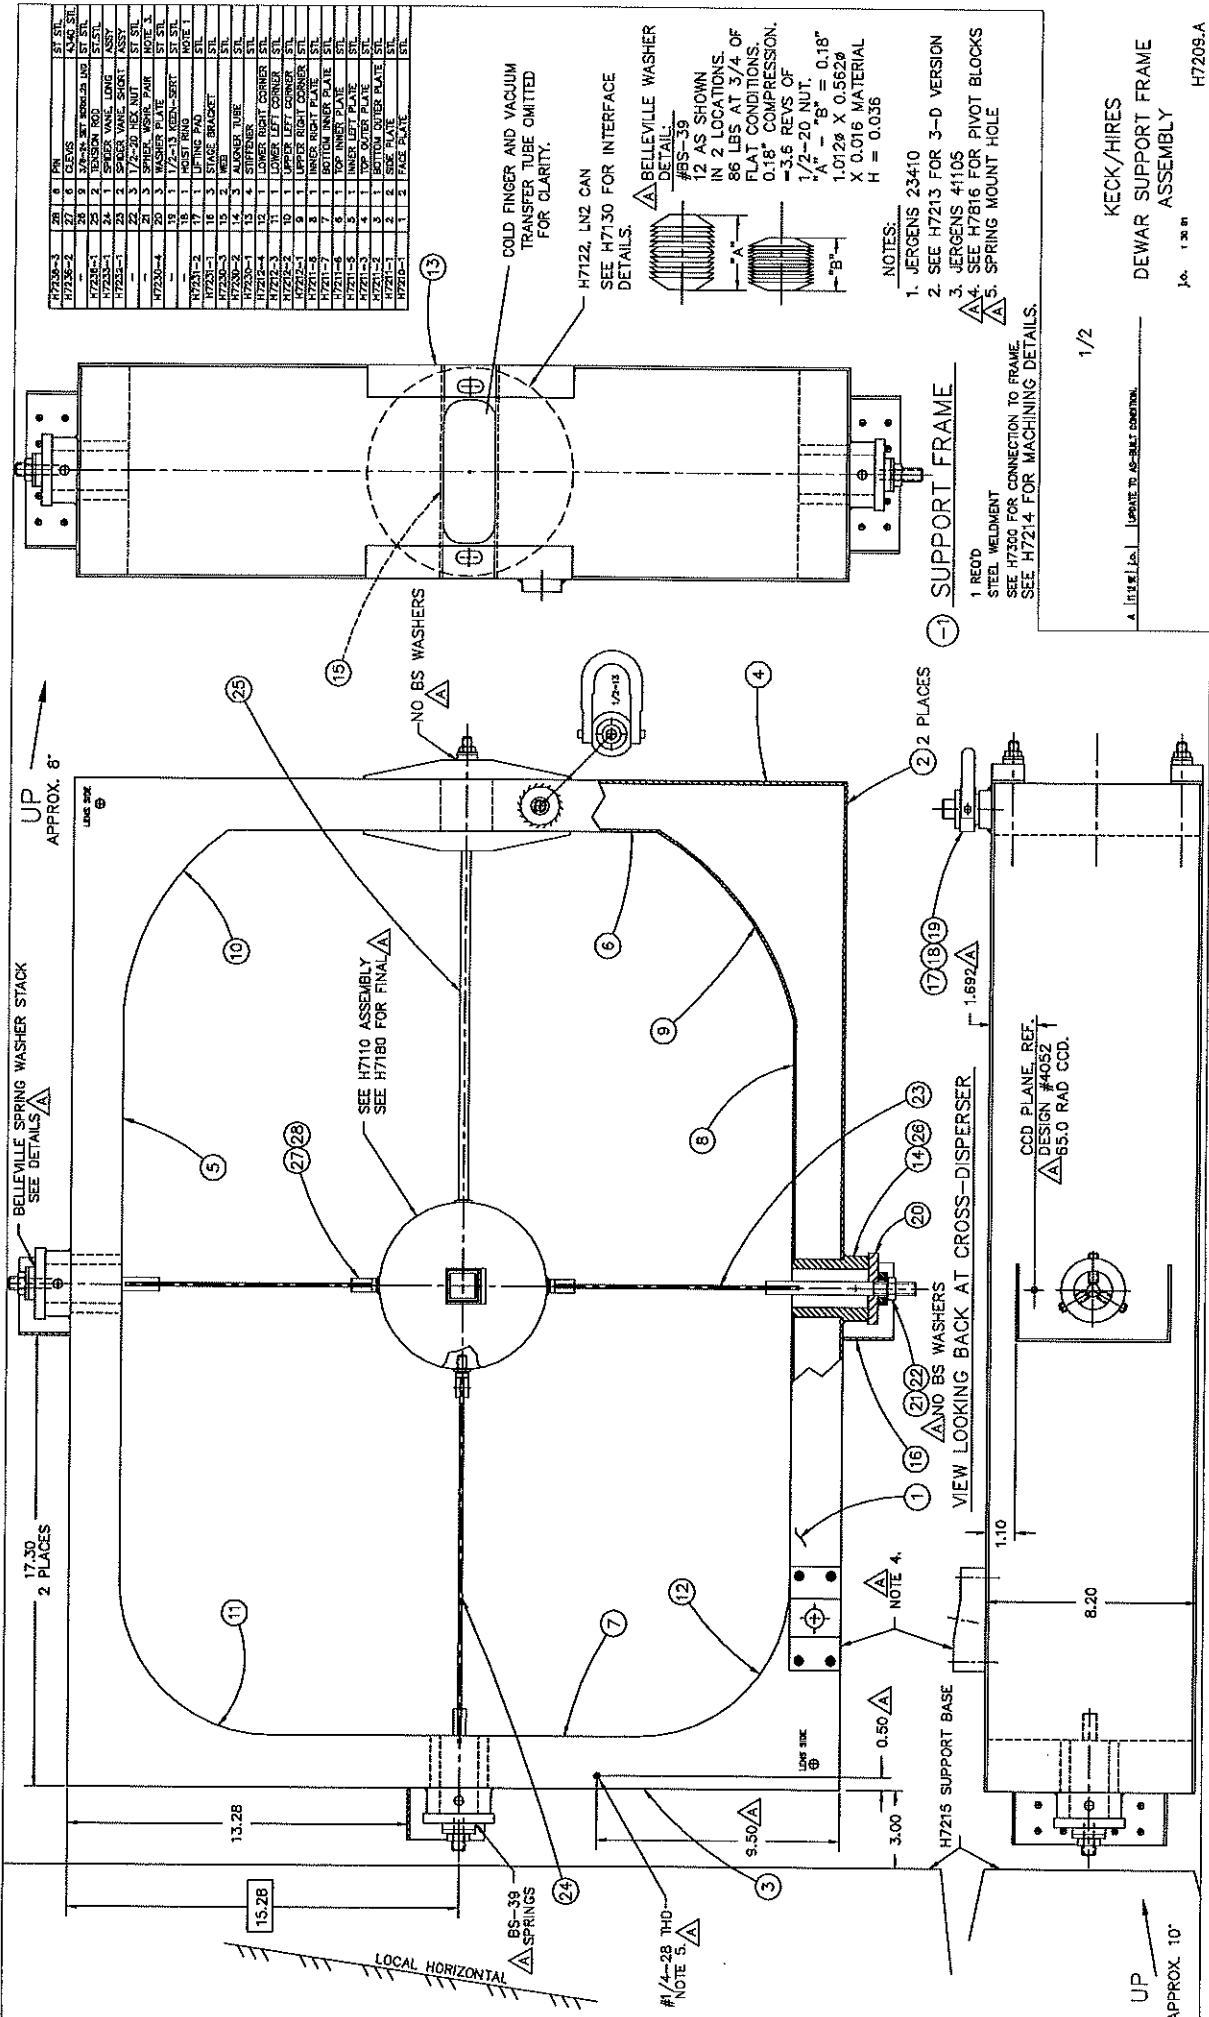

H7238-3	27	6	PHI	ST	STL
H7238-2	27	6	CLEVIS	6.40	STL
H7238-1	28	9	3/4"-8 X 1/2" BELLVILLE WASHER	ST	STL
H7237-3	28	9	3/4"-8 X 1/2" BELLVILLE WASHER	ST	STL
H7237-2	28	9	3/4"-8 X 1/2" BELLVILLE WASHER	ST	STL
H7237-1	28	9	3/4"-8 X 1/2" BELLVILLE WASHER	ST	STL
H7236-3	22	3	1/2"-20 HEX NUT	ST	STL
H7236-2	22	3	1/2"-20 HEX NUT	ST	STL
H7236-1	22	3	1/2"-20 HEX NUT	ST	STL
H7235-3	21	3	SPRINGER WASHER PAIR	NOTE 3	
H7235-2	21	3	SPRINGER WASHER PAIR	NOTE 3	
H7235-1	21	3	SPRINGER WASHER PAIR	NOTE 3	
H7234-3	18	1	1/2" DIA. X 1/2" THK. WASH. PLATE	STL	
H7234-2	18	1	1/2" DIA. X 1/2" THK. WASH. PLATE	STL	
H7234-1	18	1	1/2" DIA. X 1/2" THK. WASH. PLATE	STL	
H7233-3	16	3	STAGE BRACKET	STL	
H7233-2	16	3	STAGE BRACKET	STL	
H7233-1	16	3	STAGE BRACKET	STL	
H7232-3	12	2	WEB	STL	
H7232-2	12	2	WEB	STL	
H7232-1	12	2	WEB	STL	
H7231-3	11	1	LOWER RIGHT CORNER	STL	
H7231-2	11	1	LOWER LEFT CORNER	STL	
H7231-1	11	1	LOWER LEFT CORNER	STL	
H7230-3	10	1	UPPER LEFT CORNER	STL	
H7230-2	10	1	UPPER LEFT CORNER	STL	
H7230-1	10	1	UPPER LEFT CORNER	STL	
H7229-3	8	1	UNDER RIGHT PLATE	STL	
H7229-2	8	1	UNDER RIGHT PLATE	STL	
H7229-1	8	1	UNDER RIGHT PLATE	STL	
H7228-3	6	1	TOP INNER PLATE	STL	
H7228-2	6	1	TOP INNER PLATE	STL	
H7228-1	6	1	TOP INNER PLATE	STL	
H7227-3	5	1	INNER LEFT PLATE	STL	
H7227-2	5	1	INNER LEFT PLATE	STL	
H7227-1	5	1	INNER LEFT PLATE	STL	
H7226-3	2	2	SIZE PLATE	STL	
H7226-2	2	2	SIZE PLATE	STL	
H7226-1	2	2	SIZE PLATE	STL	
H7225-3	1	1	FACE PLATE	STL	
H7225-2	1	1	FACE PLATE	STL	
H7225-1	1	1	FACE PLATE	STL	

COLD FINGER AND VACUUM TRANSFER TUBE OMITTED FOR CLARITY.

H7122 LN2 CAN
SEE H7130 FOR INTERFACE DETAILS.

BELLEVILLE WASHER
DETAIL:
#BS-39
12 AS SHOWN
IN 2 LOCATIONS.
86 LBS AT 3/4 OF
FLAT CONDITIONS.
0.18" COMPRESSION.
-3.6 REVS OF
1/2"-20 NUT.
"A" - "B" = 0.18"
1.0128 X 0.5628
X 0.016 MATERIAL
H = 0.036

- NOTES:
1. JERGENS 23410
 2. SEE H7213 FOR 3-D VERSION
 3. JERGENS 41105
 4. SEE H7816 FOR PIVOT BLOCKS
 5. SPRING MOUNT HOLE

1 RECD
STEEL WELDMENT
SEE H7300 FOR CONNECTION TO FRAME.
SEE H7214 FOR MACHINING DETAILS.

1/2


UP APPROX. 10'

KECK/HIRES
DEWAR SUPPORT FRAME
ASSEMBLY

H7209.A

A. LOCAL HORIZONTAL

UP APPROX. 10'

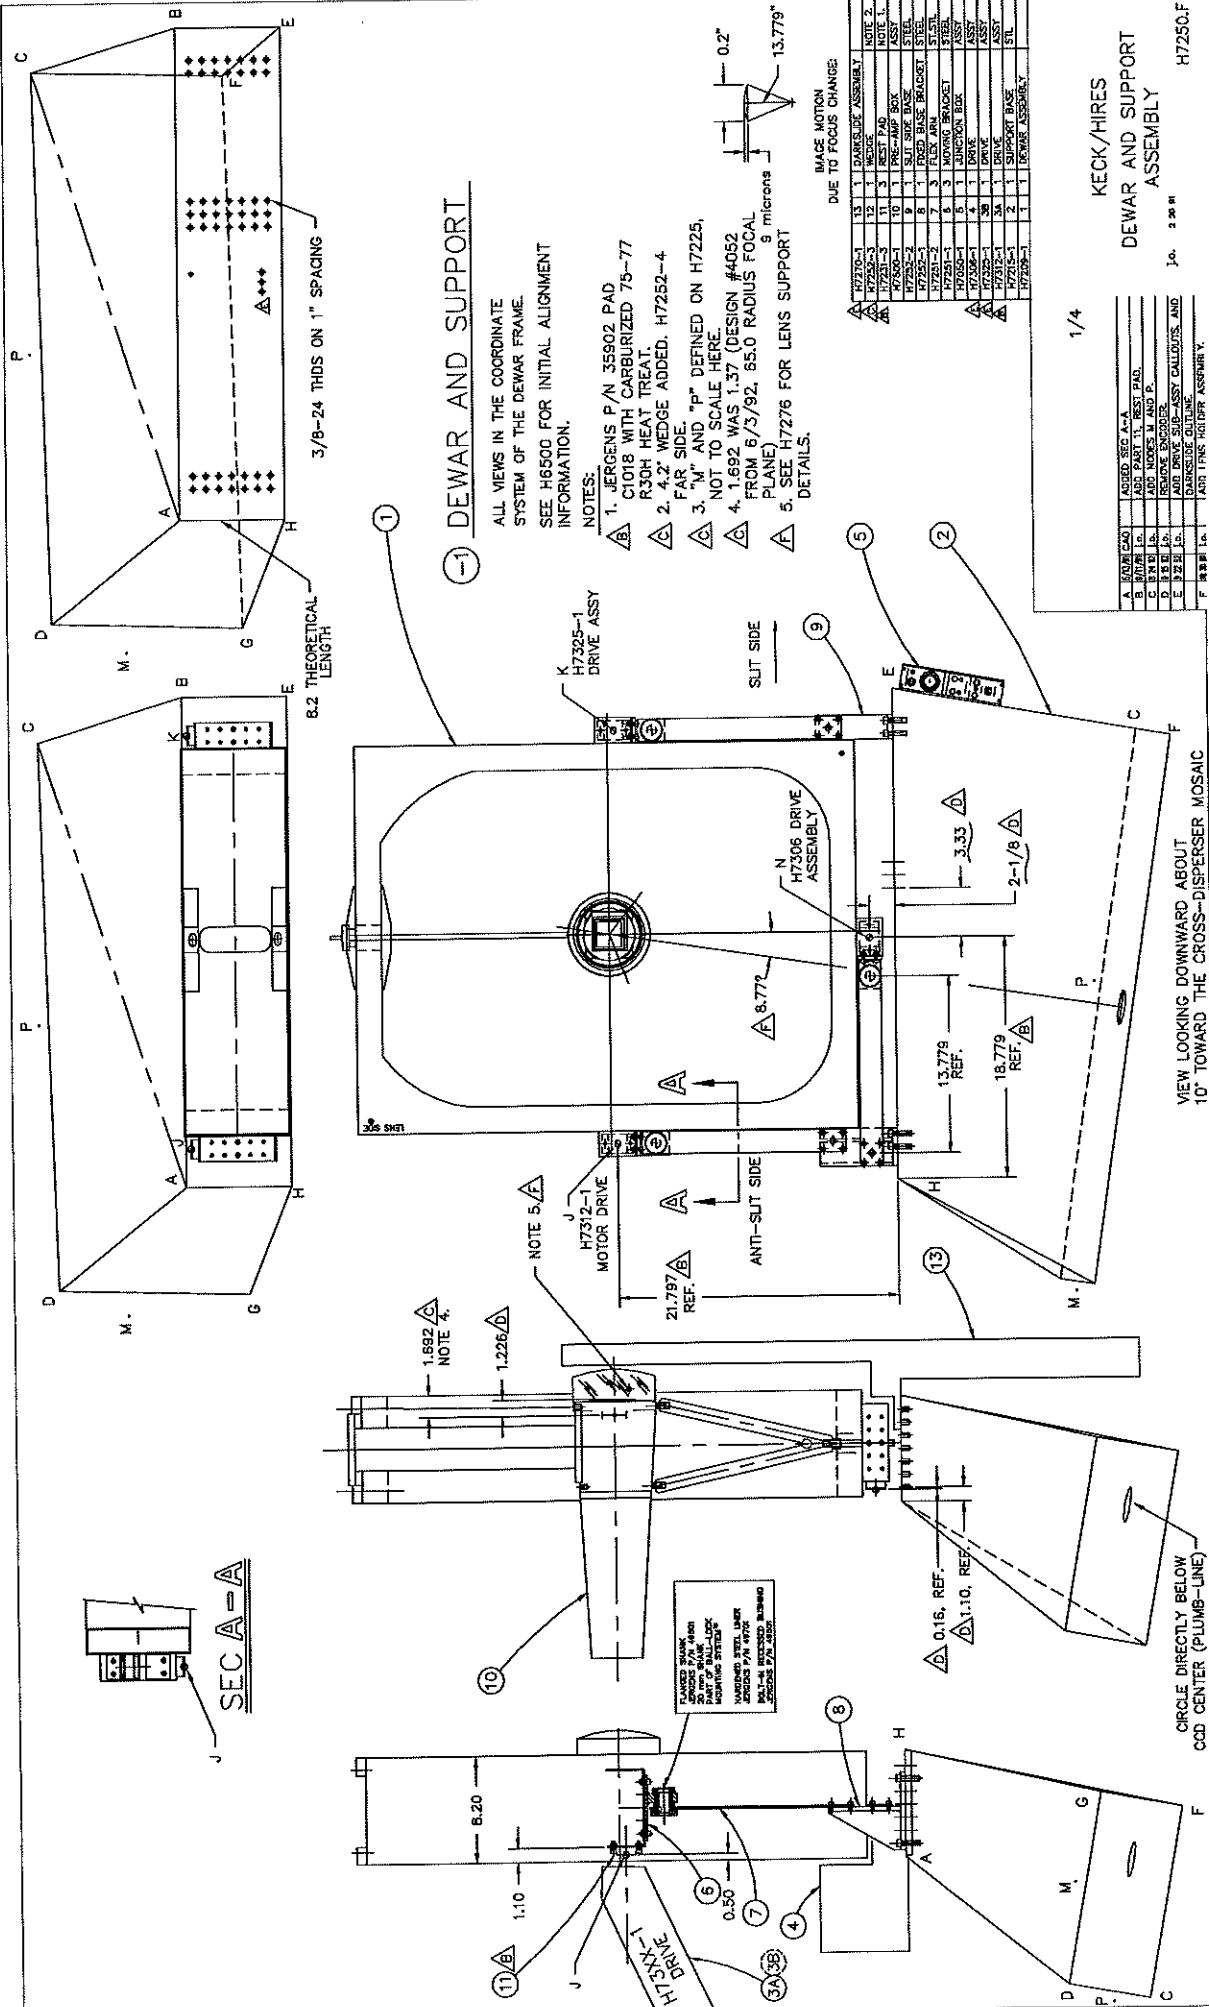

(-1) DEWAR AND SUPPORT

ALL VIEWS IN THE COORDINATE SYSTEM OF THE DEWAR FRAME. SEE H6500 FOR INITIAL ALIGNMENT INFORMATION.

- NOTES:
- 1. JERCENS P/N 35902 PAD C1018 WITH CARBURIZED 75-77 R30H HEAT TREAT.
 - 2. 4.2" WEDGE ADDED. H7252-4 FAR SIDE.
 - 3. "M" AND "P" DEFINED ON H7225, NOT TO SCALE HERE.
 - 4. 1.692 WAS 1.37 (DESIGN #4052 FROM 6/3/92, 65.0 RADIUS FOCAL PLANE) 9 MICRONS.
 - 5. SEE H7276 FOR LENS SUPPORT DETAILS.

IMAGE MOTION DUE TO FOCUS CHANGE:

ITEM	QTY	DESCRIPTION	NOTE
A	13	1 DARKSIDE ASSEMBLY	NOTE 2
A	13	1 REST PAD	NOTE 1
A	10	1 PRE-AMP BOX	TEST
A	8	1 FIXED BASE BRACKET	STEEL
A	7	3 FLY ARM	ST-51
A	6	3 MOVING BRACKET	ST-51
A	8	1 JUNCTION BOX	ASSY
A	38	1 DRIVE	ASSY
A	2	1 SUPPORT BASE	ASSY
A	1	1 REWIRE ASSEMBLY	STL

1/4


ITEM	QTY	DESCRIPTION
A	1	ADDED SEC A-A
B	1	ADD PART 1, REST PAD
C	1	ADD WEDGE AND P.
D	1	ADD DRIVE SUB-ASSY CALLOUTS AND DARKSIDE OUTLINE
E	1	ADD DRIVE SUB-ASSY CALLOUTS AND DARKSIDE OUTLINE
F	1	ADD 1 P/N 3012 P/R ASSEMBLY

KECK/HIRES
DEWAR AND SUPPORT
ASSEMBLY

J. 2. 20 81 H7250.F

VIEW LOOKING DOWNWARD ABOUT 10° TOWARD THE CROSS-DISPENSER MOSAIC


CIRCLE DIRECTLY BELOW COD CENTER (PLUMB-LINE)

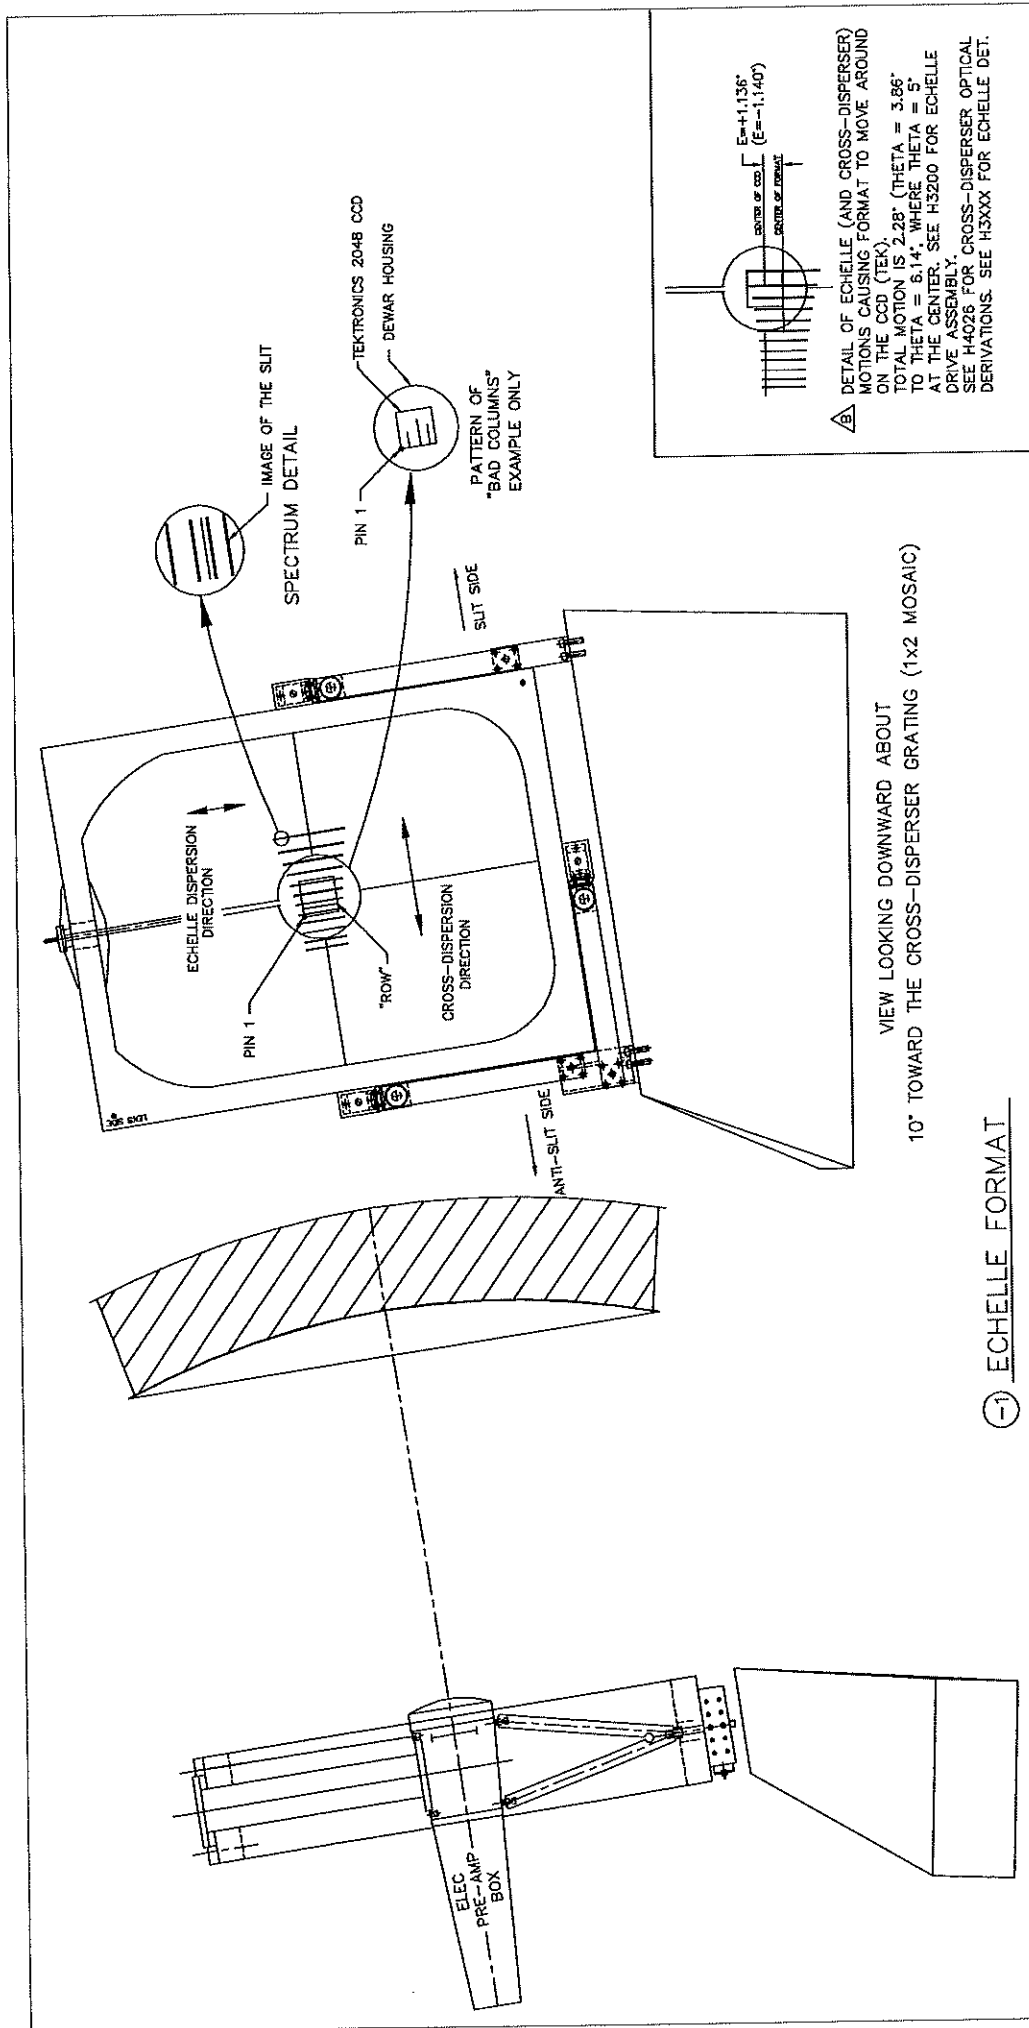

VIEW LOOKING DOWNWARD ABOUT
10° TOWARD THE CROSS-DISPERSER GRATING (1x2 MOSAIC)

① ECHELLE FORMAT

- NOTES
1. CCD CAN BE ROTATED 180° WITHOUT ROTATING THE SOCKET. PIN 1 WOULD BE ON A DIAGONAL CORNER TO THAT SHOWN.
 2. THE SOCKET MAY BE ROTATED 90° BUT NOT -90°.

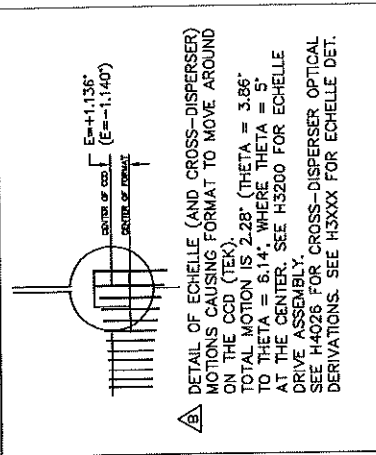

1/4



3RD ANGLE
PROJECTION

A 15 8 1 5
B 1 9 3 1 8


KECK/HIRES
DEWAR WITH CCD
ORIENTATION

H7260.B

DRIVE ASSEMBLY

3 REQ'D, SIMILAR
NOTES:


1. LOW HEAD SOCKET DRIVE SCREW
2. 4.5:1 FROM 16T TO 72T SPROCKET AND 90T BELT (BERG 20TB-90)
3. 20:1 LEVER: $\pm 0.50"$ MICROMETER TRAVEL IS $\pm 0.025"$ STAGE TRAVEL. 1/8" THICK FILTER REQUIRES 0.002" RE-FOCUS.
4. $\pm 0.50"$ BRONZE SCREW ALLOWS INITIAL ALIGNMENT ONLY.
5. UPPER SCREW CONTACT FORCE IS T.B.D. Δ
6. LOWER SCREW CONTACT FORCE IS 6.75 LBS. Δ
7. USE 85% FOR SCREW/NIUT ENGAGEMENT.
8. MICROSWITCH BZ-2RWB22-A2
9. MICROSWITCH DT-2RW212-A7
10. INTERRUPTER: TRW OPB-970-T55
11. SEE H7365 FOR EXTREMES OF LIMITS
12. LEE SPRING: 4.1 LB/IN. DESIGN HT = 1.4" (10.5 LBS) FREE HT = 4". SQUASH HT = 0.62". Δ
13. MCMASTER-CARR 91246--A540, ST-STEEL
14. CAUTION. SHORT SCREW HERE.

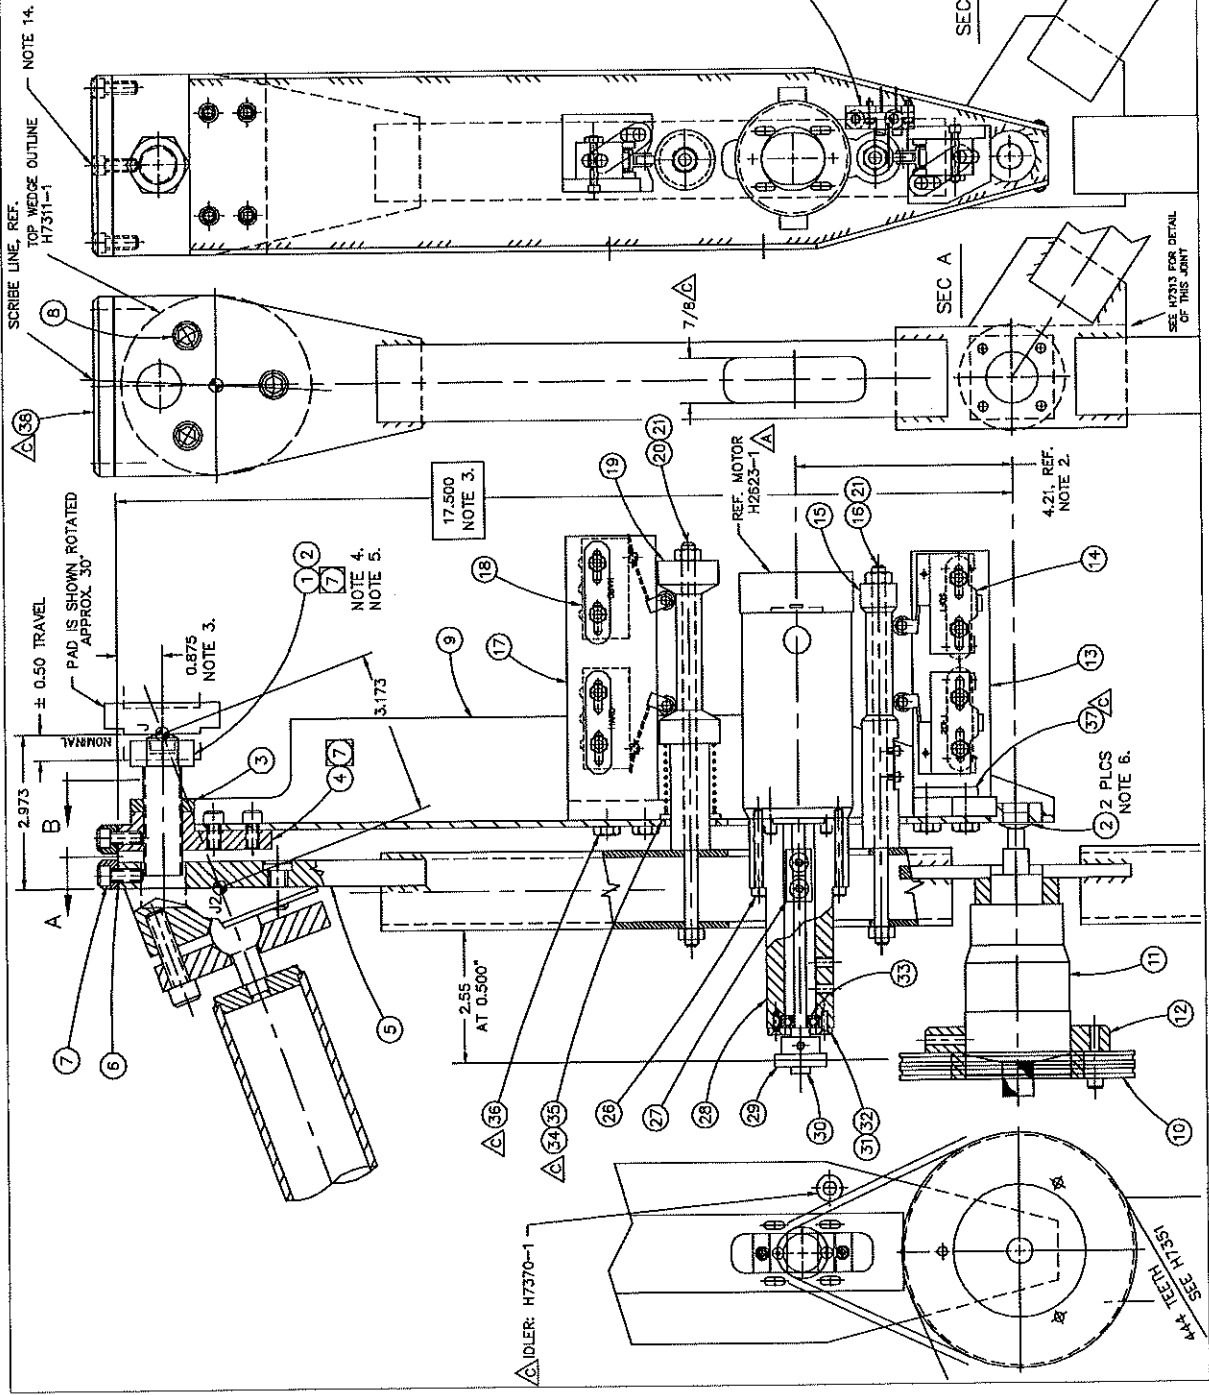

QTY	DESCRIPTION	REF	UNIT	ST	STL
1	INTERRUPTER	H7367-1	ASST		
1	LEVER	H7365-1	ALUM		
1	LEVER	H7365-2	ALUM		
1	LEVER	H7365-3	ALUM		
1	LEVER	H7365-100	ALUM		

KECK/HIRES
CCD FOCUS
SCREW ASSEMBLY
H7312.C


REV	DATE	BY	CHKD	DESCRIPTION
A				UPDATE TO AS-BUILT CONDITION.
B				LAST MOTOR NOTE.
C				ADD PARTS IN 37 (RED PLATE CLAMP)
D				REWORKED TO CORRECT MOUNTING
E				REWORKED TO CORRECT MOUNTING
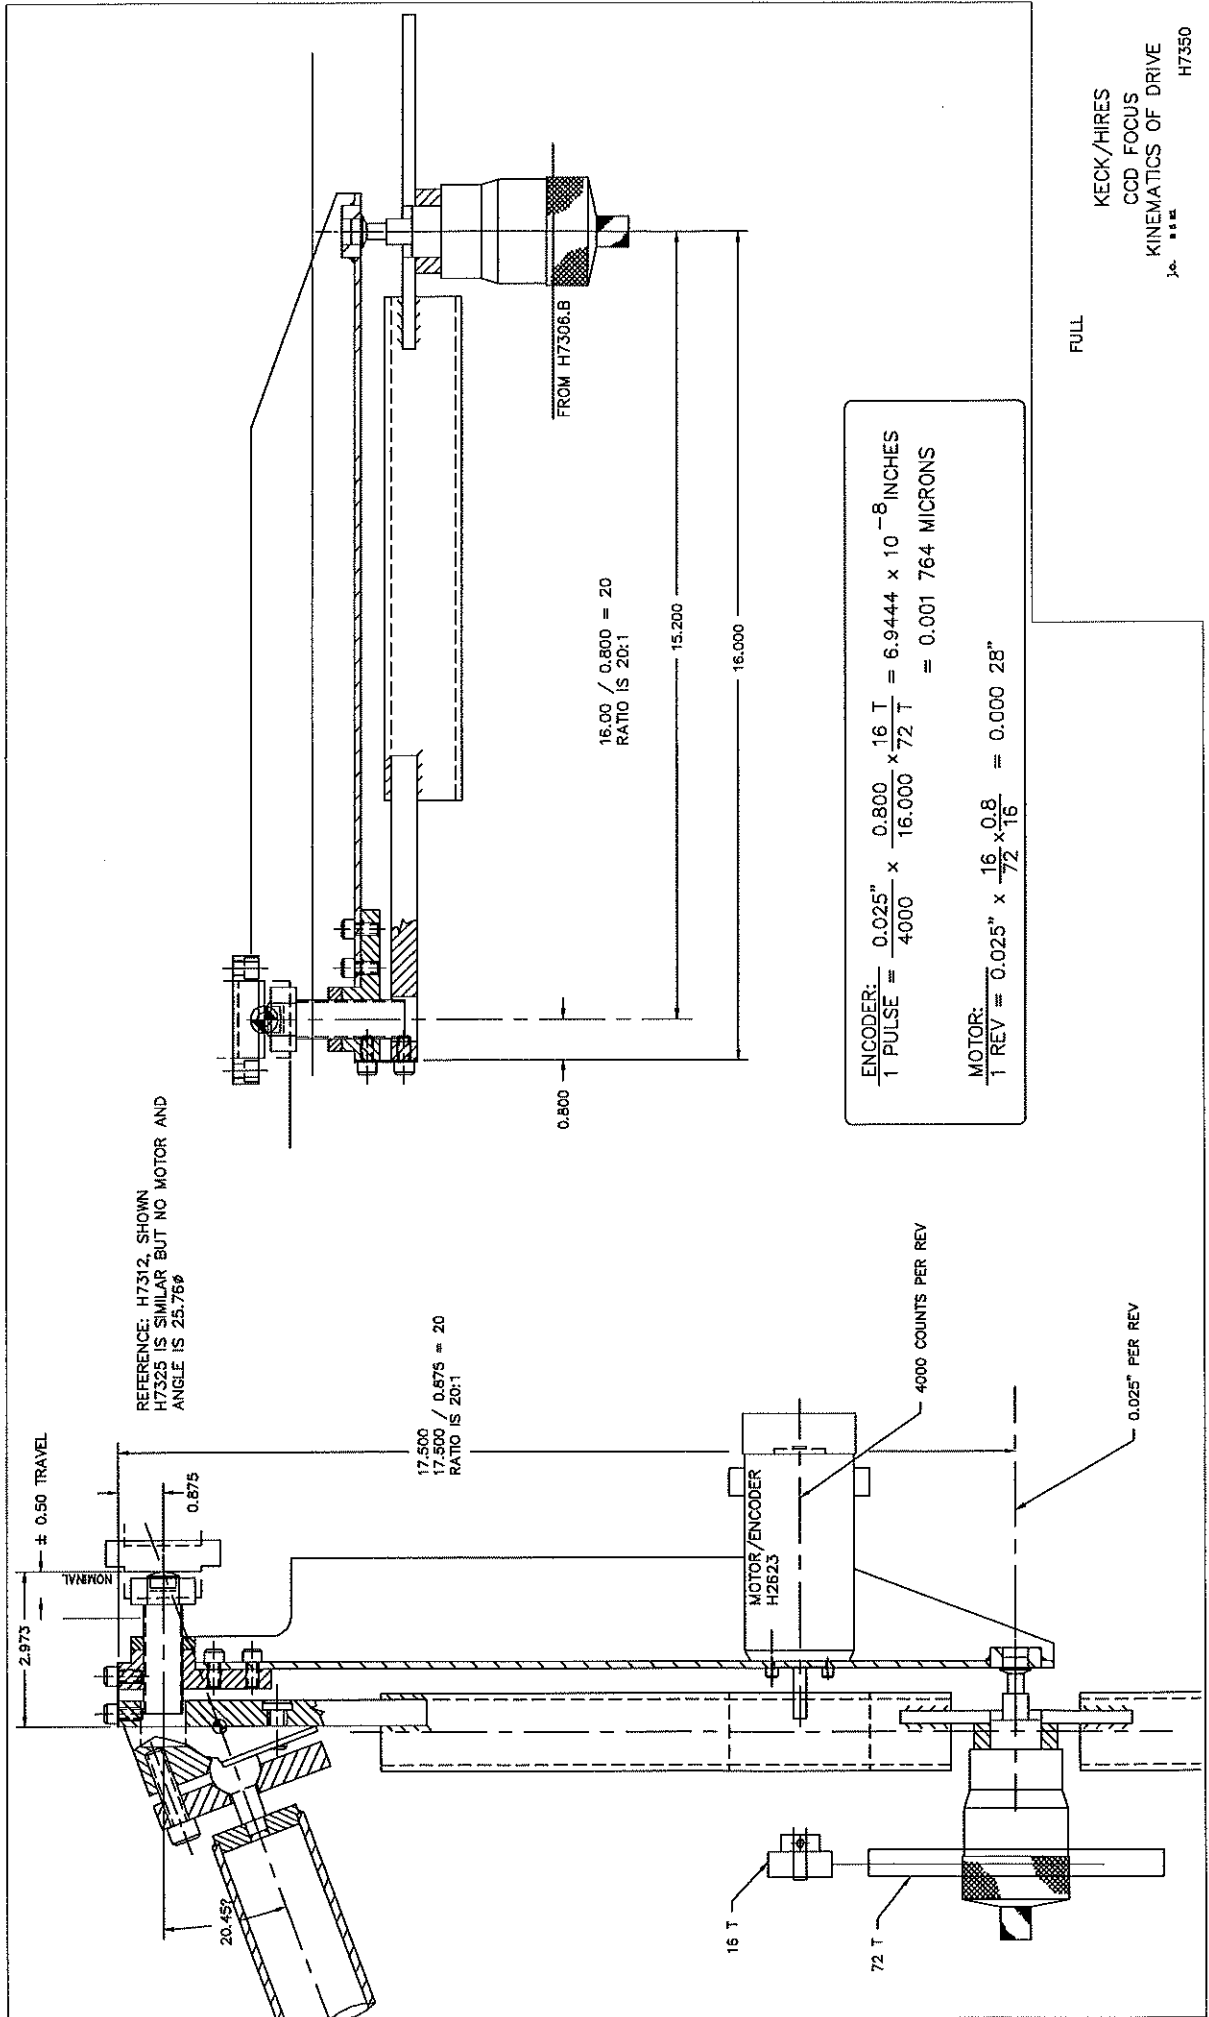

ENCODER: $\frac{0.025"}{1 \text{ PULSE}} = \frac{0.800}{4000} \times \frac{16 \text{ T}}{72 \text{ T}} = 6.9444 \times 10^{-8} \text{ INCHES}$
 $= 0.001764 \text{ MICRONS}$

MOTOR: $\frac{0.025"}{1 \text{ REV}} = \frac{16 \times 0.8}{72 \times 16}$
 $= 0.00028"$

FULL
 KECK/HIRES
 CCD FOCUS
 KINEMATICS OF DRIVE
 J.A. H.I.E.
 H7350

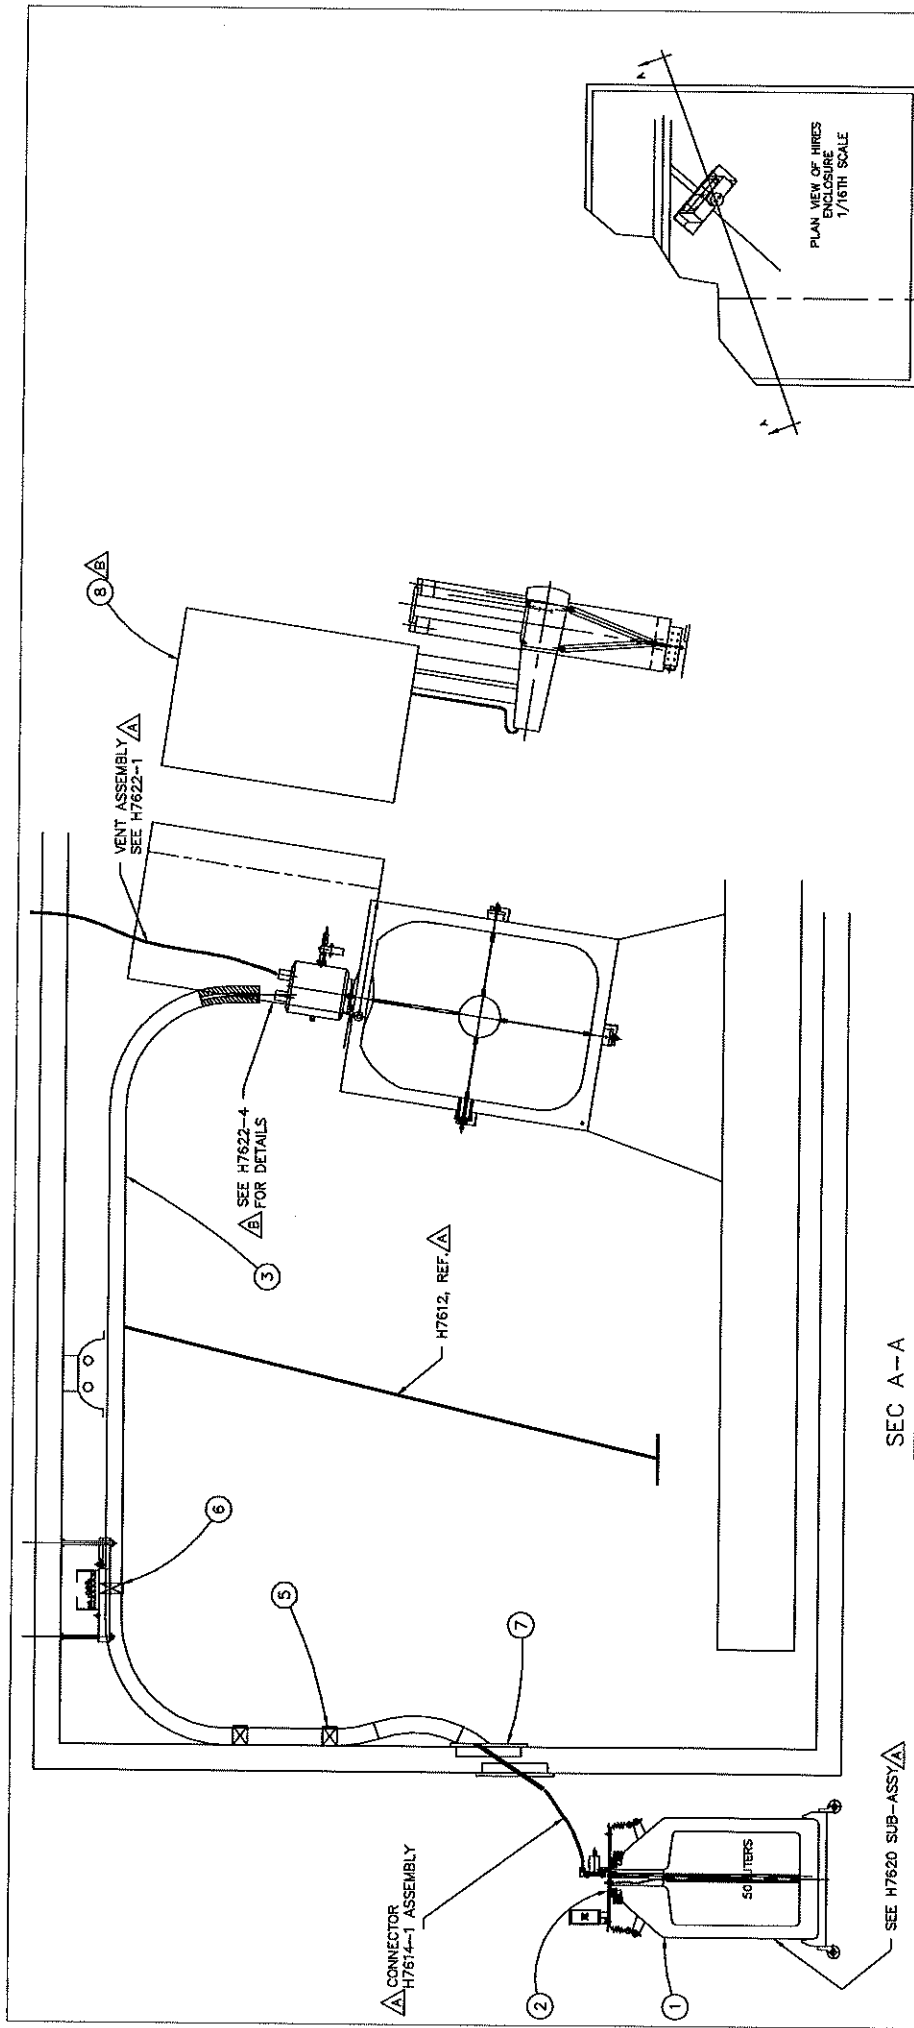

SEC A-A

LIQUID NITROGEN FILL/VENT SYSTEM

NOTES:

- DO NOT SCALE THIS DRAWING.
- SEE H1462 ET AL FOR CCD CONTROLLER BOX

H1462-1	1	CCD CONTROLLER BOX	ASSY
H7620-1	2	WALL FEED THRU	PVC
H7620-2	2	TRANSFER ASSEMBLY	ALUM
H7620-3	1	TRANSFER LINE	ALUM
H7620-4	2	TRANSFER LINE	ALUM
H7620-5	2	TRANSFER ASSEMBLY	ALUM
H7620-6	1	SUPPLY DOWEL	30 L



1/8

A	H1462	1	CCD CONTROLLER BOX
B	H7620	2	WALL FEED THRU
C	H7620	2	TRANSFER ASSEMBLY
D	H7620	1	TRANSFER LINE
E	H7620	2	TRANSFER LINE
F	H7620	2	TRANSFER ASSEMBLY
G	H7620	1	SUPPLY DOWEL

KECK/HIRES
 CGD-DEWAR
 CRYOGENIC TRANSFER

H7600.B

J.P. 3 11 83

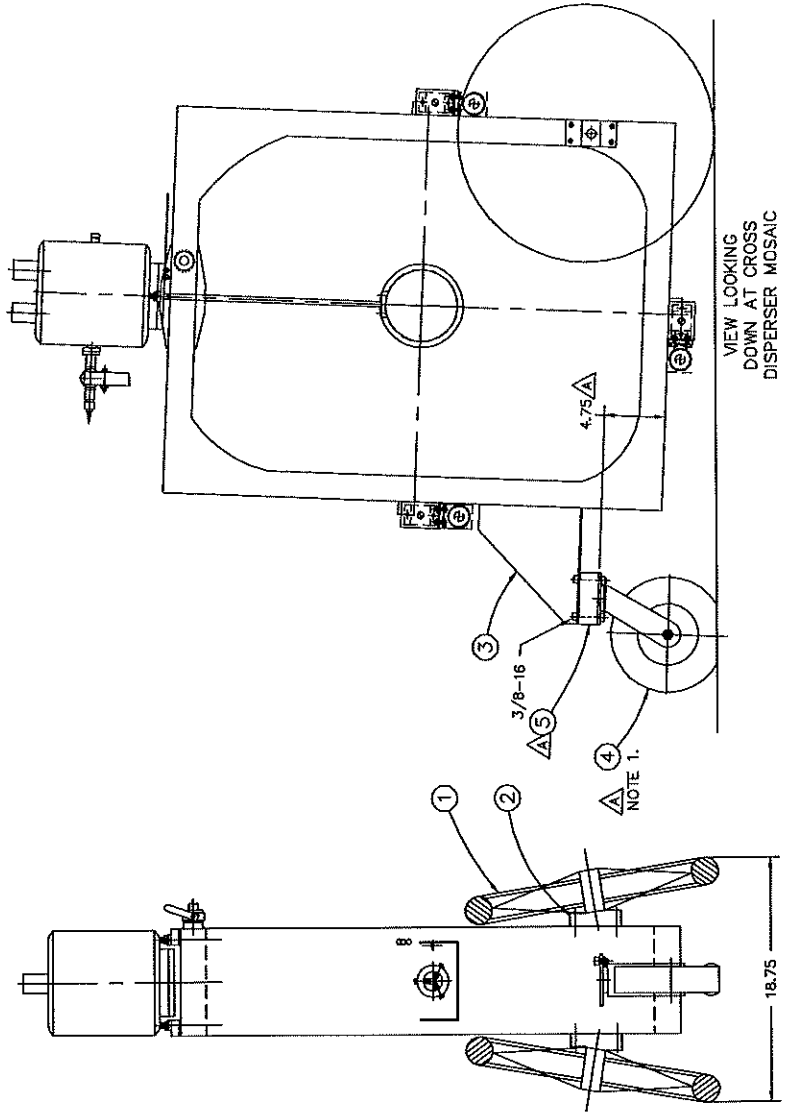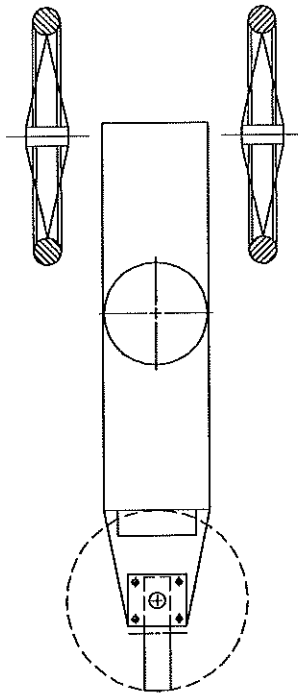

① DEWAR CART ASSEMBLY

2 REQ'D/A

NOTES:

1. UNDER-INFLATE TIRE AS SHOWN

PER ASSEMBLY

QTY	DESCRIPTION	UNIT	REQ'D	ASSEMBLY
1	CASTER	STEEL	4	1
1	CASTER MOUNT	STEEL	3	1
2	FRONT BLOCK	STEEL	2	2
2	FRONT BLOCK	STEEL	2	2
2	FRONT BLOCK	STEEL	2	2
2	FRONT BLOCK	STEEL	2	2


1/4

KECK/HIRES
DEWAR CART
ASSEMBLY


J.O. 3 25 82

H7815.A

A. 13.1.81 [6.] PART BLOCK FOR MORE OBVIOUS CLEARANCE.

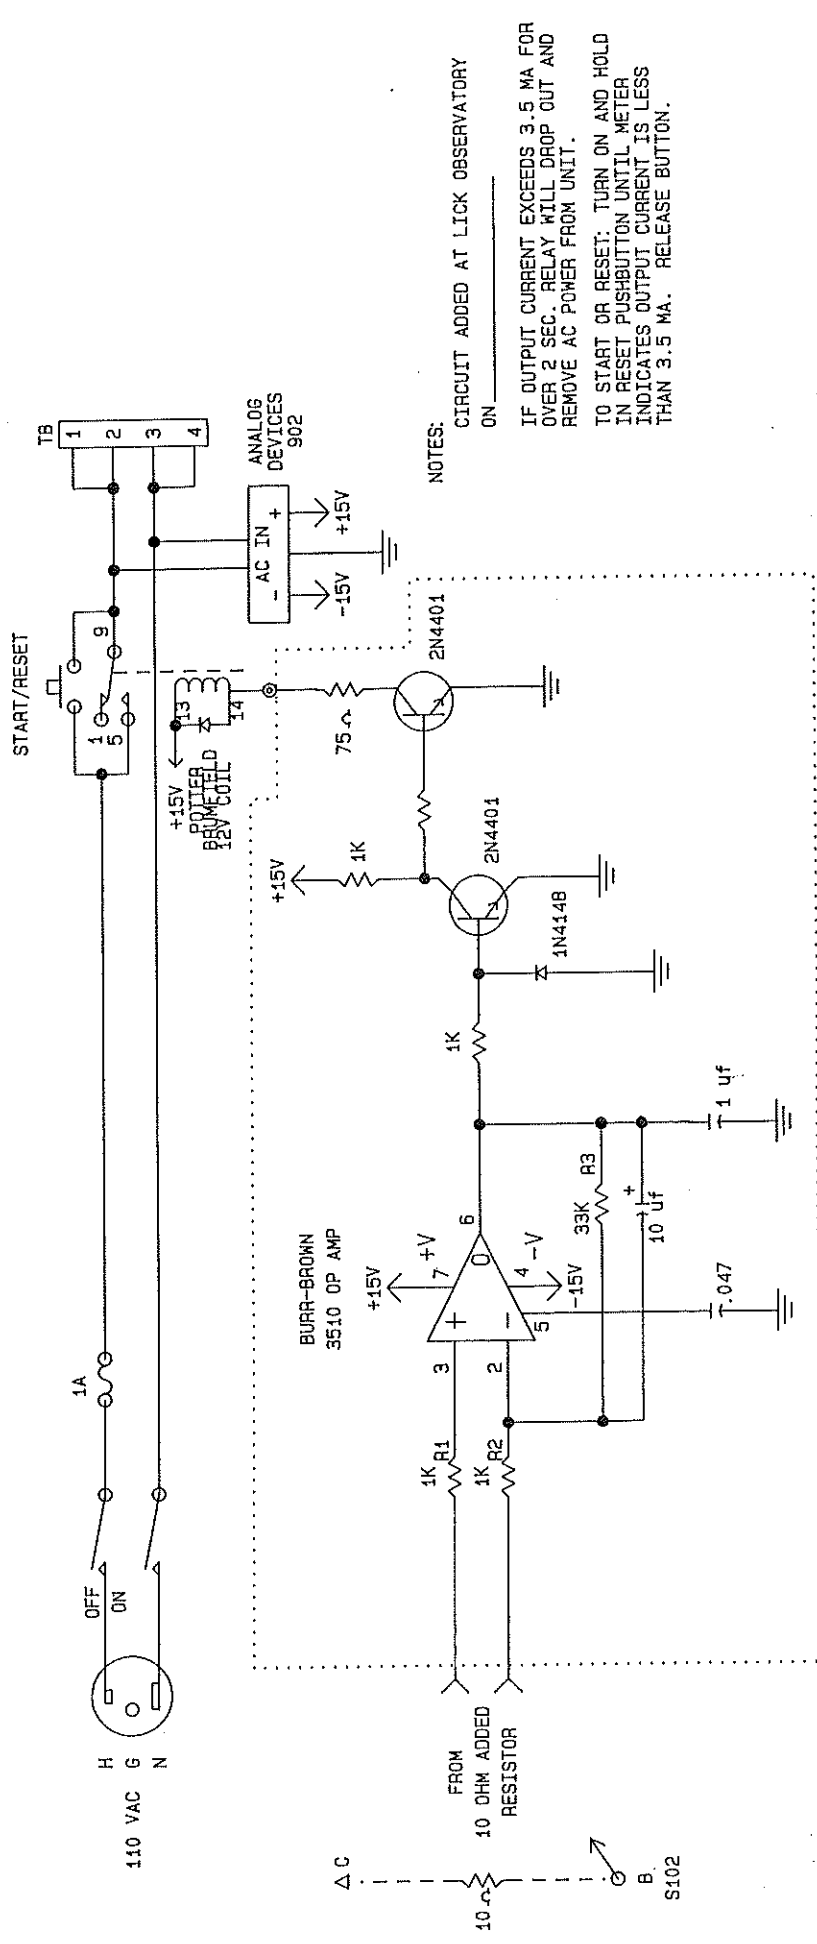

NOTES:
 CIRCUIT ADDED AT LICK OBSERVATORY ON _____
 IF OUTPUT CURRENT EXCEEDS 3.5 MA FOR OVER 2 SEC. RELAY WILL DROP OUT AND REMOVE AC POWER FROM UNIT.
 TO START OR RESET: TURN ON AND HOLD IN RESET PUSHBUTTON UNTIL METER INDICATES OUTPUT CURRENT IS LESS THAN 3.5 MA. RELEASE BUTTON.

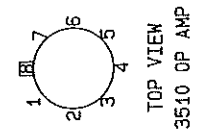

TOP VIEW
 3510 OP AMP

**UNIVERSITY OF CALIFORNIA
 LICK OBSERVATORY**


**OVERLOAD PROTECTION FOR
 VARIAN ION PUMP**

DES'N BY LBR CRD	APPROVED BY	DWG. NO. EL-1027-2S	
DRW'N BY CD			DATE 4-19-84
CHK'D BY			


MARK	DATE	DRAWN	CHKD	REVISION
	1-24-90	CD		ENTERED IN PCAD

Appendix G List of Drawings — Housing & Structure

1. H6000 Locating Tree
2. H0010 General Telescope Assembly
3. P0010 General Layout
4. H0012 Elevation Axle Detail
5. H0102 Final Optical Layout
6. H0148 Super-Duper 3 Layout
7. H6100 Main Assembly Drawing
8. H6102 Nasmyth Deck and Leg Detail
9. H6120 Support Foot Detail (Ball-On-Flat)
10. H6170 Optical Bench Assembly (Main Structure)
11. H6174 Support Foot Detail (Ball-In-Groove)
12. H6177 Support Foot Detail (Ball-In-Cone)
13. H6200 Main Support Framework
14. H6220 Interferometer Mounting for Mosaic Testing
15. H6222 Details of Testing
16. H6400 Main Housing Assembly
17. H6410 3-D of Main Housing
18. H6425 Electronics Vault Assembly
19. H6429 Hatch Assembly
20. H6460 Light Trap Assembly
21. H6461 Light Trap Details
22. H6470 Housing and Freezer During Testing at UCSC

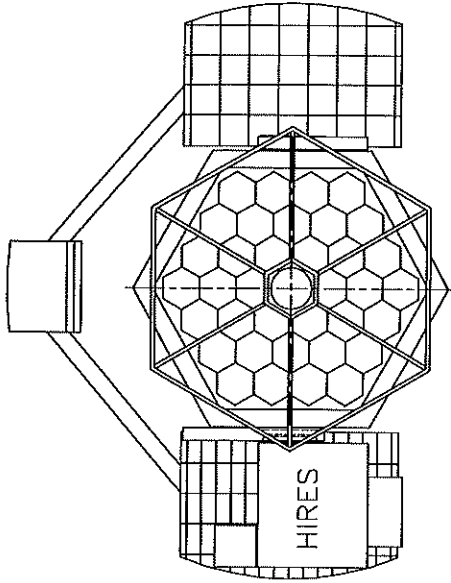


TOP VIEW

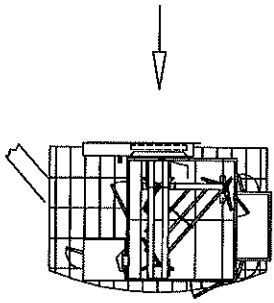


TOP VIEW
ROOF REMOVED


HIGH RESOLUTION SPECTROGRAPH
MOUNTED ON THE KECK TELESCOPE

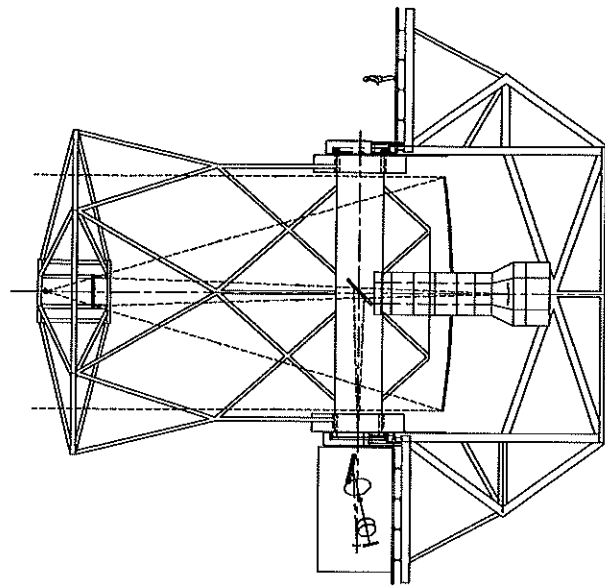



FRONT VIEW

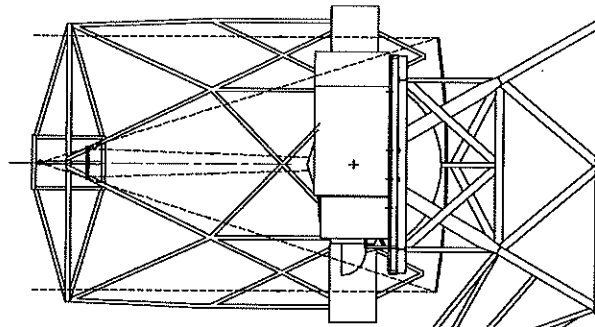


SIDE VIEW

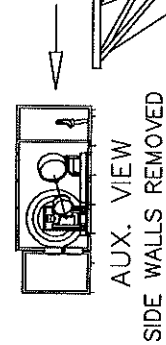

AUX. VIEW
SIDE WALLS REMOVED

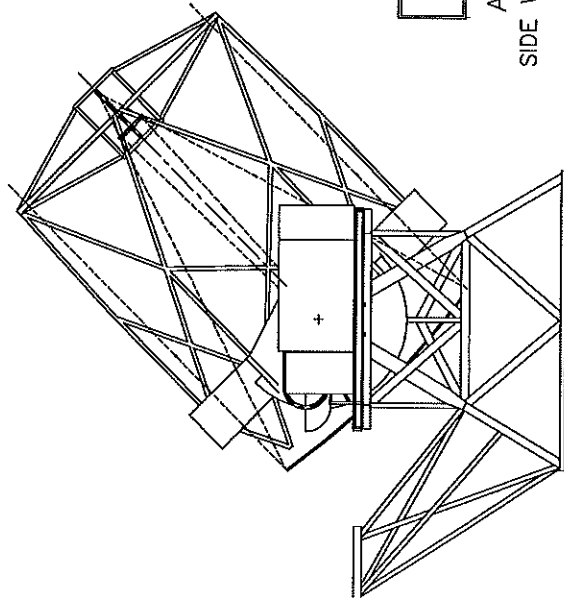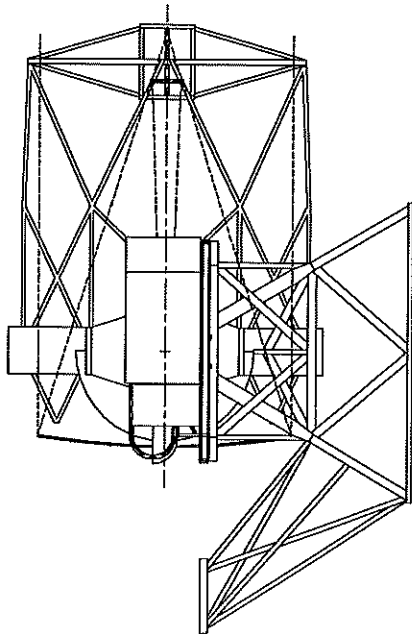

SIDE VIEWS WITH ROTATION

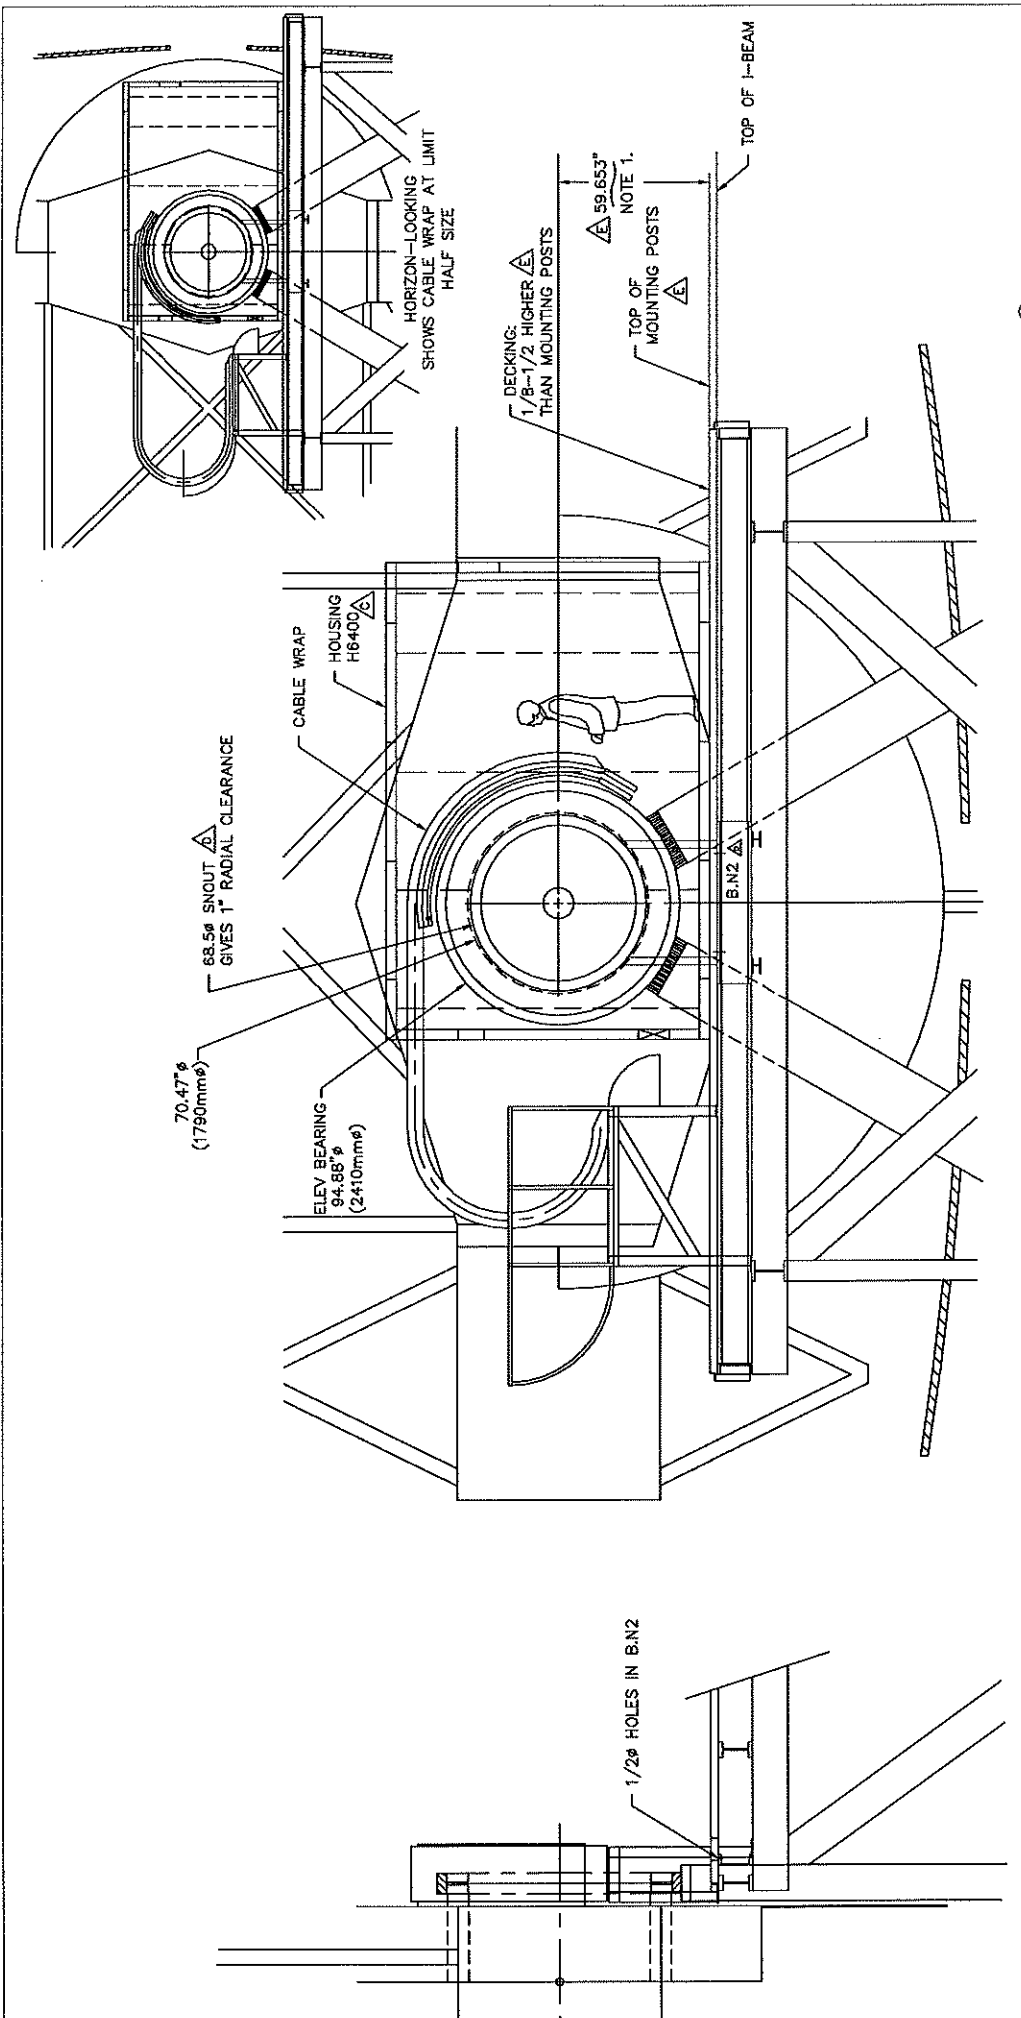


① LEFT NASMYTH PLATFORM

NOTES:
 1. RON LAUB MEASURED THIS DISTANCE ON 5-16-91.
 2. FOR REFERENCE, RIGHT NASMYTH DISTANCE IS 59.450.

1/20

NO.	DATE	BY	CHKD	DESCRIPTION
1	10/11/90	J.A.		ISSUED FOR FABRICATION
2	10/11/90	J.A.		ISSUED FOR FABRICATION
3	10/11/90	J.A.		ISSUED FOR FABRICATION
4	10/11/90	J.A.		ISSUED FOR FABRICATION
5	10/11/90	J.A.		ISSUED FOR FABRICATION

KECK/HIRES
 GENERAL ASSEMBLY
 ELEVATION AXLE DETAIL
 14 9 14 88
 H0012.E

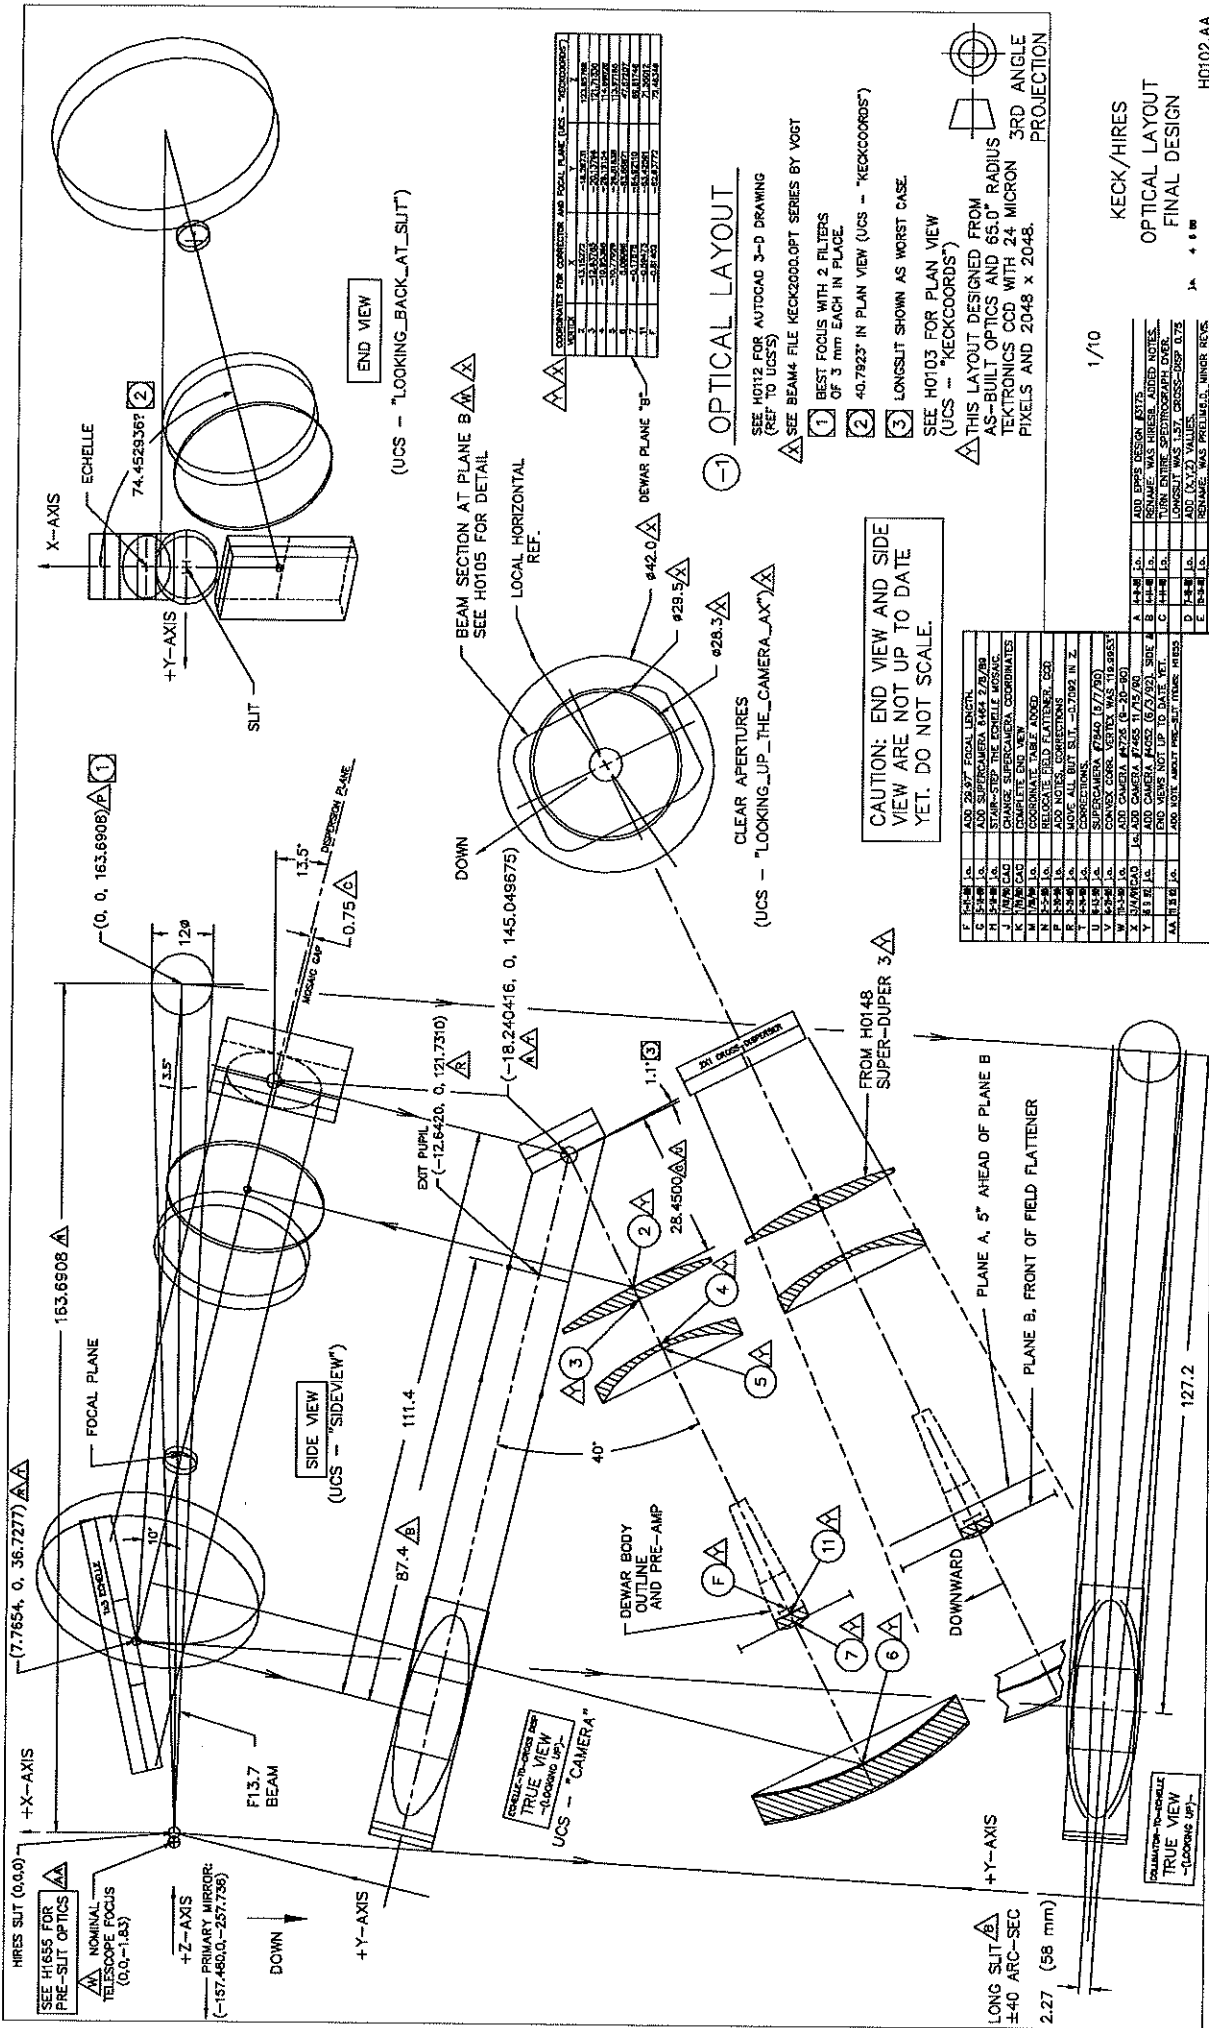

COORDINATES FOR CONJECTOR AND FOCAL PLANE (UCS = "KECKCOORDS")

NUMBER	X	Y	Z
1	-187.480	0	-257.736
2	-187.480	0	-257.736
3	-187.480	0	-257.736
OPTICAL LAYOUT

- SEE H0172 FOR AUTOCAD 3-D DRAWING (REF TO UCS)
- SEE BEAM4 FILE KECK2000.OPT SERIES BY V06T
- BEST FOCUS WITH 2 FILTERS OF 3 mm EACH IN PLACE
- 40.7923" IN PLAN VIEW (UCS = "KECKCOORDS")
- LONGSLIT SHOWN AS WORST CASE
- SEE H0103 FOR PLAN VIEW (UCS = "KECKCOORDS")
- THIS LAYOUT DESIGNED FROM AS-BUILT OPTICS AND 65.0" RADIUS TEKTRONICS CCD WITH 24 MICRON PIXELS AND 2048 x 2048.


CAUTION: END VIEW AND SIDE VIEW ARE NOT UP TO DATE YET. DO NOT SCALE.

NO.	DESCRIPTION	DATE
1	ADD 25.97" FOCAL LENGTH	10/1/92
2	ADD 1.17" DEPRESSION	10/1/92
3	START-STEP THE FOCAL PLANE	10/1/92
4	CHANGE SUPER-CAMERA COORDINATES	10/1/92
5	COMPLETE END VIEW	10/1/92
6	COORDINATE TABLE ADDED	10/1/92
7	ADD NOTE TO FLATTENER DEB	10/1/92
8	ADD NOTE TO FLATTENER DEB	10/1/92
9	MOVE ALL BUT SLIT -2.7092 IN X	10/1/92
10	CORRECTIONS	10/1/92
11	SUPER-CAMERA F7940 (9/7/92)	9/7/92
12	ADD CAMERA F7940 (9/7/92)	9/7/92
13	ADD CAMERA F7940 (9/7/92)	9/7/92
1/10

KECK/HIRES
OPTICAL LAYOUT
FINAL DESIGN

H0102.AA

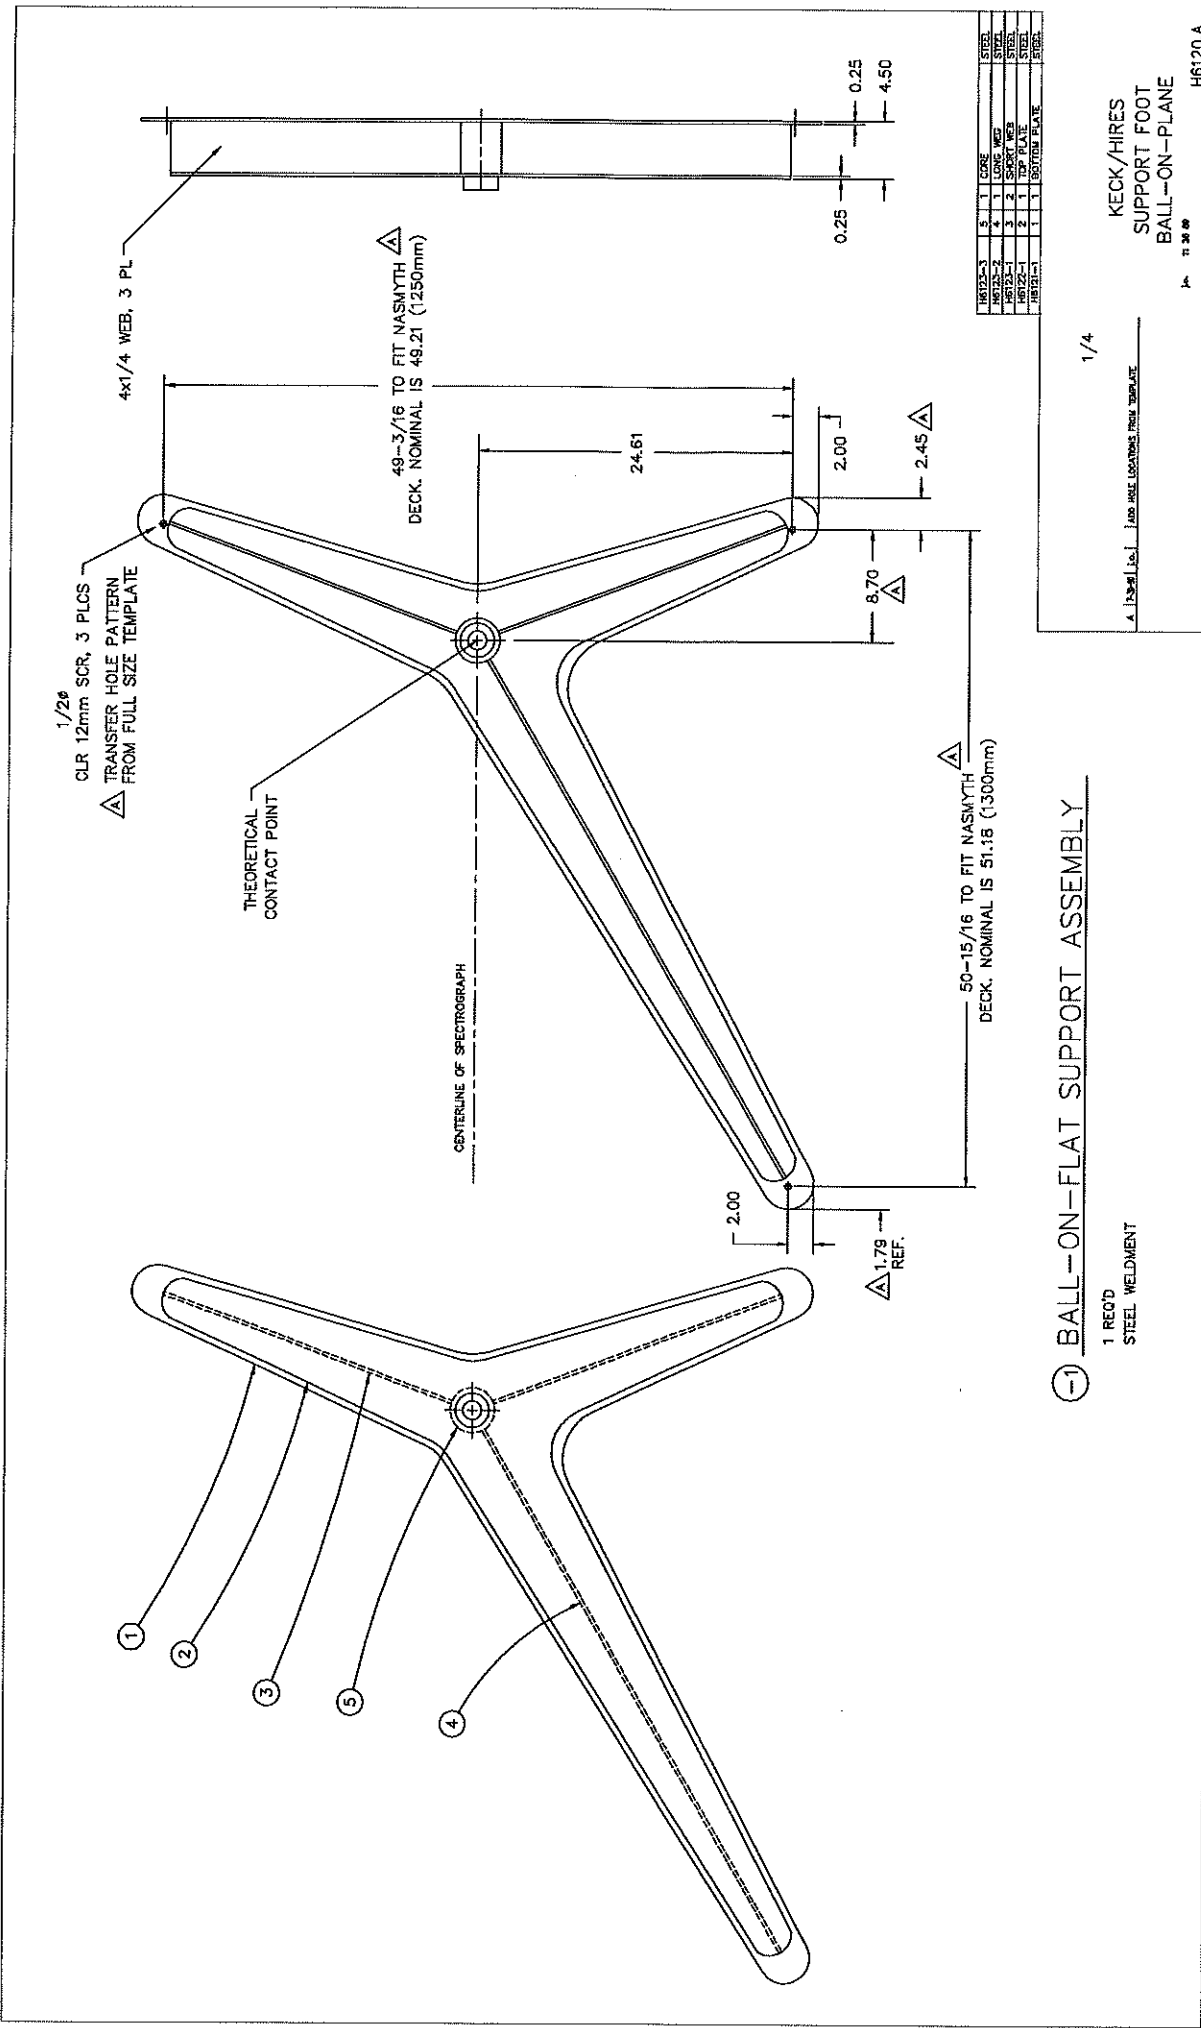

STEP	DESCRIPTION	STEP
1	CORE	5
2	LONG WEB	6
3	SUPPORT WEB	7
4	TOP PLATE	8
5	BOTTOM PLATE	9


1/4

1.5mm L.S. | ADD HOLE LOCATIONS FROM TEMPLATE

KECK/HIRES
 SUPPORT FOOT
 BALL-ON-PLANE
 H612D.A

BALL-ON-FLAT SUPPORT ASSEMBLY

1 REQ'D
 STEEL WELDMENT

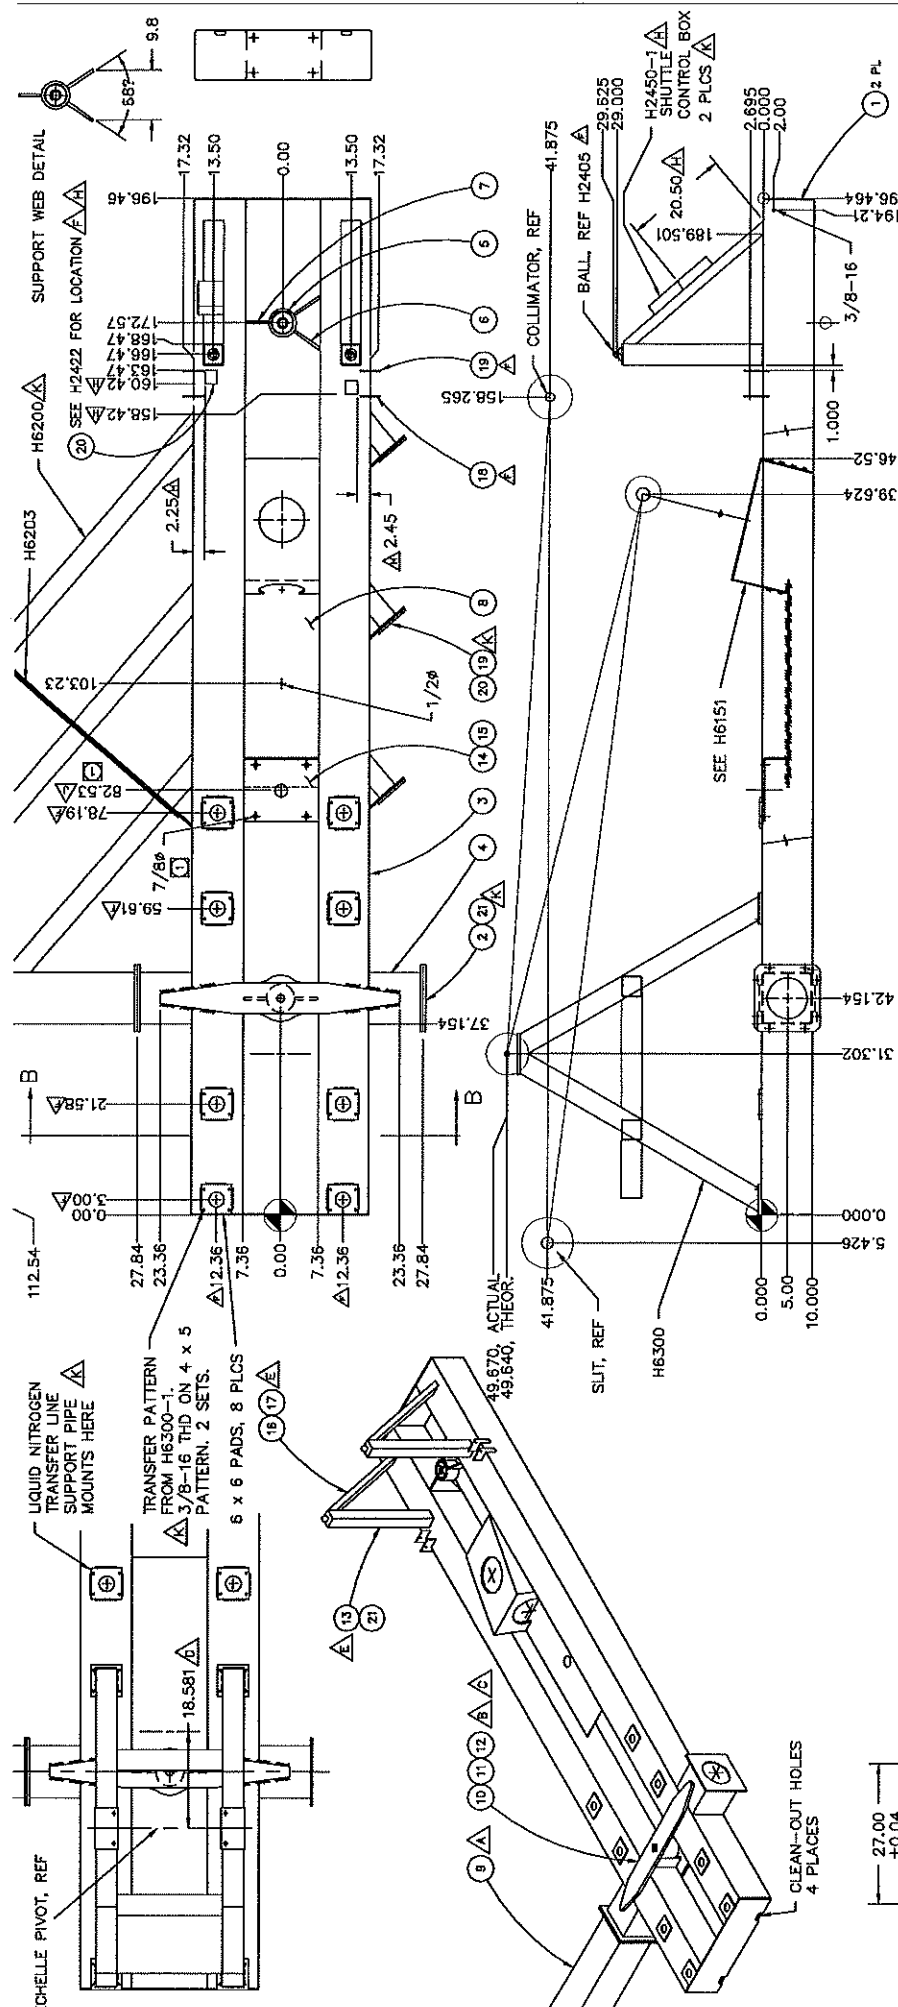

ITEM	DESCRIPTION	QTY	MATERIAL
1	TOP UP	1	STEEL
2	OUTRIGGER	1	ASTY
3	PLATE 300x125x1/2	1	STEEL
4	WEB	3	STEEL
5	WEBS	7	STEEL
6	WEBS	7	STEEL
ITEM	DESCRIPTION	QTY	MATERIAL
1	FRONT PIVOT PLATE	1	STEEL
2	FRONT PIVOT PLATE	1	STEEL
3	FRONT PIVOT PLATE	1	STEEL
OPTICAL BENCH STRUCTURE

- 1 REQ'D STEEL WELDMENT SANDBLAST AND PRIME
- 2. PAINT DETAIL: PAINT WITH DUPONT 8255 RED CORLAR EPOXY PRIMER, 8255 ACTIVATOR AND 35085 THINNER AT 30% FOLLOWED BY DUPONT IRON POLYURETHANE ENAMEL N8079JH FLAT BLACK WITH 192S ACTIVATOR AND 8485S ENAMEL REDUCER. ADD REDUCER ONLY IF NEEDED. 24 HOURS BETWEEN PRIMER AND FINISH COAT.
- 3. 7/8" HOLES ON 10 X 10 PATTERN TO SUPPORT RUGER 1/2 TON CRANE.


1/10

KECK/HIRES
OPTICAL BENCH
ASSEMBLY


H6170.K

SEC B-B



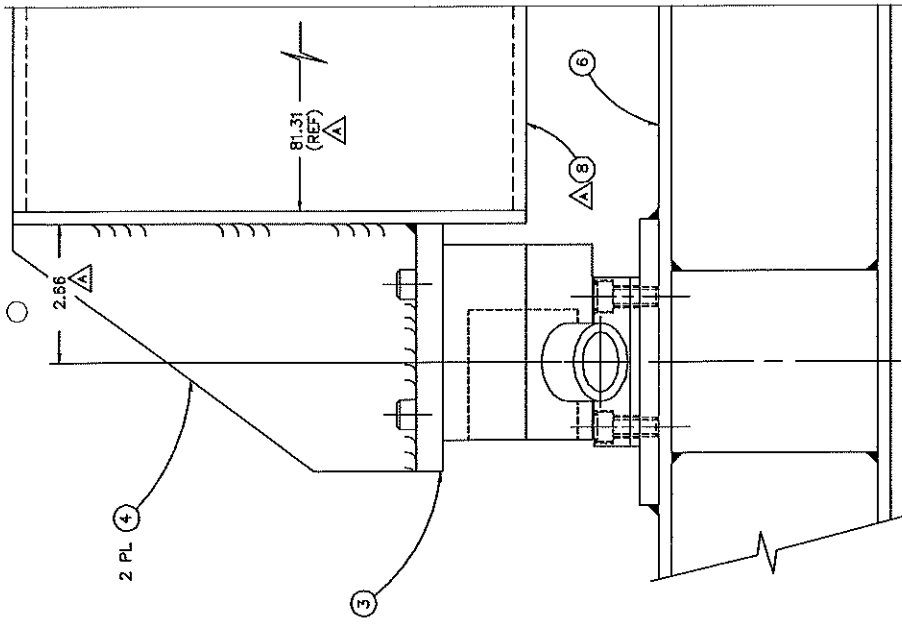

QTY	DESCRIPTION	MATERIAL
1	BLANK	STL
1	OUTRIGGER	STL
4	3/8-24 ANCS	SSSTL
1	WRENCH	WRENCH
1	ROLLER	ANAL STL
2	SUPPORT	STL
1	SUPPORT BASE	STL
1	CAM FOLLOWER	STL
1	CAM FOLLOWER MOUNT	STL
1	CAM FOLLOWER RING	NOTE 1

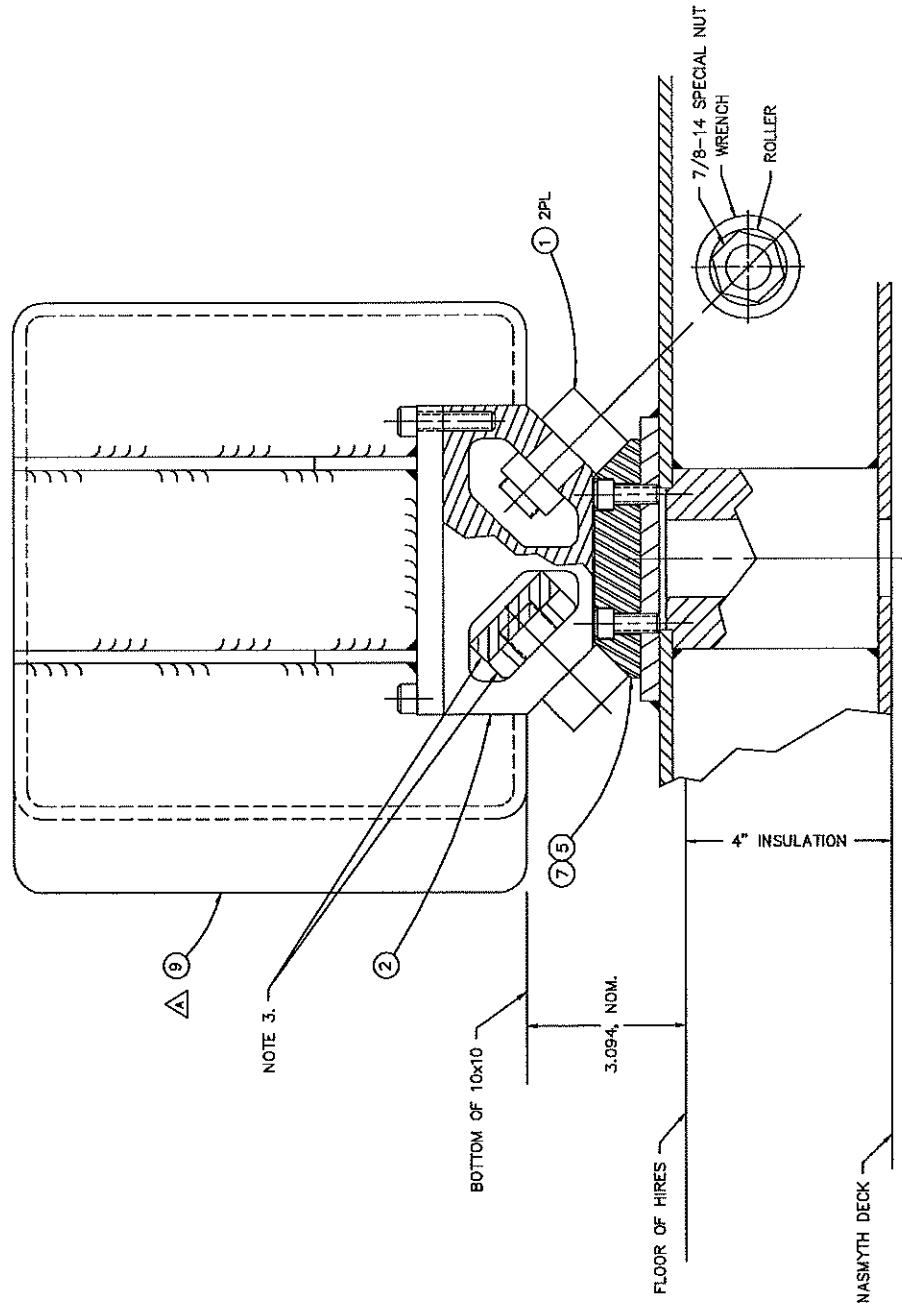


VIEW LOOKING AT THE SLIT BUT PERPENDICULAR TO THE OPTICAL CENTERLINE

① CROSSED ROLLER SUPPORT


- 1 REQD
NO VERTICAL ADJUSTMENT
11,280 lbs ON CAM FOLLOWERS
- NOTES:
1. CROWNED, HEAVY DUTY, SEALED CAM FOLLOWER
2. TRACK GROUND STRAIGHT (NOT CROWNED)
3. AFTER HEAT TREATING TO ROCKWELL 60C.
3. SHOWS WRENCH - 3000 IN-LBS CLAMPING TORQUE.

KECK/HIRES
OPTICAL BENCH
CROSSED ROLLER ASSY
H6174-A

FULL
A 10/28/60 CAD 2.63 WAS 2.25; ADD ITEMS 8 & 9
REV

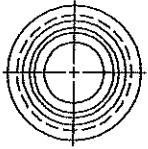

UNIBAL LS-19
 HEIM CO. 63,000 LBS
 1.25" WIDE, 2.625" OD
 1.1875" ID
 BRONZE INSERT
 2" BALL

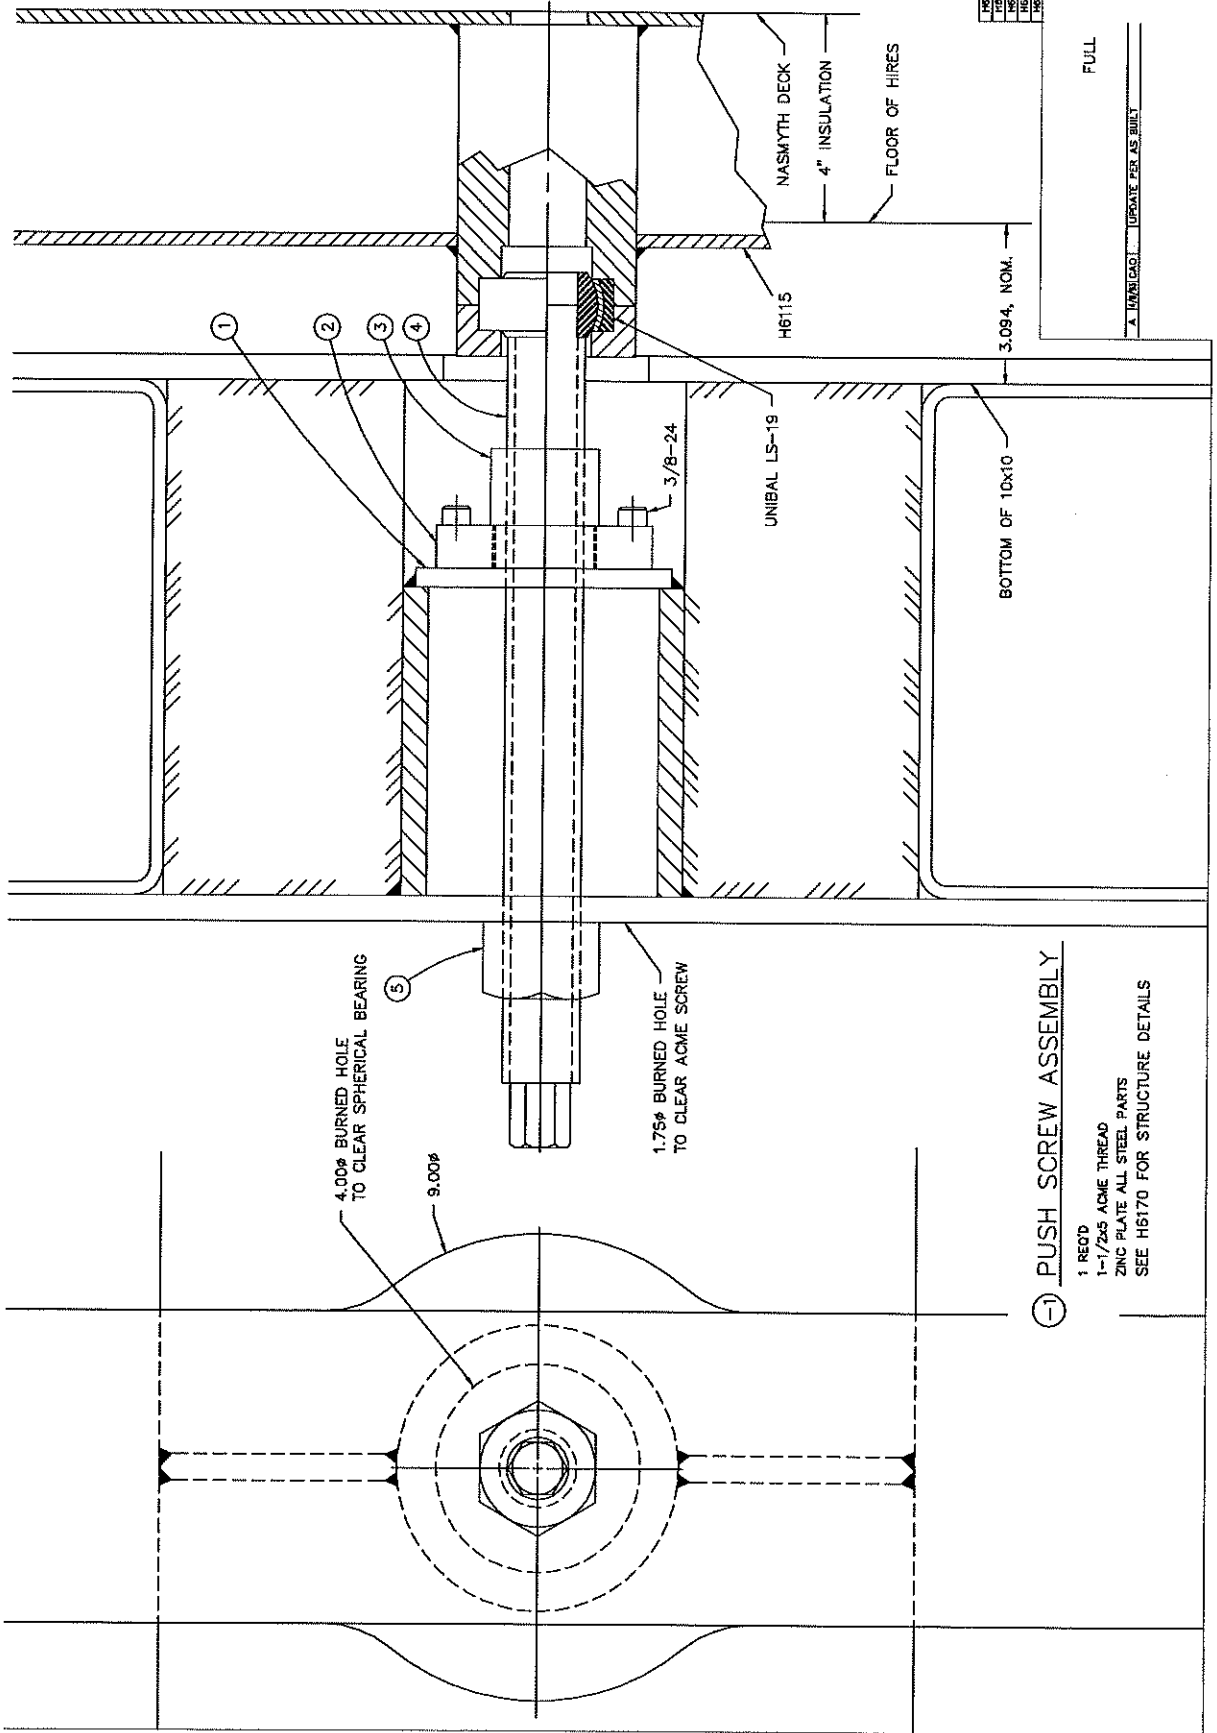

H6172-5	5	1	LOCK NUT	STL
H6172-6	4	1	ACME SCREW	4140
H6172-3	3	1	ACME NUT	BRONZE
H6172-4	2	1	ACME FLANGE	STL
H6172-2	1	1	FLUSH PLATE	STL

KECK/HIRES
 BALL/CONE SUPPORT
 PUSH SCREW DETAIL
 H6177.A

FULL

A UNIBAL LS-19 UPDATE PER AS BUILT



4.00" BURNED HOLE
 TO CLEAR SPHERICAL BEARING

9.00"

1.75" BURNED HOLE
 TO CLEAR ACME SCREW


(-) PUSH SCREW ASSEMBLY

- 1 REQ'D
- 1-1/2" ACME THREAD
- ZINC PLATE ALL STEEL PARTS
- SEE H6170 FOR STRUCTURE DETAILS

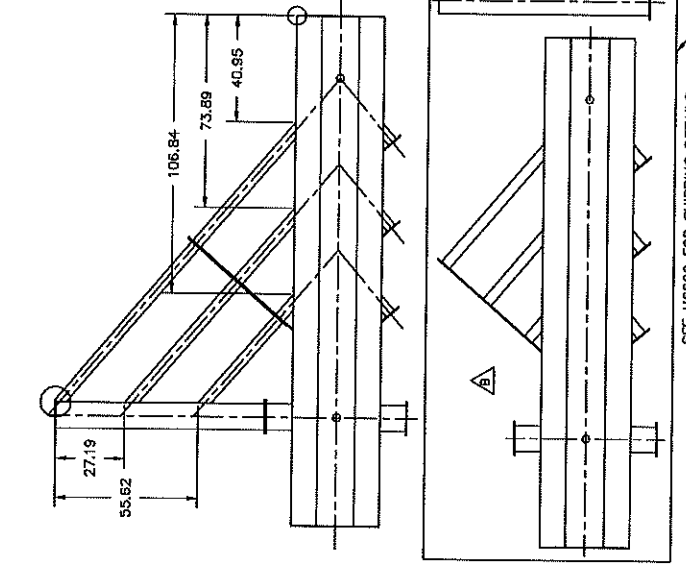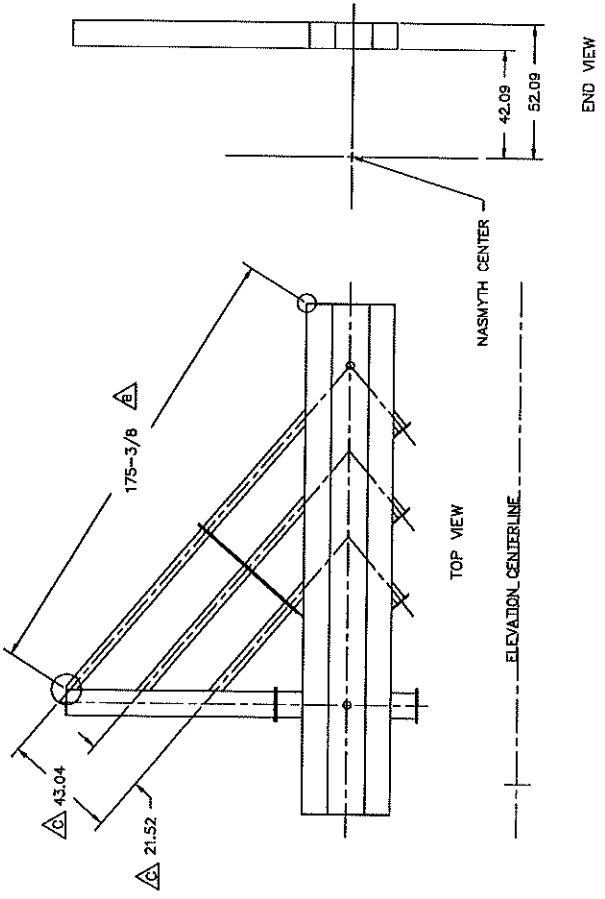

SEE H6600 FOR SHIPPING DETAILS

8' X 24' TRAILER

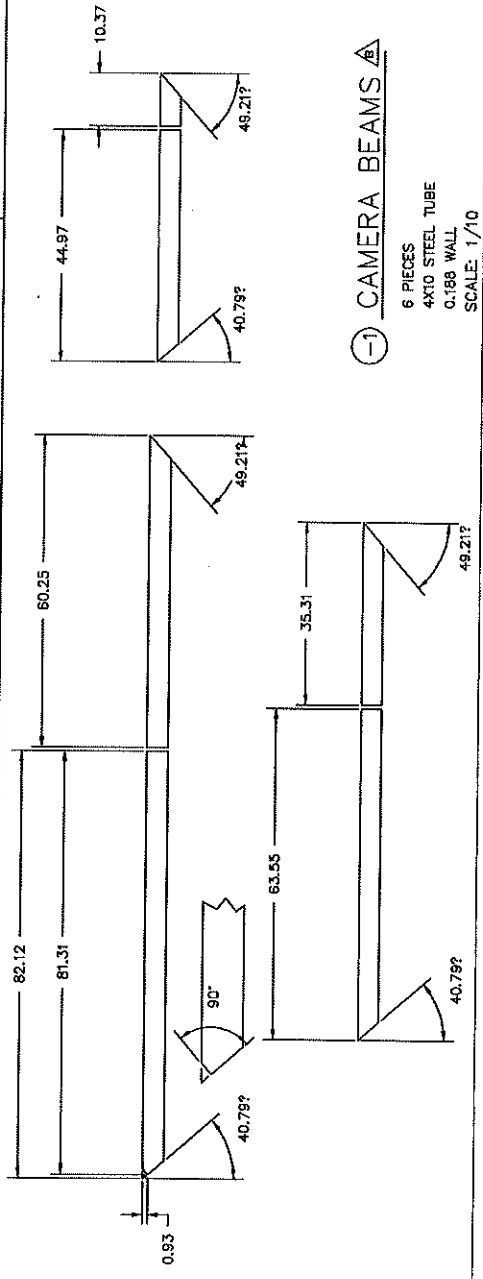



② HOOKS Δ
 3 REQ'D
 4X10 STEEL TUBE
 0.188 WALL
 SCALE: 1/10

① CAMERA BEAMS Δ
 6 PIECES
 4X10 STEEL TUBE
 0.188 WALL
 SCALE: 1/10

0.050

A	FROM I.C.	EXTEND FRAME 12" (FROM SUD)
B	FROM I.C.	MODIFY AND PARTS - 1, 2, 3
C	FROM I.C.	ADD DIMENSIONS, CLEANUP

KECK/HIRES
 SUPPORT STRUCTURE
 FRAME DETAIL
 14 11 11 88
 H6200.C

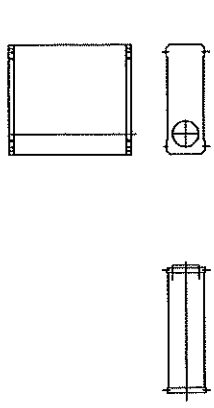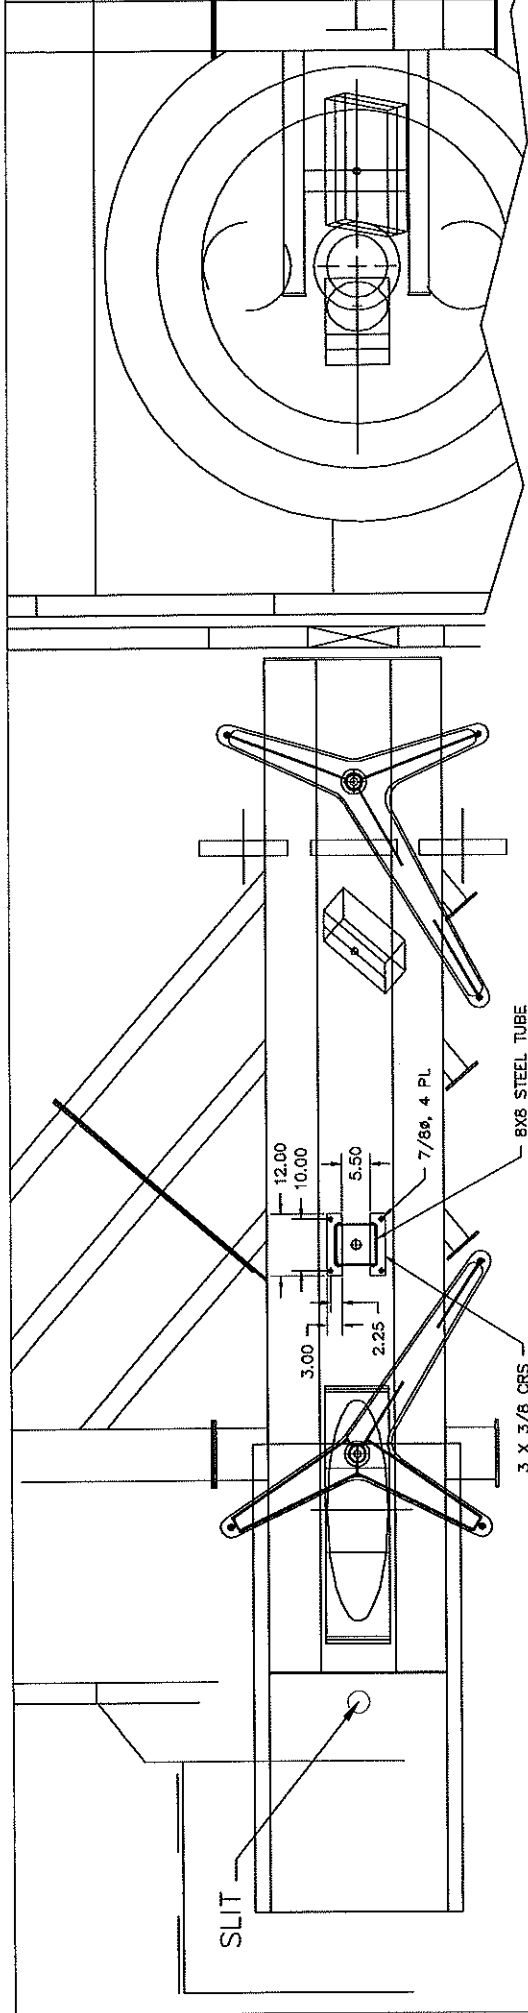


INTERFEROMETER MOUNT




1 REQ'D

- NOTES:
1. NO SPACER IS REQUIRED TO LOOK AT THE LOWER ECHELLE CRACK.
 2. 2" SPACER IS REQUIRED TO LOOK AT THE CROSS DISPERSER CRACK.
 3. THE 5.45" SPACER IS REQUIRED TO LOOK AT THE UPPER ECHELLE CRACK.

1/10

KECK/HIRES
 INTERFEROMETER MOUNT
 MOSAIC TESTING
 Jan. 1985
 H6220

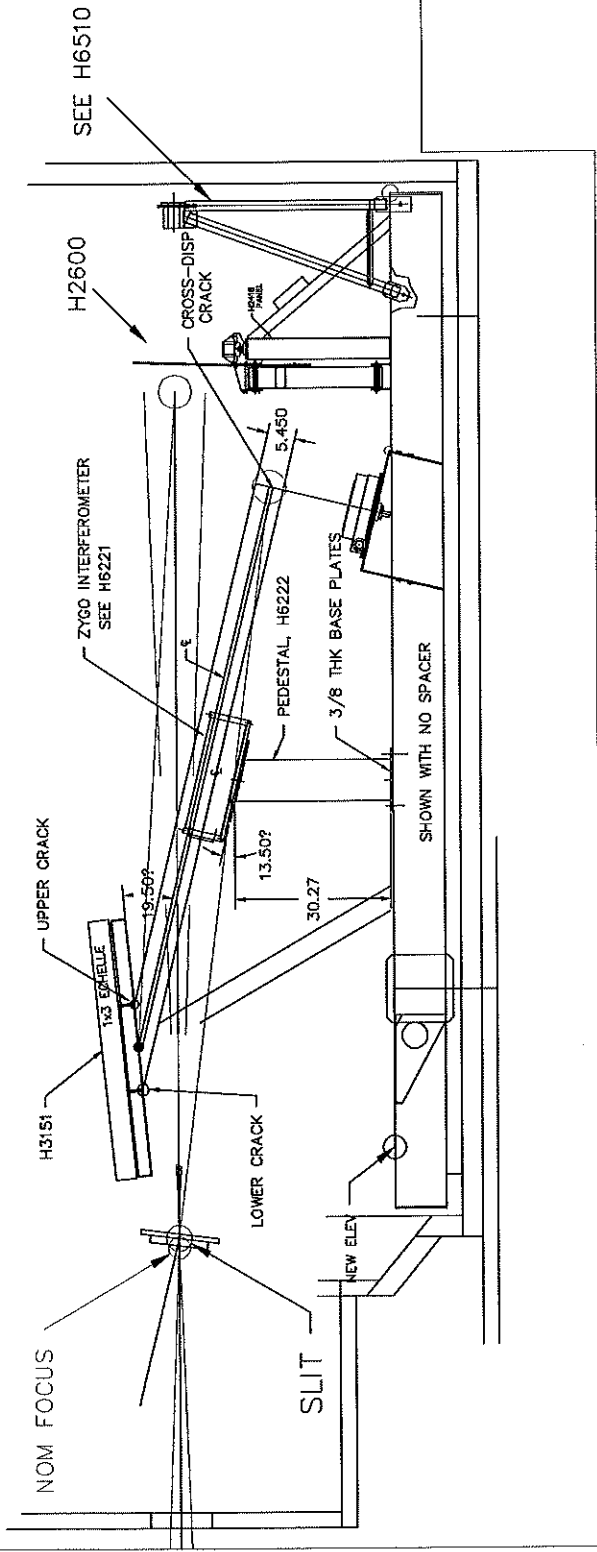

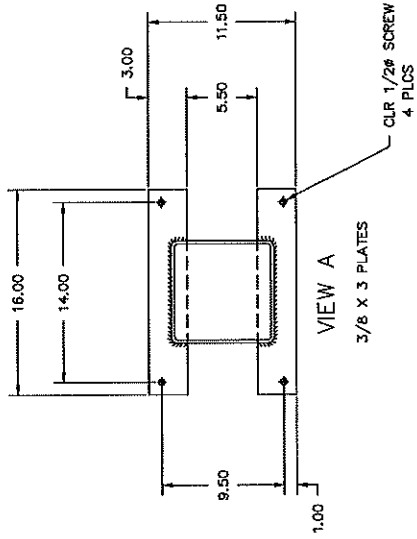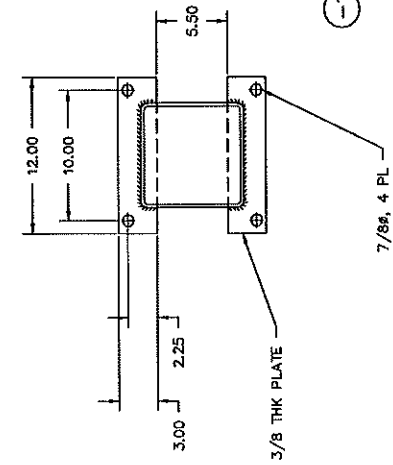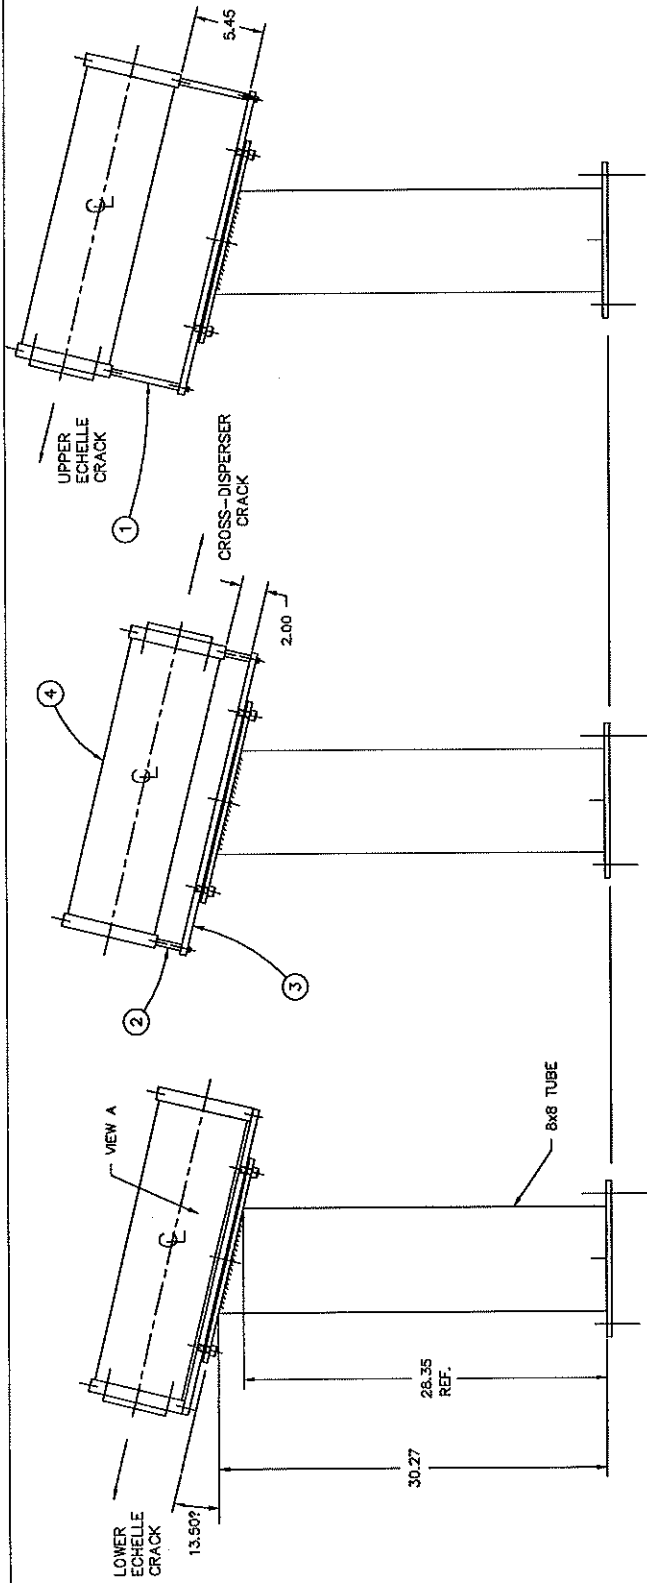

PEDESTAL

1 REQ'D
STEEL
PAINT WHITE




1/4

A. 11281 (L.S.) UPDATE TO AS-BUILT CONDITION.

H6222-1	4	1	INTERFEROMETER	2700
H6222-2	3	1	BASE	ALUM
H6222-3	2	2	SHORT RISER	STL
H6222-4	1	2	TALL RISER	STL

KECK/HIRES
INTERFEROMETER MOUNT
PEDESTAL DETAIL
JUL 1978
H6222A

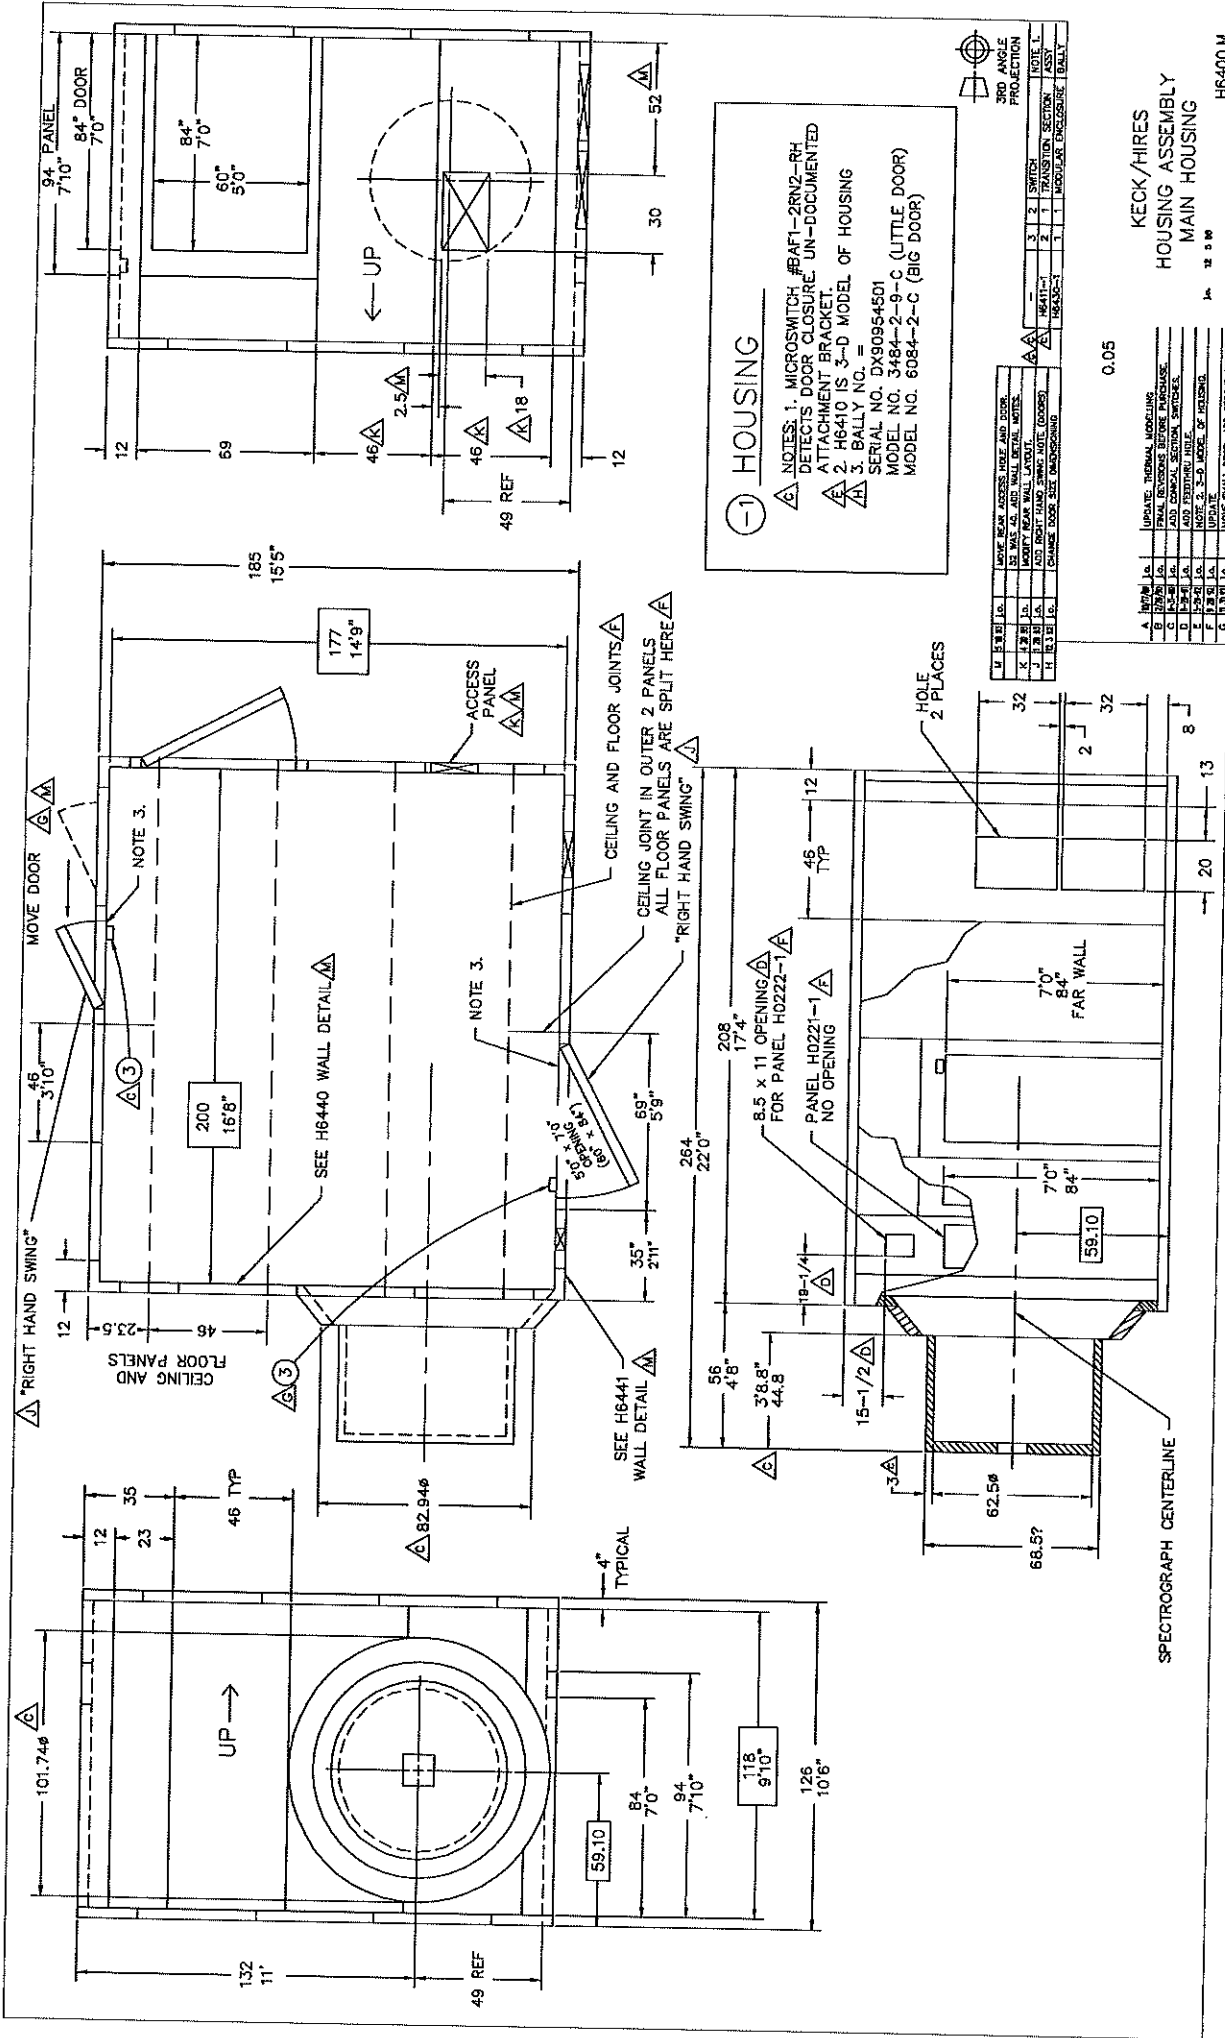

HOUSING

NOTES: 1. MICROSWITCH #BAF1-2RNZ-RH
 DETECTS DOOR CLOSURE UN-DOCUMENTED
 ATTACHMENT BRACKET.
 2. H6410 IS 3-D MODEL OF HOUSING
 3. BALLY NO. =
 SERIAL NO. DX90954501
 MODEL NO. 3484-2-9-C (LITTLE DOOR)
 MODEL NO. 6084-2-C (BIG DOOR)


1	3RD ANGLE PROJECTION
2	SWITCH POSITION SECTION
3	SWITCH POSITION SECTION
KECK/HIRES
 HOUSING ASSEMBLY
 MAIN HOUSING


0.05

A	1/18/81	LA	UPDATE: INTERNAL MODELING
B	1/22/81	LA	FINAL REVISIONS BEFORE PURCHASE
C	1/22/81	LA	ADD INTERNAL SECTION SWITCHES
D	1/22/81	LA	ADD INTERNAL SECTION SWITCHES
E	1/22/81	LA	ADD INTERNAL SECTION SWITCHES
F	1/22/81	LA	NOTE 2, 3, 4, 99, 100
G	1/22/81	LA	UPDATE: MOVE SMALL DOOR; ADD SECOND BIG DR

H6-400.LM

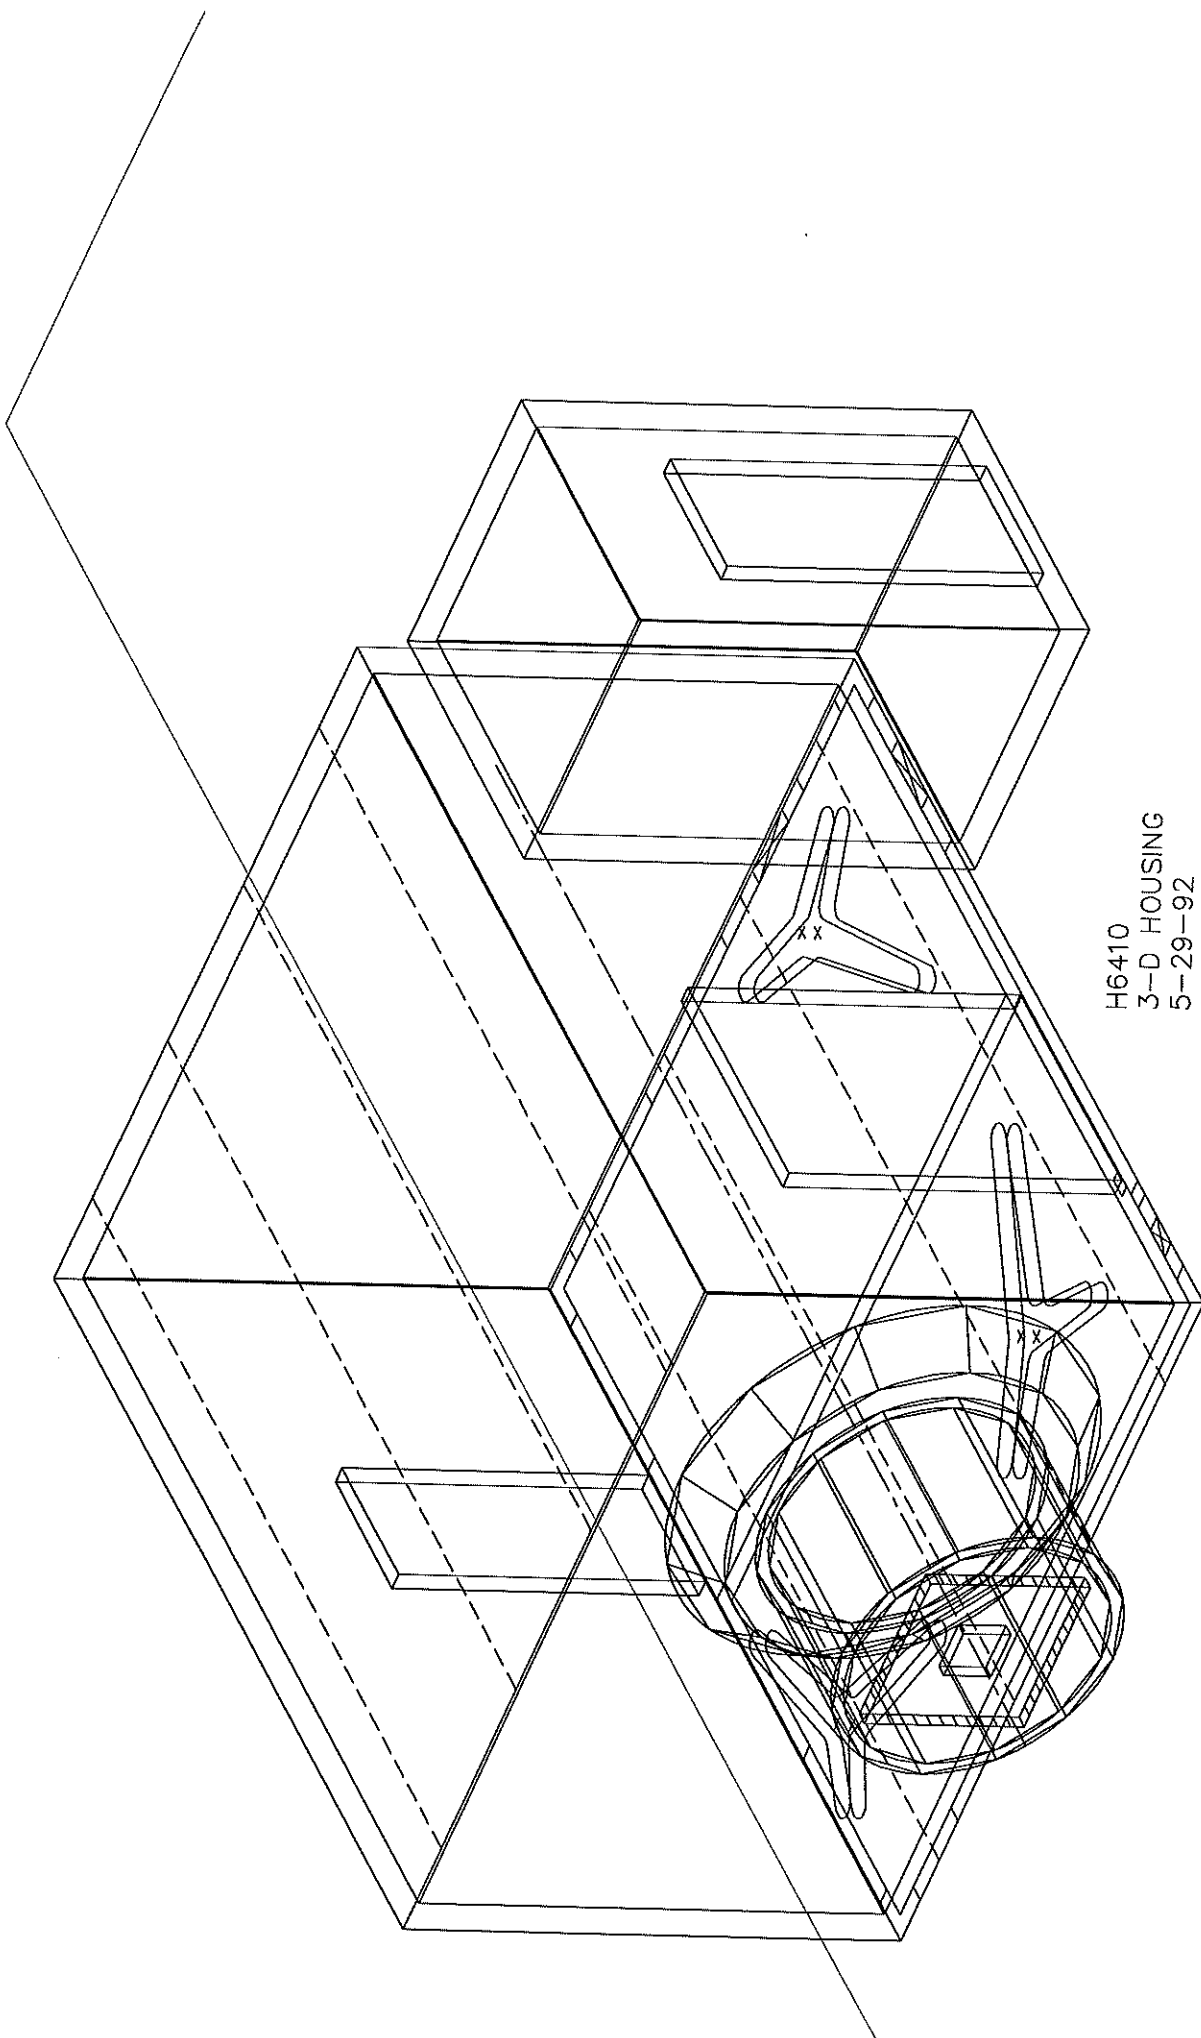

H6410
3-D HOUSING
5-29-92

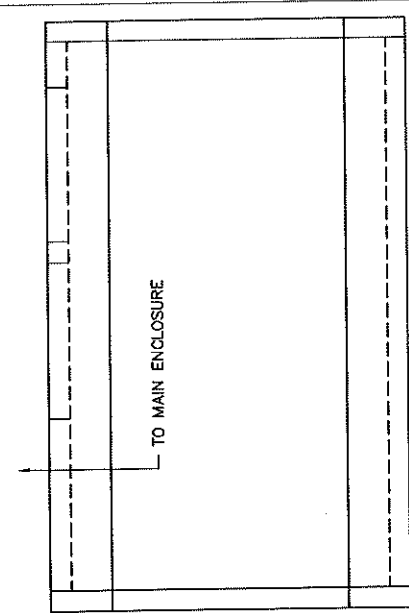


SIDE VIEW
VIEW FROM DOME MEZZANINE

VAULT


DOOR 233 LBS
WALL PANEL 151 LBS
CORNER 70 LBS
FLOOR PANEL 76 LBS
CEILING PANEL 54 LBS

1 REQ'D
BALLY BUILDING
WEIGHT: APPROX 1400 LBS


- NOTES:
1. ALL PANELS ARE GALVANIZED WITH WHITE POLYURETHANE PAINT.
 2. INSULATION IS POURED-IN-PLACE POLYURETHANE FOAM.
 3. WALLS AND CEILING PANELS ARE 0.026" THK GALV STEEL
 4. FLOOR PANELS ARE 0.073" THK GALV STEEL
 5. STANDARD DOOR WITHOUT HEATER STRIPS IS REQUIRED, HINGED AS SHOWN.
 6. NO ELECTRICITY IS NEEDED.
 7. NO COOLING IS NEEDED.
 8. REAR WALL CUTOUTS TO BE TRIMMED AND LEFT OPEN (NO DOORS OR PANELS REQUIRED)
 9. SERIAL #DX8952601, MODEL #3478-2-C PLAQUE ON INSIDE OF ENCLOSURE
 10. THE TWO CUTOUTS ARE FRAMED WITH WOOD PIECES. THEY ARE TREATED WITH A GREEN COLORED PRESERVATIVE.

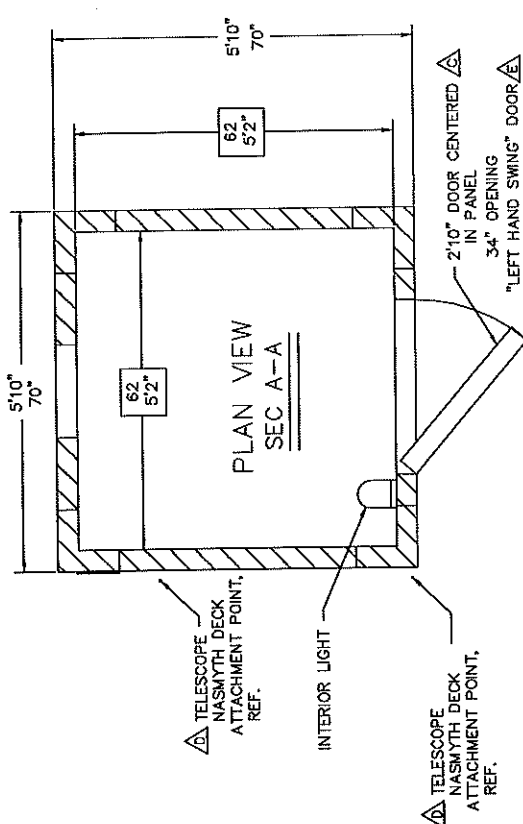


PLAN VIEW
SEC A-A

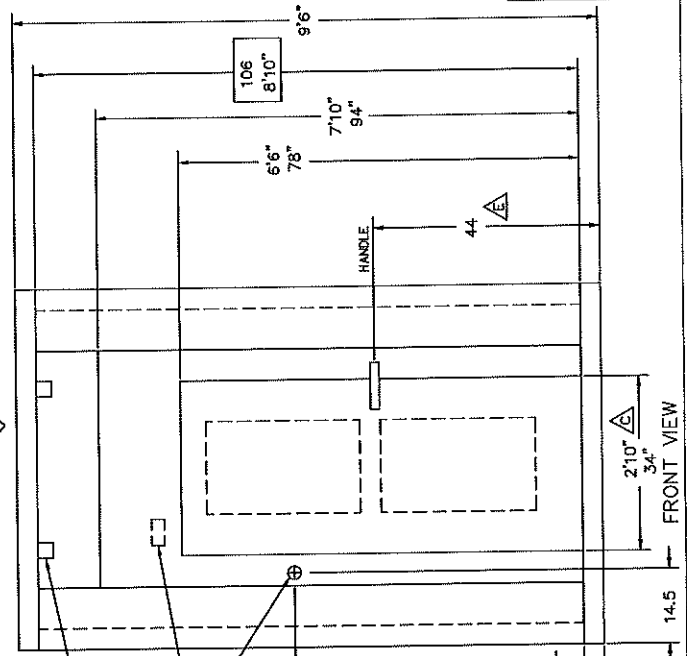

FRONT VIEW

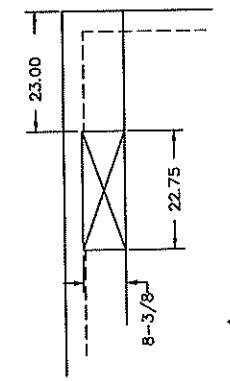

FEEDTHRU PANEL
-DETAIL-
PANEL EDGE IS FLUSH WITH HOUSING JOINT. SEE EL-2320-2W, EL-2321-2W AND EL-2322-2W FOR MORE.

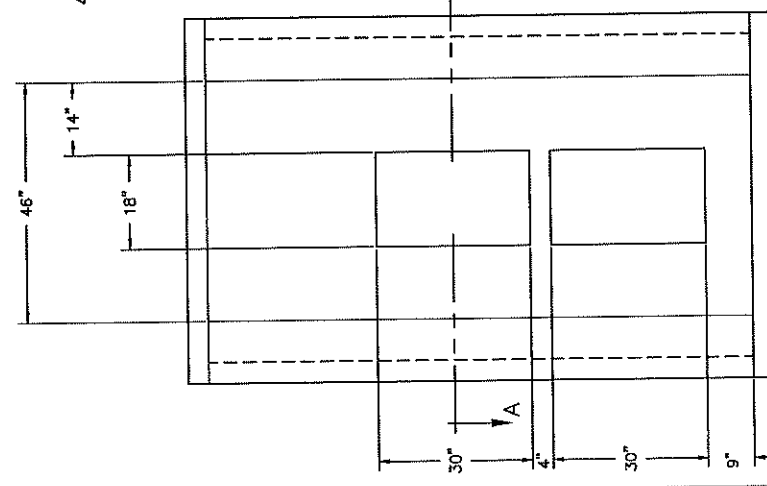

REAR VIEW

SHOWS TWO 18" x 30" CUTOUTS
NOTE: WE MADE THE CUTOUTS IN THE LARGE HOUSING 20" x 32" FOR MORE CLEARANCE. NOTE 10.

KECK/HIRES
ELECTRONICS VAULT
ASSEMBLY

1/10


A	B	C	D	E
ADD WEIGHTS	ADD WEIGHTS	ADD WEIGHTS	ADD WEIGHTS	ADD WEIGHTS
ADD WEIGHTS	ADD WEIGHTS	ADD WEIGHTS	ADD WEIGHTS	ADD WEIGHTS
14 9 7 88

H6425.E

Appendix H List of Drawings — Shipping & Initial Alignment

1. H9000 Ruger Crane Assembly and Extended Boom
2. H9005 Ruger Crane, Position 1
3. H9006 Ruger Crane, Position 2
4. H3075 Echelle Mosaic Cart
5. H4075 Cross Disperser Cart
6. H6605 Main Frame Casters
7. H6936 Camera Mirror Moving Details

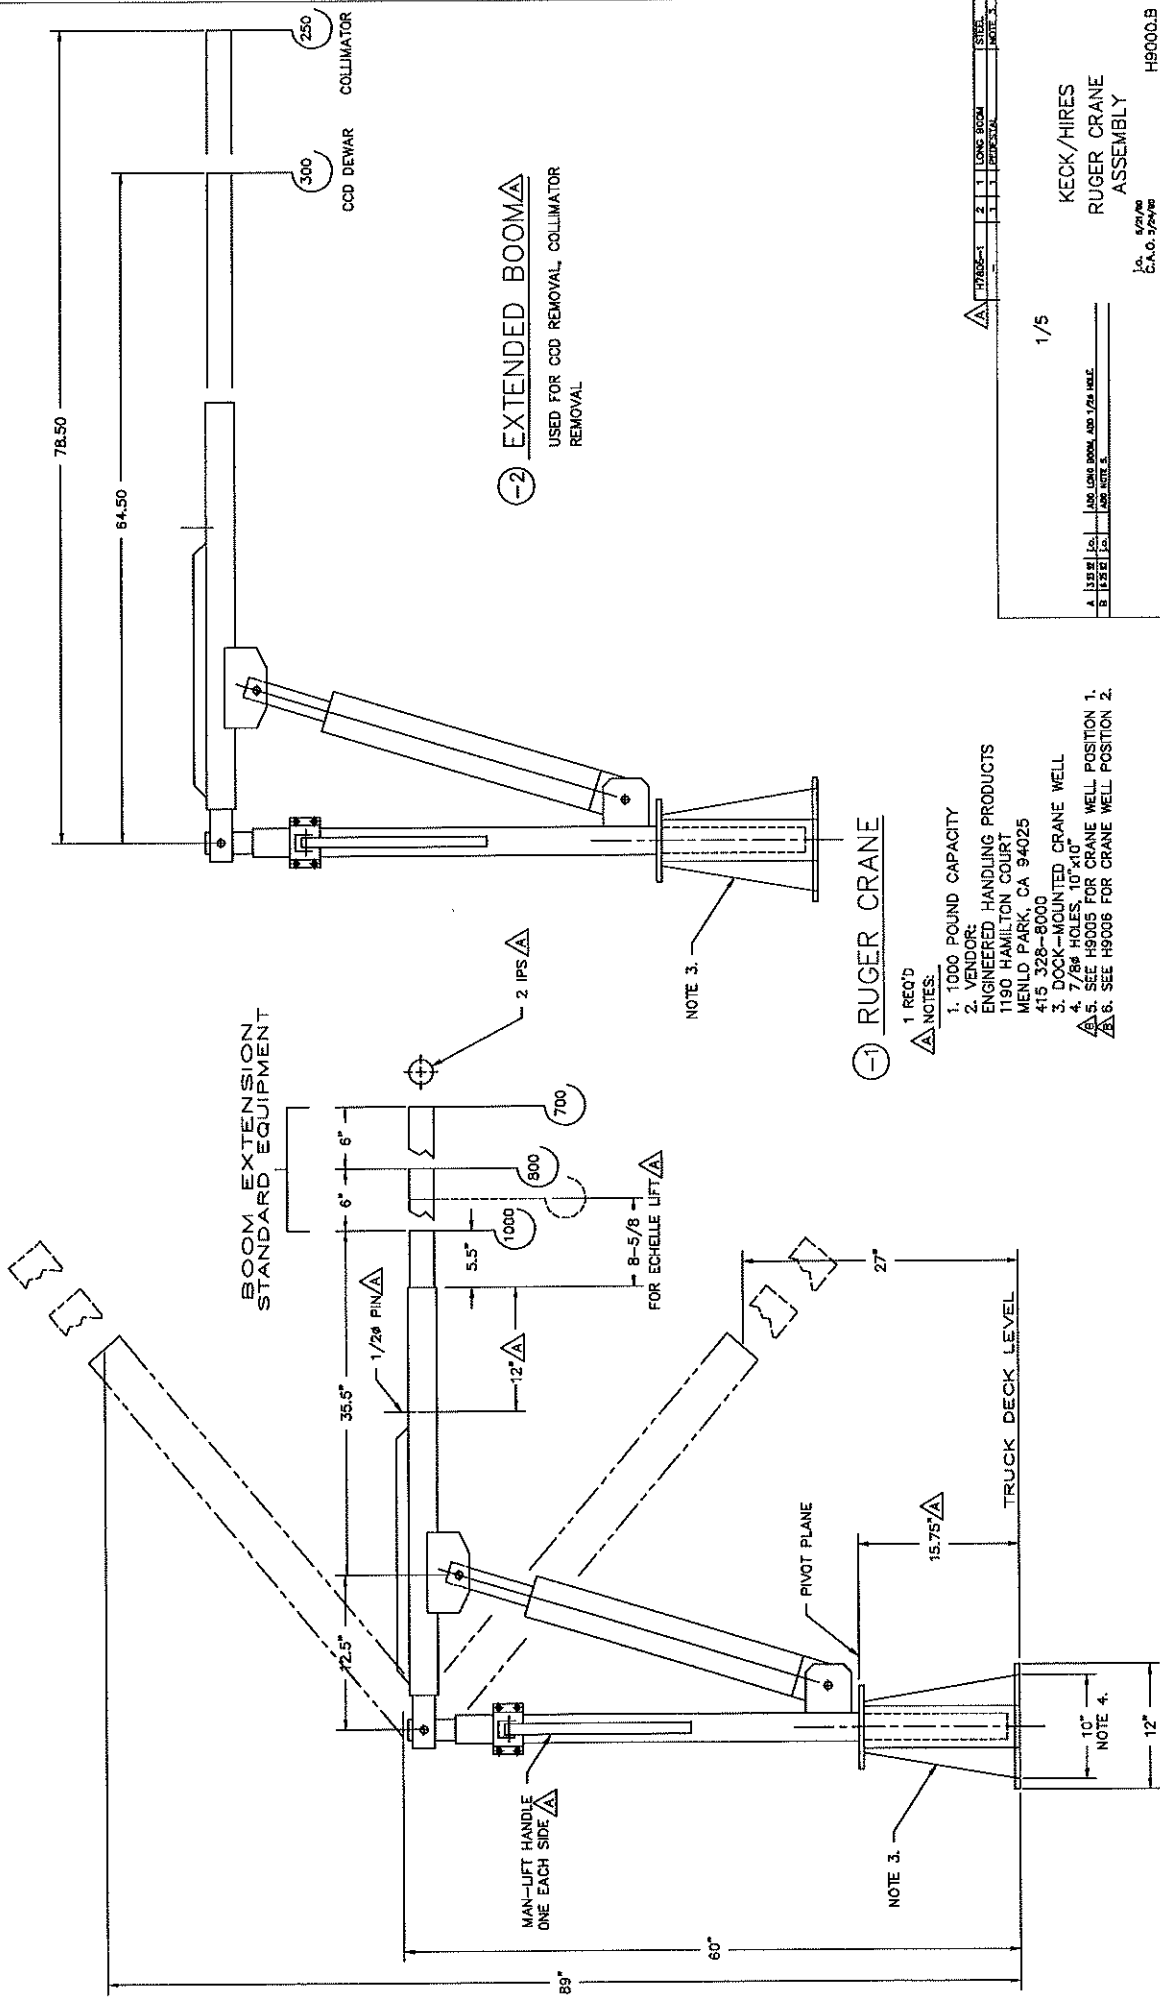

② EXTENDED BOOM
 USED FOR CCD REMOVAL, COLLIMATOR
 REMOVAL

① RUGER CRANE

1 REQ'D
 NOTES:



1. 1000 POUND CAPACITY
2. VENDOR:
 ENGINEERED HANDLING PRODUCTS
 1190 HAMILTON COURT
 MENLO PARK, CA 94025
 415 328-8000
3. DOCK-MOUNTED CRANE WELL
4. 7/8" HOLES, 10"x10"
5. SEE H9005 FOR CRANE WELL POSITION 1.
6. SEE H9006 FOR CRANE WELL POSITION 2.

1/5

KECK/HIRES
 RUGER CRANE
 ASSEMBLY

5/2/96
 C.A.O. 3/2/96
 H9000.B

A 13.5' HOLE
 B 13.5' HOLE
 AND LONG ROOM AND 1/2" HOLE
 AND NOTE 5.

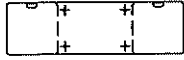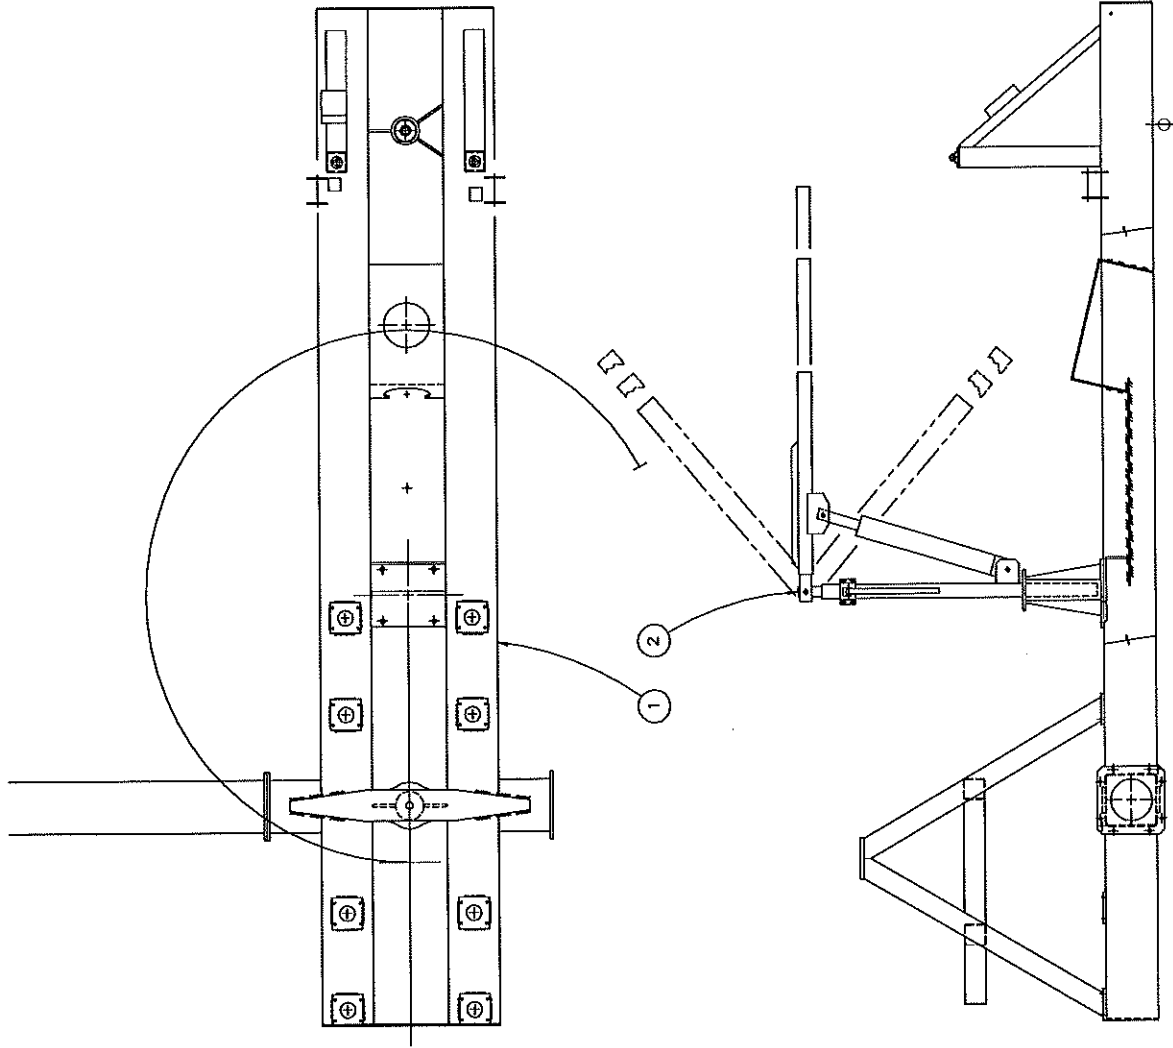

① CRANE MOUNTED IN SOCKET 1

NOTES:
1. CROSS-DISPERSER ACCESS


H9000-1	2	1	REUSER CRANE
H9070-1	1	1	OPTICAL BENCH STRUJ

1/10

KECK/HIRES
CRANE
POSITION 1

LA KAWZ
S/VAE S/VAE

H9005

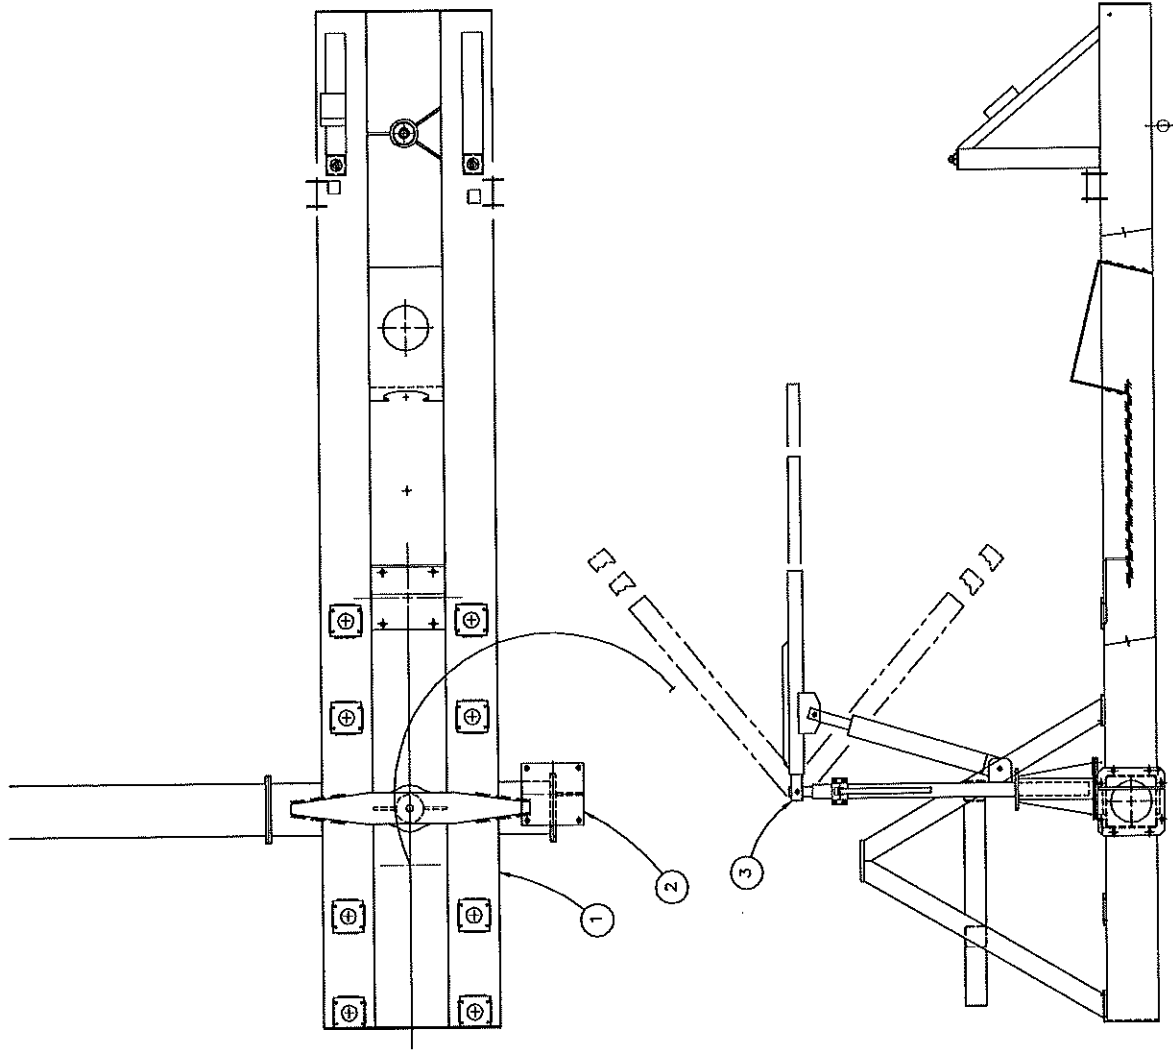

① CRANE MOUNTED IN SOCKET 2

NOTES:

1. ECHELLE, MOSAIC ACCESS
2. CRANE STORAGE POSITION




HR007-1	3	1	BLUER CRANE BASE
HR000-1	2	1	RUBER CRANE
HR100-1	1	1	OPTICAL BENCH STRUCTURE

1/10

KECK/HIRES
CRANE
POSITION 2
LA 04 01/02
03/02
H9006

① CART ASSEMBLY

1 RECD
 NOTES:
 1. GLOBAL INDUSTRIAL EQUIP. #748042
 PNEUMATIC CASTER-SWIVEL
 8860 HEMLOCK DRIVE
 HEMPSTEAD, NY 11550-6620
 800 645-1232
 △.2. 1.5 x 1.5 STEEL TUBING.

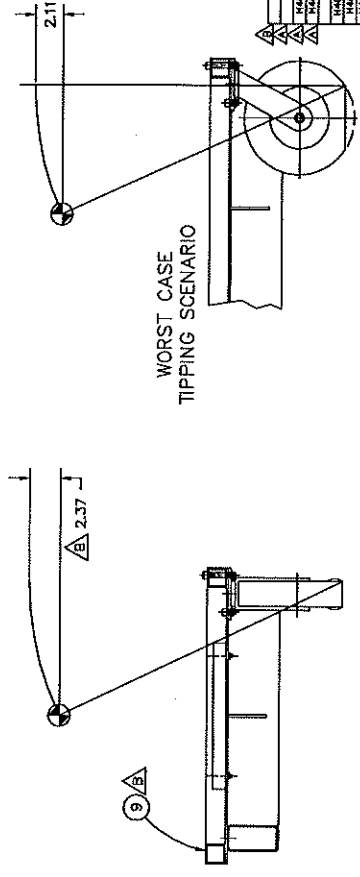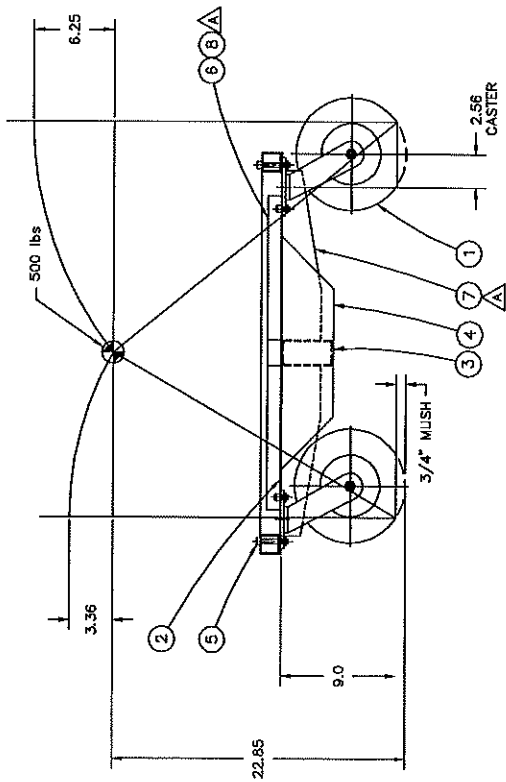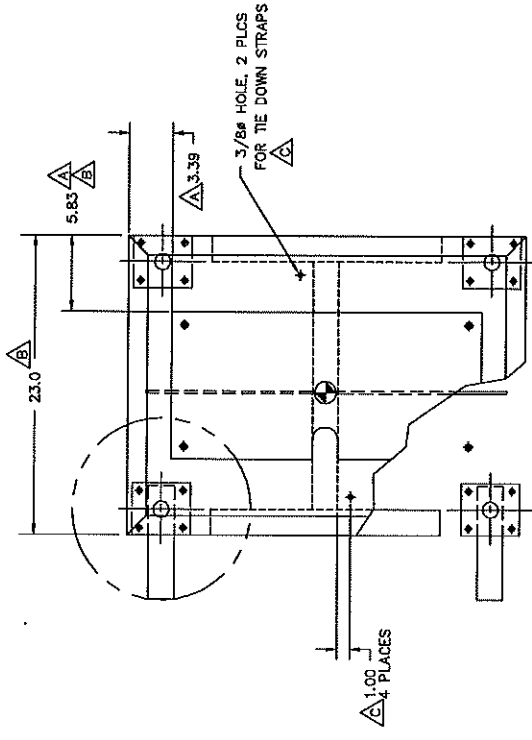


NOTE 1	NOTE 2
1	1
2	2
3	3
100	100

1/4

KECK/HIRES
 CROSS DISPENSER CART
 ASSEMBLY

M4075.C

REV	DATE	DESCRIPTION
1		ISSUED FOR ASSEMBLY DRAWING
2		REVISED TO ADD 2 PLCS FOR TIE DOWN STRAPS
3		REVISED TO ADD 2 PLCS FOR TIE DOWN STRAPS

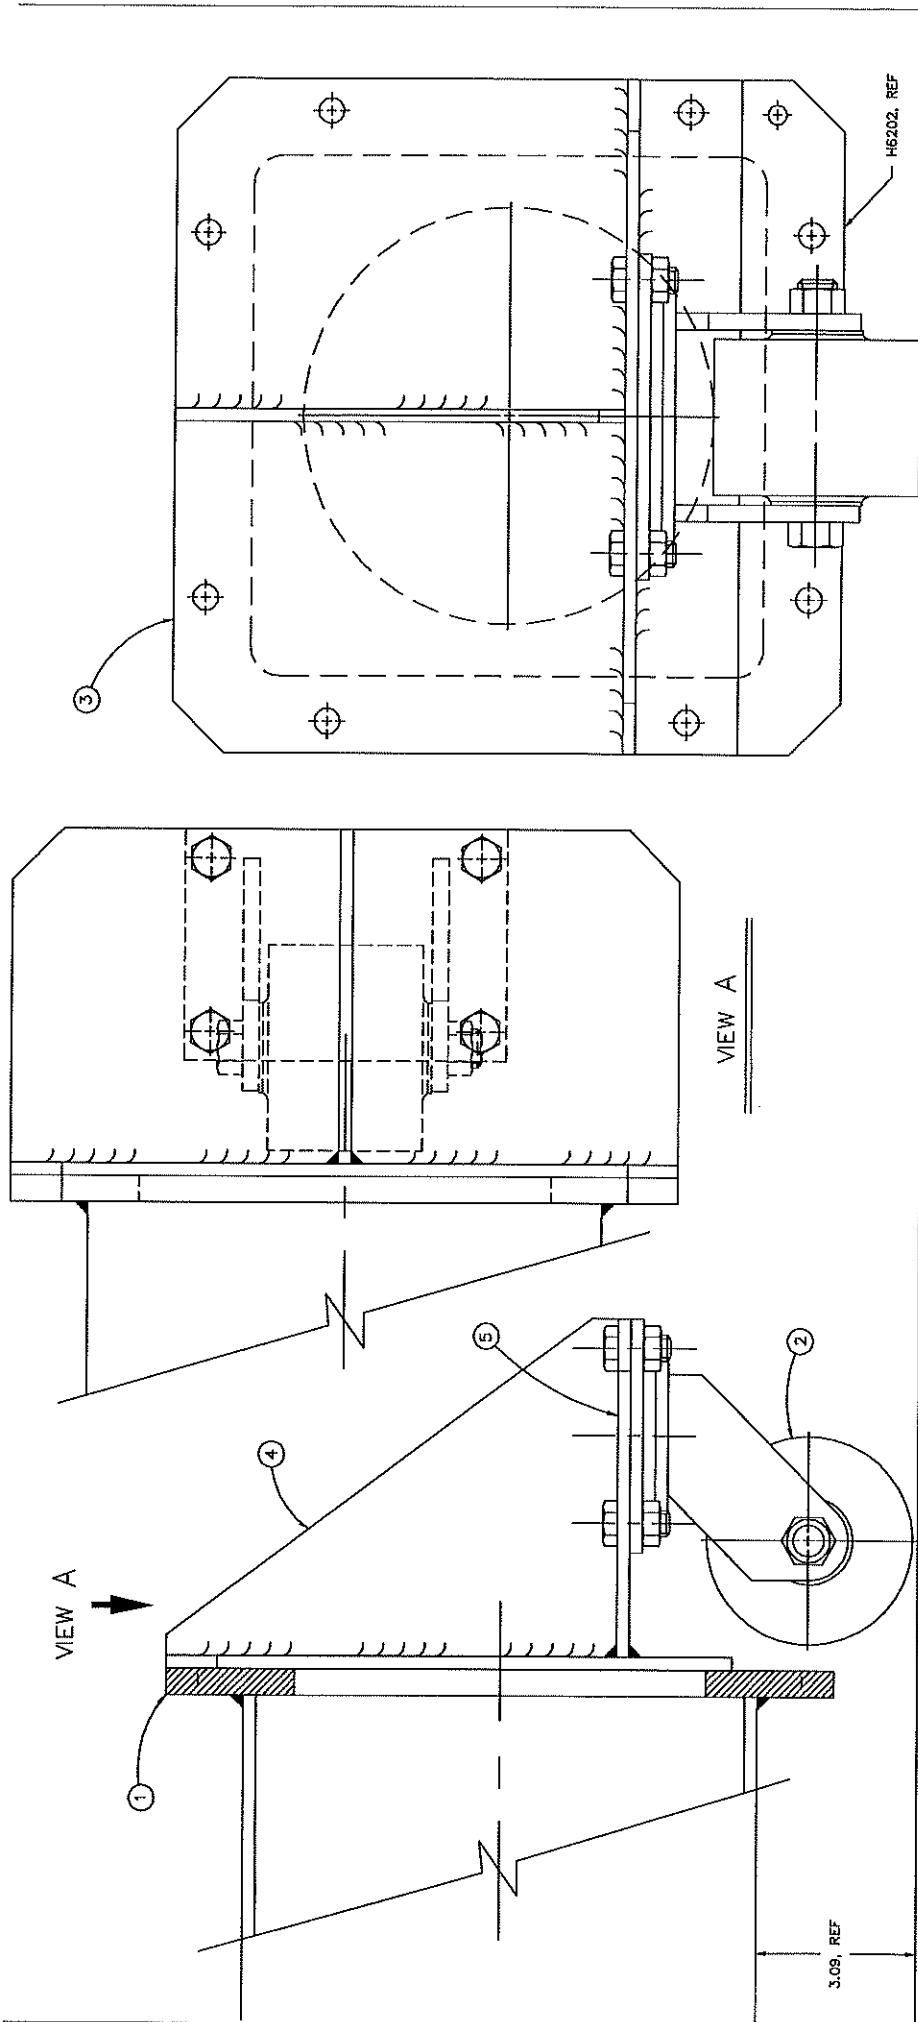

H6600-3	CASTER MOUNT	STEEL
H6600-2	SUPPORT	STEEL
H6600-1	WHEEL	STEEL
H6202	SWIVEL PLATE	STEEL
	WHEEL	STEEL
	WHEEL	STEEL
	WHEEL	STEEL

① CASTER ASSEMBLY

3 REQ'D
 ALBION #81-CA-04501
 49X3 SEMI-STEEL WHEELS
 CAPACITY: 1650 LBS
 SWIVEL STYLE
 POWDER COAT WHITE


FULL

KECK/HIRES
 CASTERS
 ASSEMBLY


H66005.A

A. J. & S. Co. Inc. 1000 PARTS

1A 12-88

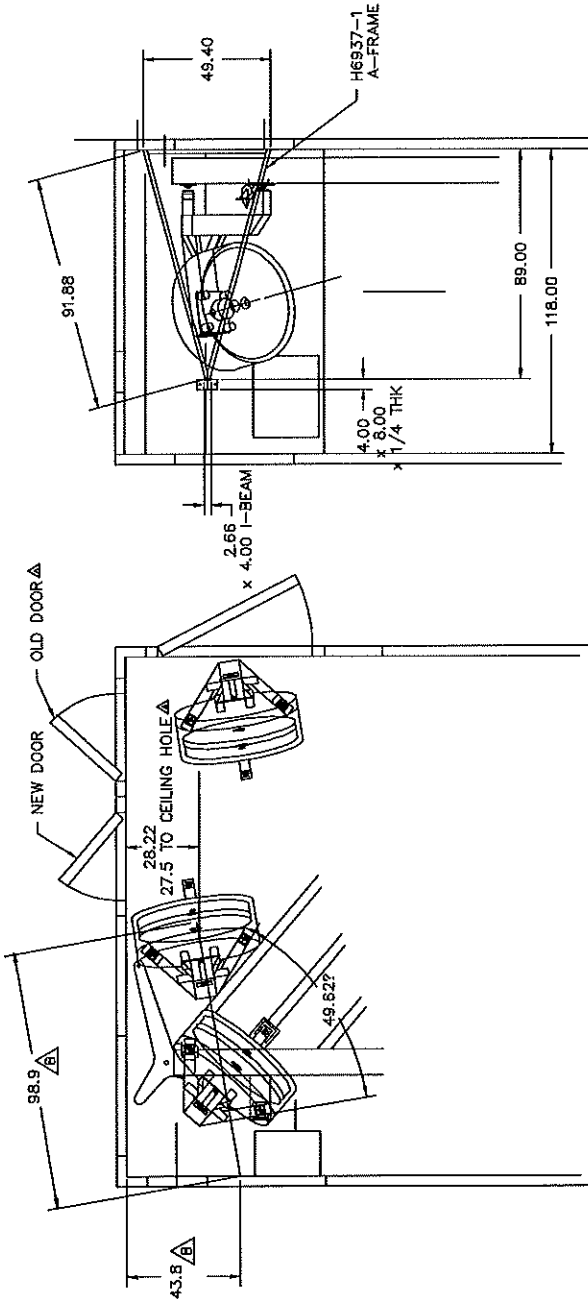

H6936.B
 PLAN VIEW
 11-17-92
 SEE H1465 FOR ROOF SUPPORT BEAM
 SEE H6440 FOR A-FRAME LOCATION

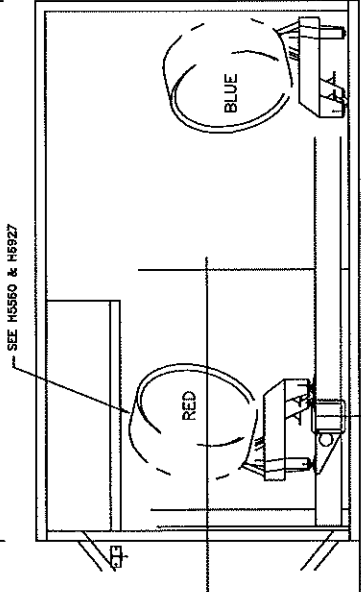

.05

KECK/HIRES
 CAMERA MIRROR LIFT
 LAYOUT

H6936.B



B 15151 10.1 1000 L-8504

Appendix I List of Drawings — Re-Aluminizing and Re-Aligning

1. H2640 Collimator Focus, Dial Indicator Detail
2. H5420 Hextek (Camera Mirror) Aluminizing Fixture Assembly
3. H6500 Alignment Scenario
4. H6510 Alignment Telescope Fixture, Rear
5. H6530 Alignment Telescope Fixture, Front
6. H6560 Alignment Target, Echelle Pivot

ROTATE APPROX. 30° AS SHOWN

① ③

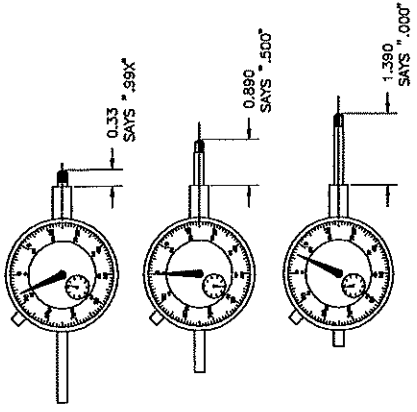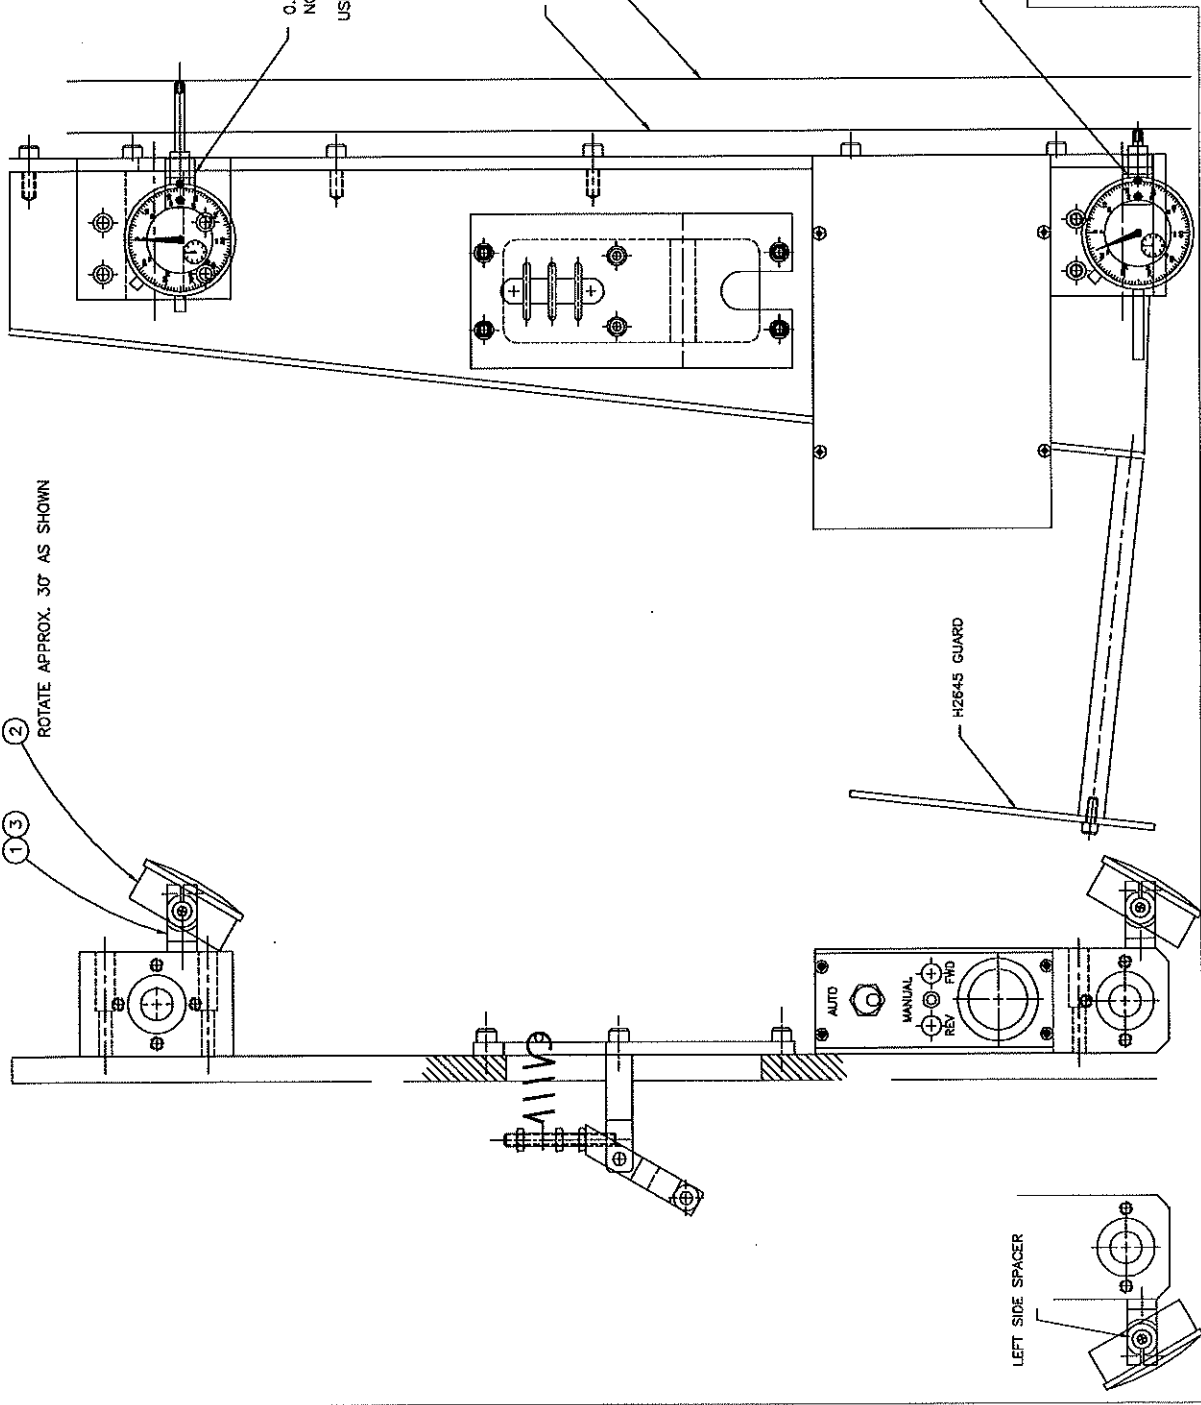

① RIGHT SIDE SUB-ASSY

1 REV'D


NOTES:

1. P/N 303560 A-2, ST. STEEL
2. DIAL INDICATOR #2416, 1" TRAVEL
FLAT BACK, 2-1/4", 0-100 DIAL (ACTUAL TRAVEL IS 1.060)
3. THIS VIEW CONNECTS TO ASSEMBLY ON H2620.E
4. LEFT SIDE HAS INDICATOR ON LOWER SPRING MOUNT ONLY.


5	6	7	8	9
1	2	3	4	5
6	7	8	9	10
11	12	13	14	15
16	17	18	19	20
21	22	23	24	25
26	27	28	29	30
31	32	33	34	35
36	37	38	39	40
41	42	43	44	45
46	47	48	49	50
51	52	53	54	55
56	57	58	59	60
61	62	63	64	65
66	67	68	69	70
71	72	73	74	75
76	77	78	79	80
81	82	83	84	85
86	87	88	89	90
91	92	93	94	95
96	97	98	99	100

FULL

KECK/HIRES
COLLIMATOR FOCUS
DIAL INDICATORS DETAIL
PA 1 17 88
H2640

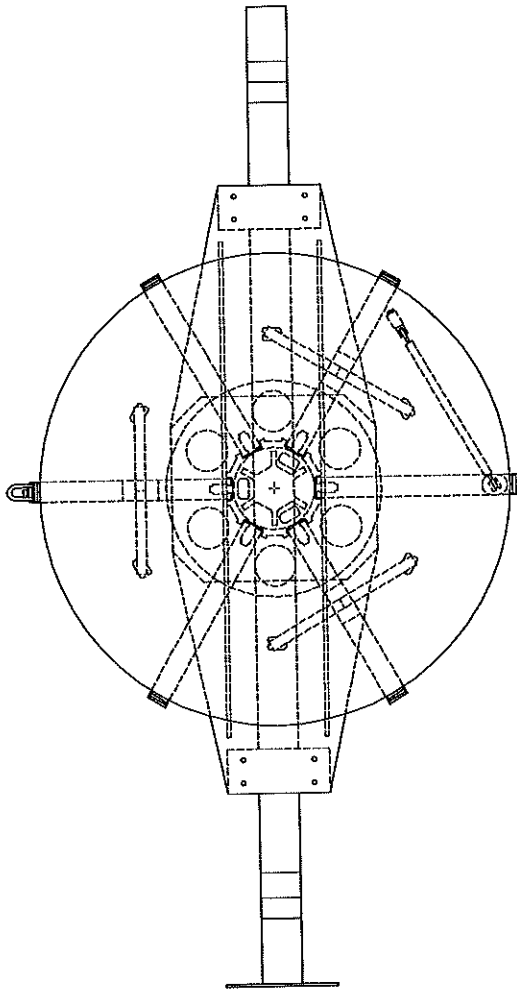

CAMERA MIRROR ASSY
H5560

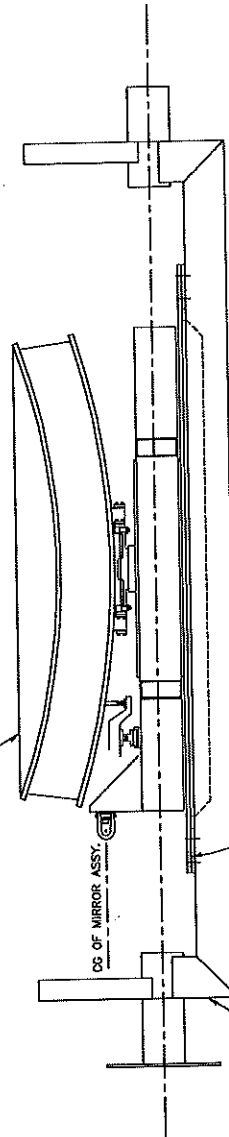

CG OF MIRROR ASSY

REF KECK P/N 643-C0023
KECK SECONDARY MIRROR CELL
HANDLING FIXTURE

ALUMINIZING FIXTURE DETAIL


H5521 & H5522

△ ENGRAVE: HIREES, CAMERA MIRROR, ALUMINIZING FIXTURE

△ DO NOT ANODIZE

△ AVOID ALL SCREW HOLES

△ DO NOT USE GREASE TO ASSEMBLE SCREWS






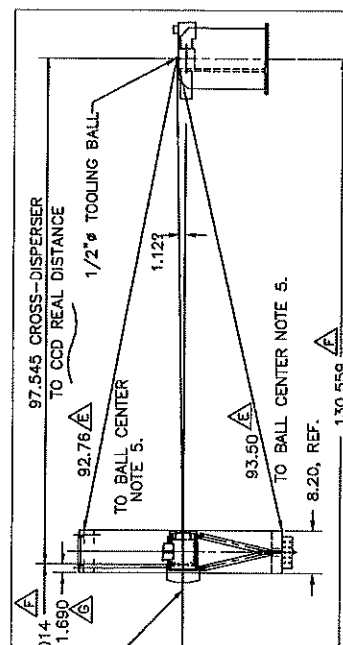


ALIGNMENT NOTES FOR DEWAR FRAME

NOTES:

- ① 40.79" IS PROJECTED ONTO THE PLAN VIEW, MEASURED ANGLE IN DISPERSION PLANE IS 40.00" TOLERANCE IS ±0.03" (±0.05" AT THE DEWAR)
HEIDENHAIN ENCODER HAS 720,000 PULSES PER REV. 40" IS 80,000 PULSES. TOLERANCE IS ± 60 PULSES.
- ② THIS LINE IS THE AVERAGE NORMAL POSITION FOR THE CORE VERSION OF HIRES. THE ANGLE AND HENCE ENCODER VALUE IS 25.343" OR 50,686 PULSES. THE INDEX SHOULD BE LOCATED NEAR HERE (TO ±200 PULSES)
- ③ DIM "A" IS 5.157 LOADED TO 1000 LBS & NO GRATING.
- ④ SEE H6520 FOR VIEW B=B.
- ⑤ MOVE HOUSING AND DEWAR BODY 0.317" (LEFT-WARD) TO ADAPT DESIGN #4052 (8/3/92).

A	1.690	1.690	1.690	1.690
B	1.690	1.690	1.690	1.690
C	1.690	1.690	1.690	1.690
D	1.690	1.690	1.690	1.690
E	1.690	1.690	1.690	1.690
F	1.690	1.690	1.690	1.690
G	1.690	1.690	1.690	1.690
H	1.690	1.690	1.690	1.690

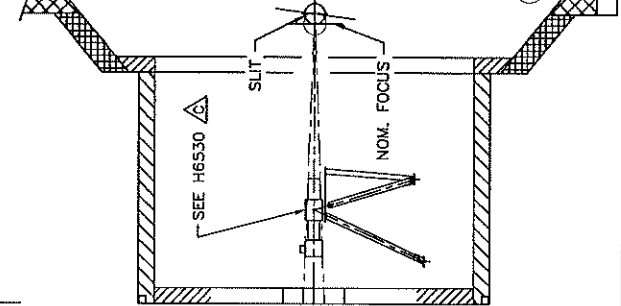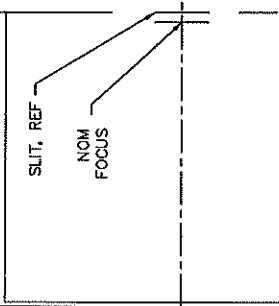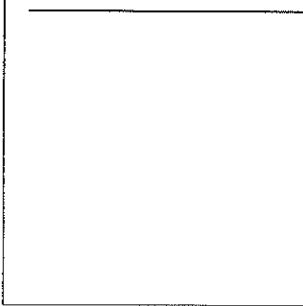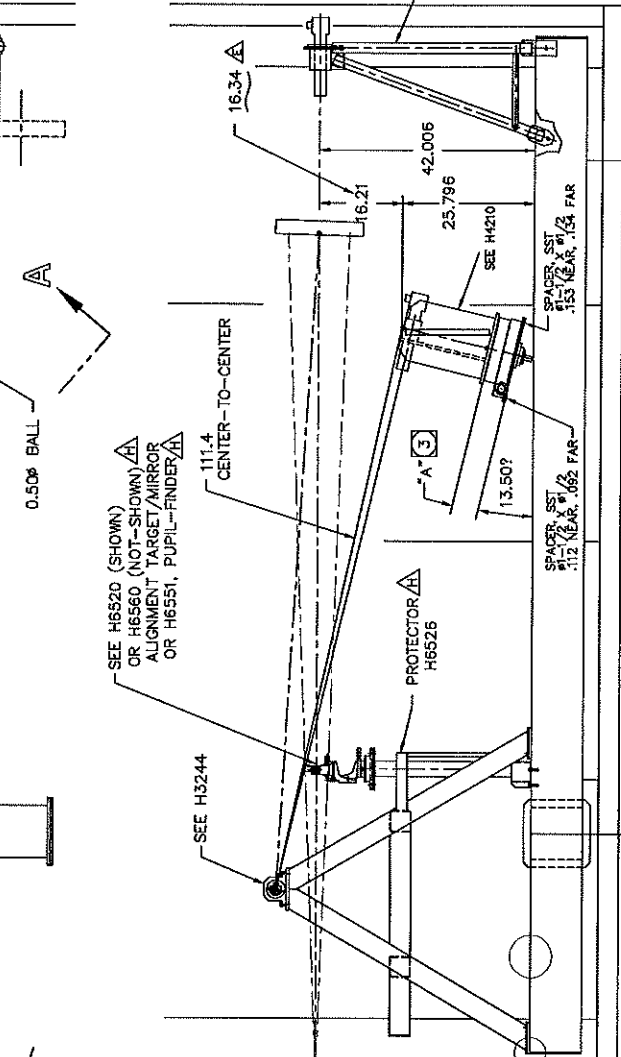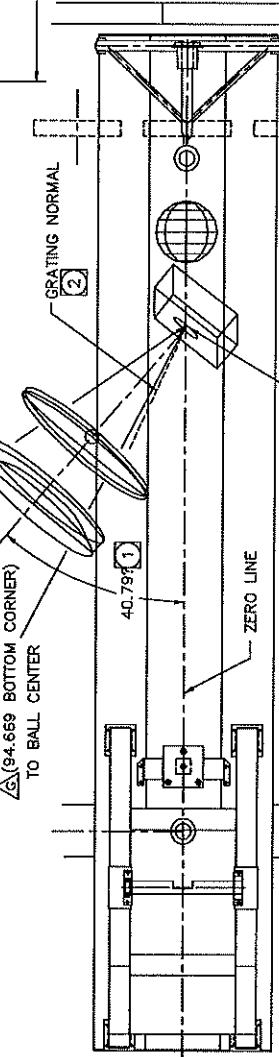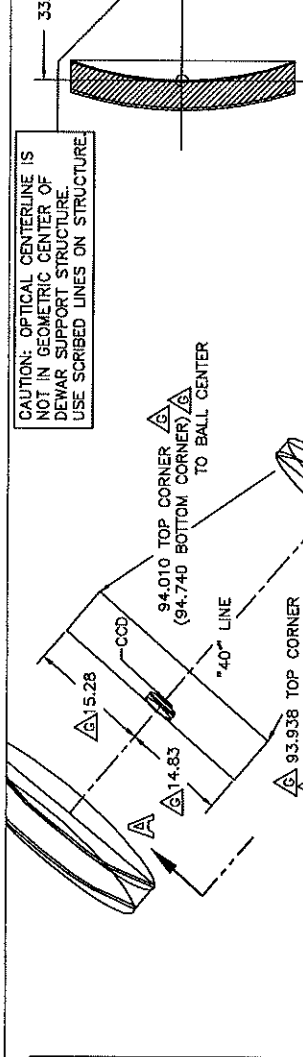


1/10

KECK/HIRES
ALIGNMENT
SCENARIO

JA 219W

H6500.H

F	1.690	1.690	1.690	1.690
G	1.690	1.690	1.690	1.690
H	1.690	1.690	1.690	1.690

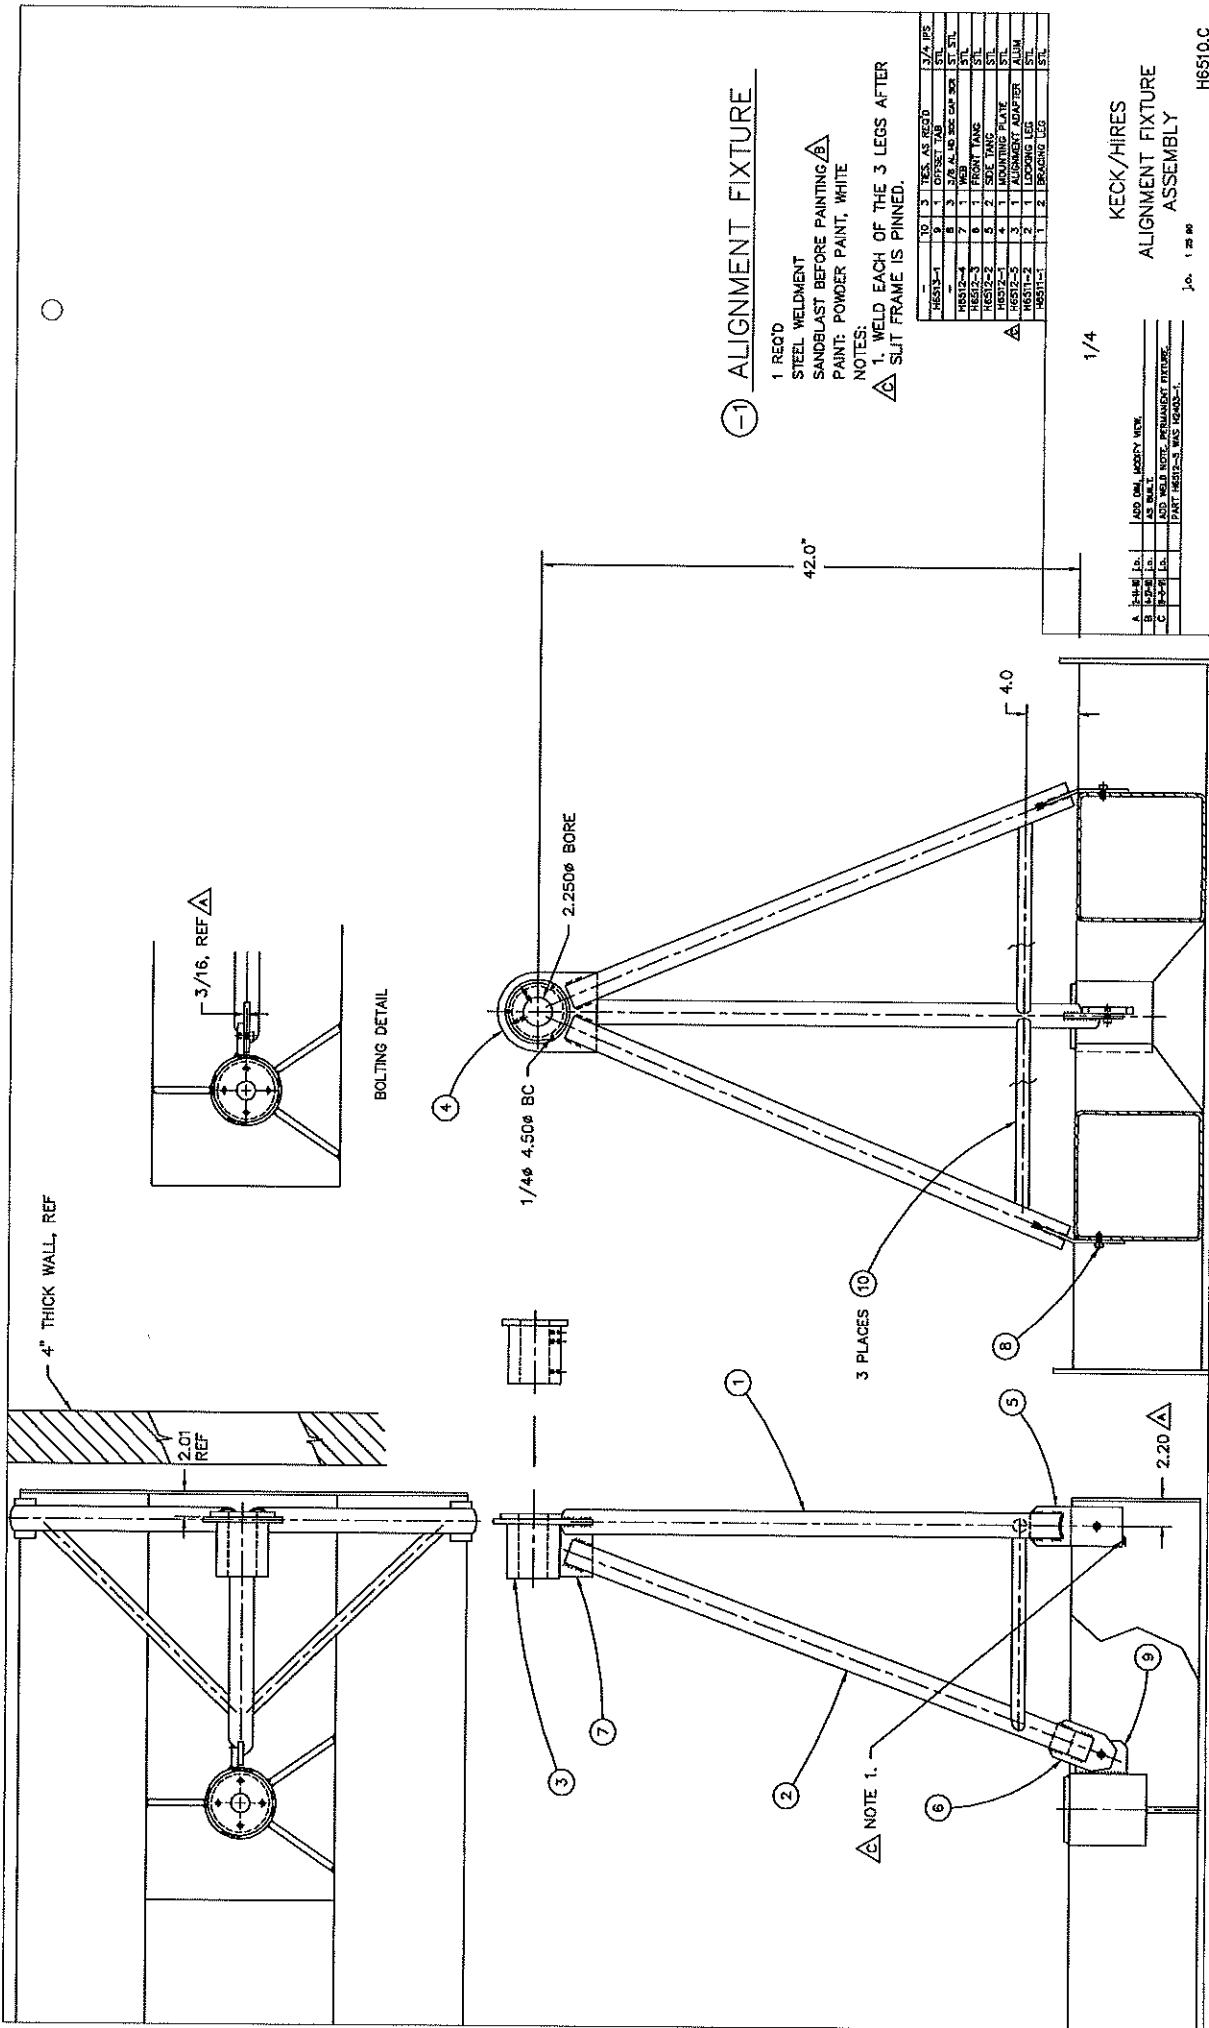

① ALIGNMENT FIXTURE

1 REC'D
 STEEL WELDMENT
 SANDBLAST BEFORE PAINTING
 PAINT: POWDER PAINT, WHITE

NOTES:
 1. WELD EACH OF THE 3 LEGS AFTER SLIT FRAME IS PINNED.

10	3	TRUSS AS REC'D	1 3/4	PS
11	1	OFFSET TAB		STL
12	1	2" X 4" X 1/4" ALUM. SEC. CAP. W/ 2" STL		ALUM.
13	1	FRONT TANK		STL
14	1	FRONT TANK		STL
15	2	SIDE TANK		STL
16	1	ADJUSTING PLATE		STL
17	1	ALIGNMENT ADAPTER		ALUM.
18	1	BROUHING LEG		STL


1/4

KECK/HIRES
 ALIGNMENT FIXTURE
 ASSEMBLY

H6510.C

A	1-1/4	1/4	ADD DIM. MODIFY VIEW.
B	1-1/4	1/4	AS BUILT.
C	1-1/4	1/4	ADD WELD NOTE. PERMANENT RELEASE.
			PART. REVISIONS WAS 1000-1.

JO. 1 25 80

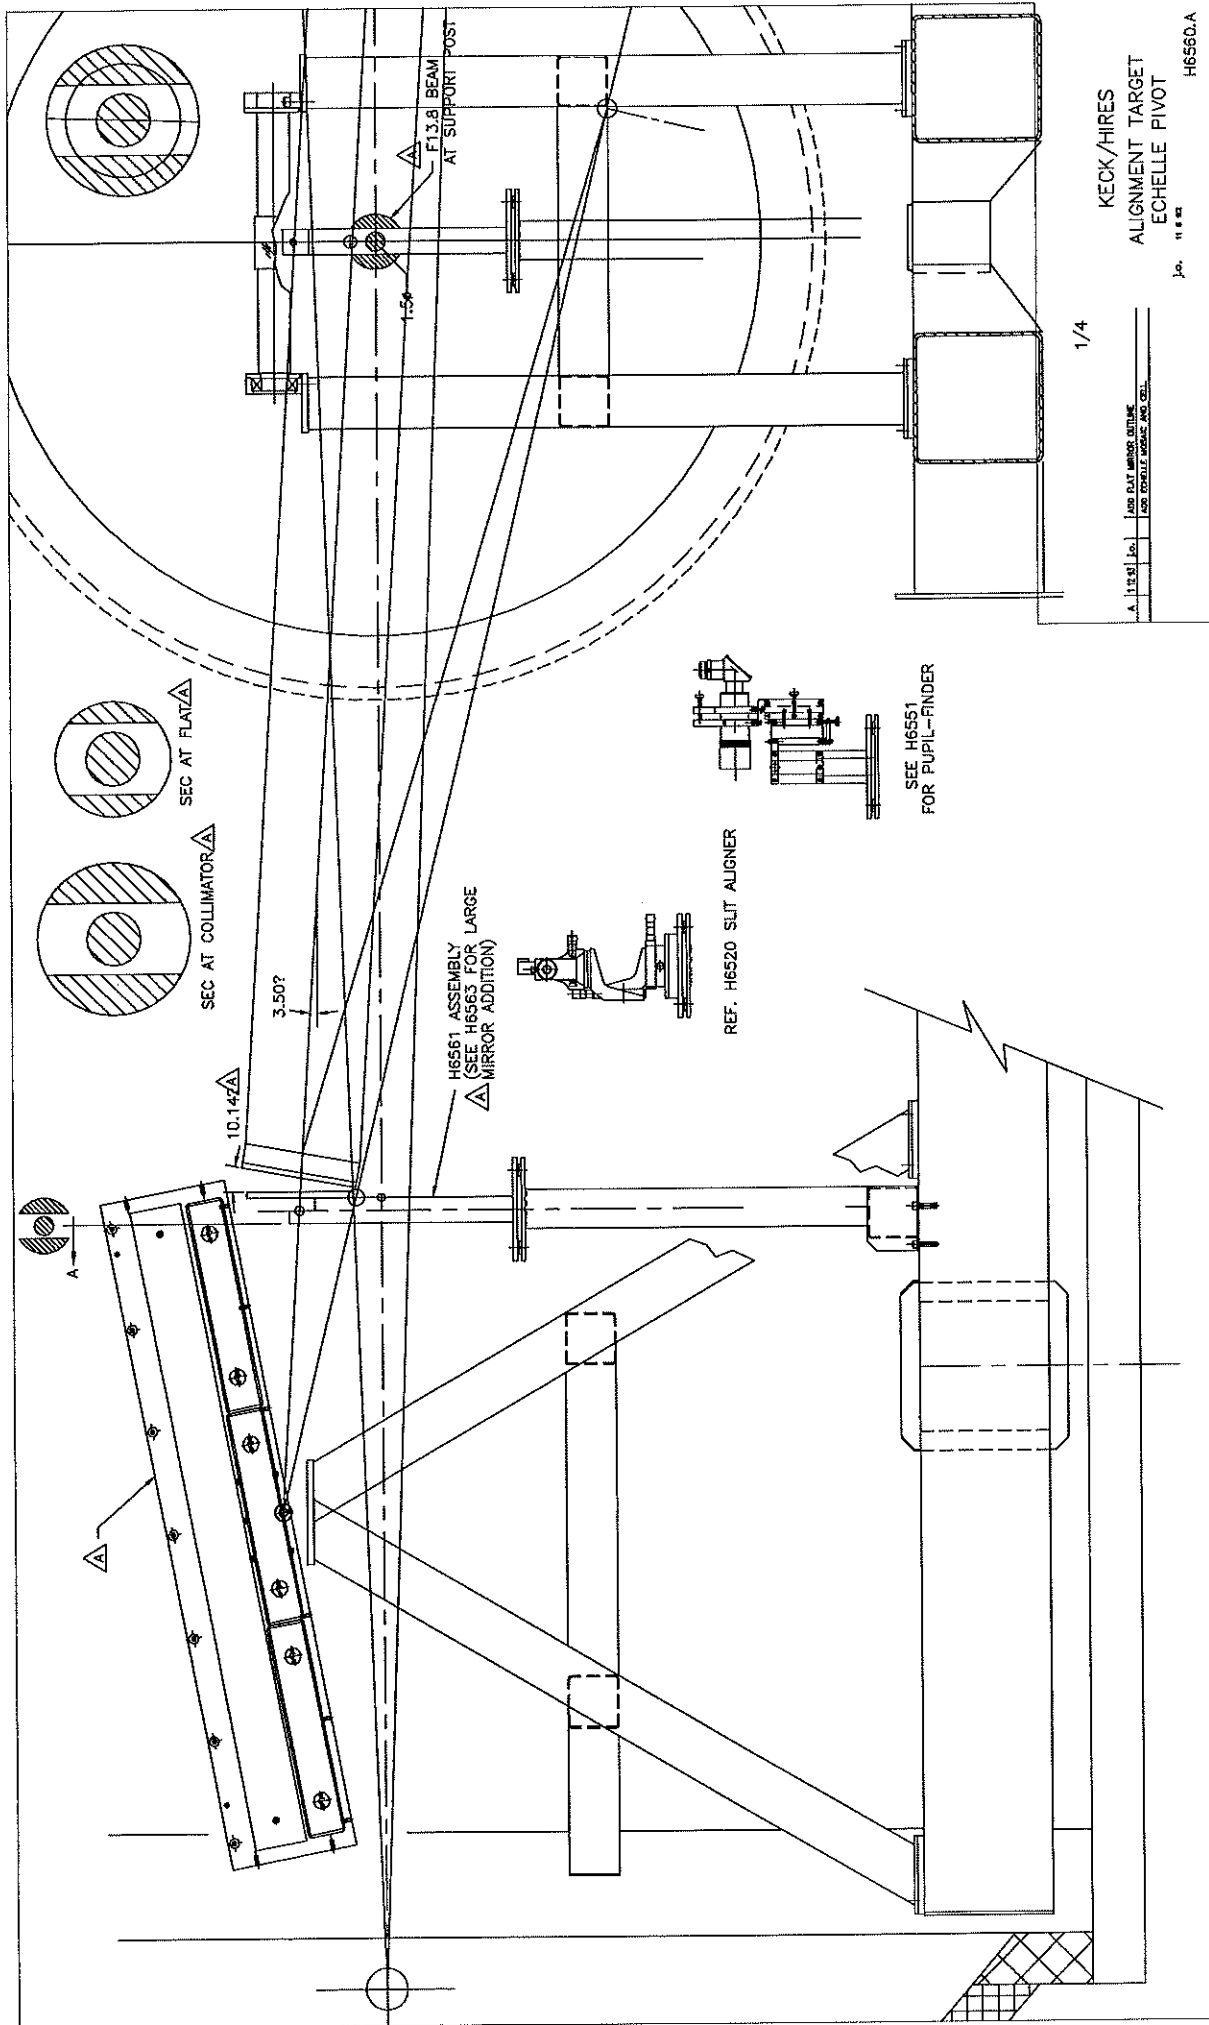

KECK/HIRES
 ALIGNMENT TARGET
 ECHELLE PIVOT
 J. O. H. S. S. S.
 H6560.A

1/4

A. 11.13.13 J. O. H. S. S. S.
 AND PLAT MIRROR OUTLINE
 AND ECHELLE MIRROR AND CELL

Appendix J List of Drawings — Other Comments

1.

Appendix K List of Drawings — Slit Area

1. P1001 Slit Area Overview and Layout
2. H6711 Slit Area Structure Sub-Assembly

GUIDER TV AND
FILTER WHEELS (2)

COMPARISON SOURCES
AND FILTER WHEEL

COMP. SOURCE
STEERING OPTICS


SLIT



SAFR-S

DECKER STAGE
4 POSITIONS

SPECTROGRAPH
FILTERWHEELS (2)

/H/P/P1001.DWG
1/24/92 BCB

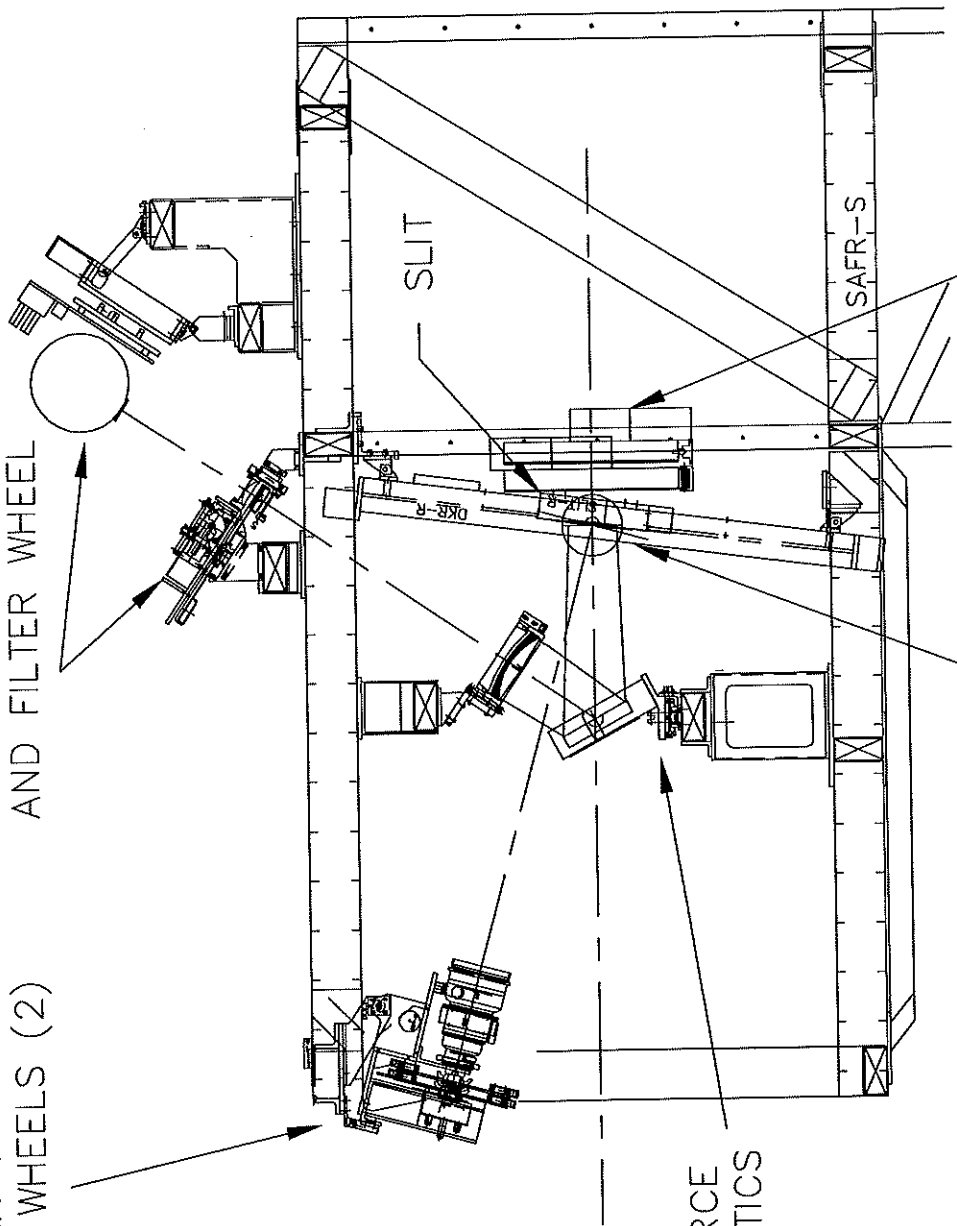

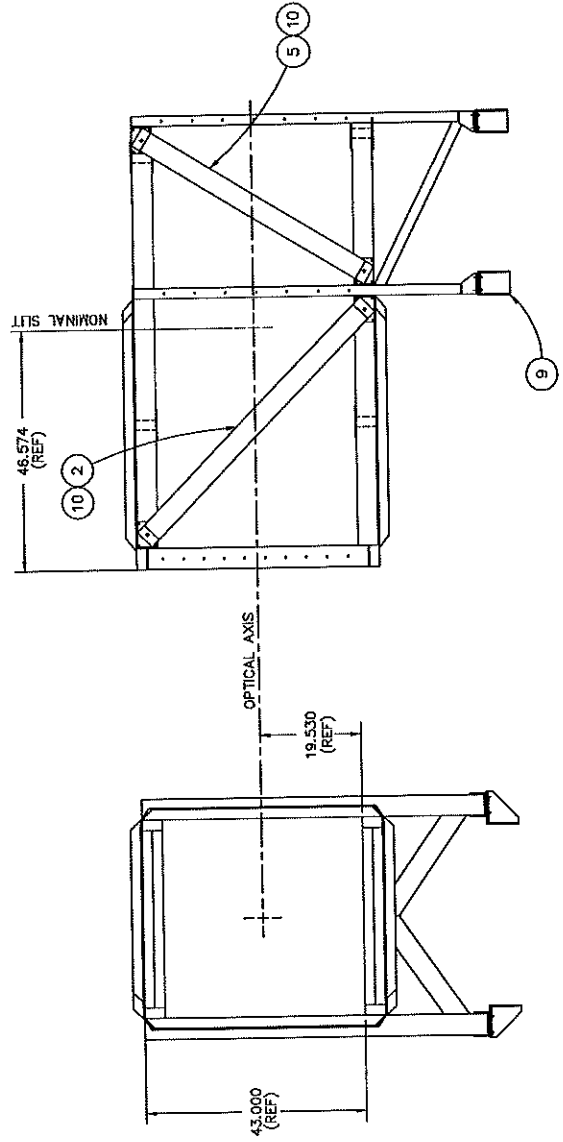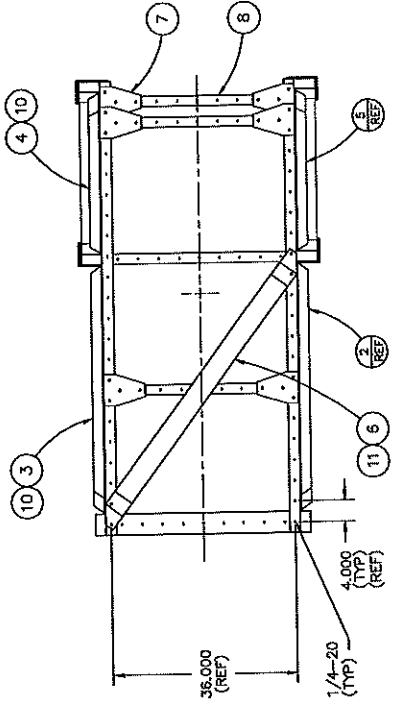

NOTES:
 1. POWDER PAINT, FULLER O'BRIEN FLAT
 BLACK EPB 534-50.

ITEM NO.	DESCRIPTION	QTY	UNIT	MATERIAL
H6710-B	LEAD PLATE	11	4	STEEL
H6710-C	SUPPORT WELD	9	4	STEEL
H6710-D	ADJ. MEMBER	8	6	STEEL
H6710-E	ROUTING PLATE	7	15	STEEL
H6710-F	TRANSVERSE WELD	6	2	STEEL
H6710-G	WELD	4	1	STEEL
H6710-H	UPPER LAG DIAG WELD	3	1	STEEL
H6710-I	NOSE DIAGONAL WELD	2	1	STEEL
H6710-J	WELD ASSEMBLY	1	1	STEEL


KECK/HIRES
 SLIT AREA STRUCTURE
 ASSEMBLY
 DATE: 8/1/90
 Dwg: 8/2/90
 H6711.D

REVISION	DATE	DESCRIPTION
A	8/1/90	UPDATE PER AS BUILT
B	7/26/90	UPDATE PER AS BUILT
C	7/26/90	UPDATE PER AS BUILT
D	8/2/90	ISSUE NOTE 1.

1/10

Appendix L List of Drawings — Slit Assembly

1. H1324 Slit Assembly
2. H1326 Slit Drive Schematic Information
3. H1322 Slit Jaw / Spring Assembly

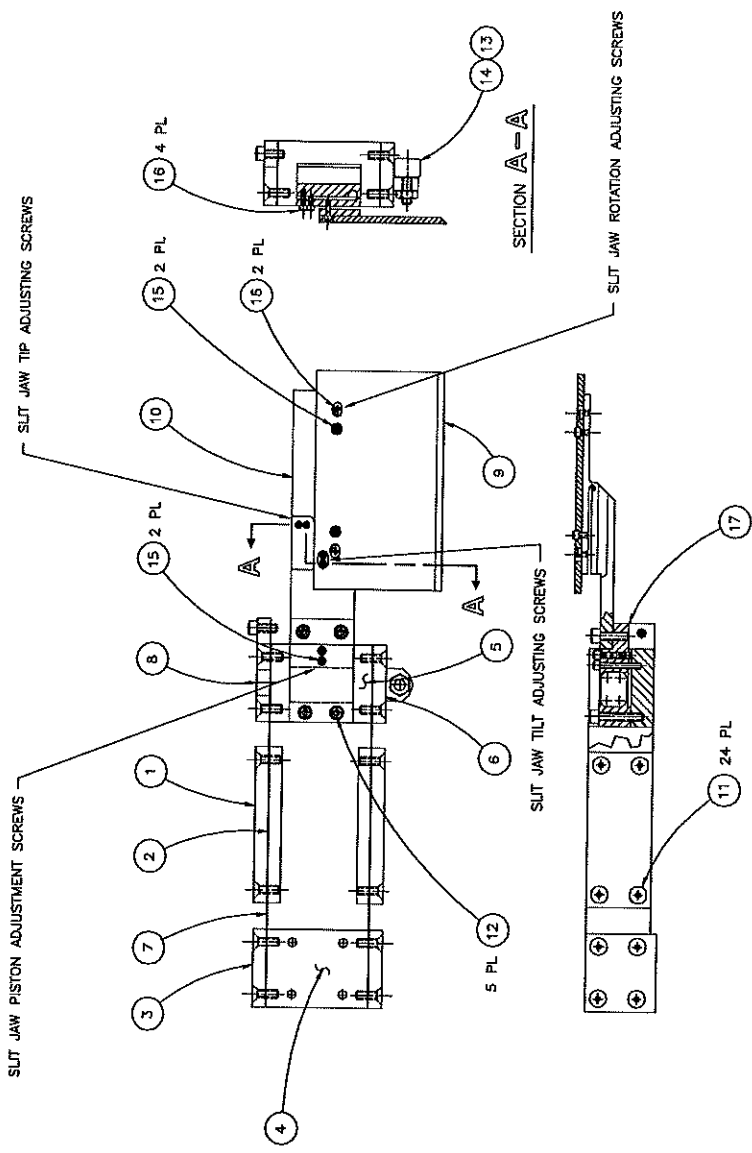

① SLIT JAW/SPRING ASSEMBLY

1 REQ'D

17	4	SKW	STICK	2-38 UNF
17	2	SKW	STICK	2-38 UNF
17	2	SKW	STICK	2-38 UNF
18	4	SKW	STICK	2-40 UNF
18	2	SKW	STICK	2-40 UNF
19	4	SKW	STICK	2-40 UNF
19	2	SKW	STICK	2-40 UNF
20	1	NUT	HEX	10-32 UNF
21	1	NUT	HEX	10-32 UNF
22	1	NUT	HEX	10-32 UNF
23	2	FOLLOWER	PLATE	ALUM
24	2	FOLLOWER	PLATE	ALUM
25	1	SKW	FINISH	2-32 UNF
26	1	SKW	FINISH	2-32 UNF
FULL

A. HIZOBI (S.S.)


KECK/HIRES
SLIT JAW/
SPRING ASSEMBLY

DATE: 07/08
C.O. 07/08

H1322.A

Appendix M List of Drawings — Slit Accessory Server

1. H1359 Details
2. H1388 Decker Plate Blank
3. H1384 Decker Plate #A
4. H1389 Decker Plate #B
5. H1390 Decker Plate #C
6. H1391 Decker Plate #D
7. H1378 Slit Accessory Server Assembly
8. H1387 Slit Accessory Server Drive Schematic
9. H6758 Slit Area Stage Mountings — Assembly
10. H6759 Slit Area Stage Mountings — Details
11. H6760 Slit Area Stage Mountings — Details

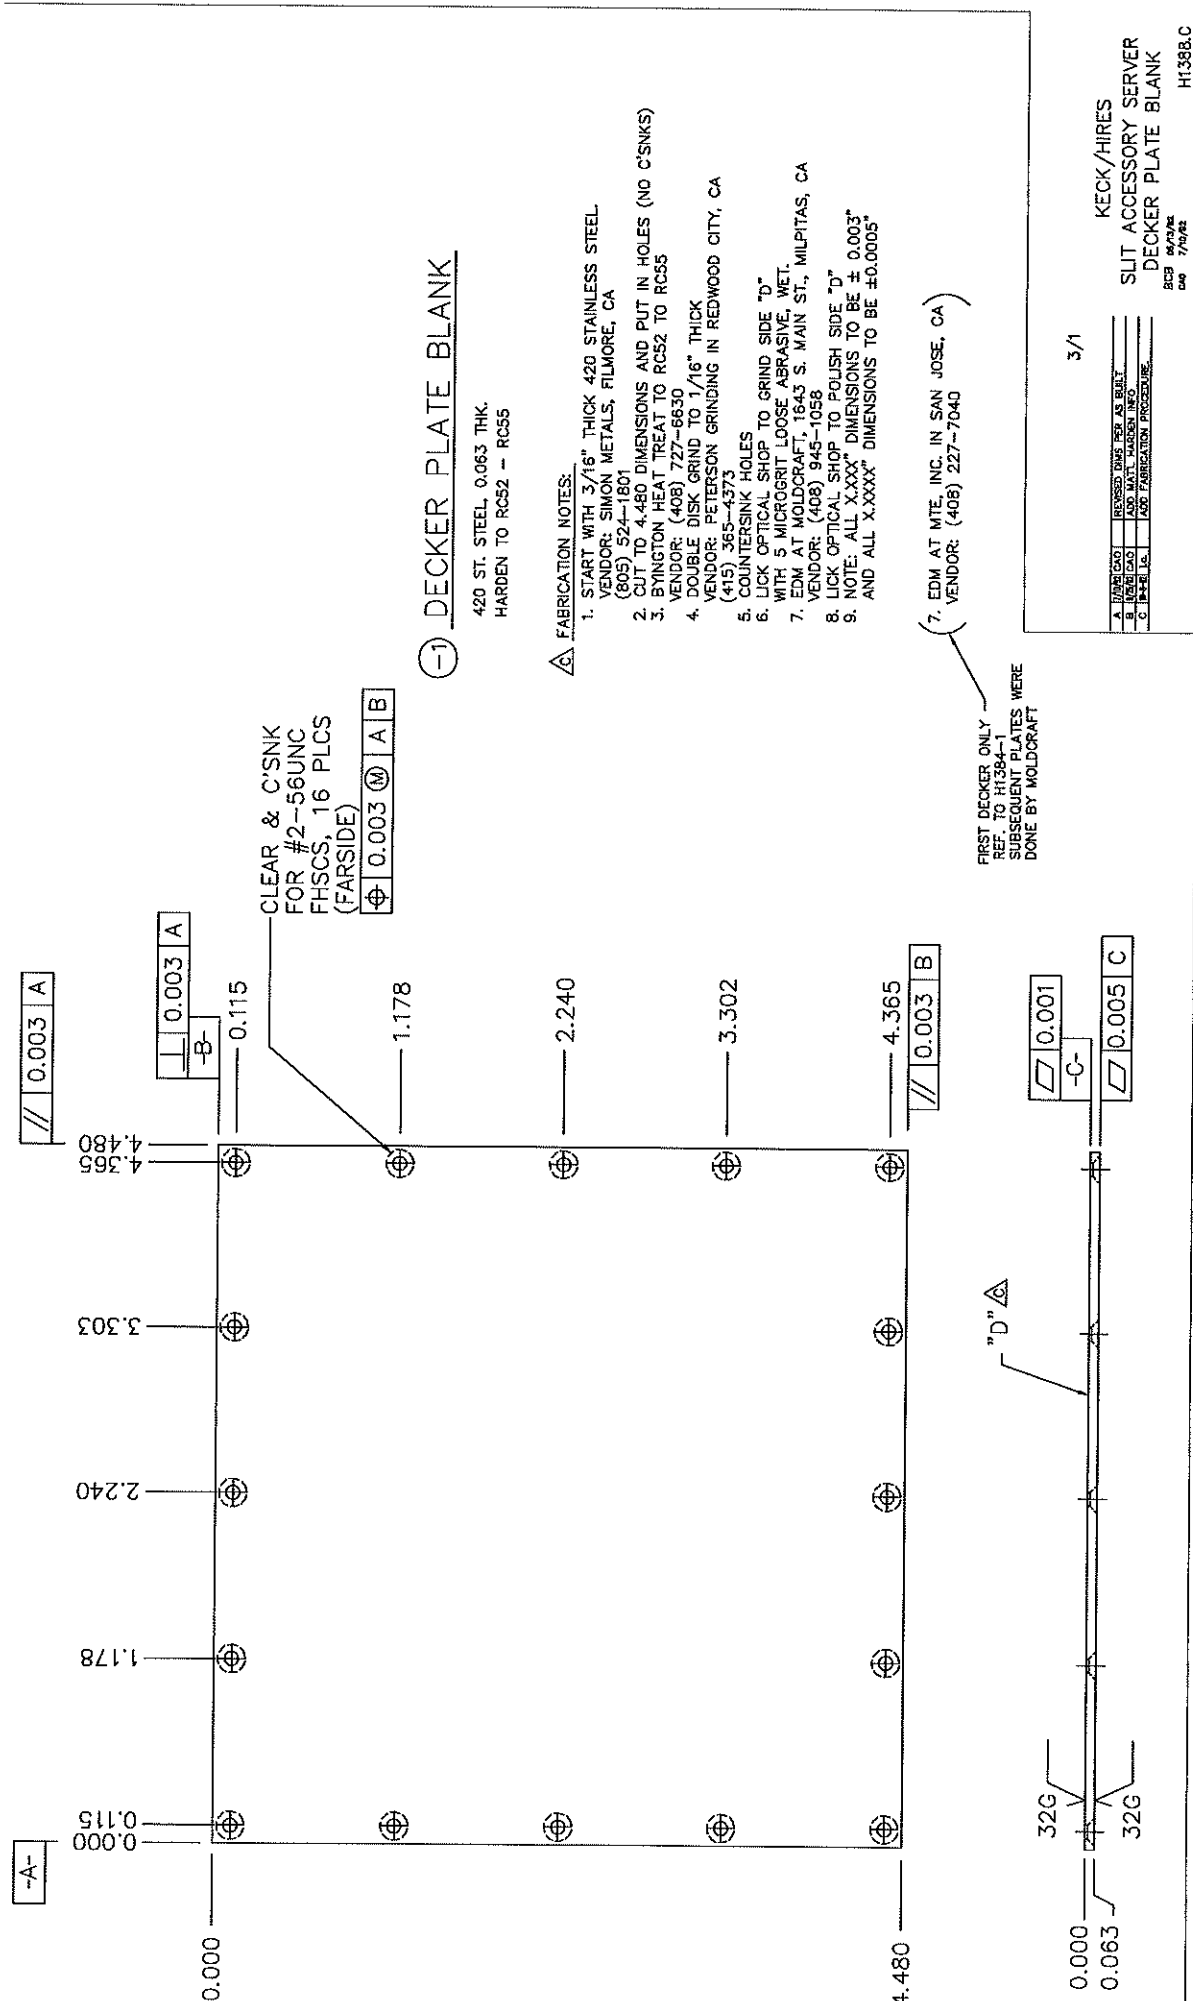

DECKER PLATE BLANK

420 ST. STEEL, 0.063 THK.
HARDEN TO RC52 - RC55

FABRICATION NOTES:

1. START WITH 3/16" THICK 420 STAINLESS STEEL.
VENDOR: SIMON METALS, FILMORE, CA (805) 524-1801
2. CUT TO 4.480 DIMENSIONS AND PUT IN HOLES (NO C'SNKS)
3. BYINGTON HEAT TREAT TO RC52 TO RC55
VENDOR: (408) 727-6630
4. DOUBLE DISK GRIND TO 1/16" THICK
VENDOR: PETERSON GRINDING IN REDWOOD CITY, CA (415) 365-4373
5. COUNTERSINK HOLES
6. LICK OPTICAL SHOP TO GRIND SIDE "D"
WITH 5 MICROGRIT LOOSE ABRASIVE, WET.
7. EDM AT MOLDCRAFT, 1643 S. MAIN ST., MILPITAS, CA
VENDOR: (408) 945-1058
8. LICK OPTICAL SHOP TO POLISH SIDE "D"
9. NOTE: ALL "XXXX" DIMENSIONS TO BE ± 0.003"
AND ALL "XXXXX" DIMENSIONS TO BE ±0.0005"

7. EDM AT MTE, INC. IN SAN JOSE, CA)
VENDOR: (408) 227-7040




FIRST DECKER ONLY
REF. TO H1384-1
SUBSEQUENT PLATES WERE
DONE BY MOLDCRAFT

3/1

KECK/HIRES
SLIT ACCESSORY SERVER
DECKER PLATE BLANK
REV 04/02
Dwg 7/02

A. MATERIAL	REVISIONS THIS DRAWING AS BUILT
B. MATERIAL	ADD MTL. HARDEN INFO
C. FINISH	ADD FABRICATION PROCEDURE

H1384.C

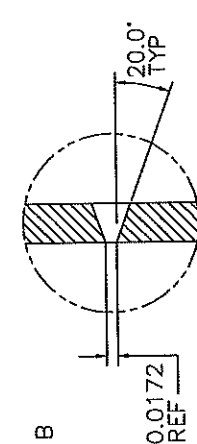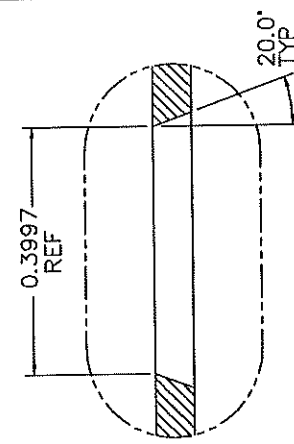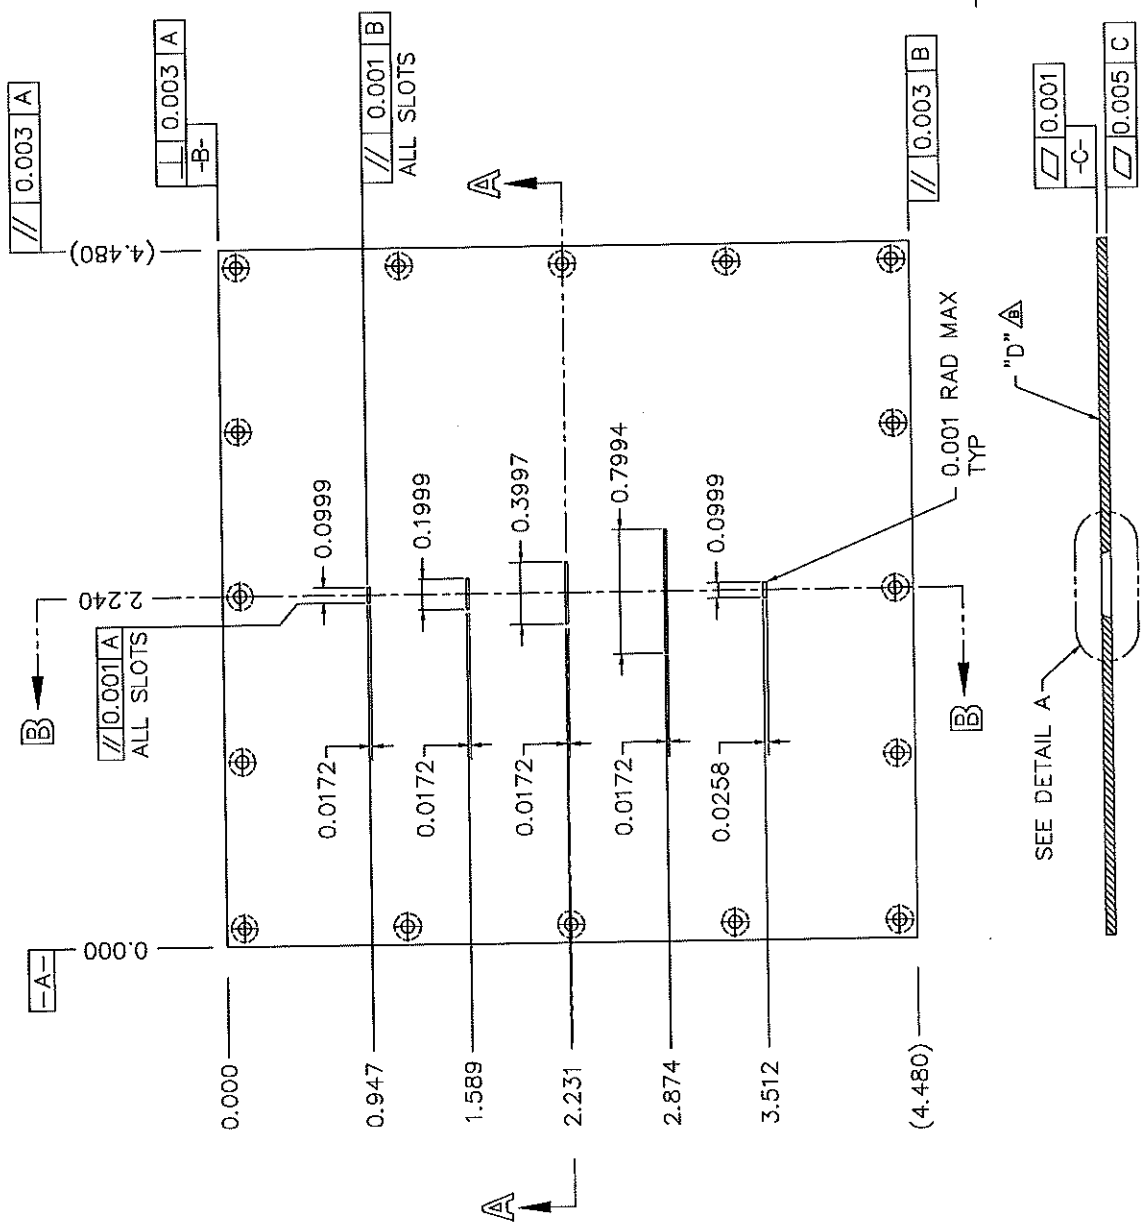

SEE DETAIL B

- DECKER PLATE #B
- NOTES:
1. SLOTS ARE CONCENTRIC @ Q.
 2. FABRICATION NOTES, SEE H1388




SEC B=B

SEC A=A

A	MODIFIED	ADD TO TITLE
B	DATE	ADD FABRICATION NOTE

3/1

KECK/HIRES
SLIT ACCESSORY SERVER
DECKER PLATE #B
RCA 7/1/82
EAG 7/1/82
H1389.B

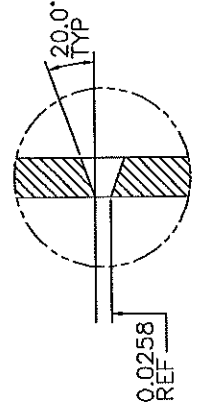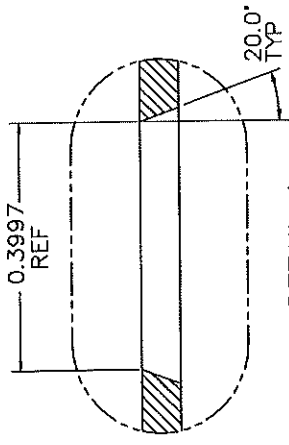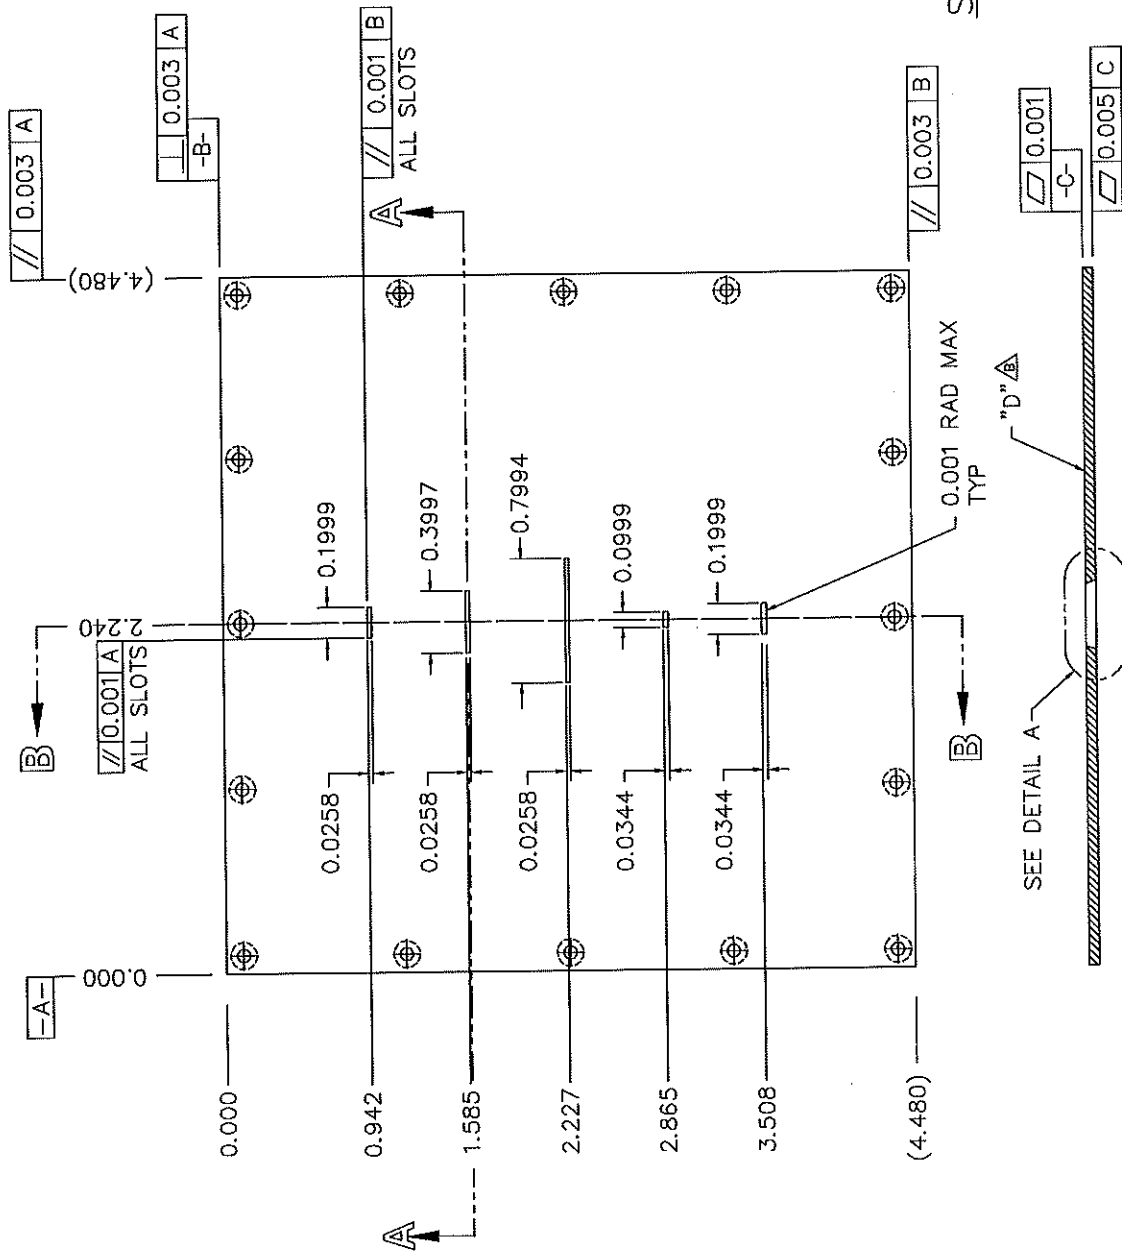


SEE DETAIL B

- ① DECKER PLATE #C
- NOTES:
1. SLOTS ARE CONCENTRIC @ C.
 2. FABRICATION NOTES, H1388

SEC B = B

A	DATE CHG	ADD TO TITLE
B	DATE CHG	ADD FABRICATION NOTE

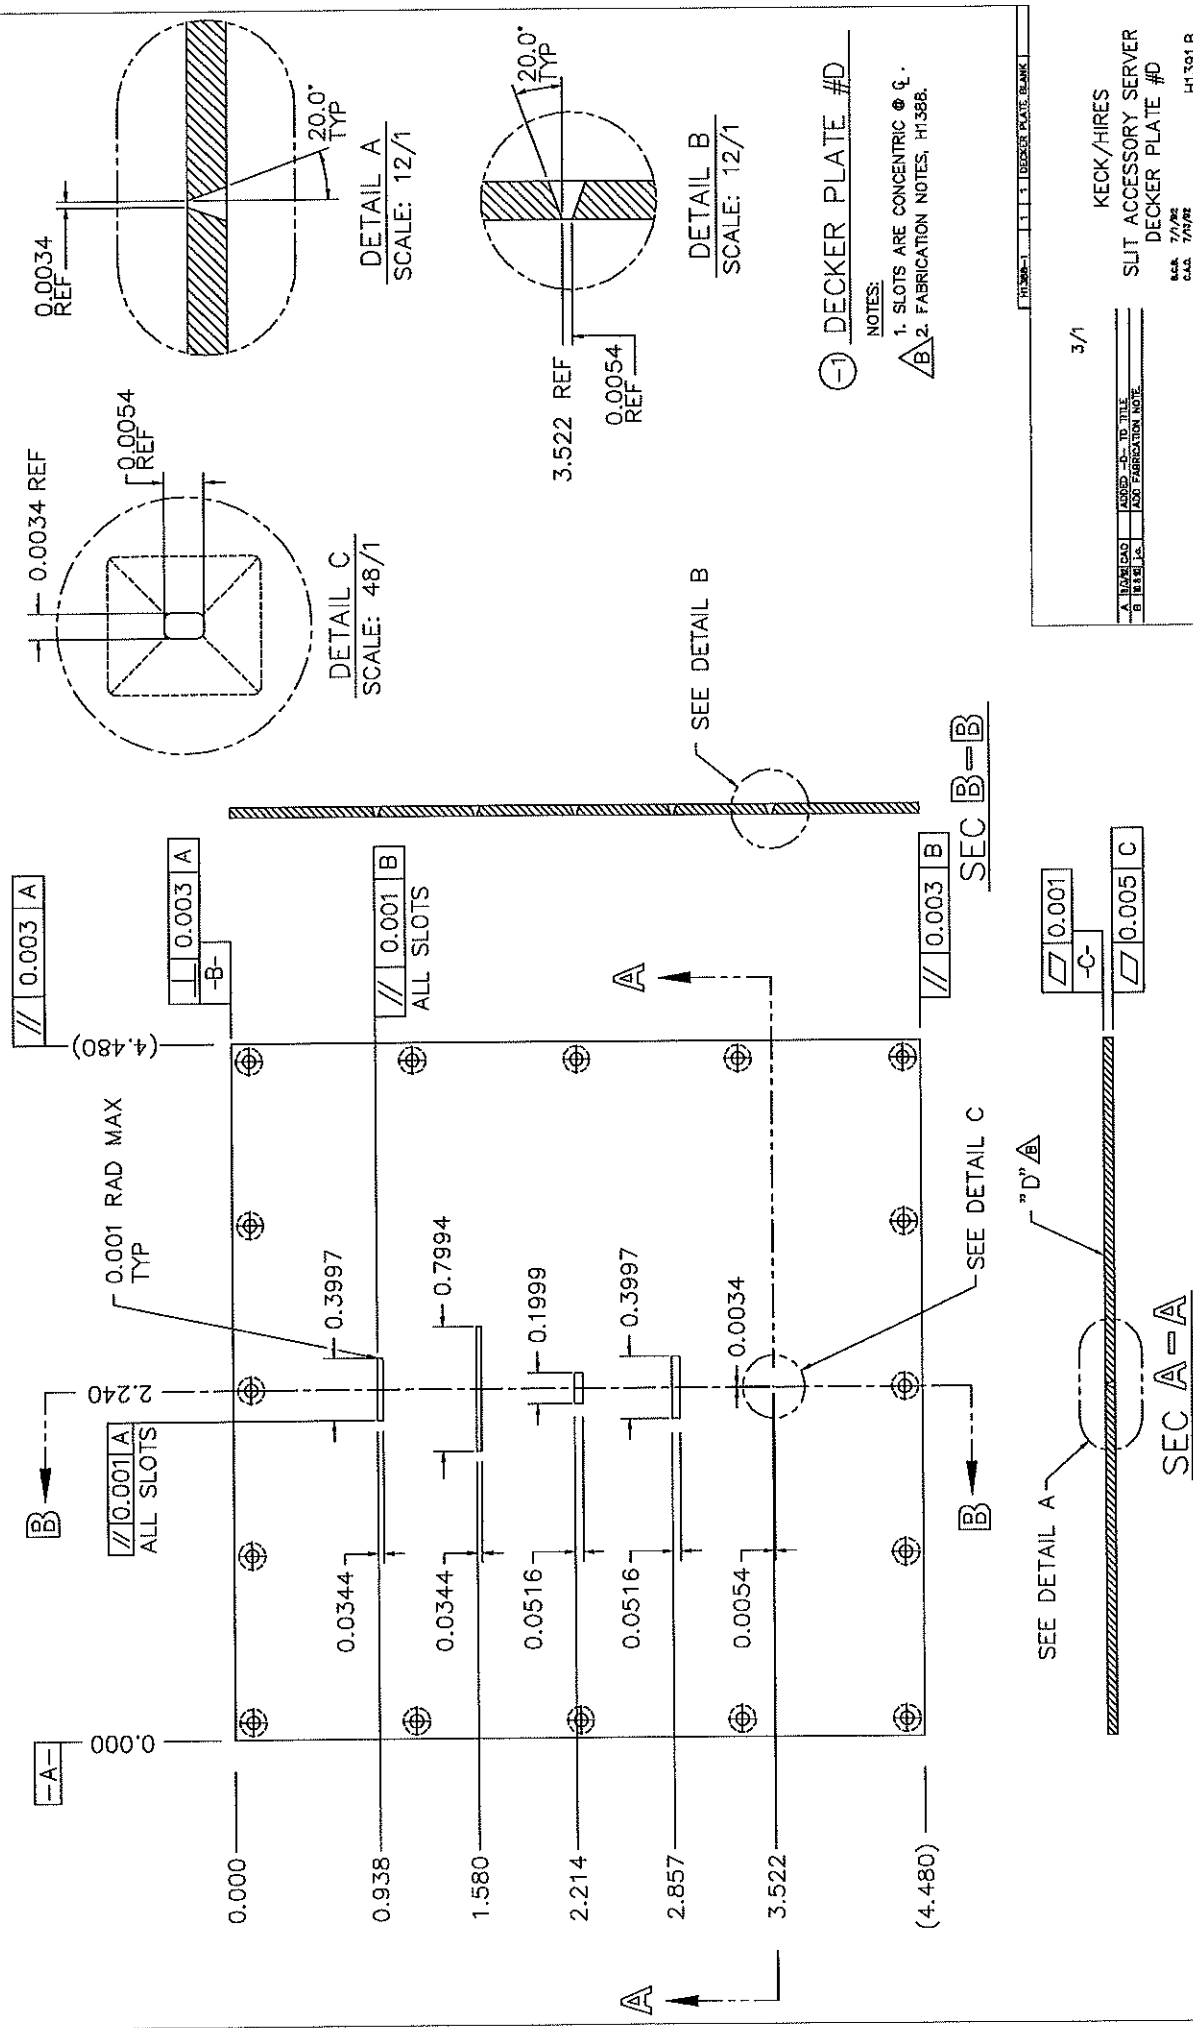

0.0034 REF

0.0034 REF

0.0054 REF

0.0034 REF

0.0054 REF

3.522 REF

0.0054 REF

20.0° TYP

20.0° TYP

DETAIL A
SCALE: 12/1

DETAIL B
SCALE: 12/1

DETAIL C
SCALE: 48/1

SEE DETAIL B

SEE DETAIL C

SEE DETAIL A

① DECKER PLATE #D

NOTES:
1. SLOTS ARE CONCENTRIC @ ϕ .
2. FABRICATION NOTES: H1391.B

1 1 1 DECKER PLATE BANK

3/1

KECK/HIRES
SLIT ACCESSORY SERVER
DECKER PLATE #D
BAR 7/1/92
C.A. 7/1/92
H1391.B

A: DRAWING
B: TITLE
C: ADD FABRICATION NOTE

SEC A-A

SEC B-B

"D" A

(4.480)

0.000

0.938

1.580

2.214

2.857

3.522

2.240

0.001 RAD MAX TYP

0.3997

0.7994

0.1999

0.3997

0.0034

0.0344

0.0344

0.0516

0.0516

0.0054

0.003 A

0.003 A

0.001 B

0.003 B

0.001 C

0.005 C

A-A

B-B

B-B

C-C

(4.480)

-B-


ALL SLOTS

ALL SLOTS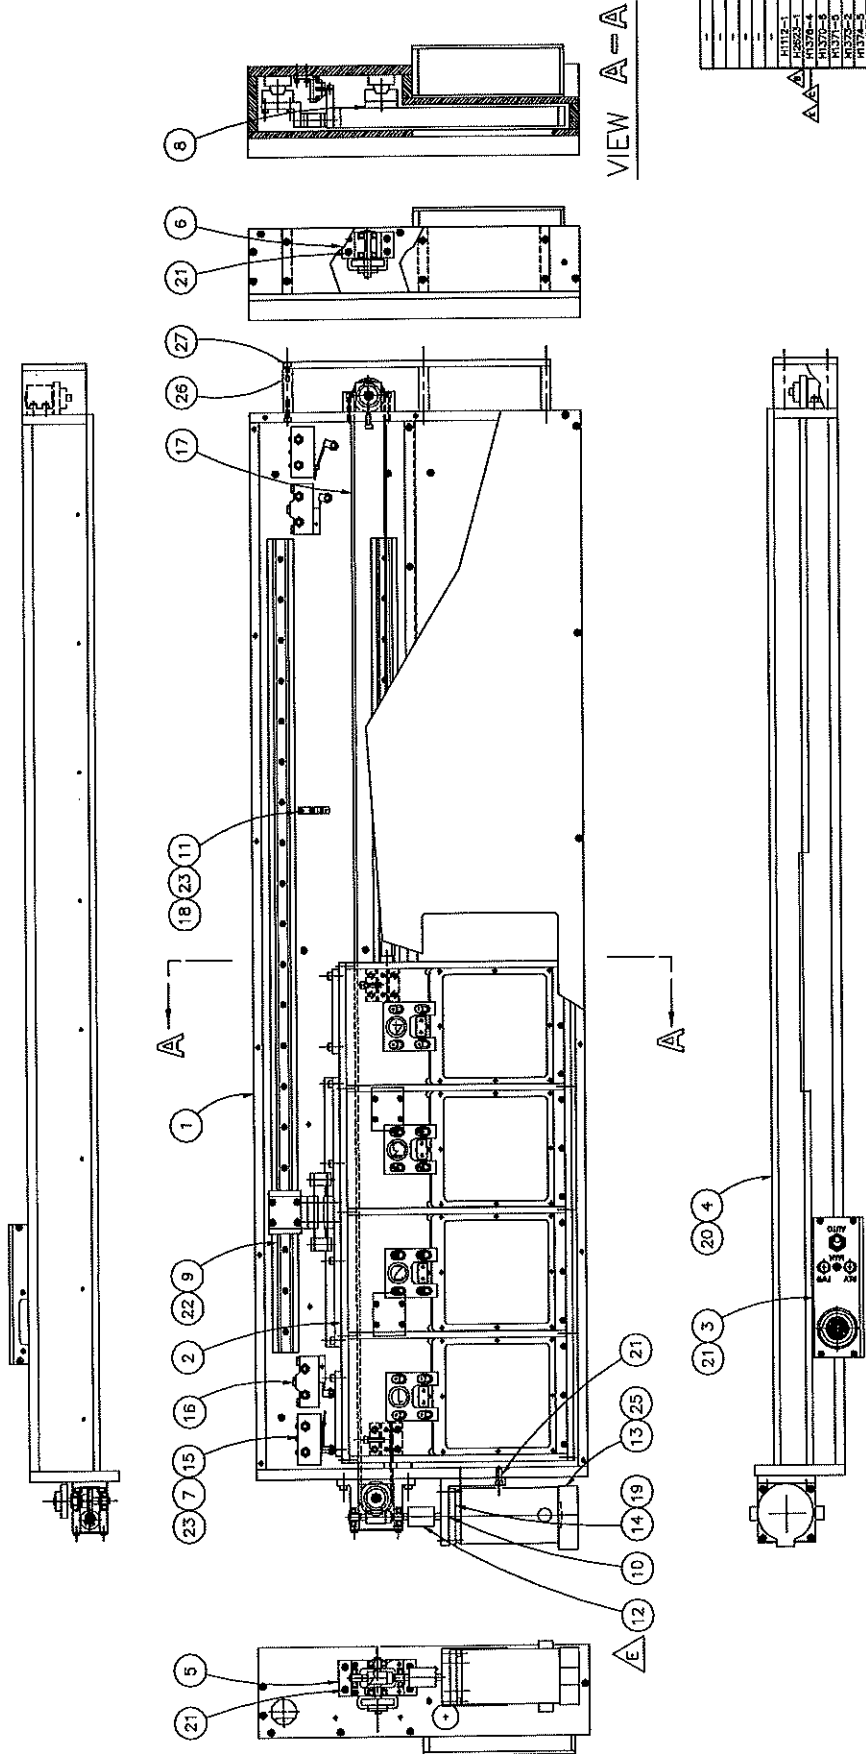

VIEW A-A

SLIT ACCESSORY SERVER

1 REQ'D
NOTES:

- 1. GALIL 50/1000
- 2. MICRO, DT-2RV22-A7
- 3. MICRO, BZ-2RW622-A2
- 4. HEWLETT PACKARD HED 6000 SERIES

1/2

KECK/HIRES
SLIT ACCESSORY SERVER
ASSEMBLY

DECL. 06/74/88
C.A.C. 06/74/88

H1378.F

20	A/R SCK. 8-32 UNC SWS	ALUM	H1374-2	1	COVER PLATE
19	A/R SCK. 8-32 UNC SWS	ALUM	H1374-3	7	SWITCH SPACER
18	A/R SCK. 4-40 UNC SWS	ALUM	H1374-4	4	COVER BOX ASSY
17	TURNING BELT BRG	NOTE 1	H1374-5	8	1. GEAR BOX ASSY
16	LIMIT SWITCH. SMT	NOTE 2	H1374-6	1	1. GEAR BOX ASSY
15	LIMIT SWITCH. SMT	NOTE 3	H1374-7	4	1. COVER
14	ADAPTOR. OPT. THRO	NOTE 4	H1374-8	1	1. ELECTRONIC BOX
13	MOTOR	NOTE 5	H1374-9	2	1. GEARBOX ASSY
12	COUPLING	NOTE 6	H1374-10	1	1. HOUSING ASSY
11	BRACKET. PHYSICAL	ALUM	H1374-11	1	
10	BRACKET. PHYSICAL	ALUM	H1374-12	1	
9	SLIDE MOUNTED	ALUM	H1374-13	2	
8	SLIDE SPACER	ALUM	H1374-14	8	
7	SWITCH SPACER	ALUM	H1374-15	7	
6	COVER BOX ASSY	ALUM	H1374-16	4	
5	GEAR BOX ASSY	ALUM	H1374-17	1	
4	COVER	ALUM	H1374-18	4	
3	ELECTRONIC BOX	ALUM	H1374-19	1	
2	GEARBOX ASSY	ALUM	H1374-20	2	
1	HOUSING ASSY	ALUM	H1374-21	1	

A	1/2" DIA. GALV. PLATE	ALUM	H1374-22	1	
B	1/2" DIA. GALV. PLATE	ALUM	H1374-23	1	
C	1/2" DIA. GALV. PLATE	ALUM	H1374-24	1	
D	1/2" DIA. GALV. PLATE	ALUM	H1374-25	1	
E	1/2" DIA. GALV. PLATE	ALUM	H1374-26	1	
F	1/2" DIA. GALV. PLATE	ALUM	H1374-27	1	

DECKER PLATES:
 DECKER PLATE MATERIAL IS 420 STAINLESS STEEL.
 PLATES ARE FINE GROUND, THEN EDM MACHINED,
 AND OPTICALLY POLISHED TO A FEW WAVES.

420 STAINLESS:
 CARPENTER TECHNOLOGY
 2263 NATIONAL AVE "A"
 HAYWARD, CA 94545-1715
 800-522-5077


THEORETICAL POSITIONING RESOLUTION:
 MOTOR ENCODER 4000CTS/REV
 GEAR BOX REDUCTION 60:1
 DRIVE GEAR PITCH RADIUS 0.6366

1 CT X 1 REV/4000 CT X 1 REV OUT/60 REV IN X 2 (.6366)/REV OUT = 0.000016666 INCH
 OR 0.000016666 INCH/CT.
 OR @ 60,000 CTS/INCH

IF SERVO LOOP IS GOOD TO 2 COUNTS,
 RESOLUTION IS 0.000033333 INCHES.

RESOLUTION AND REPEATABILITY HAVE BEEN TESTED MECHANICALLY TO 0.0005 INCHES.
 BETTER TESTING WILL BE PERFORMED WITH THE GUIDER COD TV.

PLATE SCALE AT SLIT ACCESSORY SERVER IS 1.375 ARC-SEC./mm.

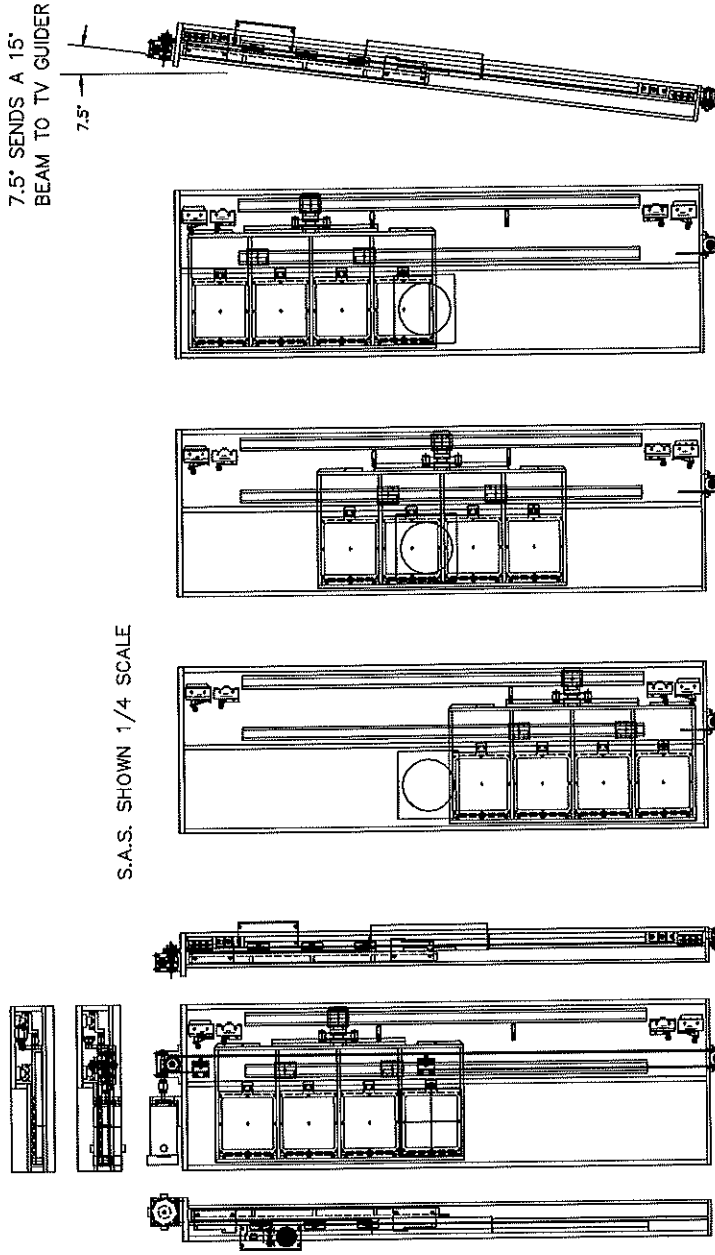

7.5" SENDS A 15"
 BEAM TO TV GUIDER

7.5"

S.A.S. SHOWN 1/4 SCALE

AT UPPER LIMIT



CENTER OF TRAVEL

DECKER CARRIAGE
 IN STOWED POSITION

TRAVEL OF CARRIAGE IS 18"
 APERTURE PLATES ARE 4.5" X 4.5" X 0.063" THICK
 USABLE APERTURE AREA IS 4" X 4"

DATE: 11/11/87

KECK/HIRES
 SLIT ACCESSORY SERVER
 DATA AND GEAR REDUCTIONS
 H1387.A

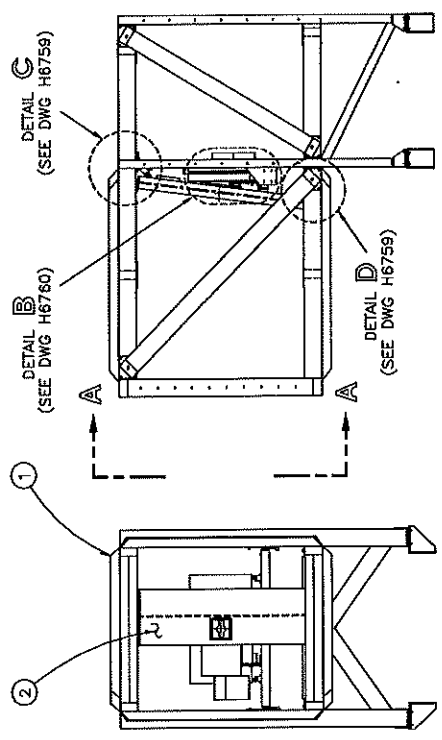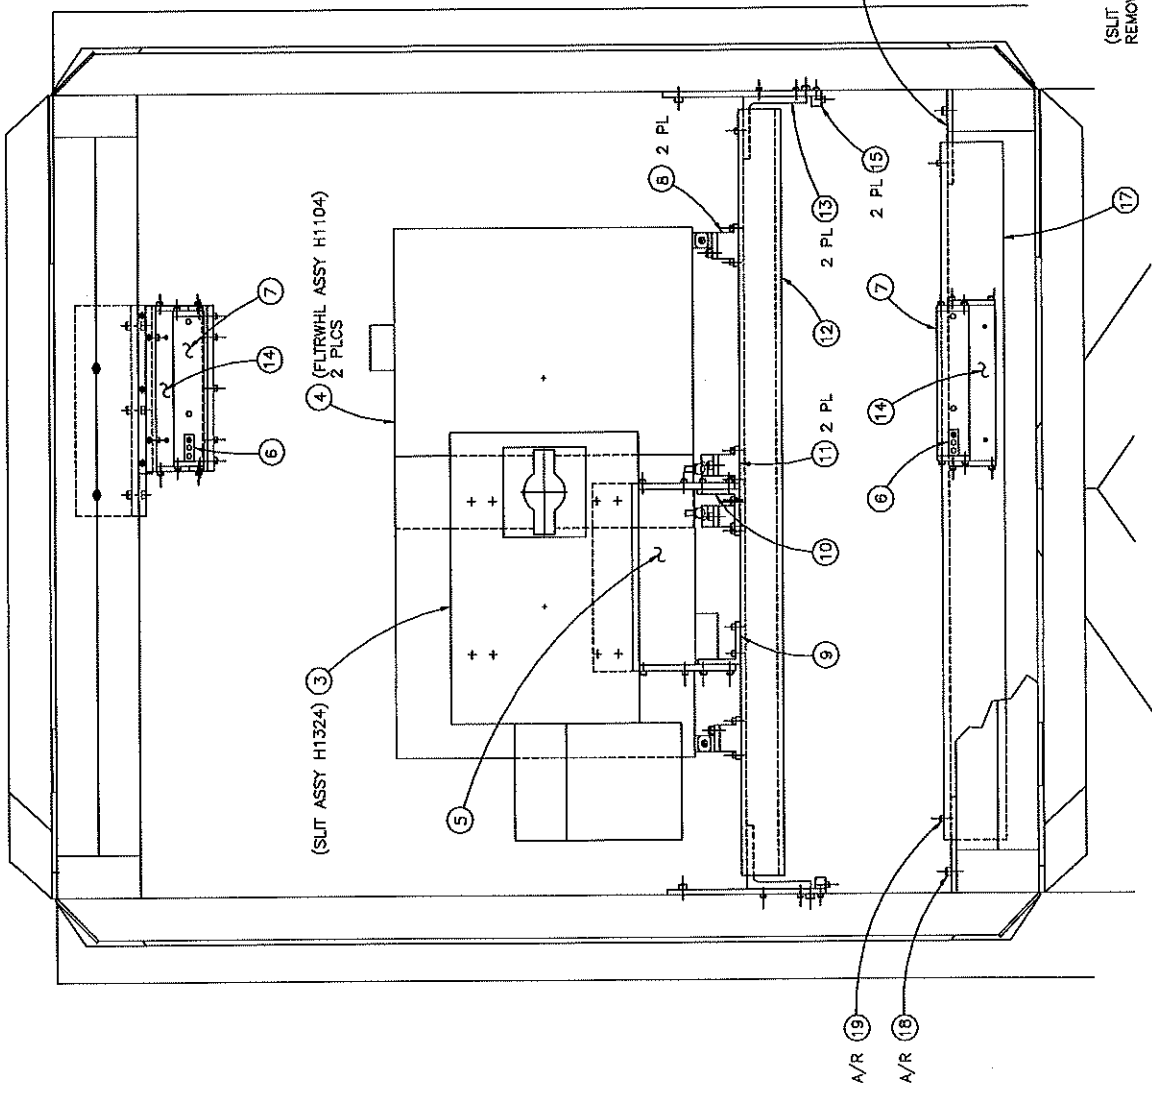

19	A/R	SER. 1/2-28 UNF SHCS
18	A/R	SER. 1/2-28 UNF SHCS
H6754-1	1	ANGLE MOUNT
H6754-2	2	CROSS PLATE
H6754-3	2	ADJUST KAS
H6754-4	2	S.A.S. MOUNT
H6754-5	2	ANGLE SUPPORT
H6754-6	1	SUPPORT
H6754-7	2	FLANGE
H6754-8	2	FLANGE (SMALL)
H6754-9	2	CROSS SUPPORT
H6754-10	2	CROSS SUPPORT
H6754-11	2	ANGLE MOUNT (RIGHT)
H6754-12	2	ANGLE MOUNT (LEFT)
H6754-13	2	P.W. STAND
H6754-14	2	FLANGE (SMALL)
H6754-15	2	CROSS SUPPORT
H6754-16	2	CROSS SUPPORT
H1104	4	12 HOLE FLTR. WHEEL ASSY
H1324	2	SLIT ASSY
H1378	2	SLIT ACCESSORY ASSY
H671	1	SLIT AREA STRUCTURE SET


NOTED

VIEW A-A

SCALE: NONE
(SLIT ACCESSORY ASSY H1378
REMOVED FOR CLARITY)


KECK/HIRES
SLIT AREA STAGE MOUNTS
ASSEMBLY
H6755

BCS 8/2000
CS 8/2000

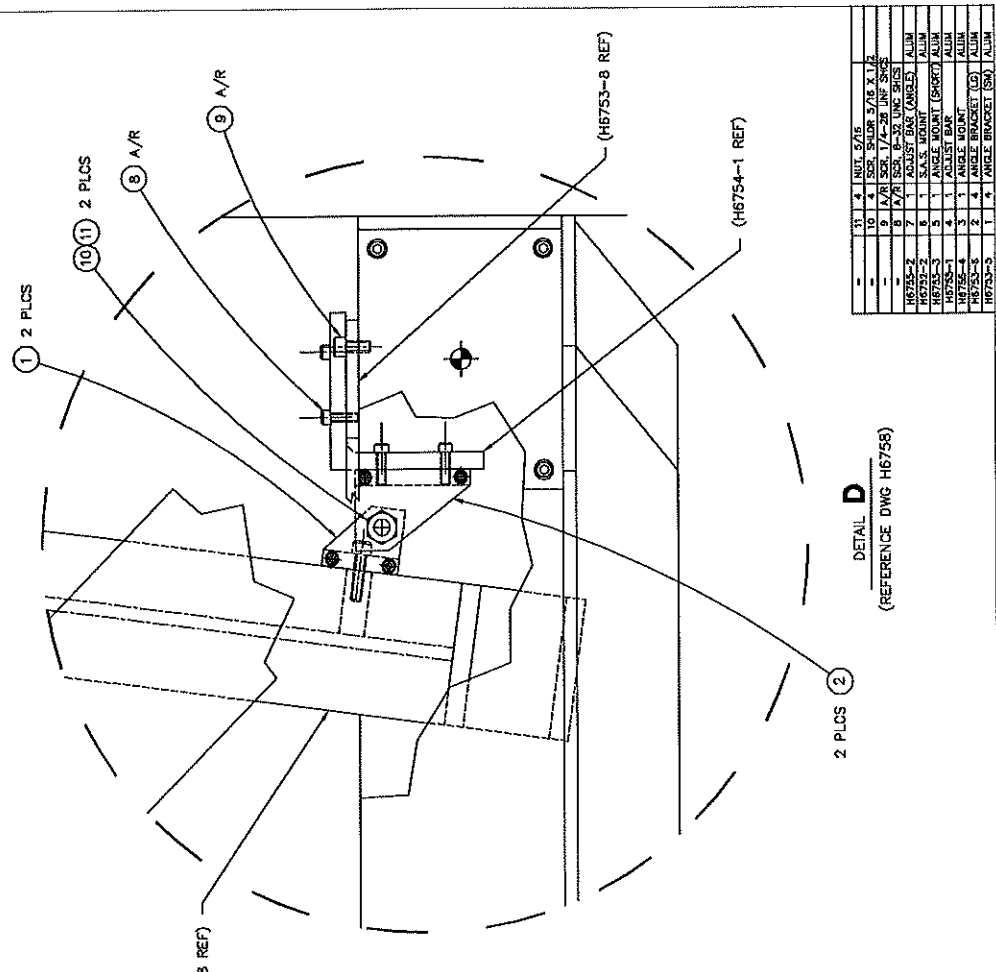

13	4	NUT 5/16
10	4	SCR. SHOR. 5/16 X 1 1/2
9	A/R	SCR. 1/4-20 INF. SIZES
8	A/R	SCR. 8-32 INF. SIZES
7	1	ADJUST. BKT. (ORLES)
H6753-2		ALUM
H6753-3		ALUM
H6753-4		ALUM
H6753-100		ALUM


DETAIL **D**
(REFERENCE DWG H6758)

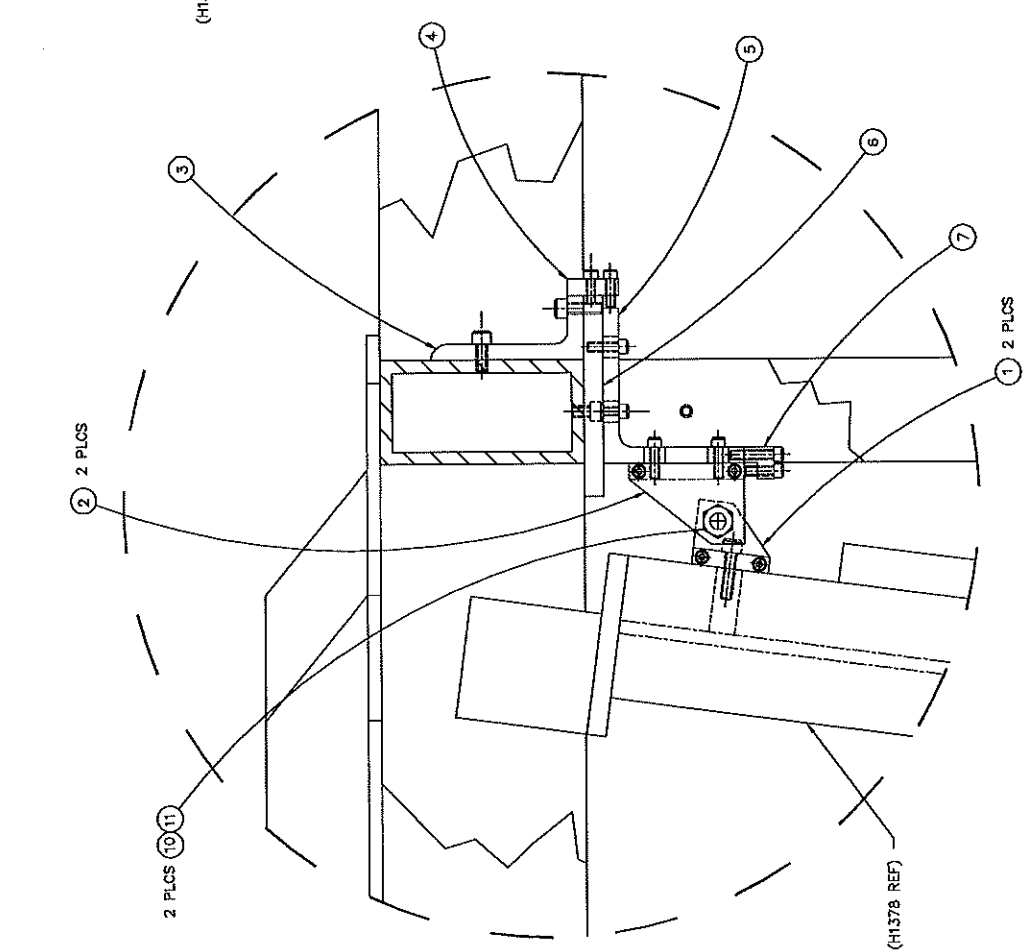

DETAIL **C**
(REFERENCE DWG H6758)

FULL

KECK/HIRES
SLIT AREA STAGE MOUNTS
ASSEMBLY DETAILS
BCB 8/1/86
G 8/1/86
H6759

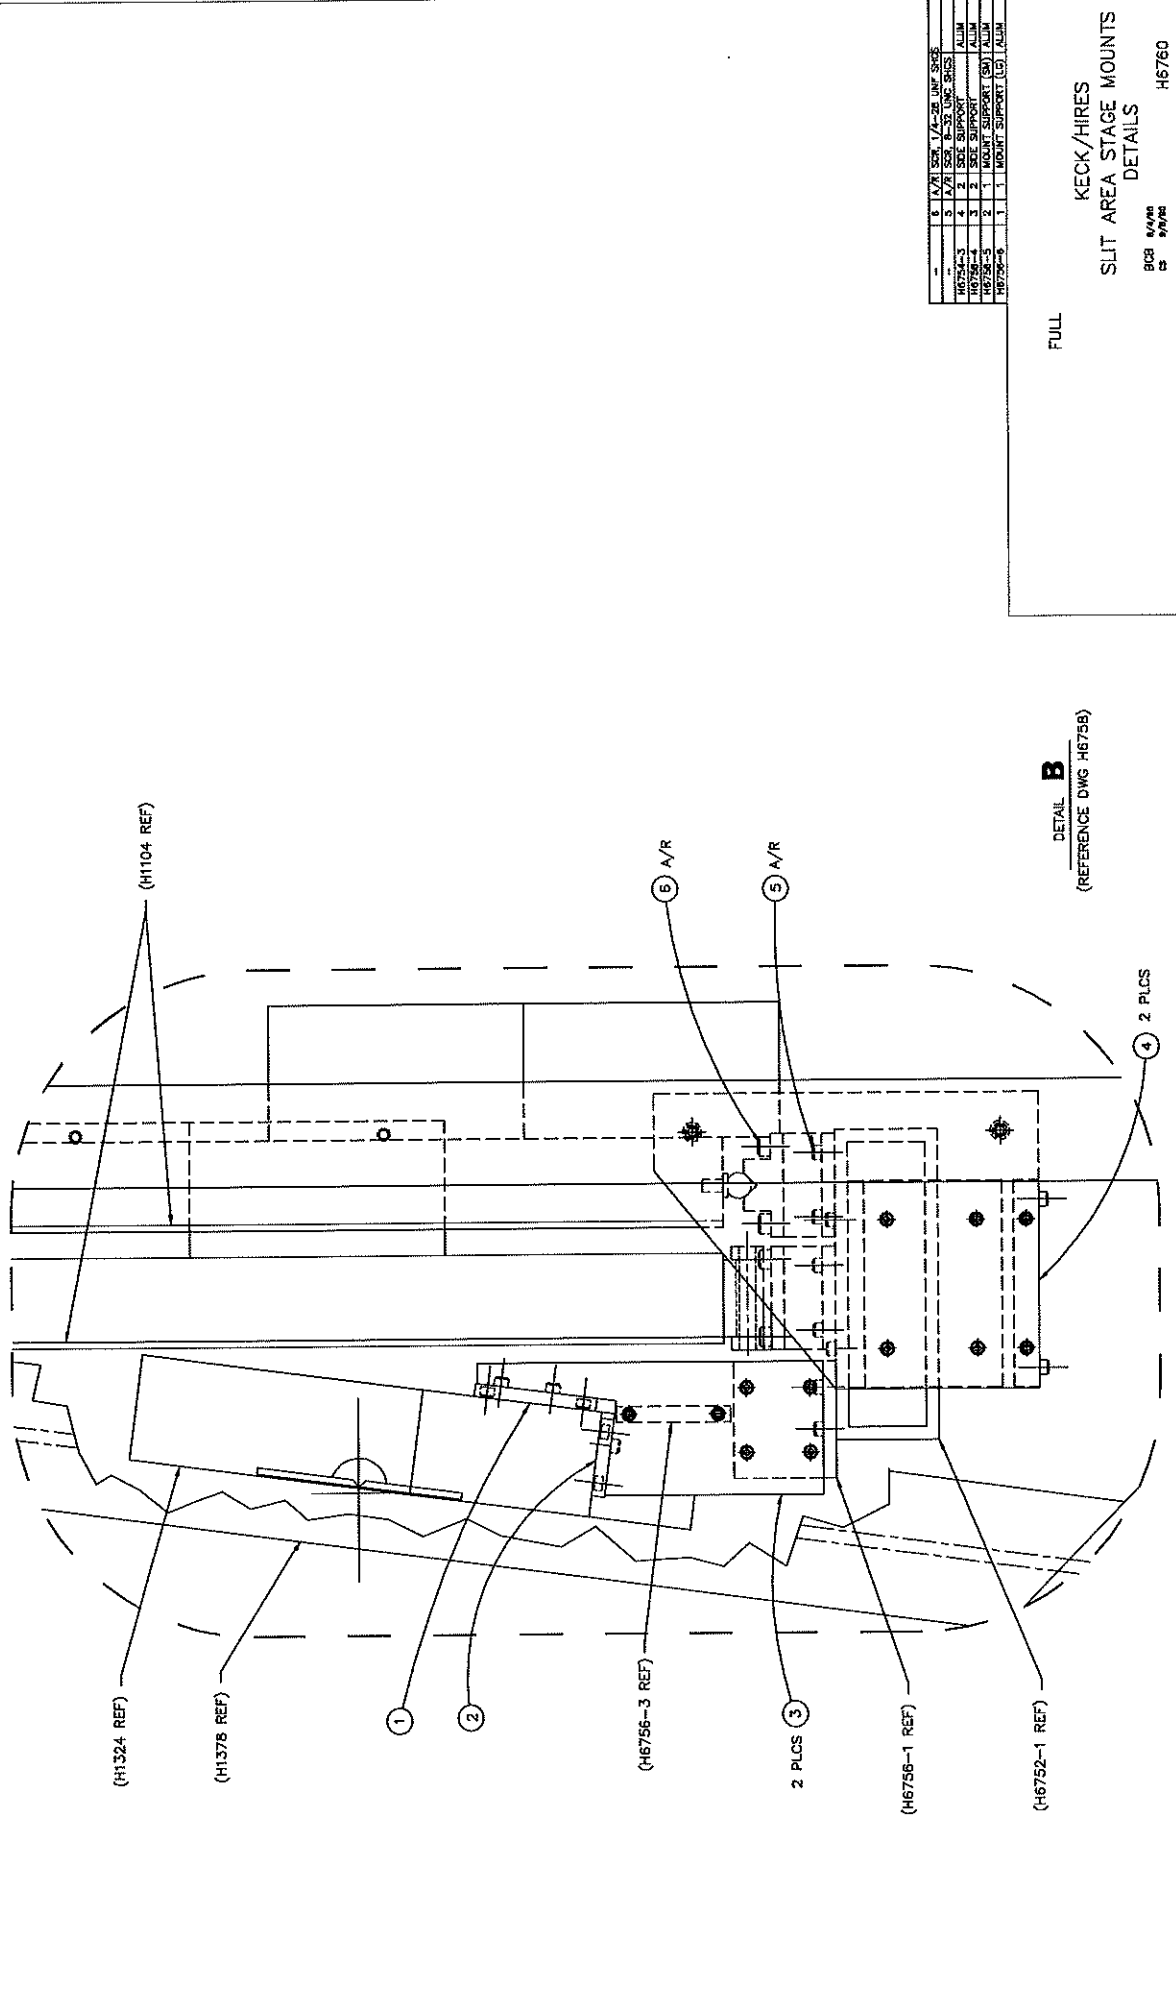

FULL




DETAIL **B**
 (REFERENCE DWG H6798)

6	A/R	5/8"	1/2"	2"	ALUM
5	A/R	5/8"	1/2"	2"	ALUM
4	2	1/2"	1/2"	2"	ALUM
3	2	1/2"	1/2"	2"	ALUM
2	1	1/2"	1/2"	2"	ALUM
1	1	1/2"	1/2"	2"	ALUM

KECK/HIRES
 SLIT AREA STAGE MOUNTS
 DETAILS
 BCB 8/2/98
 CS 8/2/98
 H6760

Appendix N List of Drawings — Filterwheels

1. H1104 12-Position Filterwheel Assembly
2. H1115 Filterwheel
3. H1114 Filterwheel Drive Schematic
4. H1110 Filterwheel Drive Motor Assembly
5. H6758 Slit Area Stage Mountings — Assembly
6. H6760 Slit Area Stage Mountings — Details

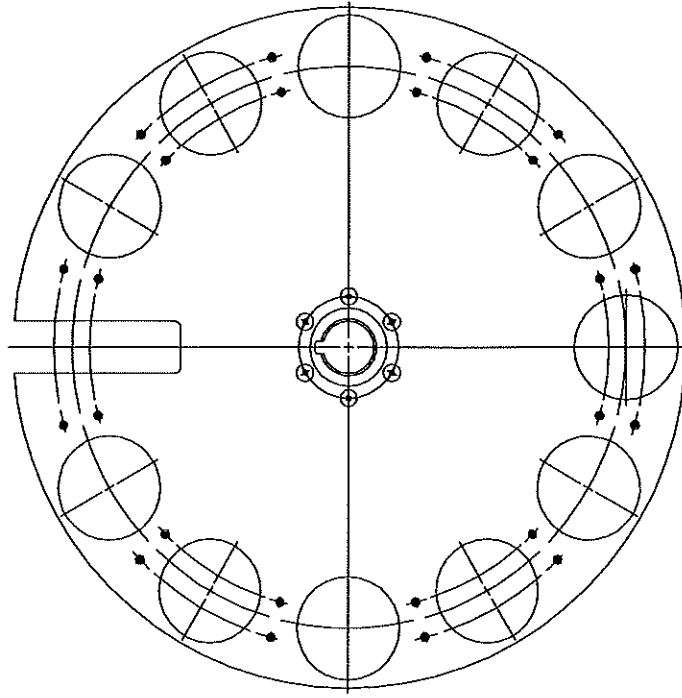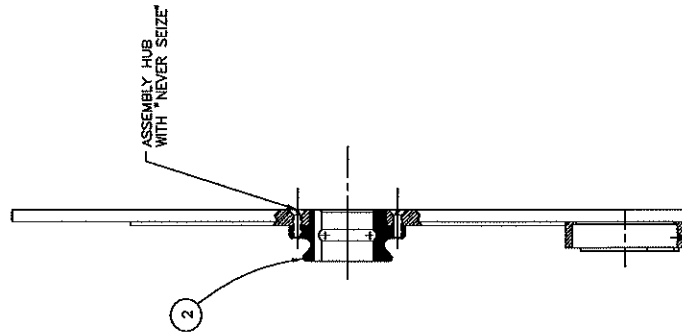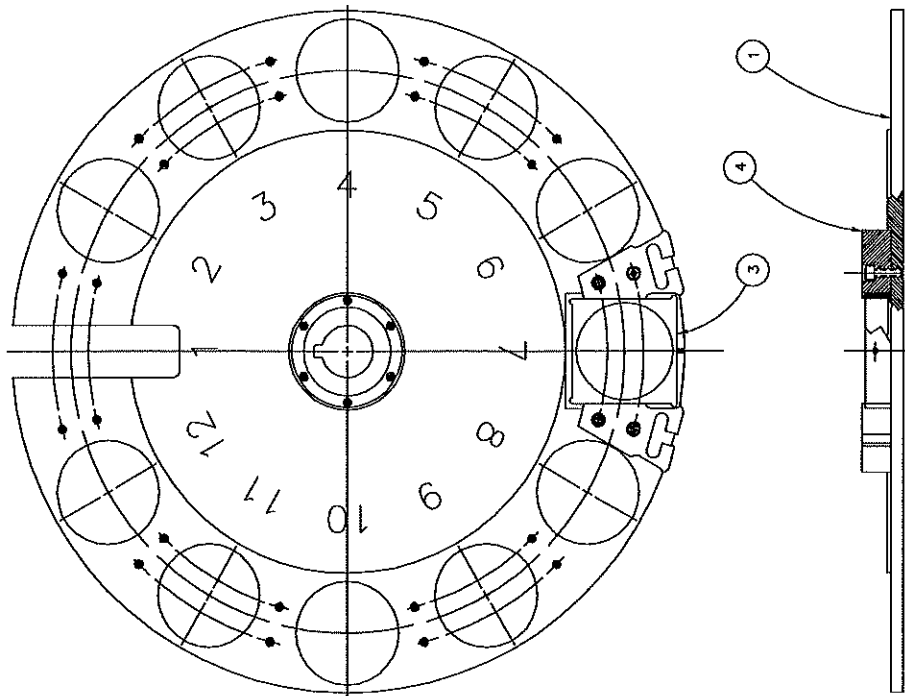

HT100-1	4	LAVI KEEPER	ALUM
HT117-2	3	LAVI FILTER HOLDER	ALUM
HT117-1	2	HUB	ALUM
HT118-1	1	FILTERWHEEL 12 HOLE	ALUM

KECK/HIRES
 FILTERWHEEL 12 HOLE
 FILTERWHEEL ASSY
 HT115.E
 S.A.C. 12 08 88
 S.A.C. 01 20 88

(1) FILTERWHEEL ASSY
 1 REQ'D

FULL

A	REVISED	DATE	BY
B	NEW	08/11/88	HT115
C	REVISED	08/11/88	HT115
D	REVISED	08/11/88	HT115
E	REVISED	08/11/88	HT115

THEORETICAL POSITIONING RESOLUTION:


MOTOR ENCODER 4000 CTS./REV
GEAR REDUCTION 30:1
FILTER POSITIONS 12 (12/REV)

1 CT X 1 REV/4000 CTS X 1 REV OUT/30 REV IN X 360°/REV = 0.003°
OR 0.003°/CT
OR 333 CTS/DEGREE

ACTUAL RESOLUTION IS DOMINATED BY FREE PLAY BETWEEN THE HUB AND THE FILTERWHEEL.



FILTER HOLDER IS H1117-2, AND WILL HOLD A 2" DIA. OR 2" SQUARE FILTER. FILTER THICKNESS CAN BE AT LEAST 0.400" IN THIS HOLDER. THICKER FILTERS WILL REQUIRE A CUSTOM HOLDER.

FILTERWHEEL ASSY. SHOWN 1/2 SCALE

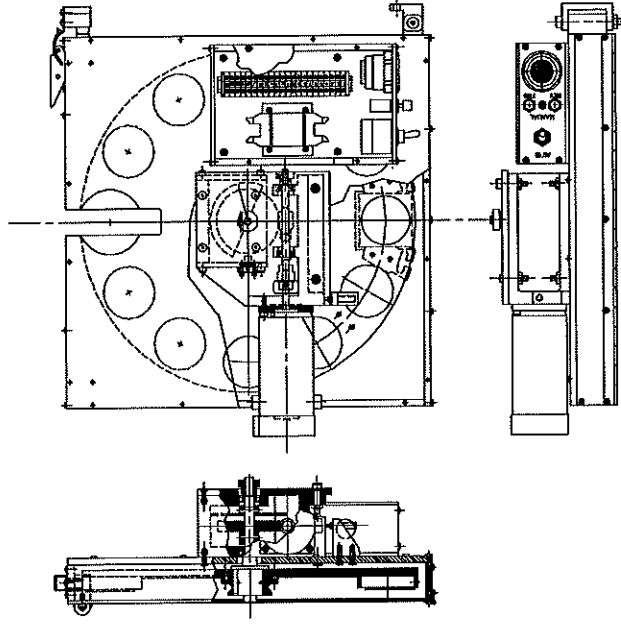

KECK/HIRES
FILTERWHEEL, 12 HOLE
DATA AND GEAR REDUCTION
REV 04/92/RC
H1117-2.A

A. 1117-2.A | GENERAL DESIGN

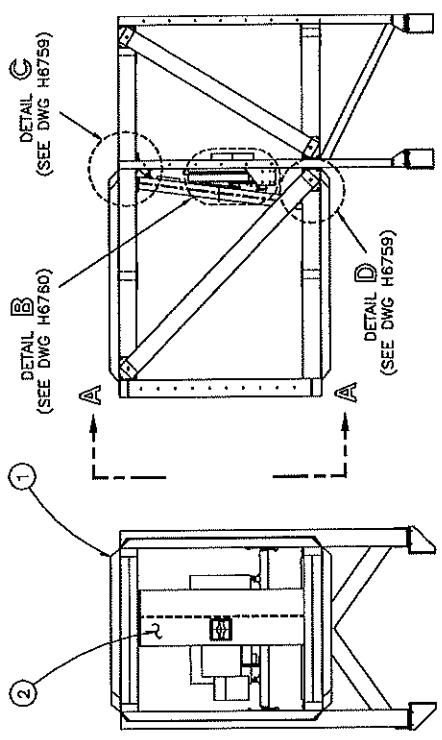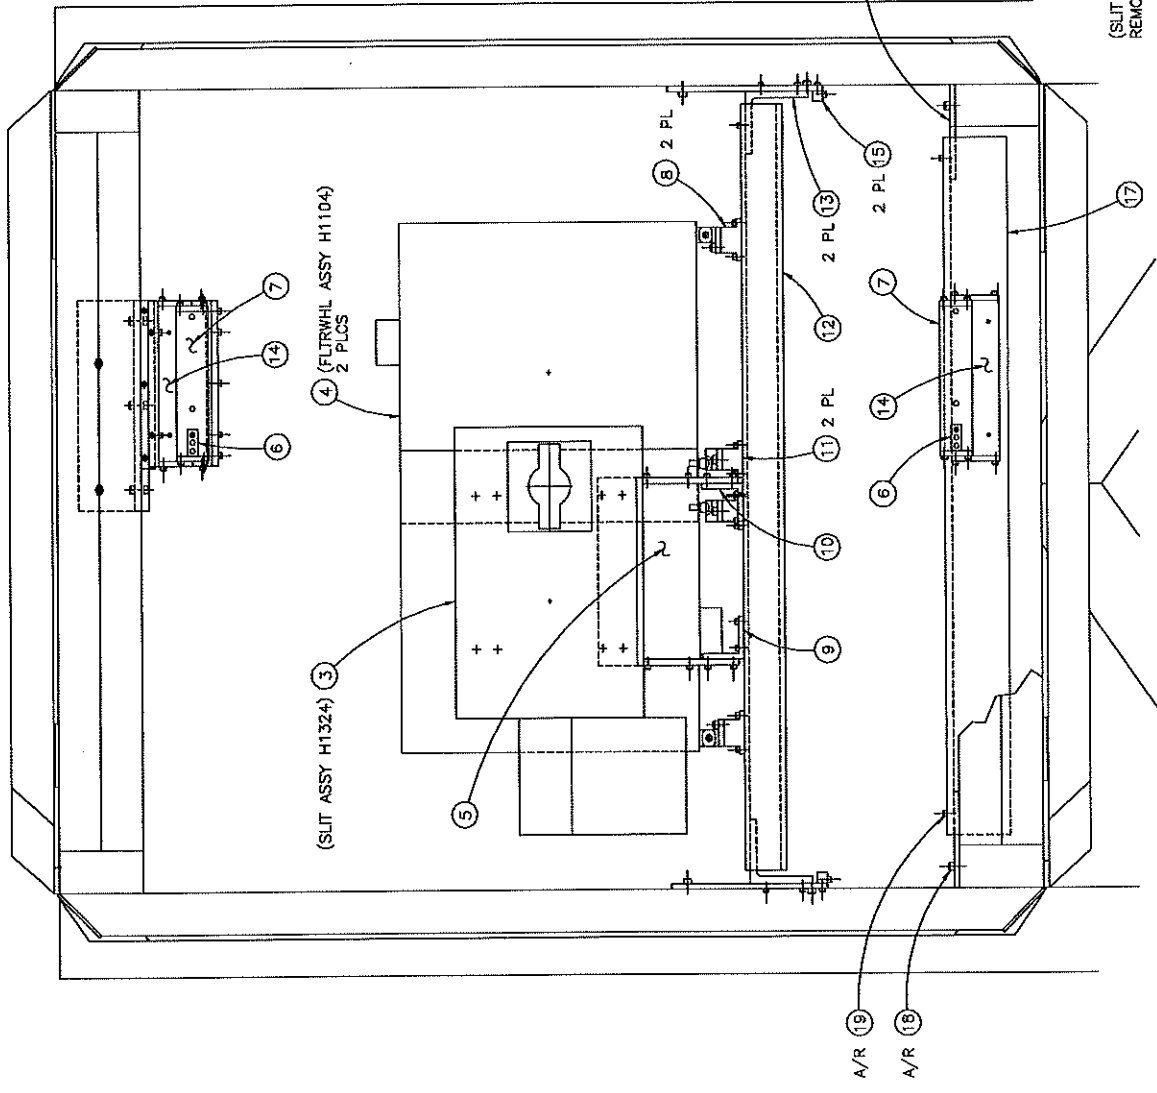

19	A/R	SCR. 1/2-20 UNF. SPACE	ALUM
18	A/R	SCR. 1/2-20 UNF. SPACE	ALUM
17	A/R	SCR. 1/2-20 UNF. SPACE	ALUM
16	2	SUPPORT PLATE	ALUM
15	2	ADJUST BAR	ALUM
14	2	S.A.S. MOUNT	ALUM
13	2	ANGLE SUPPORT	ALUM
12	2	ANGLE SUPPORT	ALUM
11	2	FLTR. STAMP	ALUM
10	1	ANGLE MOUNT (RIGHT)	ALUM
9	1	ANGLE MOUNT (LEFT)	ALUM
8	2	P.W. STAMP	ALUM
7	2	FLANGE (SMALL)	ALUM
6	1	CROSS SUPPORT	ALUM
5	4	CROSS SUPPORT	ALUM
4	2	12 HOLE PLTR. WHEEL	ASSY
3	1	SLIT ACCESSORY	ASSY
2	1	SLIT ACCESSORY	ASSY
1	1	SLIT AREA STRUCTURE	ST


NOTED

VIEW A-A

SCALE: NONE
 (SLIT ACCESSORY ASSY H1378
 REMOVED FOR CLARITY)

KECK/HIRES
 SLIT AREA STAGE MOUNTS
 ASSEMBLY

BOB 6/2/86
 CS 6/2/86
 H6756

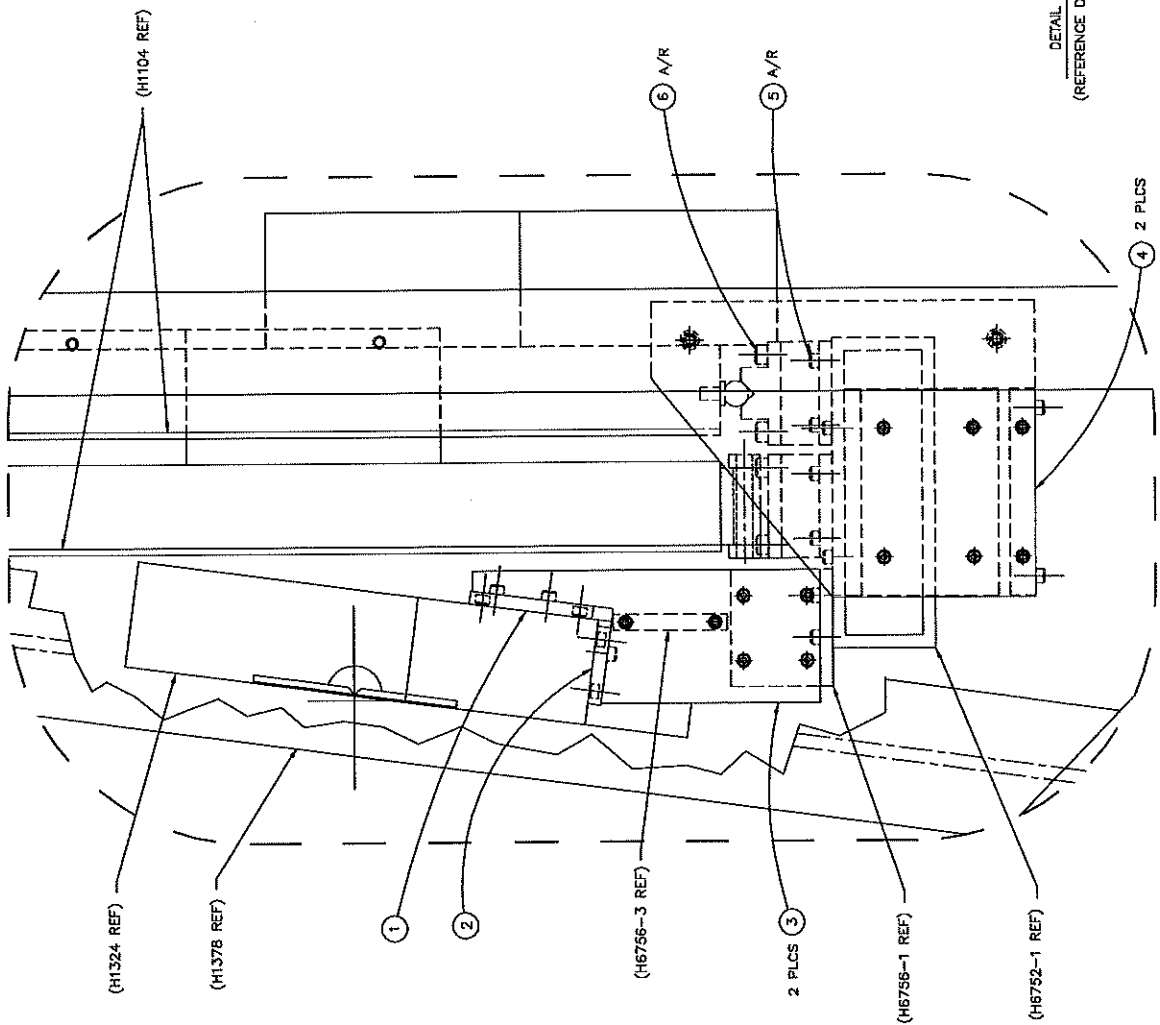

DETAIL **B**
 (REFERENCE DWG H6756)


FULL

6	A/R	SLIT AREA STAGE MOUNT	ALUM
5	A/R	SLIT AREA STAGE MOUNT	ALUM
4	3	SLIT SUPPORT	ALUM
3	2	SLIT SUPPORT	ALUM
2	1	MOUNT SUPPORT (SM)	ALUM
1	1	MOUNT SUPPORT (LG)	ALUM

KECK/HIRES
 SLIT AREA STAGE MOUNTS
 DETAILS
 BCB 8/7/88
 CS 9/9/88
 H6760

Appendix O List of Drawings — Shutter

1. H1203 Shutter and Filterwheel

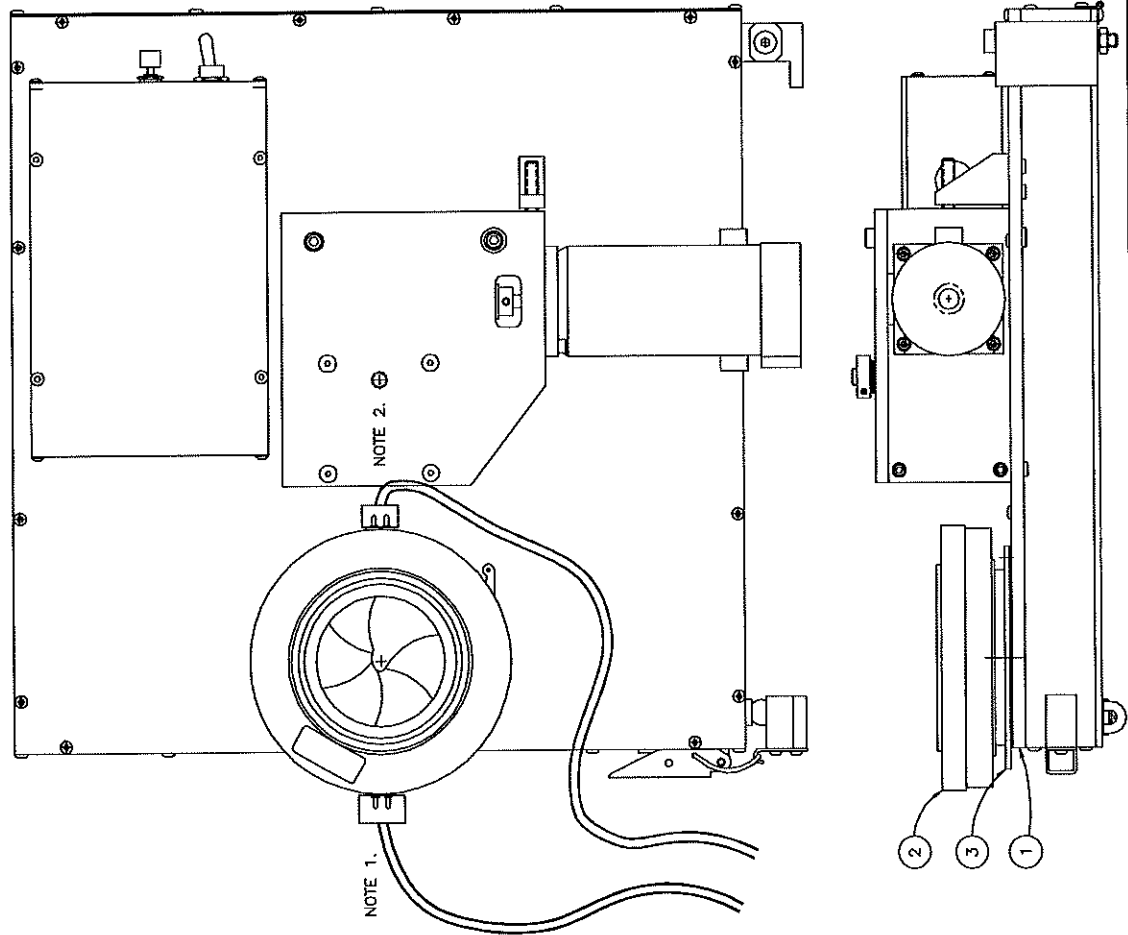

(1) SHUTTER
 1 REQ'D
 NOTES:
 1. ACTUATE SOLENOID.
 2. SENSE (REED SWITCH)

H1203-1	3	1	SHUTTER MOUNTING FLANGE ALUM
H1203-2	3	1	SHUTTER MOUNTING FLANGE ALUM
H1203-3	2	1	REED SWITCH
H1203-4	2	1	REED SWITCH

FULL
 A 15381 (S) LASER SOURCE AND ACTUATE MIRROR
 KECK/HIRES
 FILTERWHEEL W/ SHUTTER
 ASSEMBLY
 H1203.A
 DATE: 12 10 88
 DWA: 07 24 88

Appendix P List of Drawings — TV Autoguider

1. H1401 TV Cooling Assembly
2. H1406 TV Cooling Installation Details
3. P1003 HIRES GUIDER FORMAT
4. H8105 Lens Drive Assembly
5. H8119 Lens Drive Schematic
6. H8326 8-Position Filterwheel Assembly
7. H8325 Filterwheel
8. H1110 Filterwheel Drive Motor Assembly
9. H8001 TV Guider Assembly
10. H8002 TV Guider Mount Assembly




① T.V. COOLING ASSEMBLY

1 REQ'D

NOTE:

1. LYTRON INC.
DRAGON COURT
WOBURN, MA 01801
617-933-7300
2. WARD-BAGBY PLASTICS
1310 PIPER DR.
MILPITAS, CA
408-262-2111
3. WIRING & PLUMBING HOLES
LOCATED AS REQ'D.

15	4	NUT #6-32
14	1	CONTAINER
13	4	TUBE 1/2" RED
12	4	O-RING 1/2" ID
11	4	SS #16-13
10	1	CONDUCTIVE TAP
9	1	INSULATION
8	1	COOLANT FEEDER
7	1	GAUGE ELECTRONICS
6	1	MANIFOLD
5	1	CONVENER
4	4	LIP
3	6	BRACKET
2	2	SHELF
1	1	SHELF

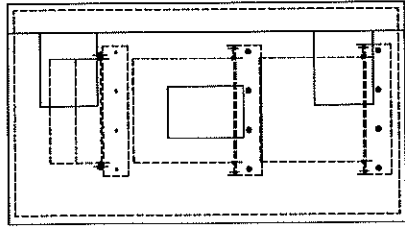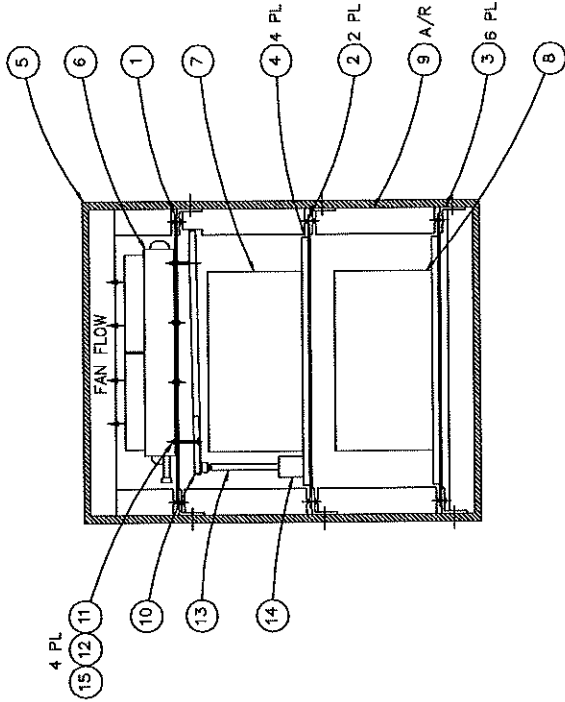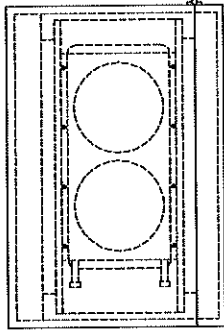





1/4

KECK/HIRES
T.V. COOLING
ASSEMBLY

REV. 12/79
CJA

H1401.A

A. PARTS LIST ADDED ITEMS 10-15

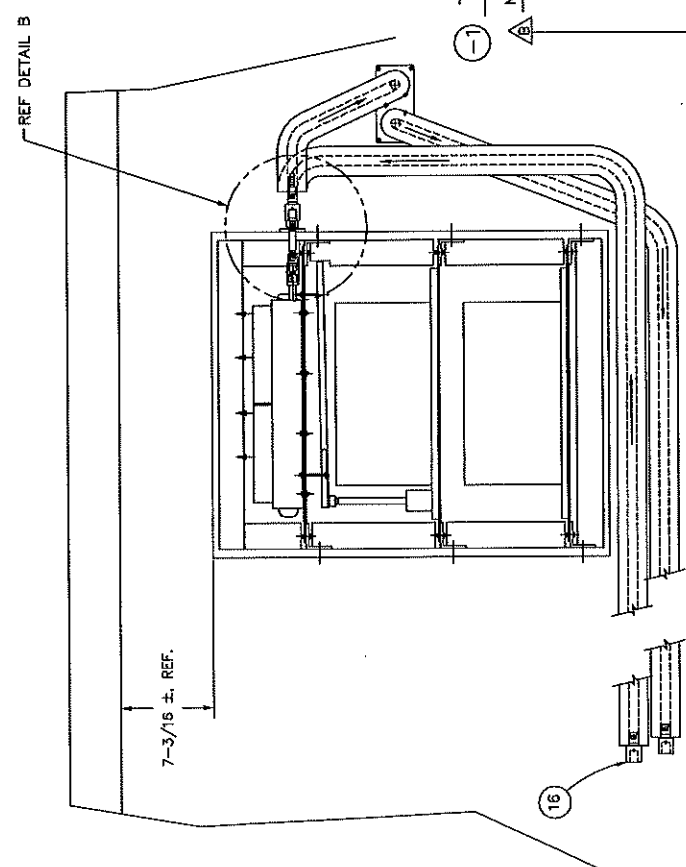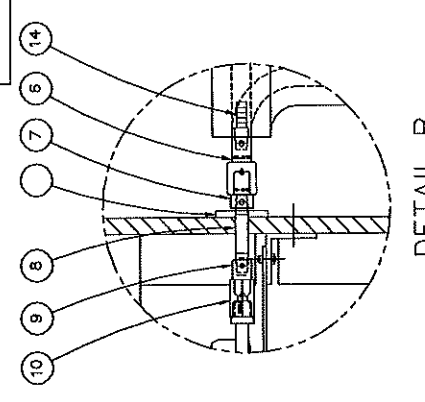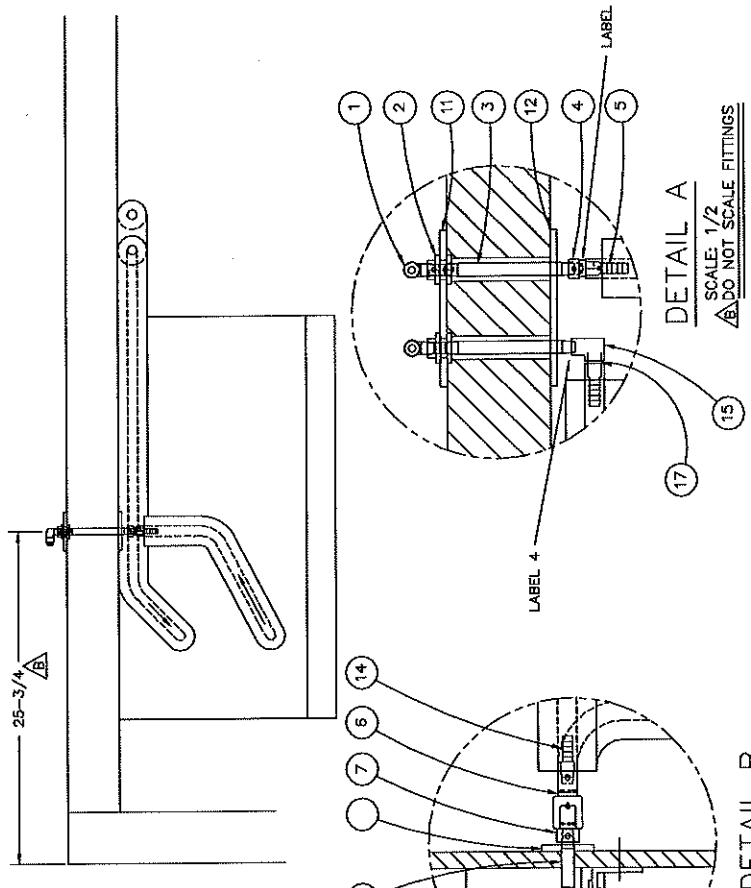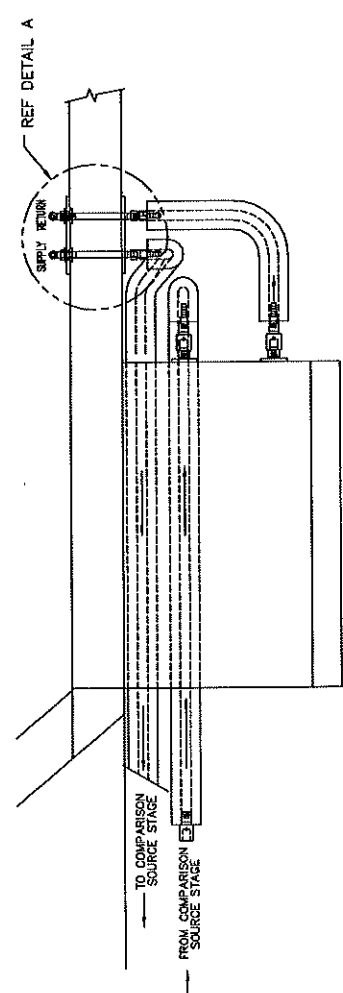

① T.V. COOLING INSTALLATION

NOTES: (ALL FITTINGS ARE BRASS)

1. PARKER BH3-60, FEMALE 3/8 NPT COUPLER
2. PARKER BH3-61, FEMALE 3/8 NPT NIPPLE
3. MCMASTER-CARR 456BK155, x 3" LONG
4. PARKER 46F-8-6, 3/8 NPT FEMALE TO 1/2 TUBE
5. PARKER 66DFHD-8, 1/2 FLARE UNION
6. PARKER 145HBLFSV-6-6, 3/8 HOSE BARB TO FEMALE SAE
7. PARKER 125HBL-6-6, HOSE BARB
8. PARKER 46F-8-6 (3/8 NPT TO 3/8 SAE)
9. MCMASTER-CARR 456BK159, 3/8 NIPPLE x 5" LONG
10. PARKER 207ACBH-6, 3/8 NPT TO 3/8 NPT, 1-14 THD O.D. x 1.31 LOA
11. COUPLINGS CO. 49-EEE (3/8 FLARE TO 3/8 NPT)
12. PARKER 2200P-6-6, 3/8 NPT 90° ELBOW


SEE H6440 FOR WALL LAYOUT DETAILS

1/4

A	UPDATE PER AS BUILT
B	REVISION
C	REVISION

KECK/HIRES
T.V. COOLING
INSTALLATION DETAILS
RCA 3/4/92
CAG 3/20/92
H1406.B

17	1	3/8 NPT NIPPLE	NOTE 1
16	2	COUPLER, BRASS	NOTE 1
15	1	ELBOW	NOTE 12
14	4	3/8" HOSE BARB	NOTE 7
13	2	FRESHTHRU PLATE	ALUM
12	1	FRESHTHRU PLATE	ALUM
11	1	FLARE UNION, 1/2"	NOTE 5
10	2	FEMALE CONNECTOR	NOTE 4
9	2	3/8 NIPPLE	NOTE 3
8	1	NIPPLE, OODK CONNECT	NOTE 2
7	1	HOSE BARB	NOTE 6
6	2	HOSE BARB	NOTE 6
5	1	FEMALE CONNECTOR	NOTE 6
4	1	3/8 NIPPLE	NOTE 9
3	1	ANCHOR COUPLING	NOTE 10
2	1	1" ELBOW	NOTE 11

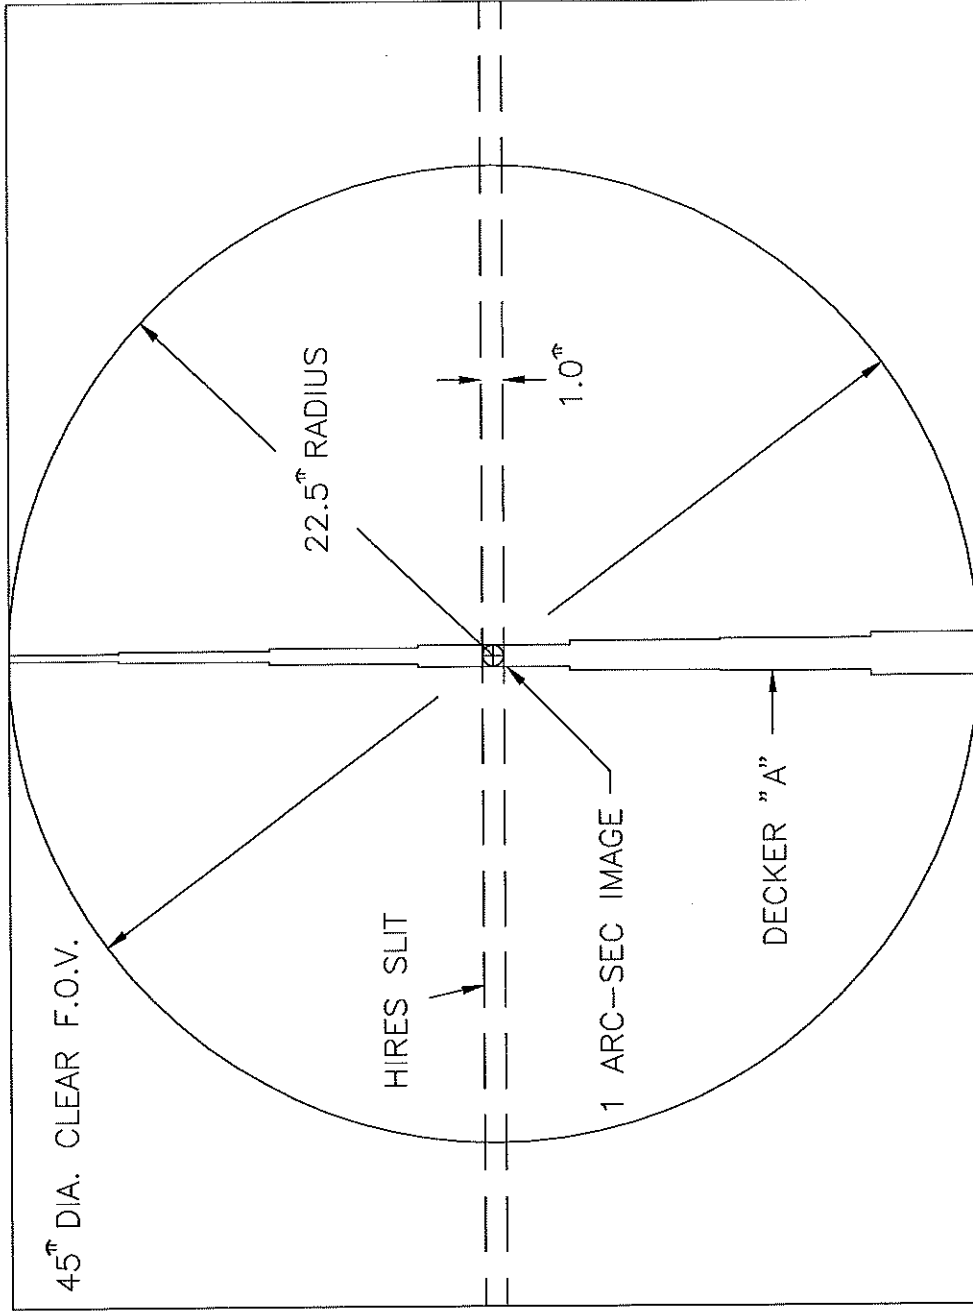

45" (288 PIXELS)


60" (384 PIXELS)

PHOTOMETRICS CH250 LC CAMERA HEAD
 THOMSON TH7883 CCD, 23μ PIXELS
 1.379"/mm AT SLIT
 6.78" +/- 0.26"/mm AT TV CCD
 0.156" +/- 0.006"/PIXEL

HIRES GUIDER FORMAT

POSITIONING OF LENS APERTURE AND FOCUS:


LENS DRIVES SHOWN 1/2 SCALE

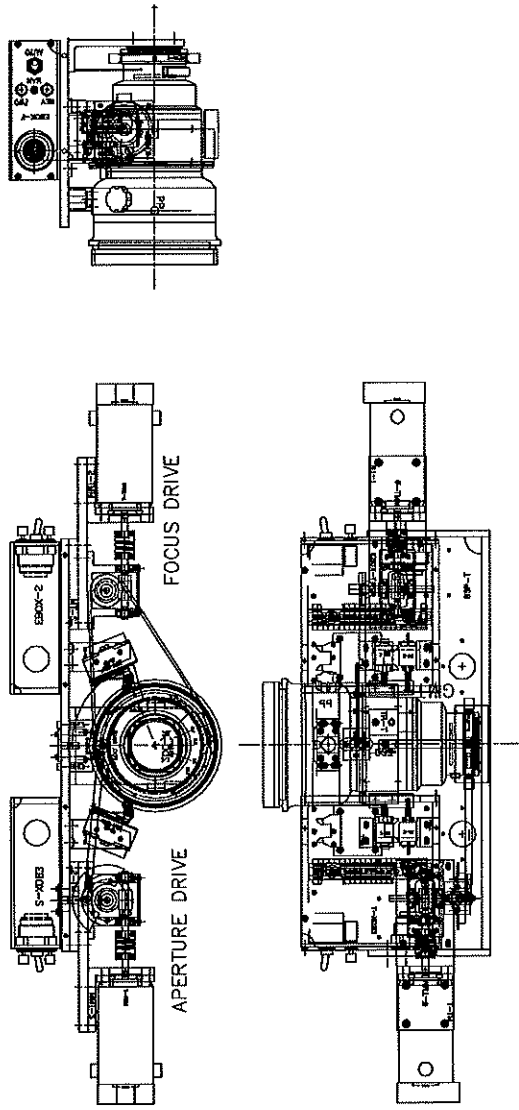

APERTURE DRIVE:
 MOTOR ENCODER 4000 CTS/REV
 GEAR BOX 60:1 REDUCTION
 BELL CRANK RADIUS 0.800
 LENS CRANK RADIUS 2.050
 APERTURE RING TRAVEL 46"
 CRANK ARM IS 6" LONG.

ONE REVOLUTION OF THE BELL CRANK RING WILL COVER THE FULL APERTURE RANGE FROM F/1.8 TO F/22. THE RATIO IS NOT LINEAR AND SETTINGS WILL COME FROM A LOOK-UP TABLE.


THE BELL CRANK DRIVE ALLOWS THE FULL RANGE OF APERTURE SETTINGS WITHOUT THE POSSIBILITY OF OVER-RUNNING THE BUILT-IN TRAVEL LIMITS.

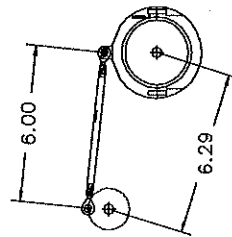

FOCUS DRIVE:
 MOTOR ENCODER 4000 CTS/REV
 GEAR BOX 60:1 REDUCTION
 TIMING BELT REDUCTION 72 T : 20 T (4.5863 P.D. TO 1.2732 P.D.) = 3.602:1
 FOCUS RING TRAVEL 136"

1 CT X 1 REV/4000 CTS X 1 REV OUT/60 REV IN X 1/3.6 X 360°/REV = 0.0004166°
 OR 0.0004166°/CT.
 OR 2400 CTS/DEG.

FOCUS RANGE IS XX TO INFINITY.
 FOCUS TRAVEL IS LIMITED BY HARDWARE AND SOFTWARE LIMIT SWITCHES.

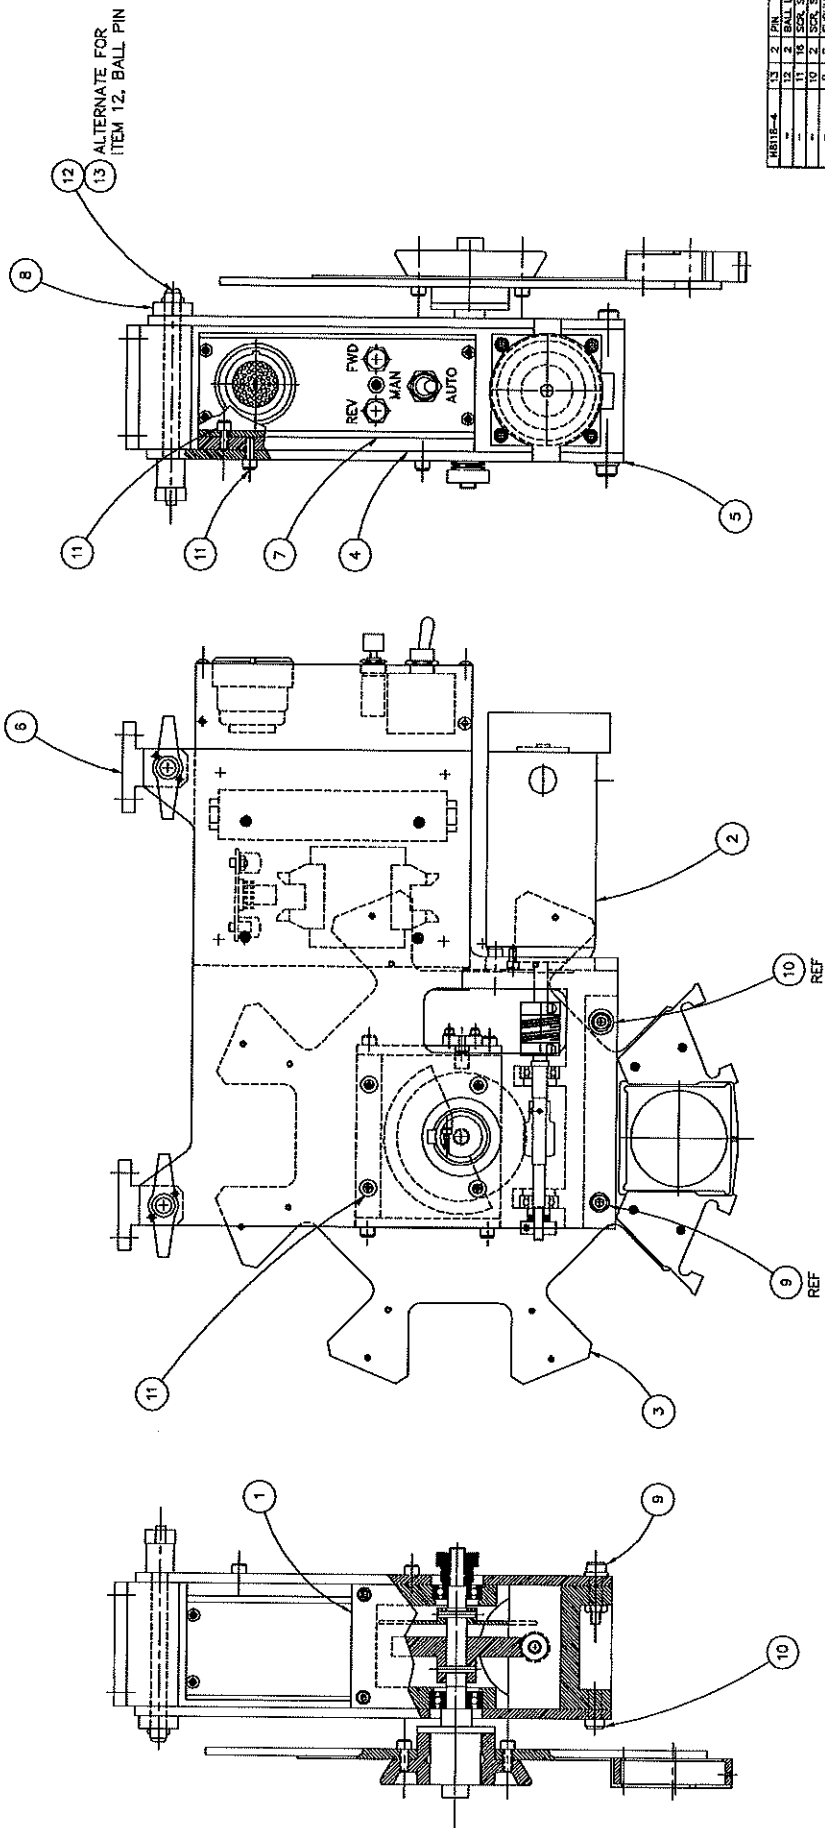

12 ALTERNATE FOR
13 ITEM 12. BALL PIN

QTY	PN	DESC	MA	QTY	EST
2	13	BALL PIN	8312	2	8312
2	14	SPACER	8312	2	8312
2	15	SPACER	8312	2	8312
2	16	SOCKET SCREW 1/4" X 28 UNF	8312	2	8312
2	17	SHOULDER SCREW 1/4" X 28 UNF	8312	2	8312
2	18	SPACER	8312	2	8312
2	19	SPACER	8312	2	8312
2	20	SPACER	8312	2	8312
2	100	SPACER	8312	2	8312



1 FILTER WHEEL ASSEMBLY
2 REQ'D

FULL

B M/R/DAD1 ASSEMBLY AS ALTERNATE

KECK/HIRES
FILTERWHEEL, 8 HOLE
ASSEMBLY

MAA 50946
CAA 10076
H8326.B

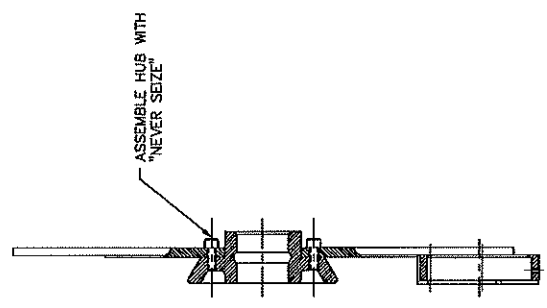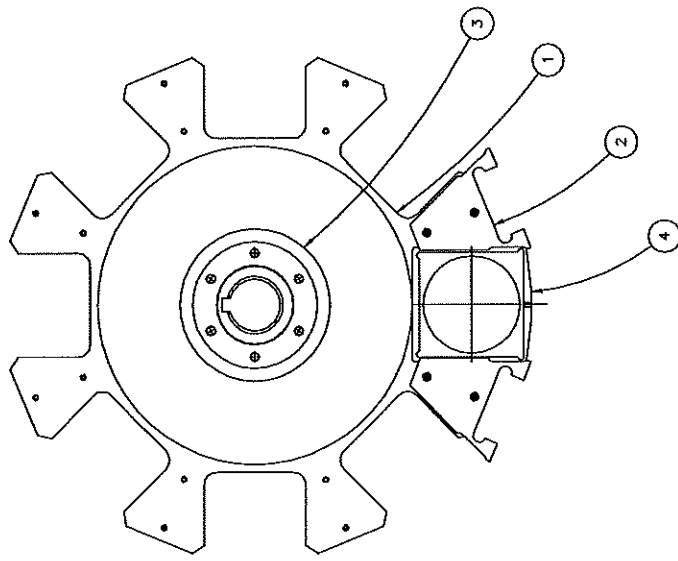



① FILTER WHEEL SUB-ASSEMBLY

2 REQ'D

PR172-2	4	0	FILTER HOLDER	ALUM
H8325-1	3	1	HUB	ALUM
H8325-2	2	0	SCREW	ALUM
H8325-3	1	1	WASHER	ALUM

FULL

KECK/HIRES
 FILTERWHEEL, 8 HOLE
 SUB-ASSEMBLY
 P.C.A. 10/20/66
 D.C.L. 10/20/66
 H8325

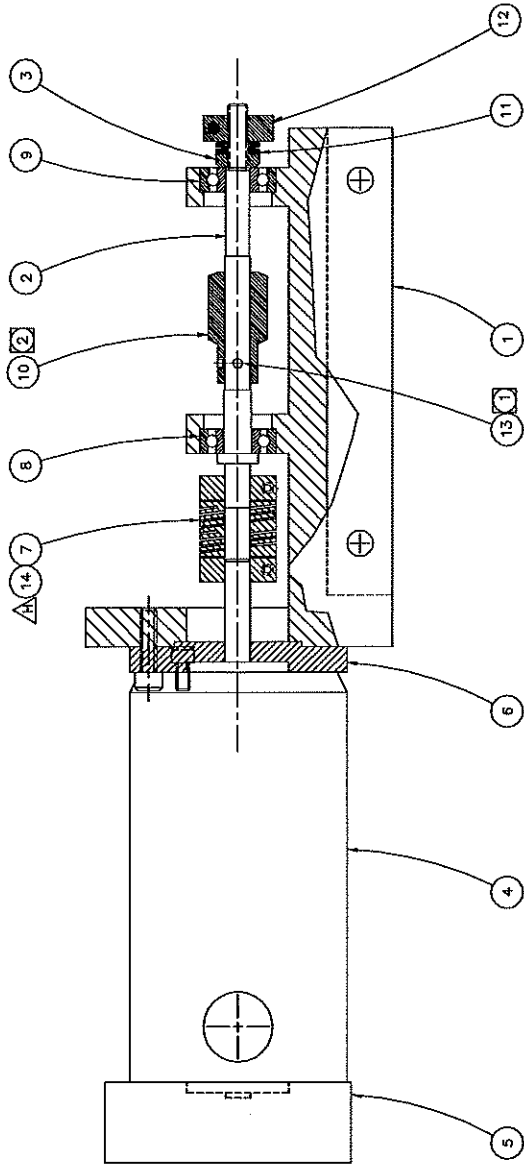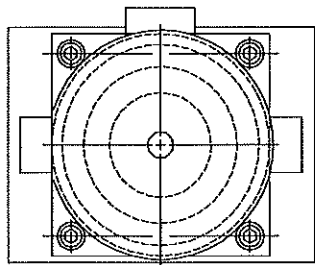

① WORM DRIVE ASSY

1 RECD

NOTES:




- ① PIN GEAR IN PLACE AFTER ASSEMBLY AND ALIGNMENT.
- ② LUBRICATE WITH NYEGEL GALL #50/100. SEE HZ623-1
- ③ HEWLETT-PACKARD HEDS-6000 SERIES
- ④ BERG #CO41S-1 WITH KEYWAY ADDED
- ⑤ SKF #607-2RS
- ⑥ SKF #626-2RS
- ⑦ BERG #W24S-4D
- ⑧ BELLEVILLE SPRING WASHER #B0437-016-S

14	2	1/16 KEY	SST
13	1	SPRING PIN, 1/16 X 1/16 L	SST
12	1	COLLAR CLAMP	
11	4	SPRING WASHERS	NOTE 2
10	4	SPRING WASHERS	NOTE 2
9	1	BALL BEARING	NOTE 5
8	1	BALL BEARING	NOTE 5
7	1	COUPLING, MODIFIED	NOTE 3
6	1	BEARING HOUSING	NOTE 2
5	1	BEARING HOUSING	NOTE 2
4	1	MOTOR	NOTE 1
3	1	SPACER	SST
2	1	SPACER	SST
1	1	WORM DRIVE	ALUM

2/1

KECK/HIRES
 FILTERWHEEL, 12 HOLE
 WORM DRIVE ASSY
 BGR 12/29/88
 CAA 1/2/89
 H1110.G

H 1338 16	MAKE NOTES MORE IN PARTS LIST	DESIGN REVIEW UPDATE
	ADD DESIGN TO COMPANYS 1/18/89	
B	ENR Dwg	
C	ENR Dwg	
D	ENR Dwg	
E	ENR Dwg	
F	ENR Dwg	
G	ENR Dwg	

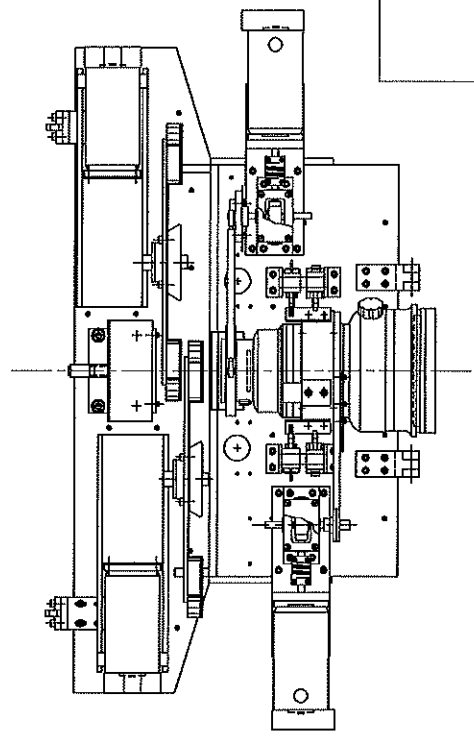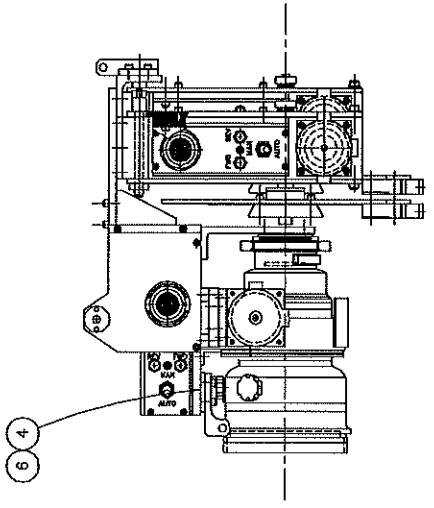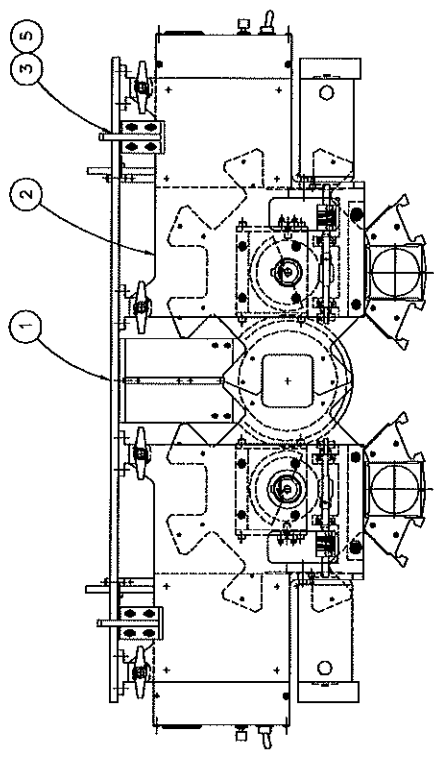

① T.V. GUIDER ASSEMBLY

H8000-1	3	CLEANS SPACERS	ALUM
H8000-2	3	PRINT	ALUM
H8000-3	4	CLEANS	ALUM
H8000-4	3	ANGLE BRACKET	ALUM
H8000-5	2	1/8 HOLE FILTERMESH ASST	ALUM
H8000-6	1	1/8 HOLES DRIVE ASSEMBLY	

1/2


KECK/HIRES
T.V. GUIDER
ASSEMBLY

REV. 01/72
CAL. 01/72
H8001

Appendix Q List of Drawings — Comparison Source System

1. H1620 Comparison Source Stage Assembly
2. H1622 Stage Schematic
3. H1618 Comp. Source Stage Mounting Surface Layout
4. H1688 Enclosure Assembly
5. H1701 Comp. Source Stage Filterwheel Assembly
6. H1706 Comp. Source Stage Filterwheel Mounting
7. H1655 Comp. Source Optics (Epps 3940)
8. H1657 Comp. Source Optics Stop Layout
9. H1812 Comp. Source Optics 2" Lens Cell Mount
10. H1816 Comp. Source Optics 6" Lens Cell Mount
11. H1814 Comp. Source Optics 6" Flat Mirror Mount

CALIBRATION SOURCE STAGE SHOWN 1/4 SCALE

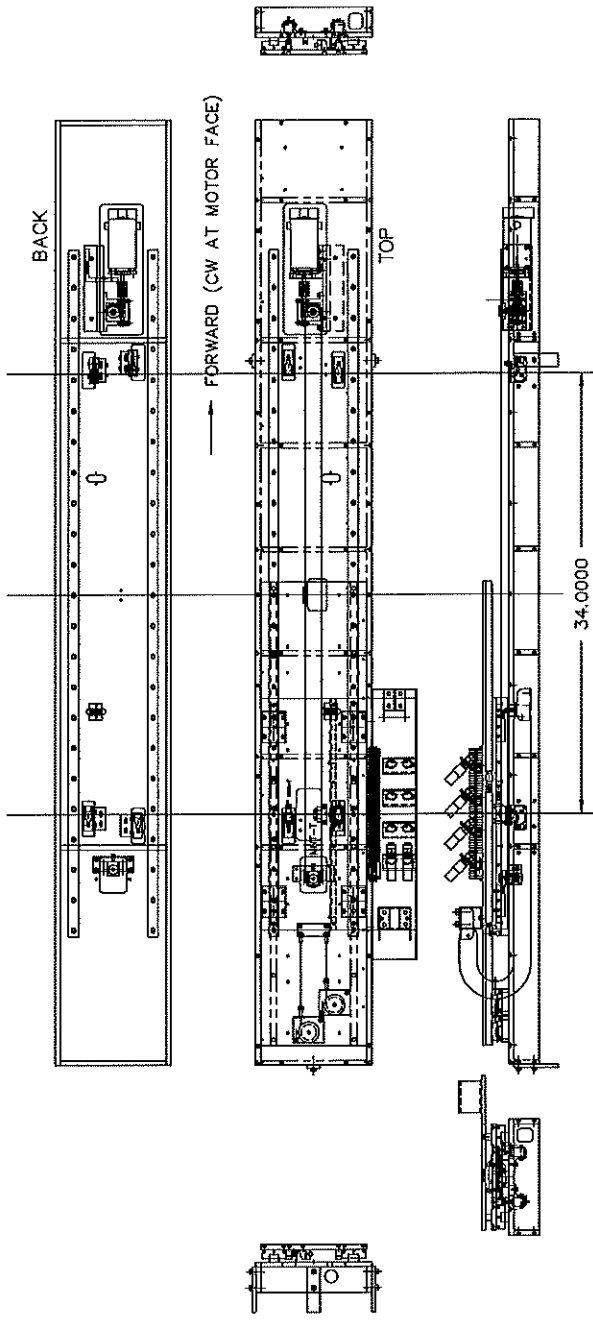

THEORETICAL POSITIONING RESOLUTION:
 MOTOR ENCODER 4000 CTS/REV
 GEAR BOX 60:1 REDUCTION
 DRIVE GEAR PITCH RADIUS 0.6366


1 CT. X 1 REV/4000 CT X 1 REV OUT/60 REV IN X $2(\pi)(0.6366) = 0.000016666$ INCH
 OR 0.000016666 INCH/CT
 OR @ 60,000 CT/INCH

IF SERVO LOOP IS GOOD TO 2 COUNTS,
 RESOLUTION IS 0.00003333 INCHES.

RESOLUTION AND REPEATABILITY HAVE BEEN TESTED MECHANICALLY TO 0.0005 INCHES.

TOTAL TRAVEL IS 34 INCHES. MOUNTING PLATFORM IS 8" X 36".
 MOUNTING PLATFORM HOLE PATTERN IS ON H1618, 6 SETS OF 4" X 4" #8-32 HOLES
 H1620 SHOWS STAGE WITH INTEGRATING SPHERES AND HOLLOW CATHODES INSTALLED.

KECK/HIRES
 COMP. SOURCES STAGE
 DATA AND GEAR REDUCTION
 SCALE 1/4"=1"
 H1622



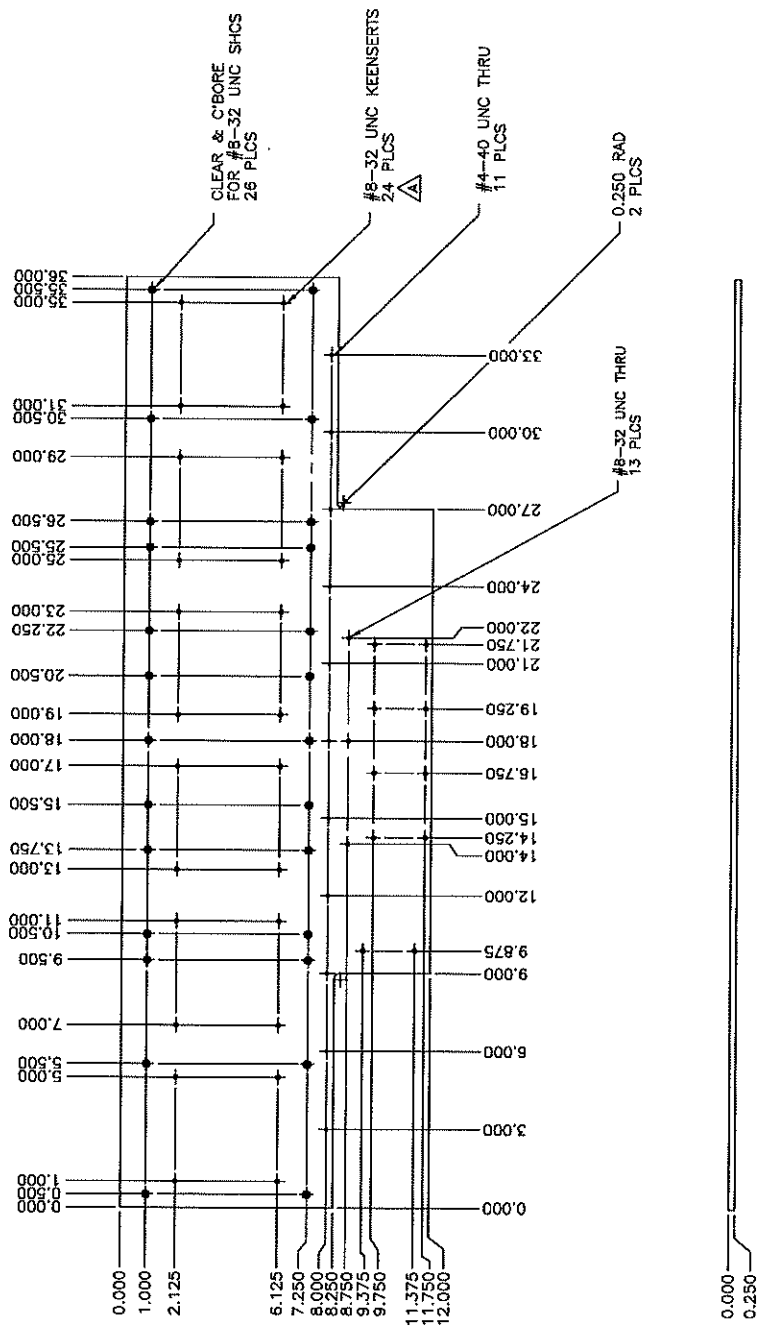


(-) MOUNTING PLATE
 1 REQ'D
 ALUM., 6061-T651 TOOLING PLATE
 BLACK ANODIZE
 FINISH: \triangle

1/2

A	FORM C/D	FOR KEENSERTS WIRE THD HOLES
B	FORM C/E	FOR GENERAL OPERATING

KECK/HIRES
 COMP. SOURCE STAGE
 SOURCE MOUNT L/O
 DATE: 7-19-80
 C.A.: T/AVP
 H1618.B

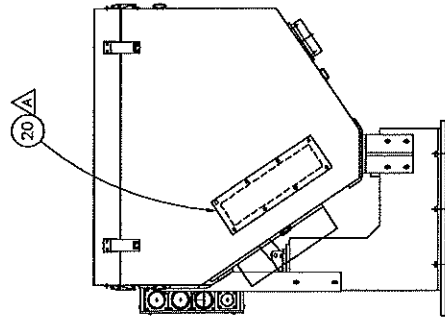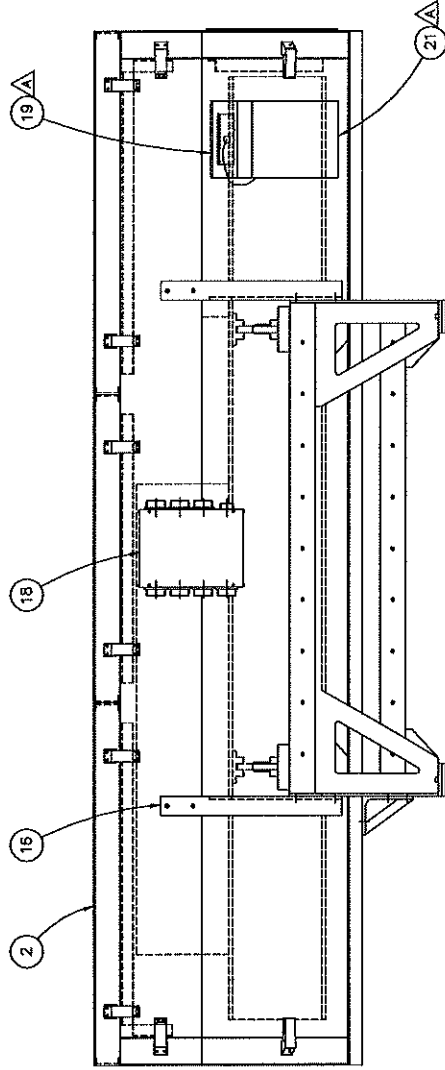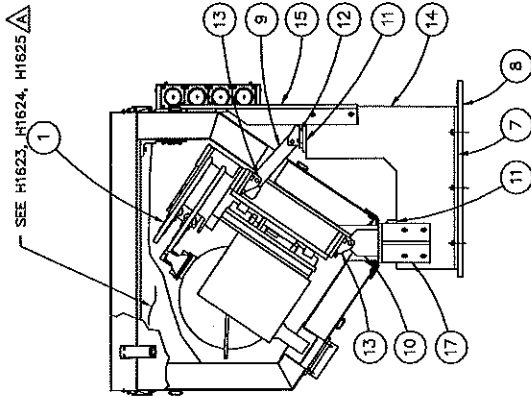


▲	H1616-1	21	1	JUNCTION BOX	ASSY
▲	H1616-2	21	1	JUNCTION BOX	ASSY
▲	H1623	19	1	BRACKET	ALUM
▲	H1624	19	1	BRACKET	ALUM
▲	H1625	19	1	BRACKET	ALUM
▲	H1626	19	1	BRACKET	ALUM
▲	H1627	17	2	BRACKET	ALUM
▲	H1628	18	1	BRACKET	ALUM
▲	H1629	18	1	BRACKET	ALUM
▲	H1630	14	1	BRACKET	STEEL
▲	H1631	13	4	BRACKET	ALUM
▲	H1632	12	2	BRACKET	ALUM
▲	H1633	11	4	BRACKET	ALUM
▲	H1634	10	2	BRACKET	ALUM
▲	H1635	9	2	BRACKET	ALUM
▲	H1636	8	2	BRACKET	ALUM
▲	H1637	7	2	BRACKET	ALUM
▲	H1638	6	2	BRACKET	ALUM
▲	H1639	5	2	BRACKET	ALUM
▲	H1640	4	2	BRACKET	ALUM
▲	H1641	3	2	BRACKET	ALUM
▲	H1642	2	2	BRACKET	ALUM
▲	H1643	1	1	BRACKET	ALUM
▲	H1644	1	1	BRACKET	ALUM
▲	H1645	1	1	BRACKET	ALUM
▲	H1700	1	1	BRACKET	ALUM

① COMPARISON SOURCE STAGE/ENCLOSURE ASSEMBLY

1/4

A. H. H. S. I. Co. | LOCK ELECTRONICS DIV. AND. 5000A.






KECK/HIRES
 COMPARISON SOURCE STAGE
 STAGE/ENCLOSURE ASSY
 H1688.A
 M.C.A. 1/1/72
 C.A.E. 1/1/72

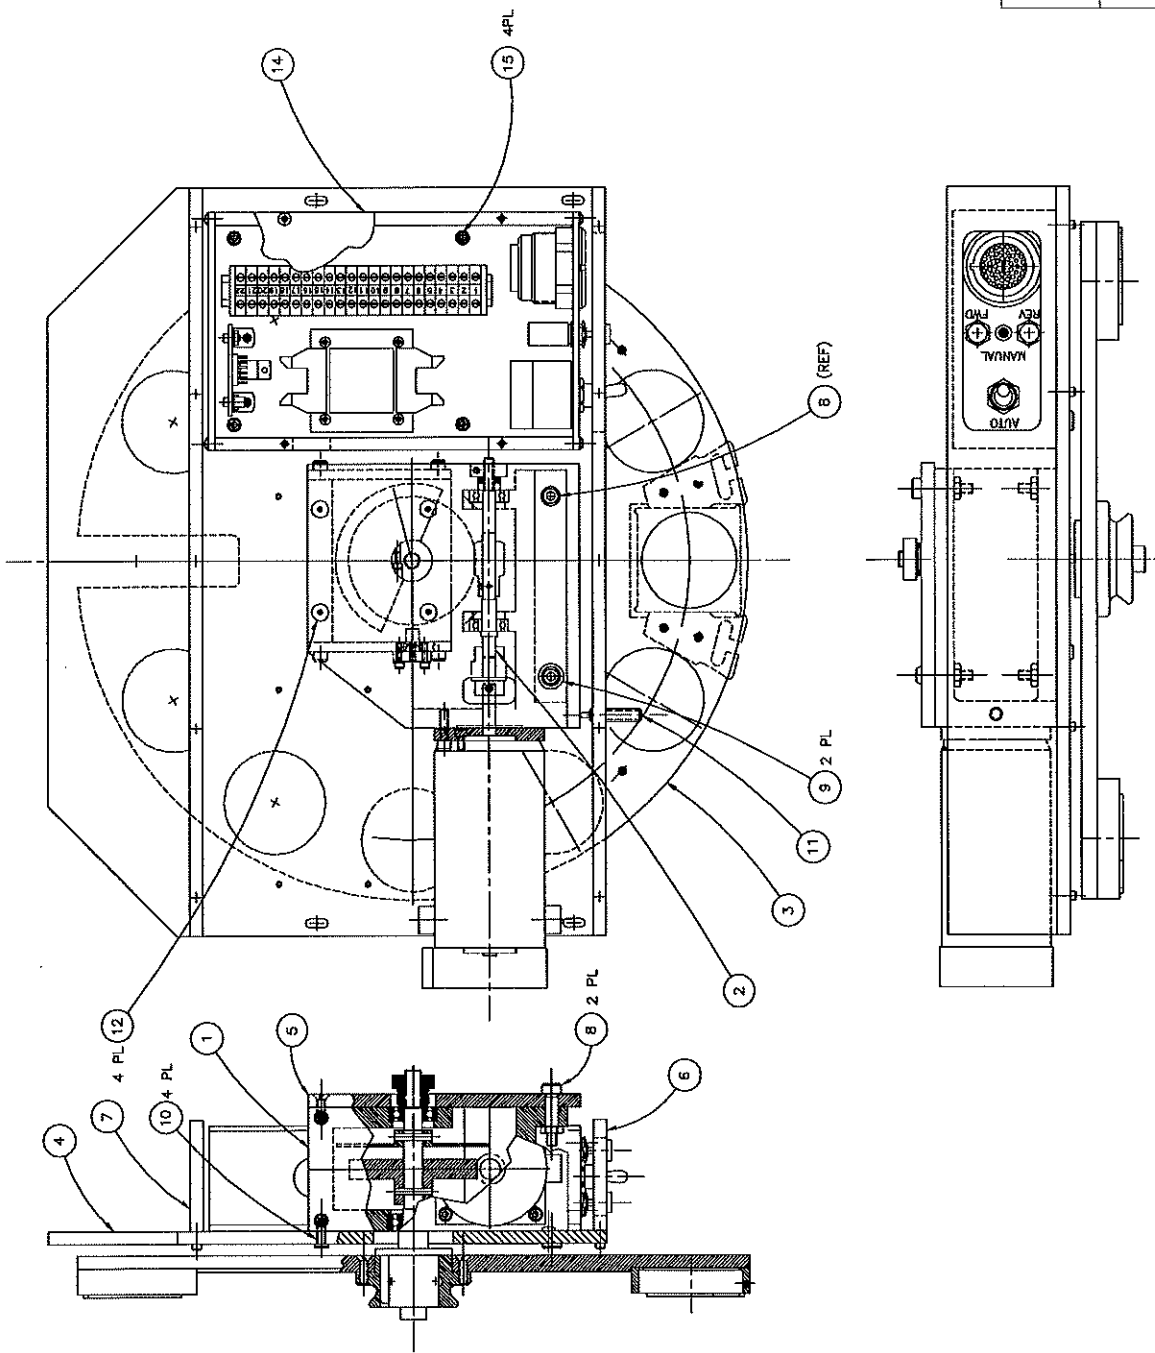

12	4	SCR. SHCS. 4-20 UNC X 3/8 LG
H1138-1	14	1 JUNCTION BOX ASSY
	13	10 SCR. SHCS. 4-20 UNC X 3/8 LG
	12	4 SCR. FLNGS. 8-20 UNC X 3/8 LG
	11	1 WDR. PLUNGER
	10	1 SCR. LOCKS. 4-20 UNC X 3/8 LG
	9	2 SCR. LOCKS. 4-20 UNC X 3/8 LG
	8	2 SHOULDER SCREWS 1/2 DIA X 3/8 LG
H1703-2	7	1 SIDE PLATE
H1703-1	6	1 SIDE PLATE
H1703-2	4	1 MOUNTING BRACKET
H1703-1	3	1 MOUNTING BRACKET
H1110-1	2	1 WORM DRIVE ASSY
H1109-1	1	1 HUB & AXLE ASSY


FULL
 A. 1/23/81 L. 1. UPDATE
 KECK/HIRES
 COMPARISON SOURCE STAGE
 FILTERWHEEL ASSY
 H1701.A
 RGR 8/1/81
 CAA 8/18/81

OUTER APERTURE RING
0.0313 ALUM
BLACK ANODIZE

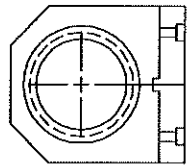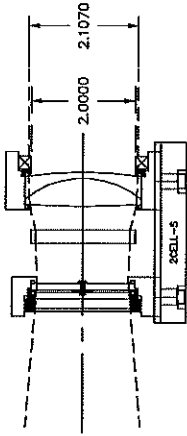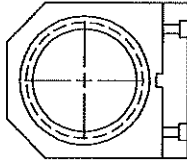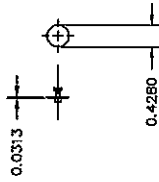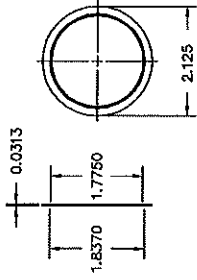

⊖1 DETAIL OF STOP


1 RECD

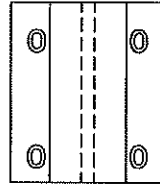


FULL

KECK/HIRES
COMP. SOURCE OPTICS
STOP L/O
DATE 02/78
H1657.B

DATE	BY	CHKD	APP'D
1981	KECK	HIRE	HIRES
DRAWN BY KECK/HIRES			
CHECKED BY KECK/HIRES			
APPROVED BY KECK/HIRES			
CHANGE A IS UNKNOWN			

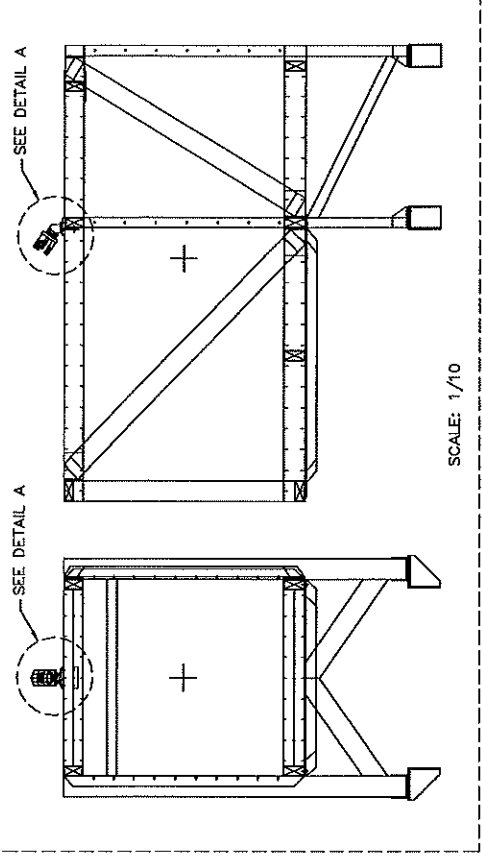

SCALE: 1/10

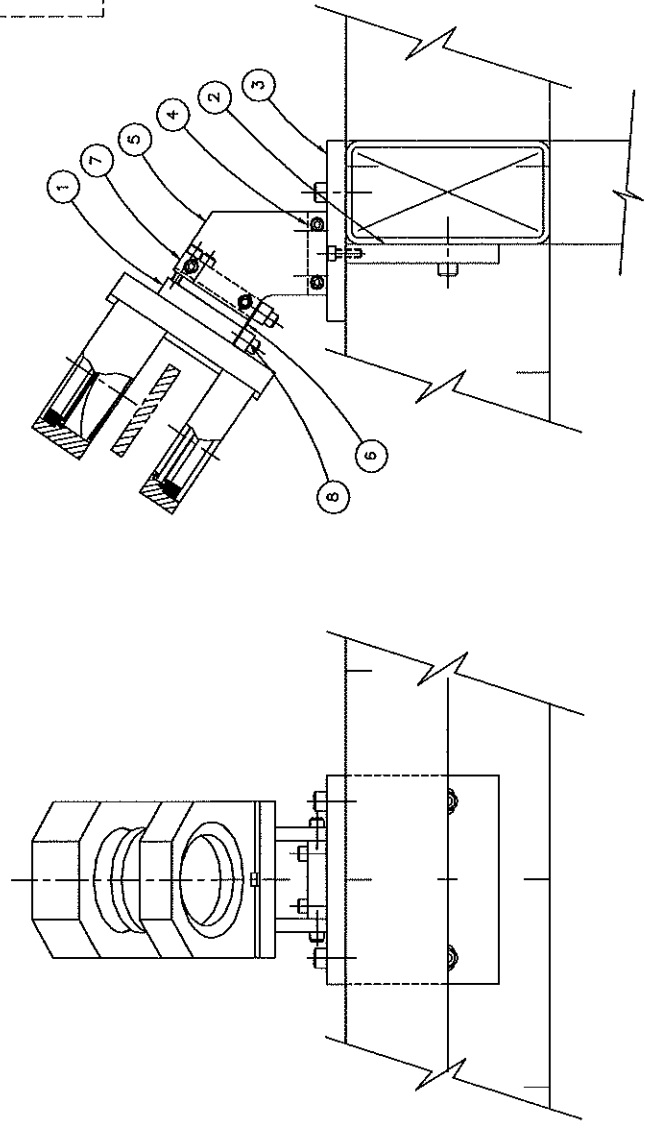

① 2" LENS CELL MOUNT ASSY
1 RECD


HT800-3	8	2	CLAMP	ALUM
HT800-2	7	1	MOUNT LOWER	ALUM
HT800-1	6	1	SPRING	STEEL
HT800-5	4	1	SPRING	ALUM
HT800-3	4	1	SPRING	ALUM
HT800-2	3	1	MOUNTING PLATE	ALUM
HT800-1	2	1	MOUNTING PLATE	ALUM
HT800-1	1	1	2" LENS CELL ASSY	ALUM

DETAIL A
SCALE: FULL


NOTED

KECK/HIRES
CALIBRATION OPTICS
2" LENS CELL MOUNT ASSY
REA 5/1/91
CAA 5/1/92
HT812

30.00 REF

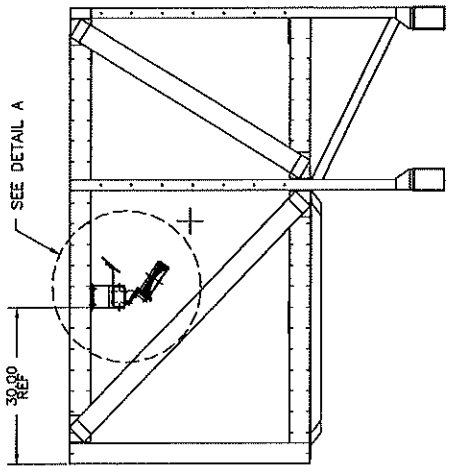


SCALE: 1/10

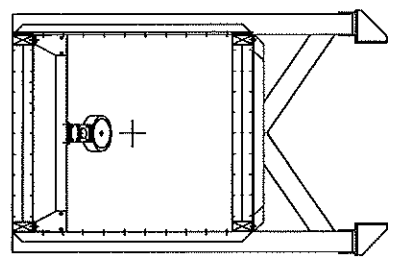

① 6" LENS CELL MOUNT ASSY

1 REQ'D


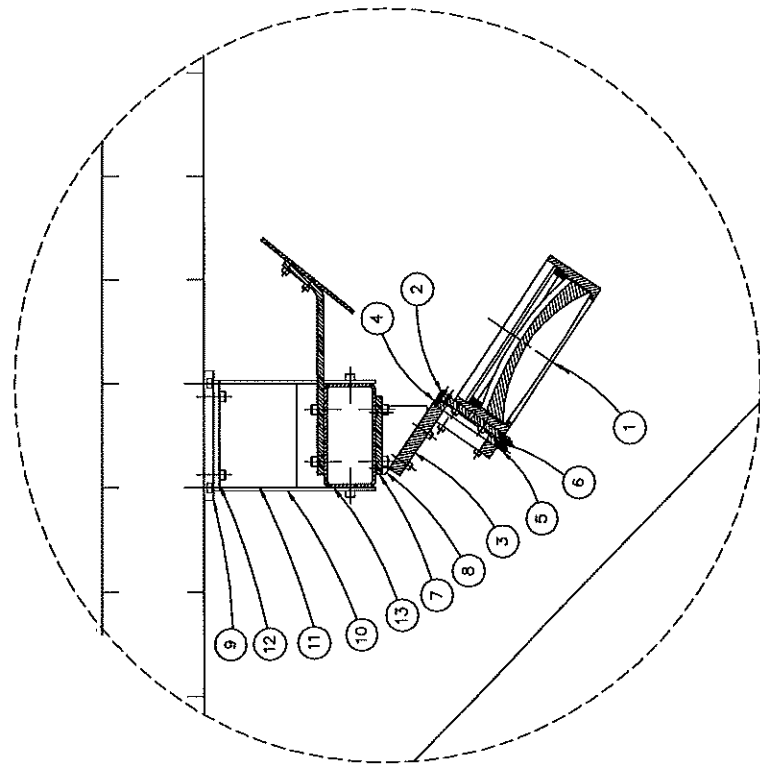


DETAIL A
SCALE: 1/2

H1877A-1	13	1	MOUNTING TUBE	STEEL	H1870-1	7	1	MOUNTING PLATE	ALUM
H1877A-2	14	1	SPRING	STEEL	H1870-2	8	1	SPRING	STEEL
H1877B-1	15	4	SOLE PLATE	STEEL	H1870-3	9	1	MOUNT UPPER	ALUM
H1877B-2	16	2	BACK PLATE	STEEL	H1870-4	10	2	BRACKET	ALUM
H1877C-1	17	2	MOUNTING PLATE	STEEL	H1870-5	11	1	MOUNT LOWER	ALUM
H1877C-2	18	2	MOUNTING PLATE	ALUM	H1870-6	12	1	6" LENS CELL ASSY	ALUM

1/4

KECK/HIRES
CALIBRATION OPTICS
6" LENS CELL MOUNT ASSY
ECL 8/1/81
CAL 5/1/82
H1816

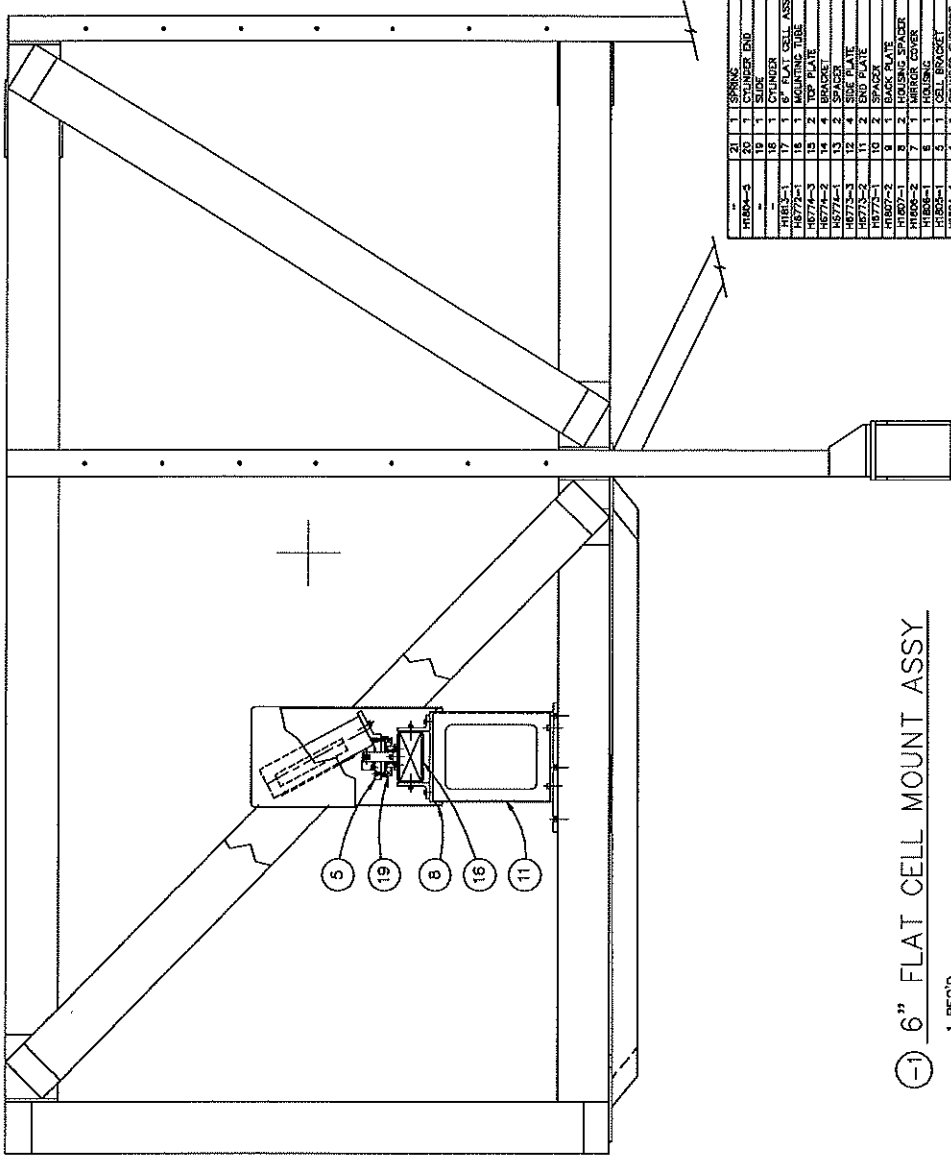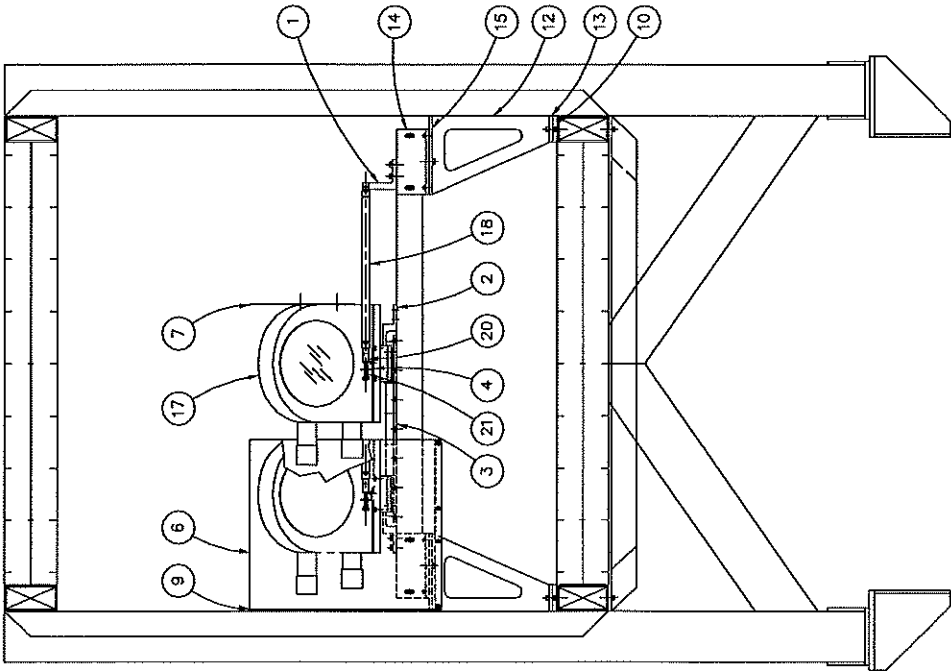

① 6" FLAT CELL MOUNT ASSY

1 REQ'D

ITEM NO.	QTY	DESCRIPTION	MATERIAL
H1804-5	21	SPACERS	STEEL
H1804-6	20	CYLINDER END	STEEL
H1804-7	19	SLIDE	STEEL
H1804-8	18	CYLINDER	STEEL
H1804-9	17	6" FLAT CELL ASSY	STEEL
H1804-10	16	FRONT TUBE	STEEL
H1804-11	15	TOP PLATE	ALUM
H1804-12	14	BRACKET	ALUM
H1804-13	13	SPACER	STEEL
H1804-14	12	SLIP PLATE	STEEL
H1804-15	11	SLIP PLATE	STEEL
H1804-16	10	SPACER	STEEL
H1804-17	9	BACK PLATE	ALUM
H1804-18	8	HOUSING SPACER	ALUM
H1804-19	7	BRACKET COVER	ALUM
H1804-20	6	CELL BRACKET	ALUM
H1804-21	5	CYLINDER SUPPORT	ALUM
H1804-22	4	SPACER	STEEL
H1804-23	3	STOP	ALUM
H1804-24	2	STOP	ALUM
H1804-25	1	CYLINDER BRACKET	ALUM

1/4

1/4
 X 1/4 INCH GRID | ANNOT. ITEMS 20 & 21

KECK/HIRES
 CALIBRATION OPTICS
 6" FLAT CELL MOUNT ASSY
 H1814.A
 EGA 5/1/91
 CAC 5/1/91


Appendix R List of Drawings — Iodine Cell Stage

1. H1955 Iodine Cell Server Assembly

Appendix S List of Drawings — Slit Area Collimation


Appendix T List of Drawings — Instrument Cooling System

1. H1423 Comparison Source Stage Cooling Details
2. H1406 TV Cooling Details
3. H1411 Vault Cooling Details
4. H1432 Cooling System Control Panel
5. H1450 Cooling System Installation
6. H1462 CCD Electronics Cooling
7. H1463 CCD Cooling Installation Details

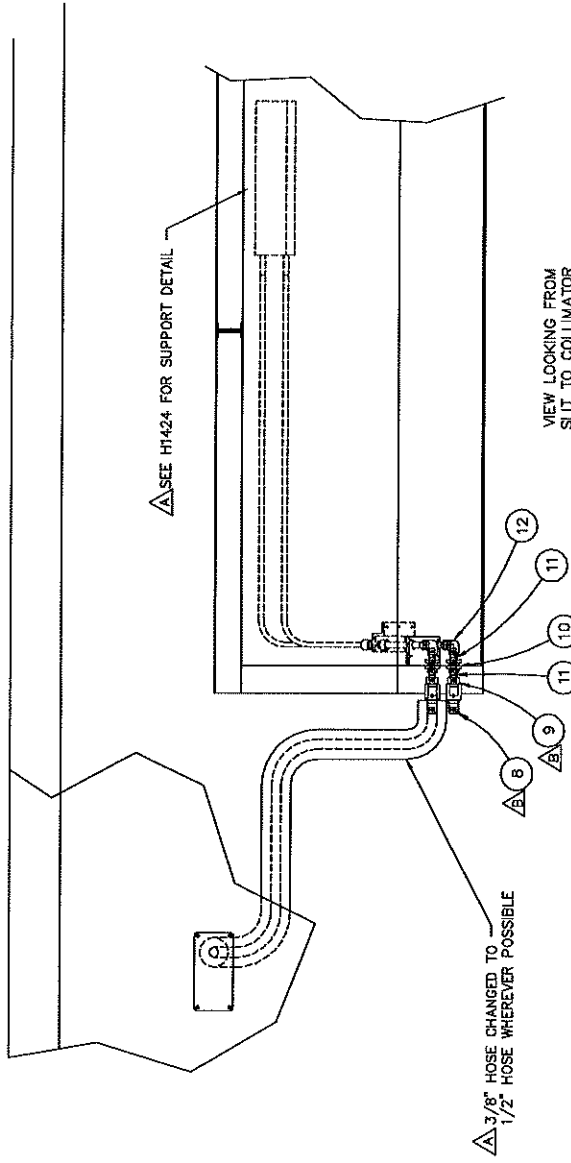

(-1) COOLING SYSTEM




- 1 REQ'D
 NOTES:
 1. PARKER 46F-6-4
 2. MCMASTER-CARR 4568F139
 3. COMAIR-ROTRON FS24B3/031157
 4. PARKER 48F-8-4
 5. SWAGELOCK SS-800-71-4
 6. MCMASTER-CARR 4568K137
 7. PARKER 2200P-4-4
 8. MCMASTER-CARR 4568K131
 9. PARKER 207ACBHS-4
 10. PARKER BH3-51
 11. PARKER BH3-50

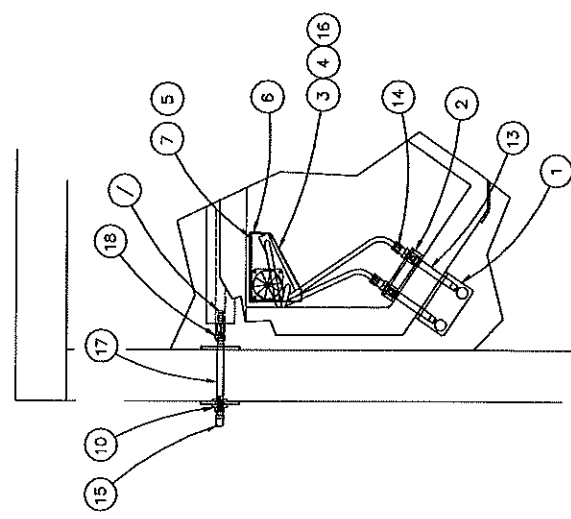


19	1	HOSE BARB	NOTE 11
18	1	FEMALE CONN	NOTE 2
17	1	NIPPLE, 5" LS	NOTE 2
16	2	FAN COUPLING	NOTE 2
15	2	BRACKET	NOTE 2
14	2	BRACKET	NOTE 2
13	2	NIPPLE, 1/2" LS	NOTE 2
12	2	ELBOW, 1/2" LS	NOTE 2
11	2	NIPPLE, 1/2" LS	NOTE 2
10	2	NIPPLE, 1/2" LS	NOTE 2
9	2	NIPPLE, 1/2" LS	NOTE 2
8	2	COUPLING, 1/2" LS	NOTE 11
7	1	COVER	ALUM
6	2	BRACKET	ALUM
5	2	BRACKET	ALUM
4	2	FAN MOUNTING PLATE	ALUM
3	1	FAN	ALUM
2	1	BRACKET	ALUM
1	1	BRACKET	ALUM

1/4

ADD NOTE, CROSS-BUILD, WORK NOTES, ETC.
 1/2" SLEEVES
 1/2" SLEEVES, ETC.

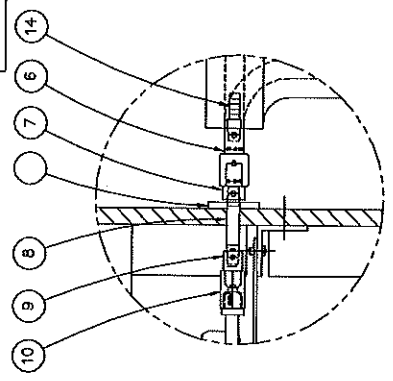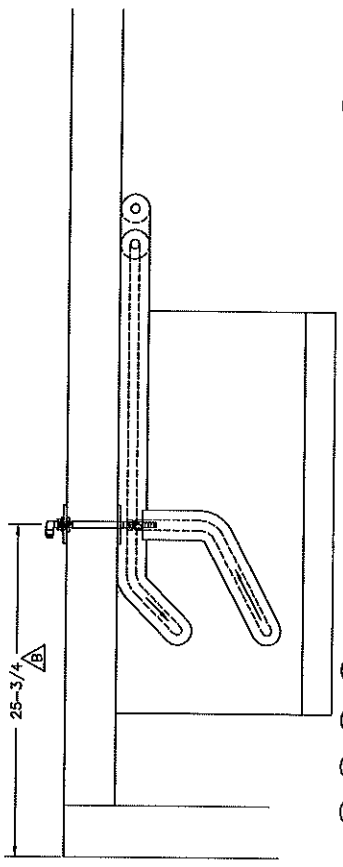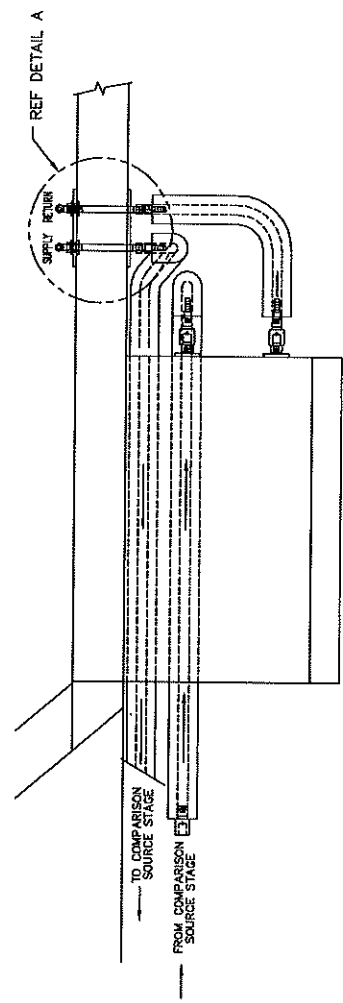

DETAIL A
SCALE: 1/2
A, DO NOT SCALE FITTINGS

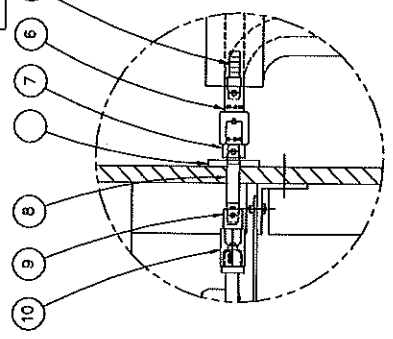

DETAIL B
SCALE: 1/2

1 T.V. COOLING INSTALLATION

NOTES: (ALL FITTINGS ARE BRASS)

1. PARKER BH3-60, FEMALE 3/8 NPT COUPLER
2. PARKER BH3-61, FEMALE 3/8 NPT NIPPLE
3. MCMASTER-CARR 4568K155, x 3" LONG
4. PARKER 46F-8-6, 3/8 NPT FEMALE TO 1/2 TUBE
5. PARKER 660FH-8, 1/2 FLARE UNION
6. PARKER 146HBL-6-5, 3/8 HOSE BARB TO FEMALE SAE
7. PARKER 123HBL-6-6, HOSE BARB
8. PARKER 46F-6-6 (3/8 NPT TO 3/8 SAE)
9. MCMASTER-CARR 4568K159, 3/8 NIPPLE x 5" LONG
10. PARKER 207ACBH-6, 3/8 NPT TO 3/8 NPT, 1-14 THD O.D. x 1.31 LOA
11. COUPLINGS CO. 49-EEE (3/8 NPT TO 3/8 NPT)
12. PARKER 2200P-6-5, 3/8 NPT 90° ELBOW

SEE H6440 FOR WALL LAYOUT DETAILS



1/4

A.	RATINGS	AS BUILT
B.	1/2" DIA.	UPDATE PER AS BUILT
		MOORE NOTES, HOSE WAS 1/2"

KECK/HIRES
T.V. COOLING
INSTALLATION DETAILS
REV. 3/78
P.L.S. 3/78

H1406.B

17	1/2" NIPPLE	BRASS	NOTE 1
18	COUPLER	ALUM	NOTE 12
19	ELBOW	ALUM	NOTE 7
20	3/8" HOSE BARB	ALUM	NOTE 7
21	FREEDRIFT PLATE	ALUM	NOTE 7
22	FREEDRIFT PLATE	ALUM	NOTE 7
23	FLARE UNION 1/2"	ALUM	NOTE 5
24	FEMALE CONNECTOR	ALUM	NOTE 3
25	3/8 NIPPLE	ALUM	NOTE 7
26	COUPLER	ALUM	NOTE 7
27	COUPLER	ALUM	NOTE 7
28	FEMALE CONNECTOR	ALUM	NOTE 6
29	3/8 NIPPLE	ALUM	NOTE 6
30	1/2" NIPPLE	ALUM	NOTE 6
31	ELBOW	ALUM	NOTE 11

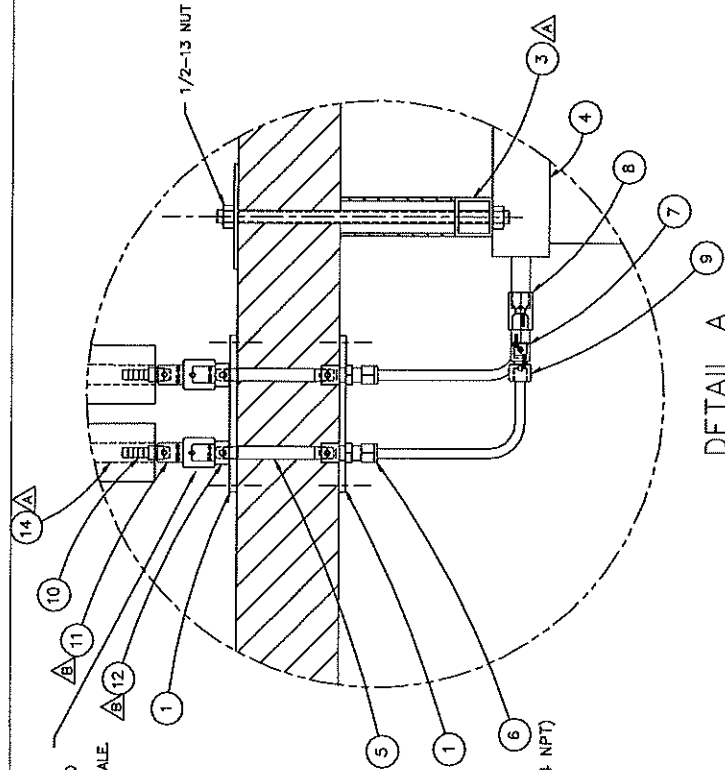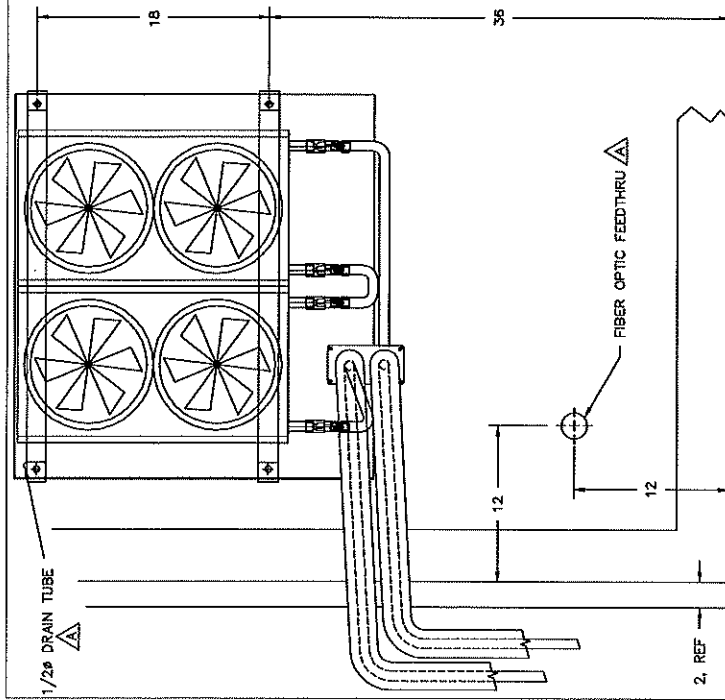

CHANGE A:
THESE CHANGED TO
1/2" HOSE PARTS
NOT SHOWN TO SCALE


VAULT COOLER

1 REQ'D

NOTES:

1. LYTRON 5321G10 HEAT EXCHANGER
LYTRON INC.
DRAGON COURT
MOBURN, MA 01801
(617) 933-7300
2. ARRANGE FANS TO BLOW UP
AS SHOWN
3. GOODYEAR CORILLA HOSE
4. PARKER BH3-61
5. PARKER 406 (3/8 SAE TO 1/4 NPT)
6. SWAGelok SS-600-7-4
7. PARKER 600PHD-8
8. PARKER 48F-8-4 (1/2 FLARE TO 1/4 NPT)
9. SWAGelok SS-600-71-4
10. MCMAS-TER-CARR 4568K137

DETAIL A
HALF SCALE

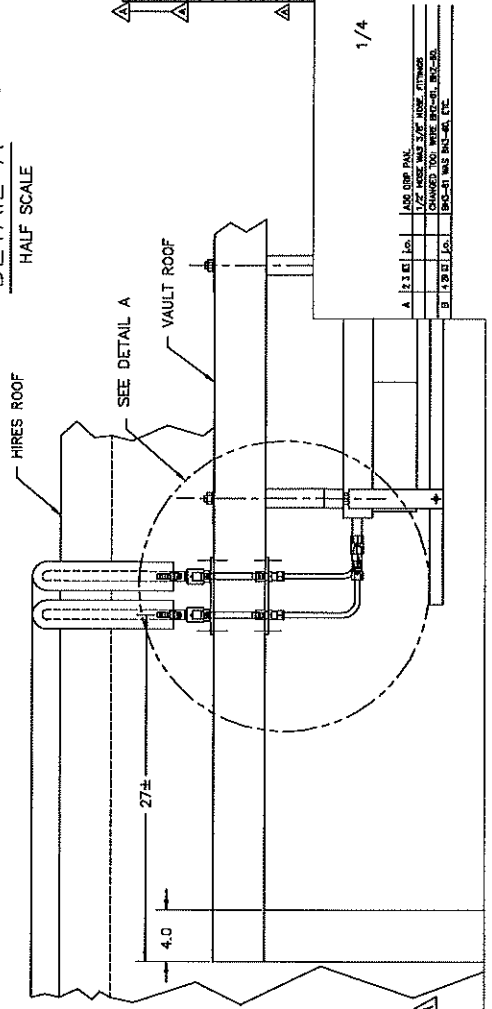

14	1/2" HOSE	ALUM	3
13	DISP. TRAY	ALUM	1
12	NOZZLE	ALUM	4
11	HOSE BAR	ALUM	2
10	FEMALE CONNECTOR	ALUM	2
9	FLARE UNION, 1/2"	ALUM	4
8	MALE CONN. W/ FLARE	ALUM	2
7	1/4" NOZZLE & LG	ALUM	2
6	HEAT EXCHANGER	ALUM	1
5	SUPPORT	ALUM	2
4	FEEDTHRU PLATE	ALUM	1
3	FEEDTHRU PLATE	ALUM	2

A	1/2" HOSE	ALUM	3
B	1/2" HOSE	ALUM	4
C	1/2" HOSE	ALUM	2
D	1/2" HOSE	ALUM	1



KECK/HIRES
VAULT COOLING SYSTEM
INSTALLATION DETAILS
RCA 3/7/92
CLC 3/25/92
H1411.B

CONTROL PANEL COOLING SYSTEM


NOTES:

1. PARKER 48F-6-6, 3/8 MALE NPT TO 45° FLARE
2. PARKER 207ACBH-6, 3/8 NPT TO 3/8 NPT
3. 1-14 THD O.D. x 1.31 LOA
4. MCMASTER-CARR 456BK152, 3/8 NPT NIPPLE x 1-1/2 LG
5. PARKER 1203F-6, 3/8 NPT
6. PARKER BUSHING, 208F-4-6
7. MCMASTER-CARR 4000KS4, 1/4 NPT PRESSURE GAGE
8. MCMASTER-CARR 456BK165, 3/8 NPT NIPPLE, 10" LOA
9. MODIFY TO FIT.

DO NOT SCALE FITTINGS.

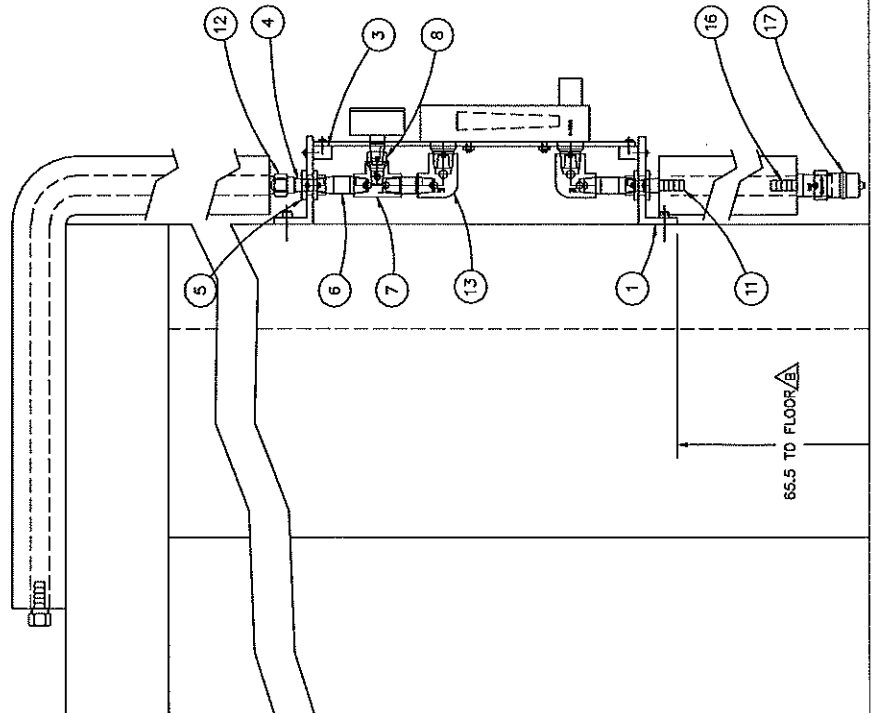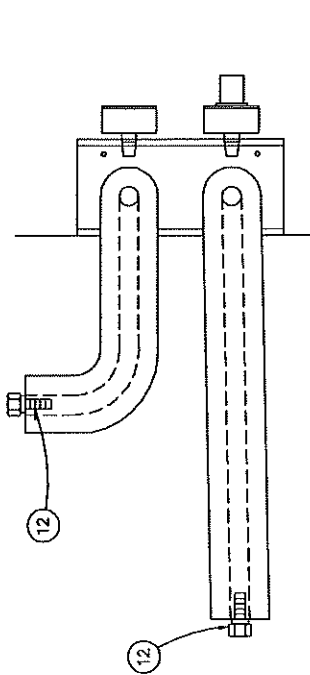

8. PARKER 125HBL-6-6, 3/8 NPT TO 3/8 TUBE
 9. PARKER 146HBLFV-6-6, 3/8 NPT TO 45° SWIVEL, 5/8-18 STRAIGHT THREADS
 10. PARKER 2200P-6-8, 3/8 NPT TO 1/2 NPT 90° ELBOW
 12. COLE-PALMER L-03285-18 BLOCK-TYPE FLOWMETER WITH VALVE, 75mm SCALE.
 13. PARKER 125HBL-6-8, 1/2 NPT MALE TO 3/8 HOSE BARB
 14. PARKER BH4-61, 1/2 NPT FEMALE, NIPPLE
 15. PARKER BH4-60, 1/2 NPT FEMALE, COUPLER
- ALL FITTINGS ARE BRASS.

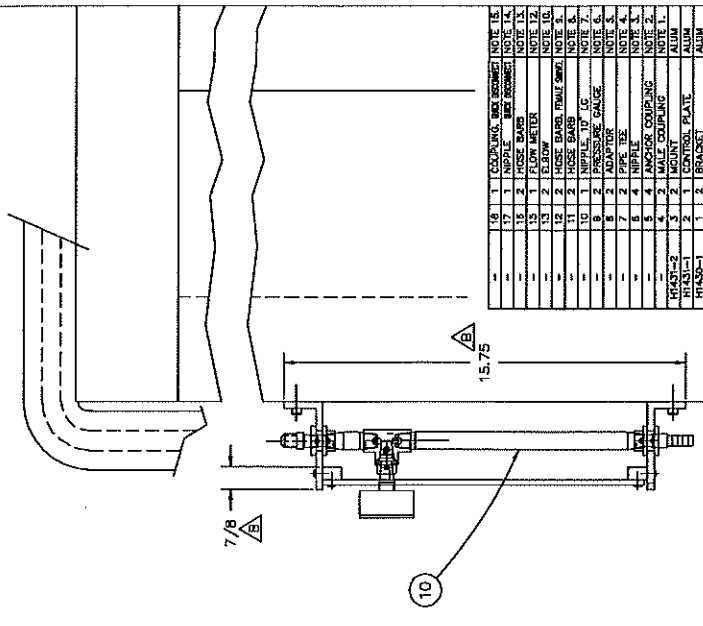

1/2





USE NOTES AND CHANGE MS. 1/2.
FOR PANEL COOLING SYSTEM.

KECK/HIRES
COOLING SYSTEM
CONTROL PANEL

REV. 3/4/92
D.C. 3 28 92

H14328

10	COLE-PALMER L-03285-18	NOTE 12
11	ADAPTOR	NOTE 13
12	FLOW METER	NOTE 14
13	FLOW METER	NOTE 15
14	FLOW METER	NOTE 16
318	FLOW METER	NOTE 320
31		

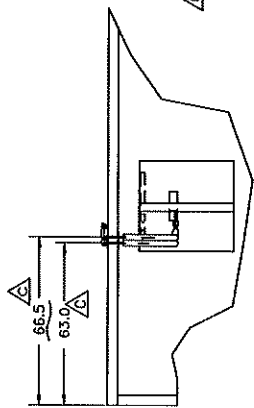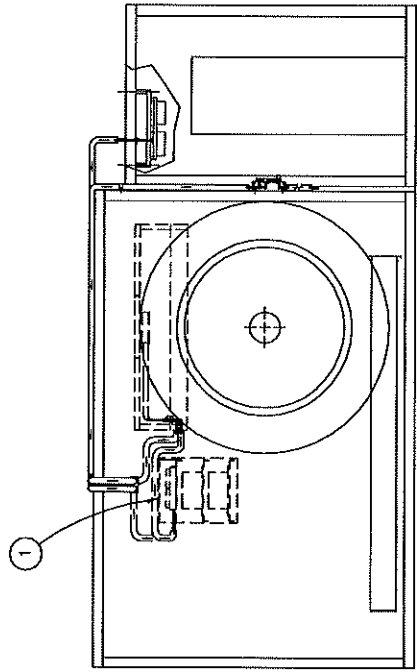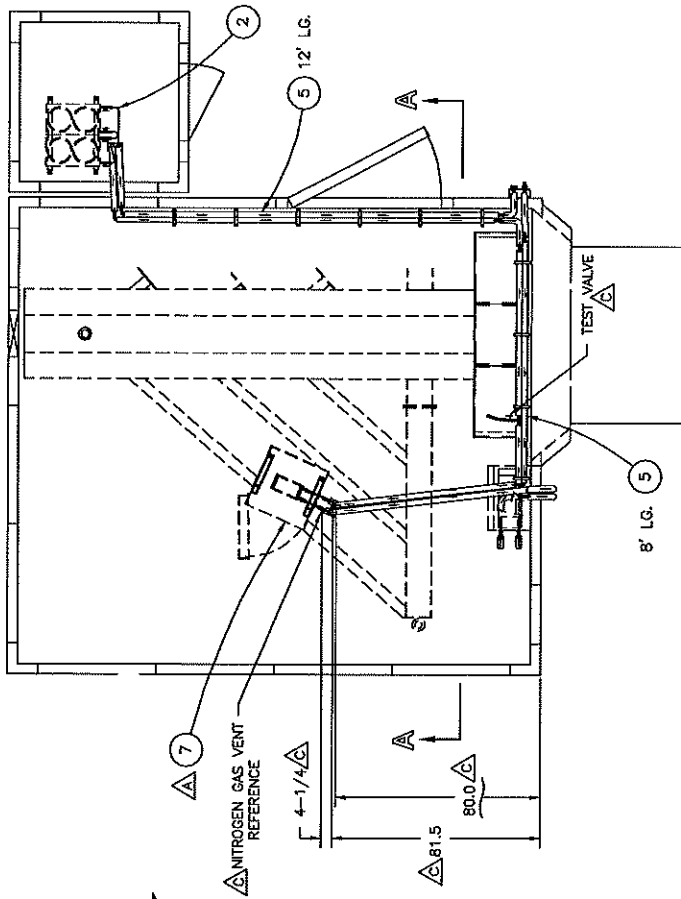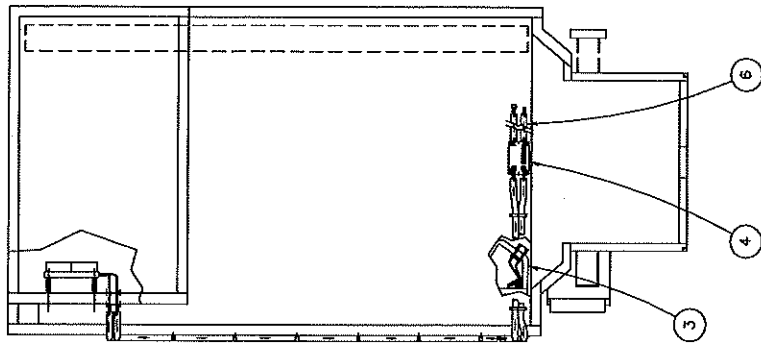

SEC A-A

ITEM NO.	DESCRIPTION	QTY	UNIT
1	CONDENSER COILS	1	EA
2	REFRIGERANT LINES	8	FT
3	COPPER PIPE	4	FT
4	COPPER PIPE	4	FT
5	CEILING PANEL COIL SYSTEM	1	EA
6	CEILING PANEL COIL SYSTEM	1	EA
7	NITROGEN GAS VENT	1	EA
8	TEST VALVE	1	EA

.05

KECK/HIRES
COOLING SYSTEM
INSTALLATION


REV. 3/7/72
CAL 4/2/72
H1450.C

REVISION	DATE	BY	DESCRIPTION
A	3/7/72	KECK	ADDED ITEM 7
B	4/2/72	HIRS	REVISED PER AS BUILT
C	4/2/72	HIRS	ADD CEILING HOLE DIMENSIONS



CCD ELECTRONICS COOLING ASSY

NOTES:

1. LYTRON INC.
DRAGON CT
ROBURN, MA 01801
617/933/7300
2. WARD-BRAGBY PLASTICS
1370 PIPER DR.
MILPITAS, CA
408/282/2111
3. WIRING AND PLUMBING HOLES
LOCATED AS REQD.
4. INSULATION THICKNESS, 2-1/4".

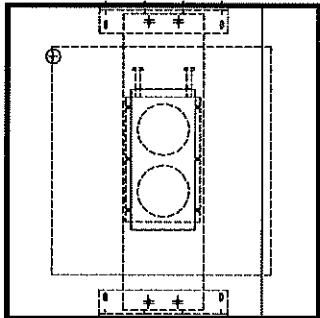

TOP VIEW

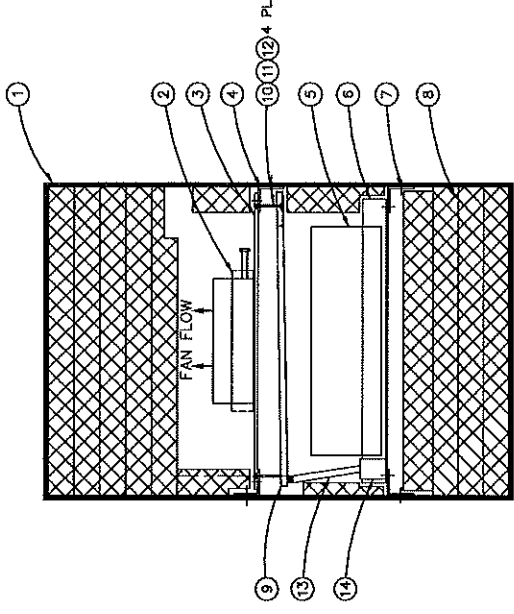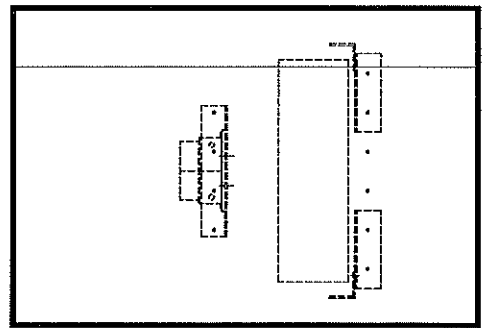




14	1	CONTAINER	SILICON
13	4	TUBE 1/2" RED	SILICON
12	4	NUT 1/2" SZ	SILICON
11	4	D-RING	SILICON
10	1	US SCREW	ALUM
9	1	CONDENSATION TRAP	ALUM
8	4	INSULATION	ALUM
7	4	BRACKET	ALUM
6	2	BRACKET	ALUM
5	4	BRACKET	ALUM
4	2	BRACKET	ALUM
3	1	SHELF	ALUM
2	1	HEAT EXCHANGER	ALUM
1	1	CONTAINER	ALUM

1/4


KECK/HIRES
CCD ELECTRONICS COOLING
ASSEMBLY

H1462.C

A	REVISION PER AS BUILT
B	REVISION PER AS BUILT
C	REVISION PER AS BUILT
D	REVISION PER AS BUILT
E	REVISION PER AS BUILT
F	REVISION PER AS BUILT
G	REVISION PER AS BUILT
H	REVISION PER AS BUILT
I	REVISION PER AS BUILT
J	REVISION PER AS BUILT
K	REVISION PER AS BUILT
L	REVISION PER AS BUILT
M	REVISION PER AS BUILT
N	REVISION PER AS BUILT
O	REVISION PER AS BUILT
P	REVISION PER AS BUILT
Q	REVISION PER AS BUILT
R	REVISION PER AS BUILT
S	REVISION PER AS BUILT
T	REVISION PER AS BUILT
U	REVISION PER AS BUILT
V	REVISION PER AS BUILT
W	REVISION PER AS BUILT
X	REVISION PER AS BUILT
Y	REVISION PER AS BUILT
Z	REVISION PER AS BUILT

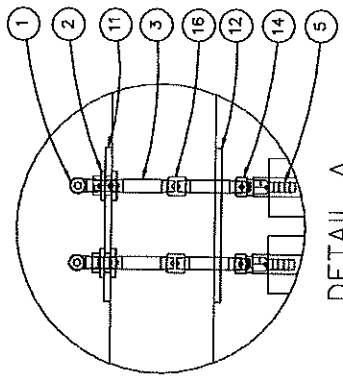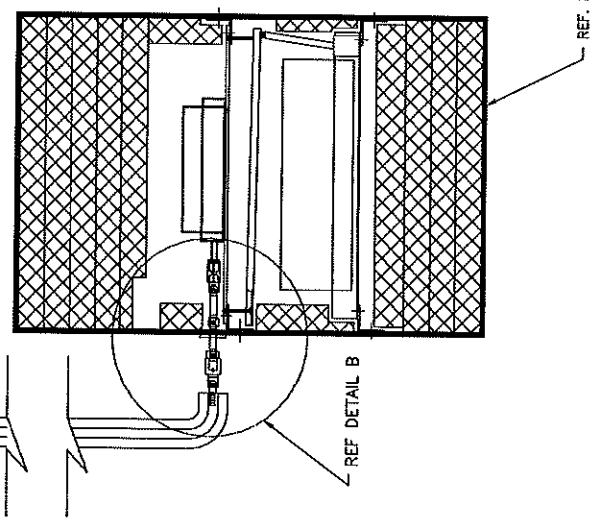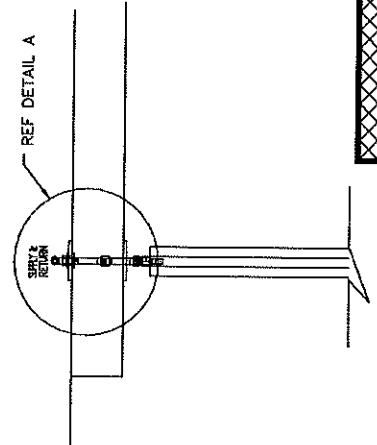

SCALE: 1/2
VIEW IS 90° FROM ORIGINAL

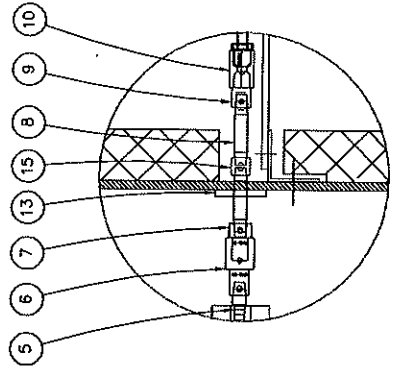

SCALE: 1/2

-1 CCD COOLING INSTALLATION

NOTES:

1. ITEM 14, 4 EA. USED TO CONNECT TO EXISTING COOLING SYSTEM, SEE H1450.
2. NOT TO SCALE.

18	2	1/2 COUPLING
19	2	3/8 COUPLING
14	6	SWAGE NUTS 1/2"
H1462-4	13	2 FRESH AIR PLATE
H1462-1	12	1 FRESH AIR PLATE
H1462-1	10	2 PLATE UNIONS 3/8"
	8	4 3/8 NIPPLE 2.50 LG
	7	2 3/8 APRIL COOL DISCONNECT
	5	2 SWAGE NUTS 1/2"
	4	2 SWAGE NUTS 3/8"
	3	4 1/2 NIPPLE 2.50 LG
	2	1/2 ANCHOR COUPLING
	1	2 BRK 1/2 TURN TO 1/2 WPT

NTS

REVISIONS:

A	DATE/CAO	REVISION
B	DATE/CAO	UPDATE PER AS BUILT
C	DATE/CAO	REMOVE FRESH AIR OPTIC EXT. ADD NOTE.


KECK/HIRES
 CCD COOLING
 INSTALLATION DETAILS
 H1463.C

Appendix U List of Drawings — Camera Mirror

1. H5000 Locating Tree
2. H5560 Camera Mirror Cell Assembly
3. H5530 Camera Mirror Cell, Radial Support Sub-Assembly
4. H5550 Door Assembly
5. H5380 Pneumatic Control Panel
6. H5514 Radial Support Load Testing
7. H5537 Axial Support Details
8. H5536 Axial Support Details
9. H5539 Torsional Link Assembly
10. H5824 Horizontal Mirror Testing
11. H5825 10° Mirror Testing (As Used in HIRES)
12. Figure 1: Half Model Showing 3 Axial Supports
13. Figure 2: Half Model — ANSYS Model
14. Figure 3: Deflection Contours and Clear Aperture

H5000	THIS DRAWING		
H5016	CELL DOOR VS. DEWAR CLEARANCE	H5700	OPEN
H5100	OPEN	H5800	FABRICATION AND TEST TOOLING H5807 OPTICS PALET L/O
H5200	CORRECTOR TOOLING		
	H5210 CORRECTOR TOOLS		
	H5214 CAMERA MIRROR TOOLS	H5900	FEA MODELS AND TEST
H5300	CORRECTOR CELLS AND SUPPORT STRUCTURE		
	H5303 CORRECTOR BASE ASSY (ISOMETRIC)		
	H5314 CORRECTOR CELL TOOLING L/O		
	H5324 MENISCUS CORRECTOR CELL ASSY		
	H5328 CORRECTOR CELL AXIAL SUPPORT ASSY'S		
	H5324 MEN. CORR. DOOR ASSY		
	H5349 BICONVEX CORRECTOR CELL ASSY		
	H5363 CORRECTOR CELL ASSEMBLY FIXTURE		
	H5370 BI-FOLDING DOOR ASSEMBLY	(H4532	CROSS DISPERSER DOORS VS BIFOLDING DOOR CLEARANCE)
H5400	CAMERA MIRROR AND TOOLING		
	H5401 CAMERA MIRROR L/O		
	H5409 CAMERA MIRROR SUPPORT ASSY (FOR STRASBAUGH)		
	H5411 CAMERA MIRROR 25" LAP (STRASBAUGH)		
	H5412 CAM. MIRROR 30" LAP (STRASBAUGH)		
	H5415 CAM. MIRROR (HEXTEK DRAWING)		
	H5420 BEAM1 RAYTRACE AT CAMERA PLANE		
	H5421 BEAM1 RAYTRACE OF TELESCOPE AND HIRES		
H5500	CAMERA MIRROR CELL		
	H5530 CAM. MIRROR RADIAL SUPPORT ASSY.		
	H5536 CAM. MIRROR AXIAL SUPPORT ASSY.		
	H5539 CAM. MIRROR TANGENT LINK ASSY.		
	H5541 CAM. MIRROR CELL SPIDER ASSY.		
	H550 CAM MIRROR DOOR ASSY.		
H5600	FIELD FLATTENER		
	H56XX		

KECK/HIRES
 SUPERCAMERA
 LOCATING TREE
 H5000

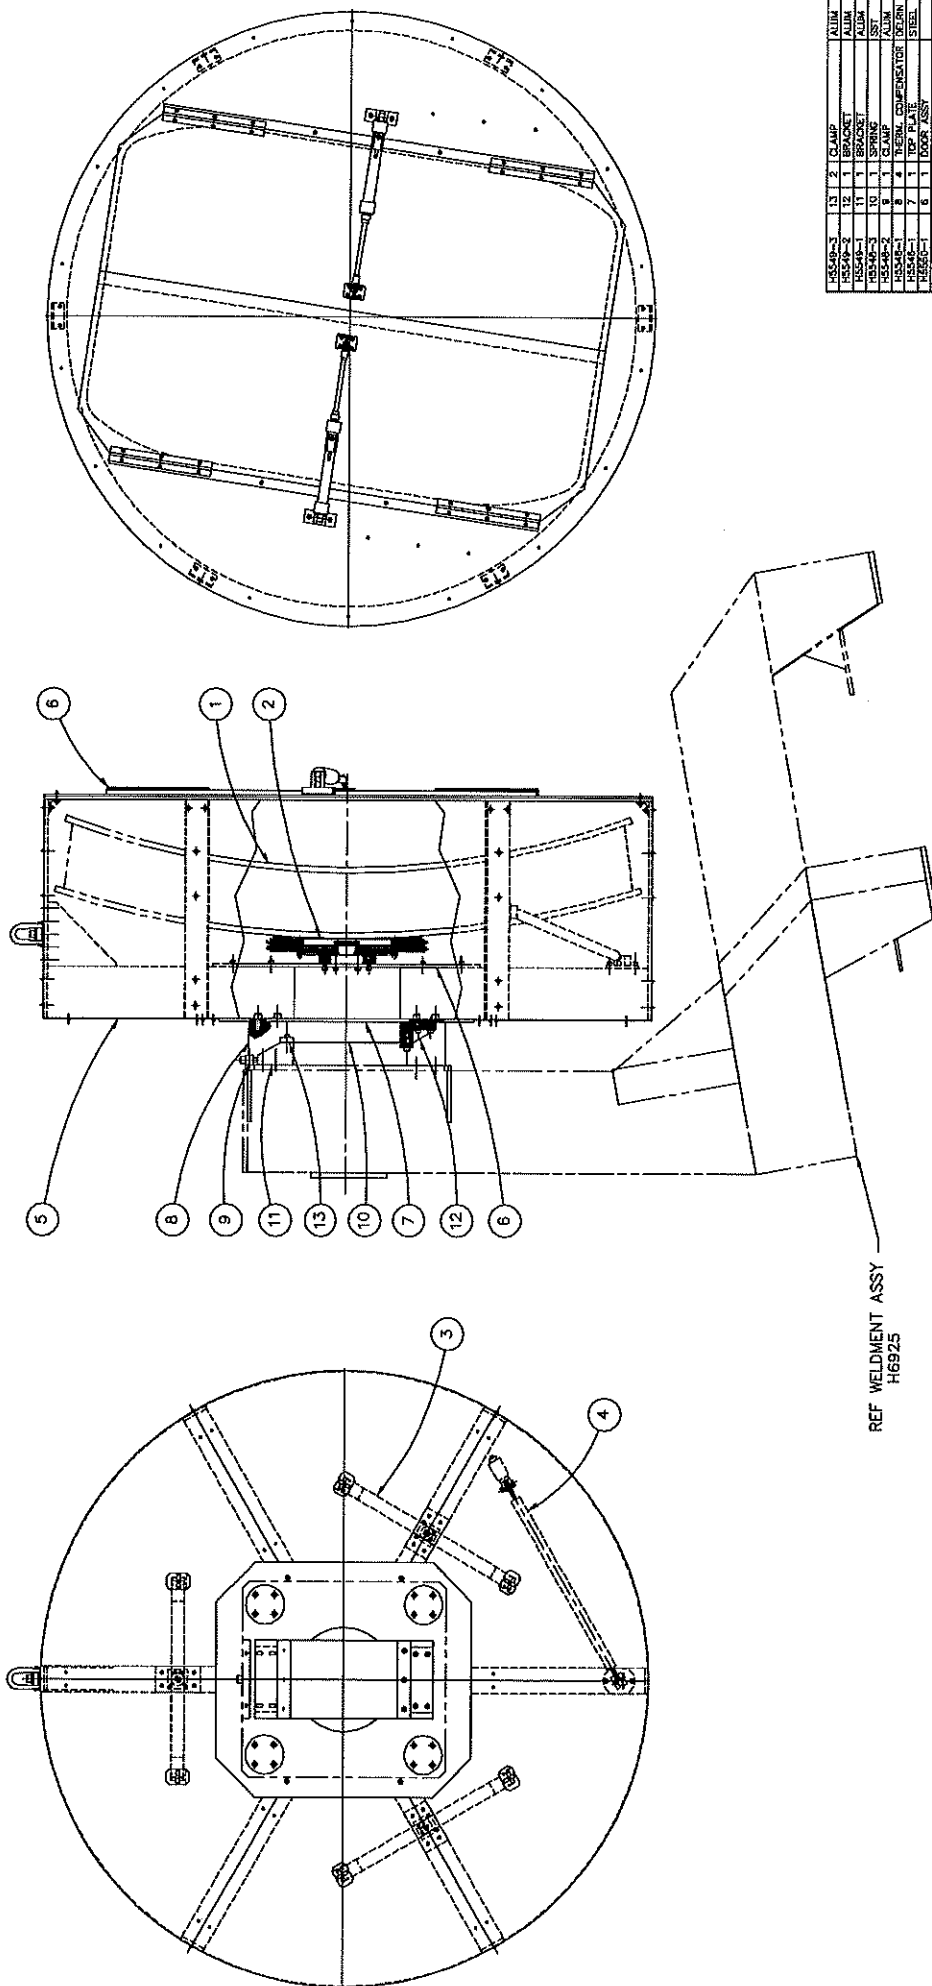

H6925-1	1	CLAMP	ALUM
H6925-2	2	CLAMP	ALUM
H6925-3	3	BRACKET	ALUM
H6925-4	4	SPRING	STAIN
H6925-5	5	CLAMP	ALUM
H6925-6	6	TRIAL COMPENSATOR	ALUM
H6925-7	7	TOP PLATE	STEEL
H6925-8	8	SPRING ASSY	STEEL
H6925-9	9	TANGENT LINK	STEEL
H6925-10	10	AXIAL SUPPORT ASSY	STEEL
H6925-11	11	RADIAL SUPPORT ASSY	STEEL
H6925-12	12	HEATER MIRROR	STEEL
H6925-13	13	HEATER MIRROR	STEEL


REF WELDMENT ASSY
H6925

① CAMERA MIRROR CELL ASSEMBLY

1/4

KECK/HIRES
CAMERA MIRROR
CELL ASSEMBLY
H5560

ALL 1/4" = 1"
CAL 4/8" = 1"

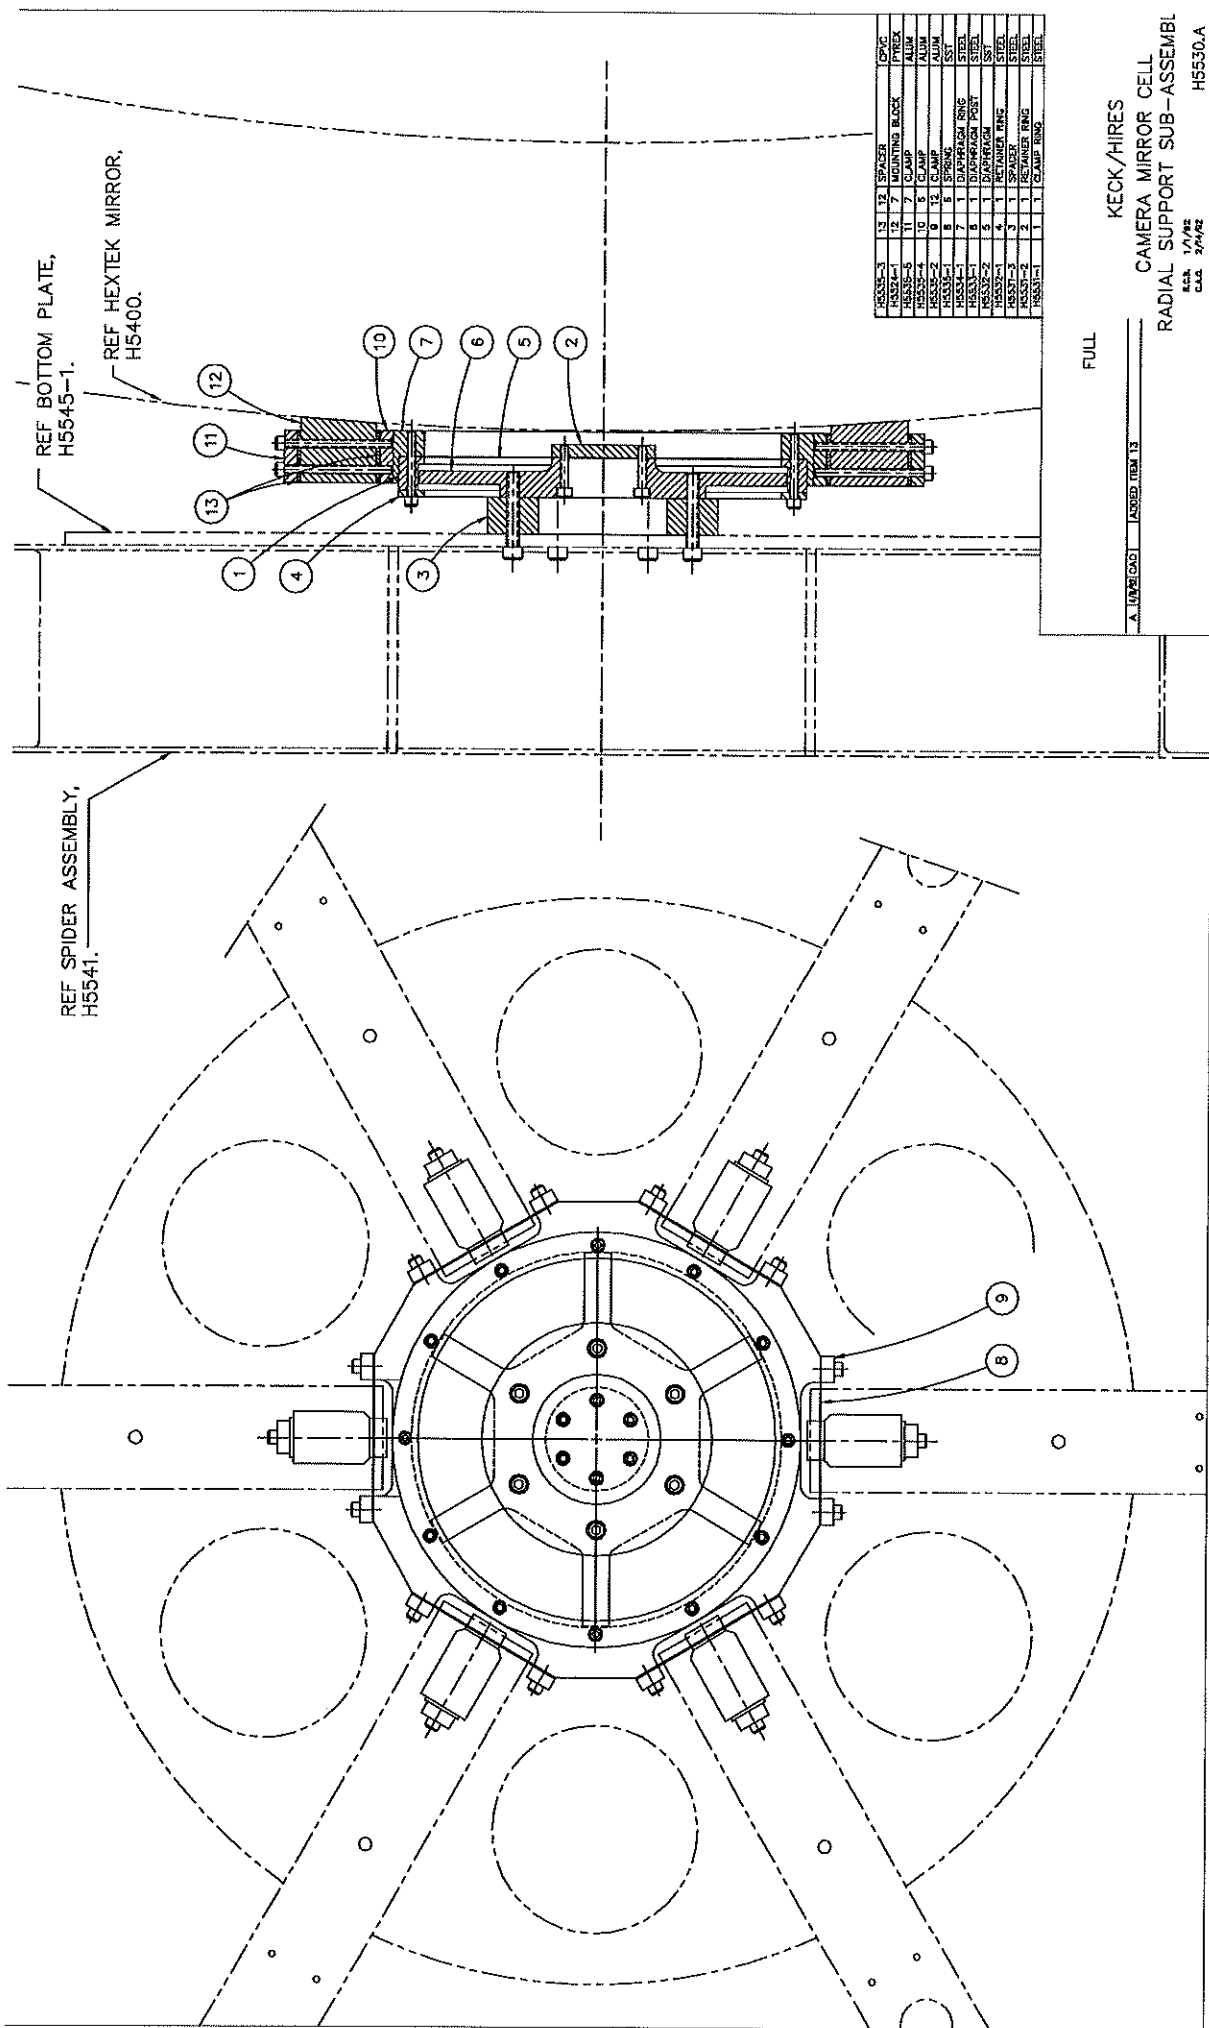

REF SPIDER ASSEMBLY,
H5541.

REF BOTTOM PLATE,
H5545-1.


REF HEXTEK MIRROR,
H5400.

H5530-3	13	SPACER	CPVC
H5530-1	12	MOUNTING BLOCK	PBRKX
H5530-2	11	CLAMP	ALUM
H5530-2	10	CLAMP	ALUM
H5530-2	9	CLAMP	ALUM
H5530-1	8	SPRING	SST
H5530-1	7	DIA PHRASE RING	STEEL
H5530-1	6	DIA PHRASE RING	STEEL
H5530-2	5	DIA PHRASE RING	STEEL
H5530-1	4	SPACER RING	STEEL
H5530-2	3	SPACER RING	STEEL
H5530-1	2	CLAMP RING	STEEL

FULL


KECK/HIRES
CAMERA MIRROR CELL
RADIAL SUPPORT SUB-ASSEMBLY
REV. 1/7/82
CAL. 2/7/82
H5530.A

A. UNRECALC. BASED ITEM 13

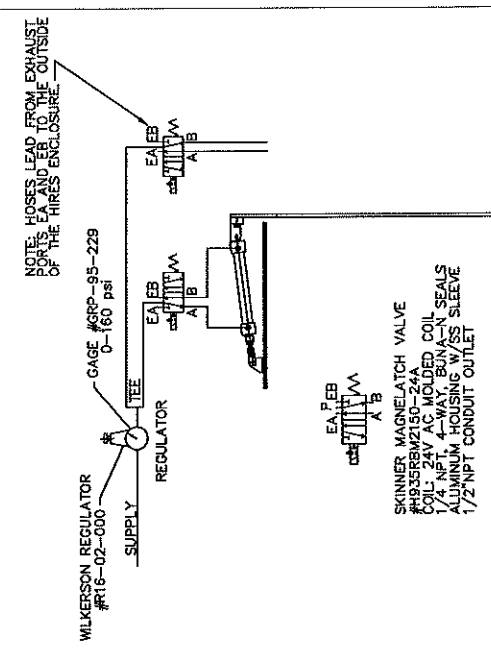

NOTE: HOSES LEAD FROM EXHAUST PORTS FROM LEAD TO THE OUTSIDE OF THE THRESH ENCLOSURE.

SKINNER MAGNETLATCH VALVE
 #R35R21501-240
 #R35R21501-240
 1/4" NPT
 4-WAY BUNA-N SEALS
 ALUMINUM HOUSING W/SS SLEEVE
 1/2" NPT CONDUIT OUTLET

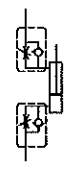


SPEED CONTROL DETAIL
 BIMBA #CP2, 1/8 NPT.
 FORT MOUNTED
 FLOW CONTROL

DOOR ASSEMBLY

1 REQ'D

NOTES:

1. CELLULAR URETHANE, #4701-01-20125-1604 WITH ADICHEM #256 ADHESIVE.
 BOYD CORP
 2209 FAIRVIEW DR.
 CERES, CA 95307
2. BIMBA #MRS-044-DXF.
3. BIMBA #D-166-3.
4. BIMBA #MRS-067-XBL-04.
 144" LEADS, FITS 3/4" CYLINDER.
5. BIMBA #D-167.
6. BIMBA #CP2, 1/8 NPT.
7. SWAGelok FITTING, #B-400-1-2 (1/8 NPT).
8. SWAGelok FITTING, #B-400-1-4.
9. REFERENCE DRAWING H4750 FOR PNEUMATIC DIAGRAMS.

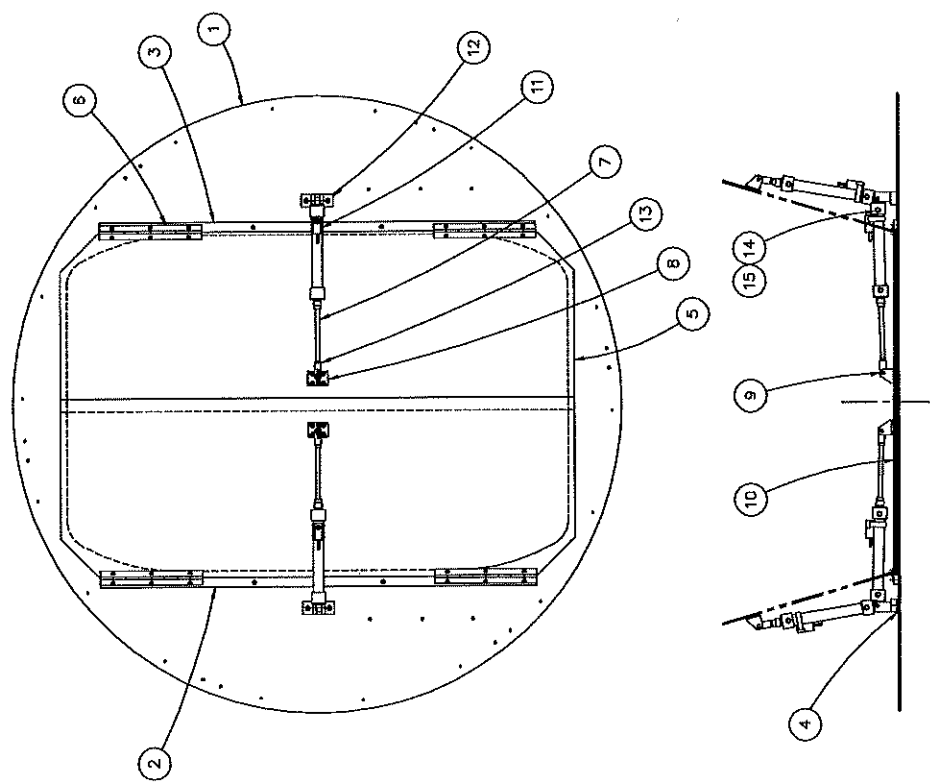


15	1/4" TUBE TO 1/4" NPT	NOTE 8
16	1/4" TUBE TO 1/4" NPT	NOTE 8
17	1/4" TUBE TO 1/4" NPT	NOTE 8
1/4

1	1/4" TUBE TO 1/4" NPT	NOTE 8
2	1/4" TUBE TO 1/4" NPT	NOTE 8
3	1/4" TUBE TO 1/4" NPT	NOTE 8
KECK/HIRES
 CAMERA MIRROR CELL
 DOOR ASSEMBLY
 H5550.B


REV 12 WAS REVISED
 REV 11
 REV 10
 REV 9
 REV 8
 REV 7
 REV 6
 REV 5
 REV 4
 REV 3
 REV 2
 REV 1

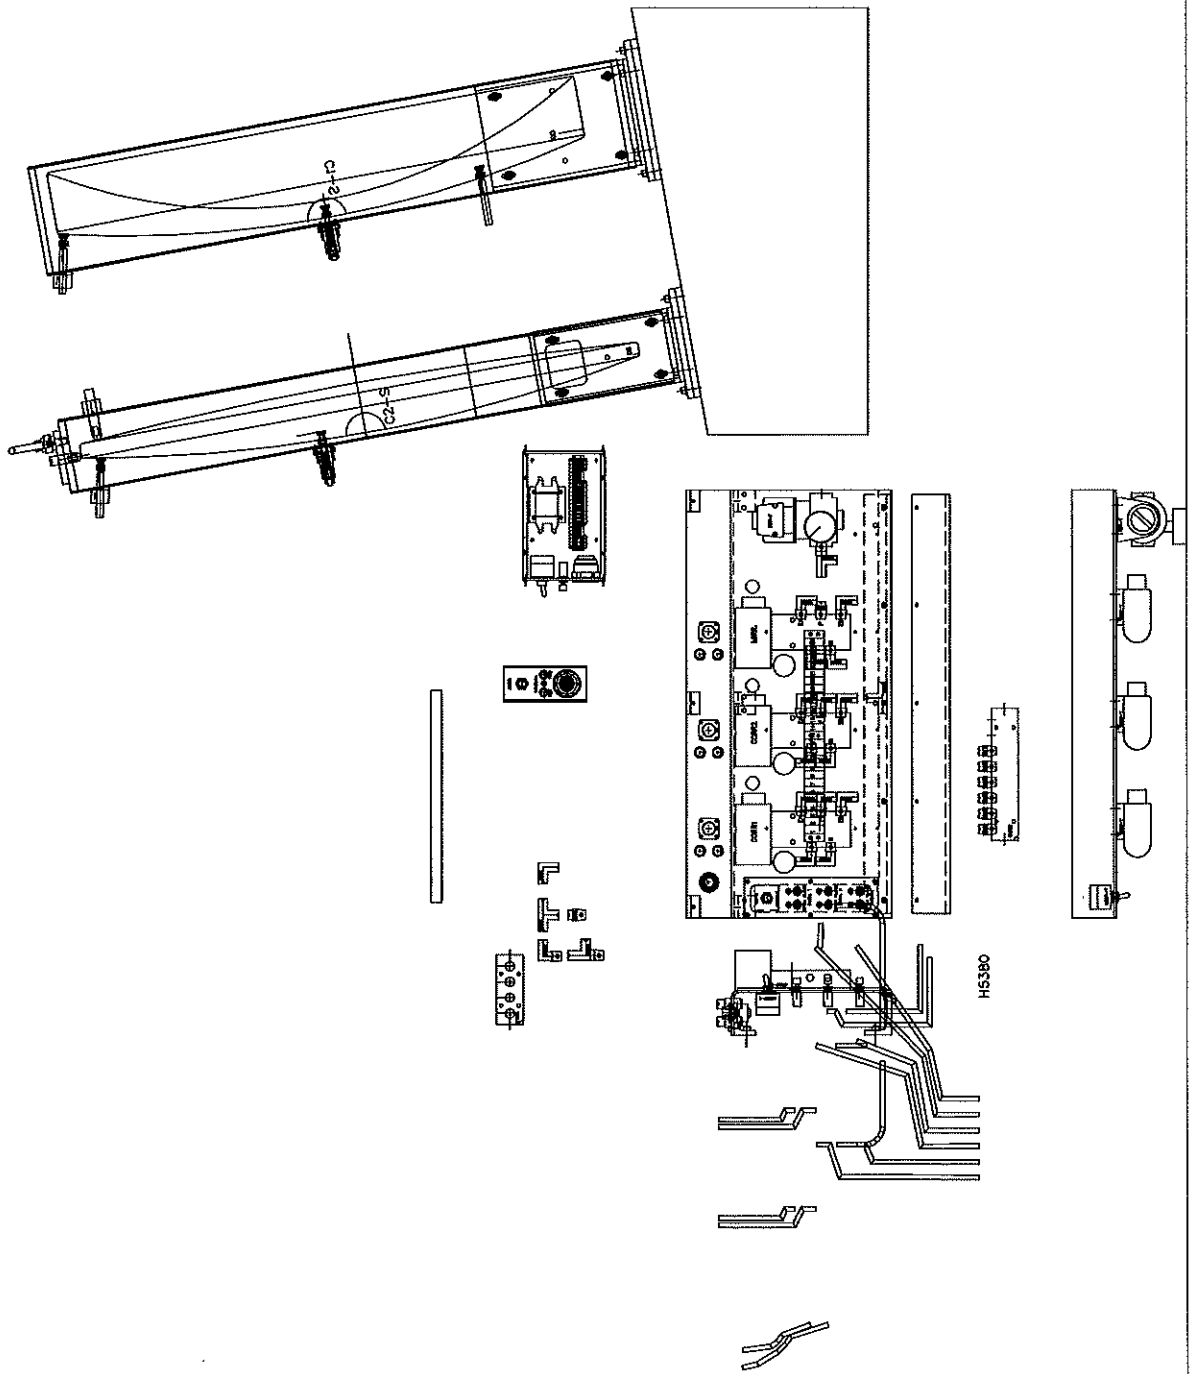

N/A

KECK/HIRES
CORRECTOR CELLS
AIR SYSTEM LAYOUT
BCB 3 18 42
HS390.A


RAM

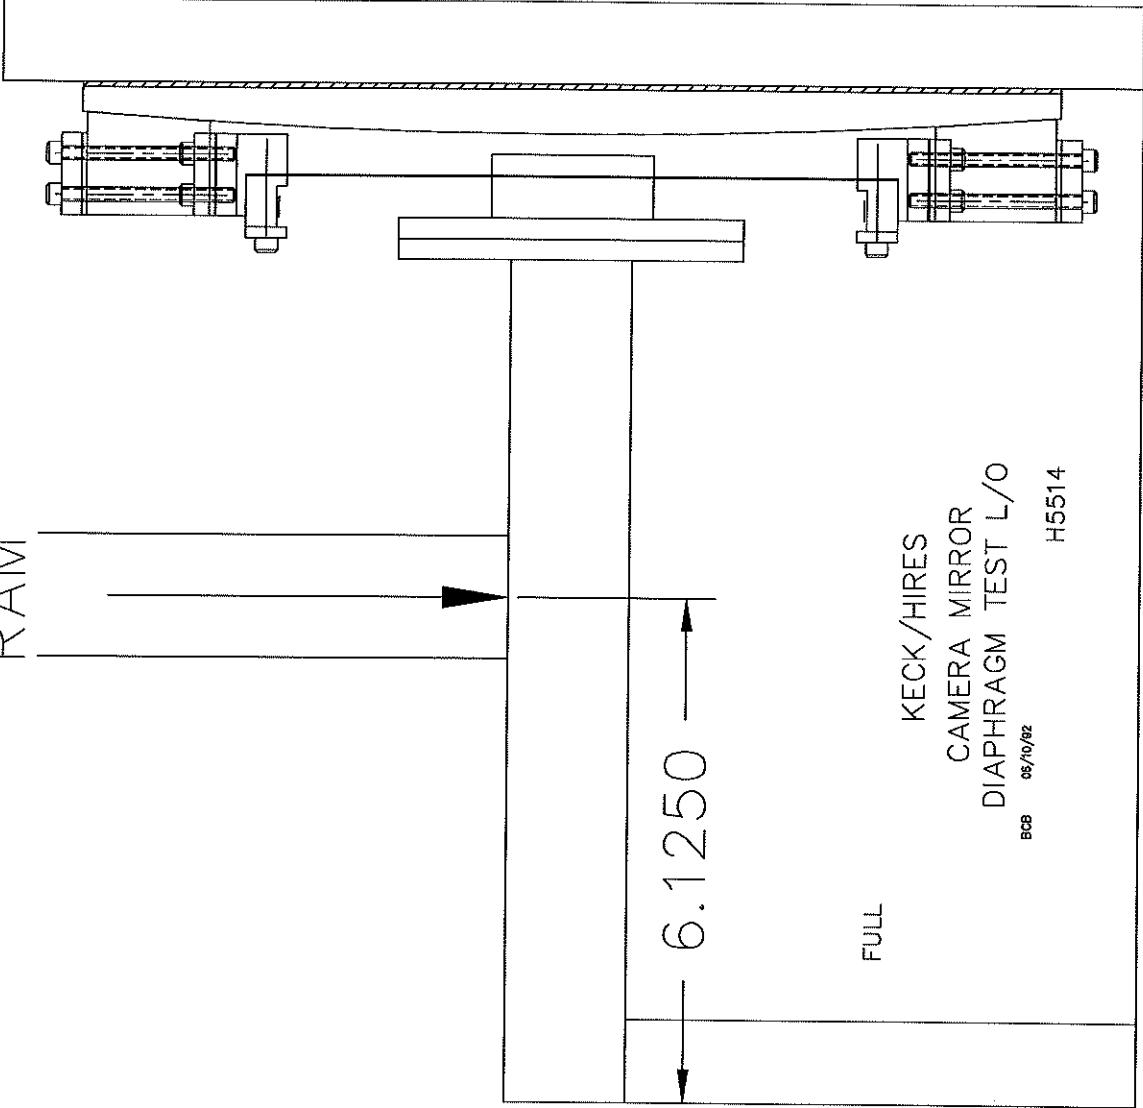

6.1250

FULL

KECK/HIRES
CAMERA MIRROR
DIAPHRAGM TEST L/O
BCB 05/10/82
H5514

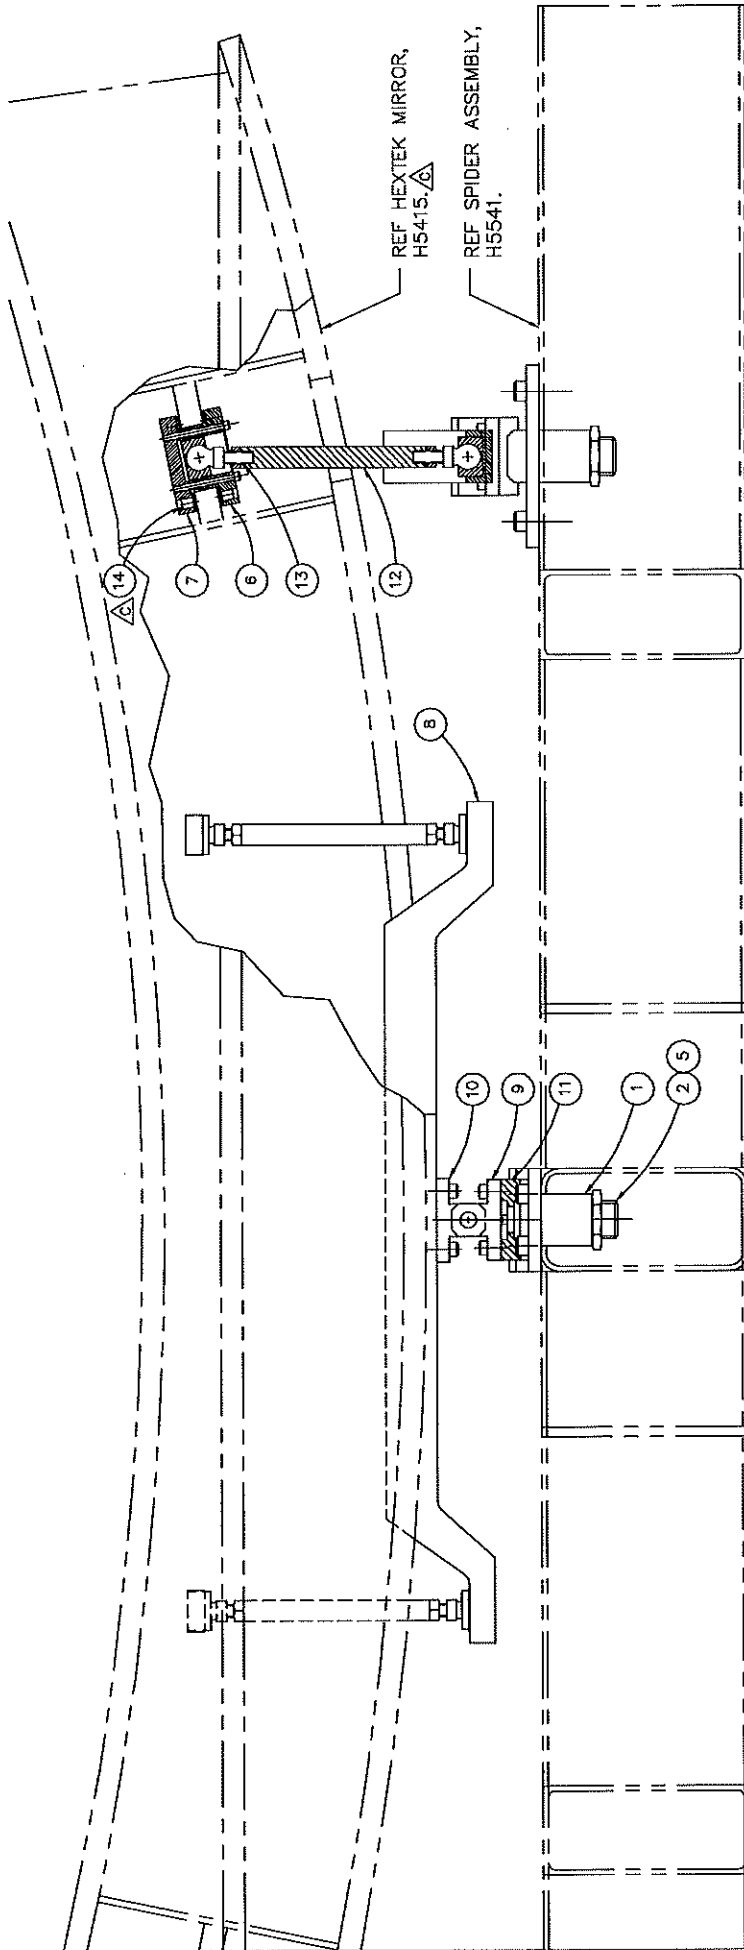


QTY	DESCRIPTION	UNIT	REF
1	BEAM SUPPORT	SS	H5537-1
1	AXIAL ADJUSTER	BRASS	H5537-2
3	CAP	ALUM	H5537-3
2	SPRING PLATE	ALUM	H5537-4
2	CLAMP	OSERN	H5537-5
6	CLAMP	OSERN	H5537-6
7	CLAMP BASE	OSERN	H5537-7
8	ARM	ALUM	H5538-1
6	FRONT BASE	ALUM	H5538-2
3	FRONT SWAGE	ALUM	H5538-4
3	FRONT SWAGE	ALUM	H5538-5
5	SHANK	OSERN	H5538-6
6	BEAM SUPPORT	SS	H5537-1

⊖ AXIAL SUPPORT SUB-ASSEMBLY

FULL


REV	DATE	BY	CHKD	DESCRIPTION
A	1/1/82	KECK	HIRES	REVISION # 1
B	1/1/82	KECK	HIRES	REVISION # 2
C	1/1/82	KECK	HIRES	REVISION # 3

KECK/HIRES
CAMERA MIRROR CELL
AXIAL SUPPORT ASSY
H5538.C
SCALE: 1/1/82
DATE: 1/1/82

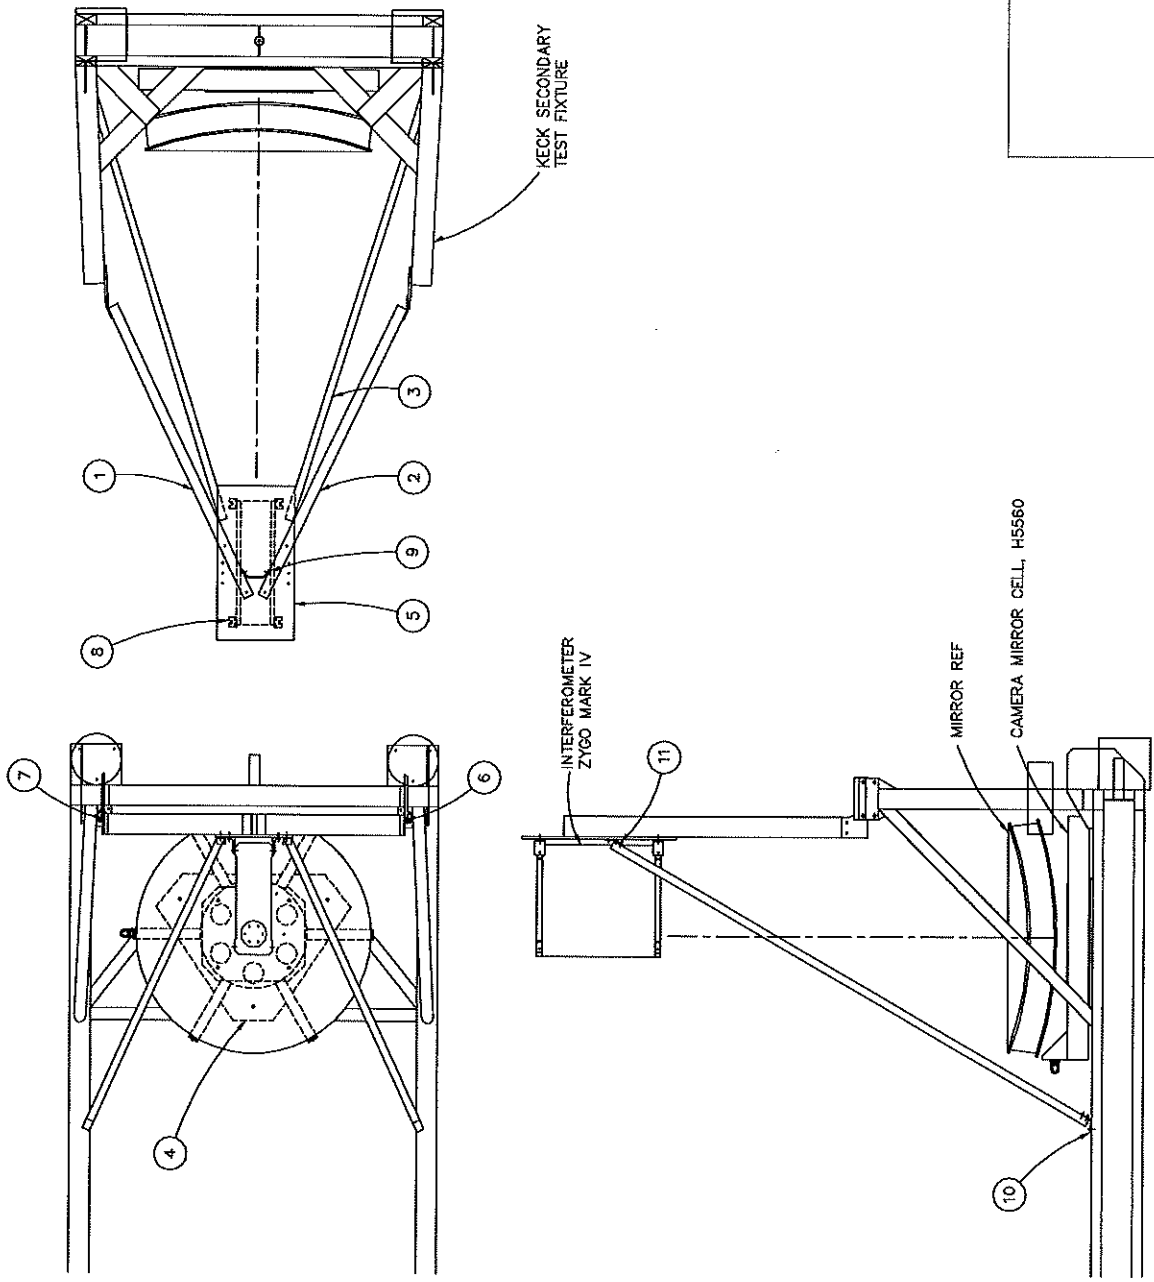

H5824-4	11	3	BRACKET	ALUM
H5824-3	10	2	BRACKET	ALUM
H5824-2	9	1	BRACKET	ALUM
H5824-1	8	4	BRACKET	ALUM
H5823-3	7	1	BRACKET	ALUM
H5823-2	6	1	BRACKET	ALUM
H5823-1	5	1	BRACKET	ALUM
H5822-1	4	1	MOUNTING PLATE	ALUM
H5821-2	3	2	STRUT	STEEL
H5821-1	2	1	PIST	STEEL
H5820-2	1	1	PIST	STEEL

KECK/HIRES
 CAMERA MIRROR
 HORIZONTAL TEST ASSY
 B.C.B. 4/7/76
 C.A.S. 4/7/76
 H5824

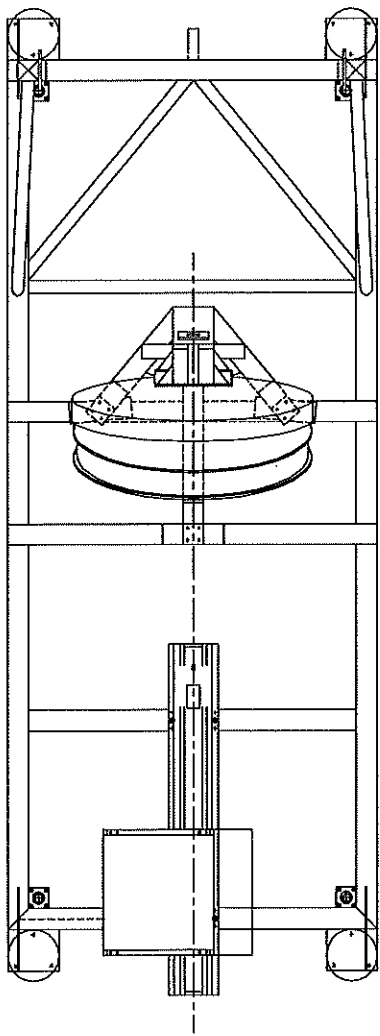


CAMERA MIRROR CELL, H5560

WELDMENT ASSY, H6925

KECK SECONDARY TEST FIXTURE

INTERFEROMETER, ZYGO MARK IV

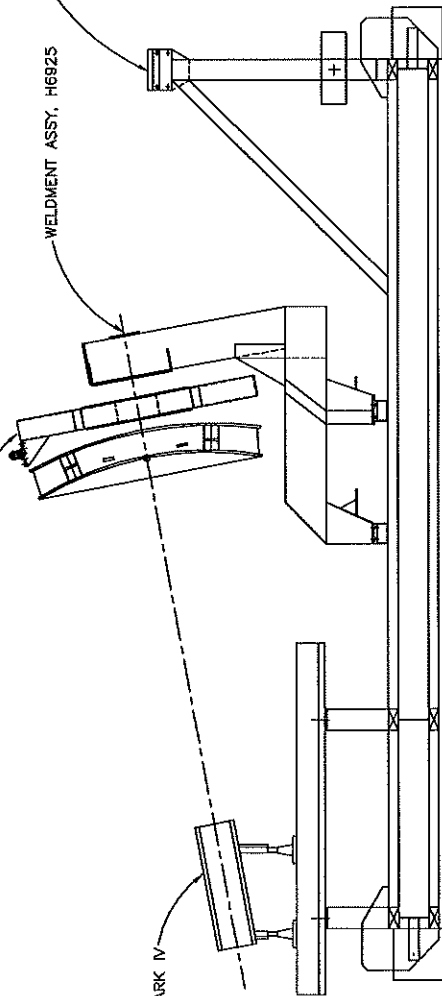

1

KECK/HIRES
CAMERA MIRROR
10" TEST ASSY
REV 7/7/92
CAL 8/5/92 H5625

ANSYS 4.4A
JUL 22 1992
15:44:32
PLOT NO. 2
POST1 NODES

ZV =-1
DIST=24.962
XF =11.346
ZF =65.418
FACE HIDDEN

POST1 NODES
TDIS

ZV =-1
DIST=24.962
XF =11.346
ZF =65.418
FACE HIDDEN

POST1 ELEMENTS
TYPE NUM
TDIS

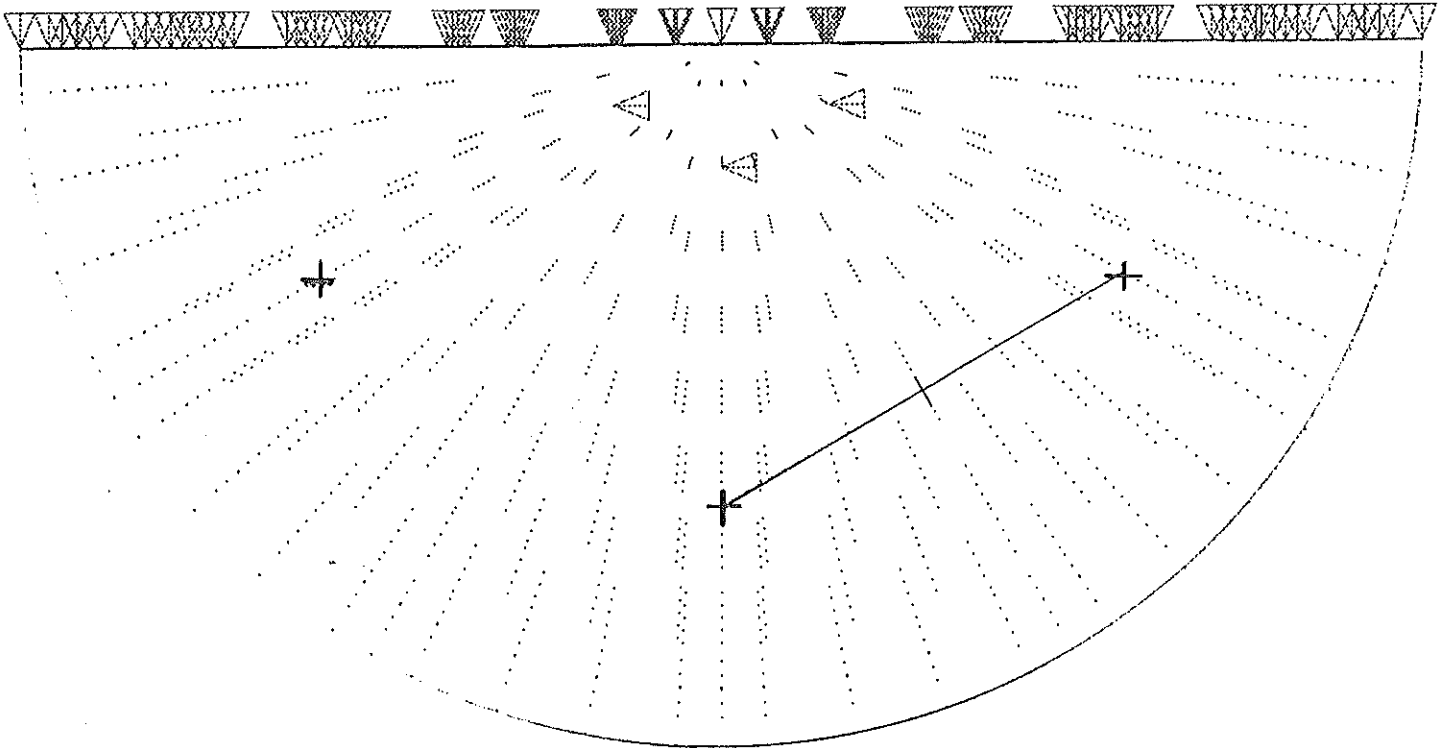


FIGURE 1

ANSYS 4.4A
AUG 10 1992
13:31:36
PLOT NO. 1
POST1 ELEMENTS
TYPE NUM
XV =-1
YV =0.3
ZV =-1
DIST=26.997
XF =11.346
ZF =65.418
FACE HIDDEN

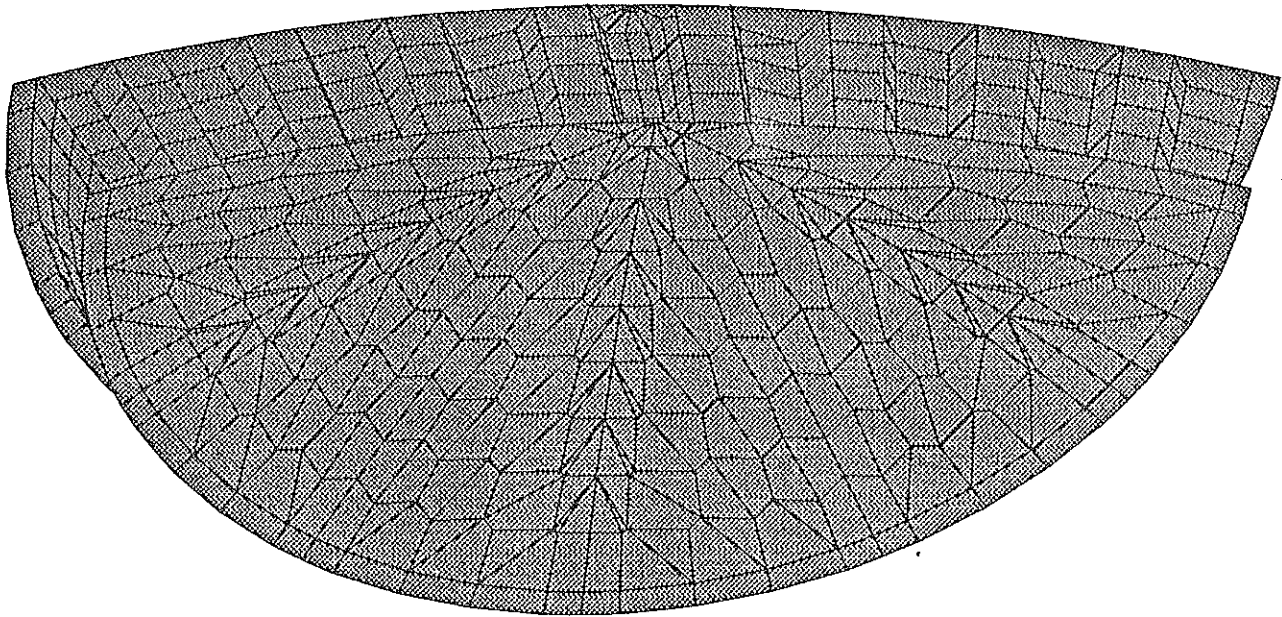


FIGURE 2

ANSYS 4.4A
 JUL 22 1992
 15:43:27
 PLOT NO. 1
 POST1 STRESS
 STEP=1
 ITER=1
 UZ
 D GLOBAL
 DMX =0.232E-04
 SMN =-0.169E-04
 SMX =0.194E-05

ZV =-1
 DIST=24.962
 XF =11.346
 ZF =65.418
 FACE HIDDEN
 -0.169E-04
 -0.148E-04
 -0.127E-04
 -0.106E-04
 -0.851E-05
 -0.642E-05
 -0.433E-05
 -0.224E-05
 -0.154E-06
 0.194E-05

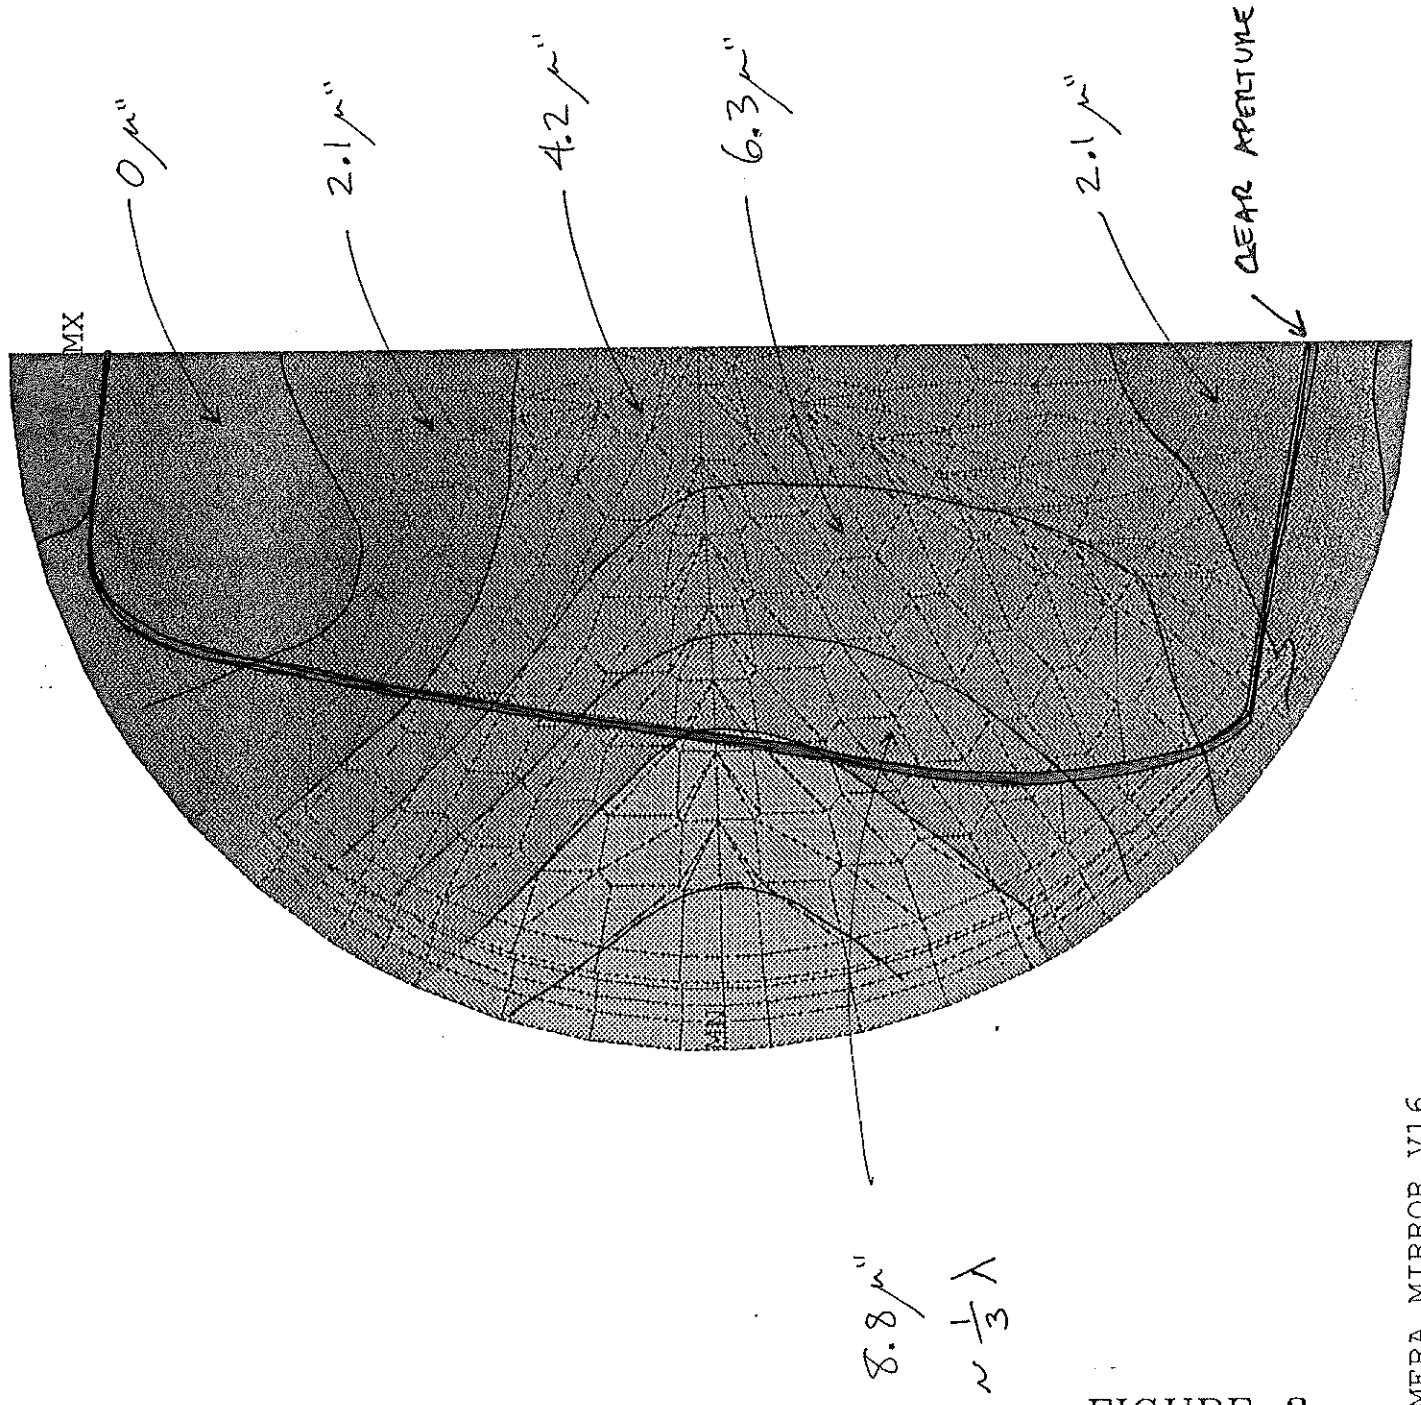



FIGURE 3

Appendix V List of Drawings — Corrector Lenses

1. Figure 1: Finite Element Half Model Showing the Application of Radial Forces
2. Figure 2: Finite Element Contour Plot
3. Figure 3: FEA Contour Plot Showing Clear Aperture of Lens
4. Figure 4: Finite Element Contour Plot
5. Figure 5: FEA Contour Plot Showing Clear Aperture of Lens
6. Figure 9: Interferometer Output, No Forces
7. Figure 11: WISP Output, No Forces
8. Figure 17: Interferometer Output, Optimum Support
9. Figure 18: WISP Output, Optimum Support
10. H0148 Super-Duper III Camera Layout
11. H5000 Locating Tree
12. H5266 Meniscus Lens Sling Assembly
13. H5267 Biconvex Lens Sling Assembly
14. H5324 Meniscus Cell Assembly
15. H5328 Axial Support Details
16. H5349 Bi-Convex Cell Assembly
17. H5363 Lens Installation/Removal Tool
18. H5370 Bi-Fold Door Sub-Assembly
19. H5375 Bi-Fold Door Air Logic
20. H5376 Bi-Fold Door Assembly
21. H5380 Air System Layout
22. H5384 Bi-Convex Lens Installation/Removal Procedure
23. H5385 Meniscus Lens Installation/Removal Procedure
24. H5811 Testing Meniscus Lens
25. H5826 Testing Meniscus Lens at 10°

ANSYS 4.4A
JUL 22 1992
15:37:25
PLOT NO. 1
PREP7 NODES
TDIS
FORC

YV =-1
DIST=16.678
YF =1.68
ZF =-7.581
VUP =-X

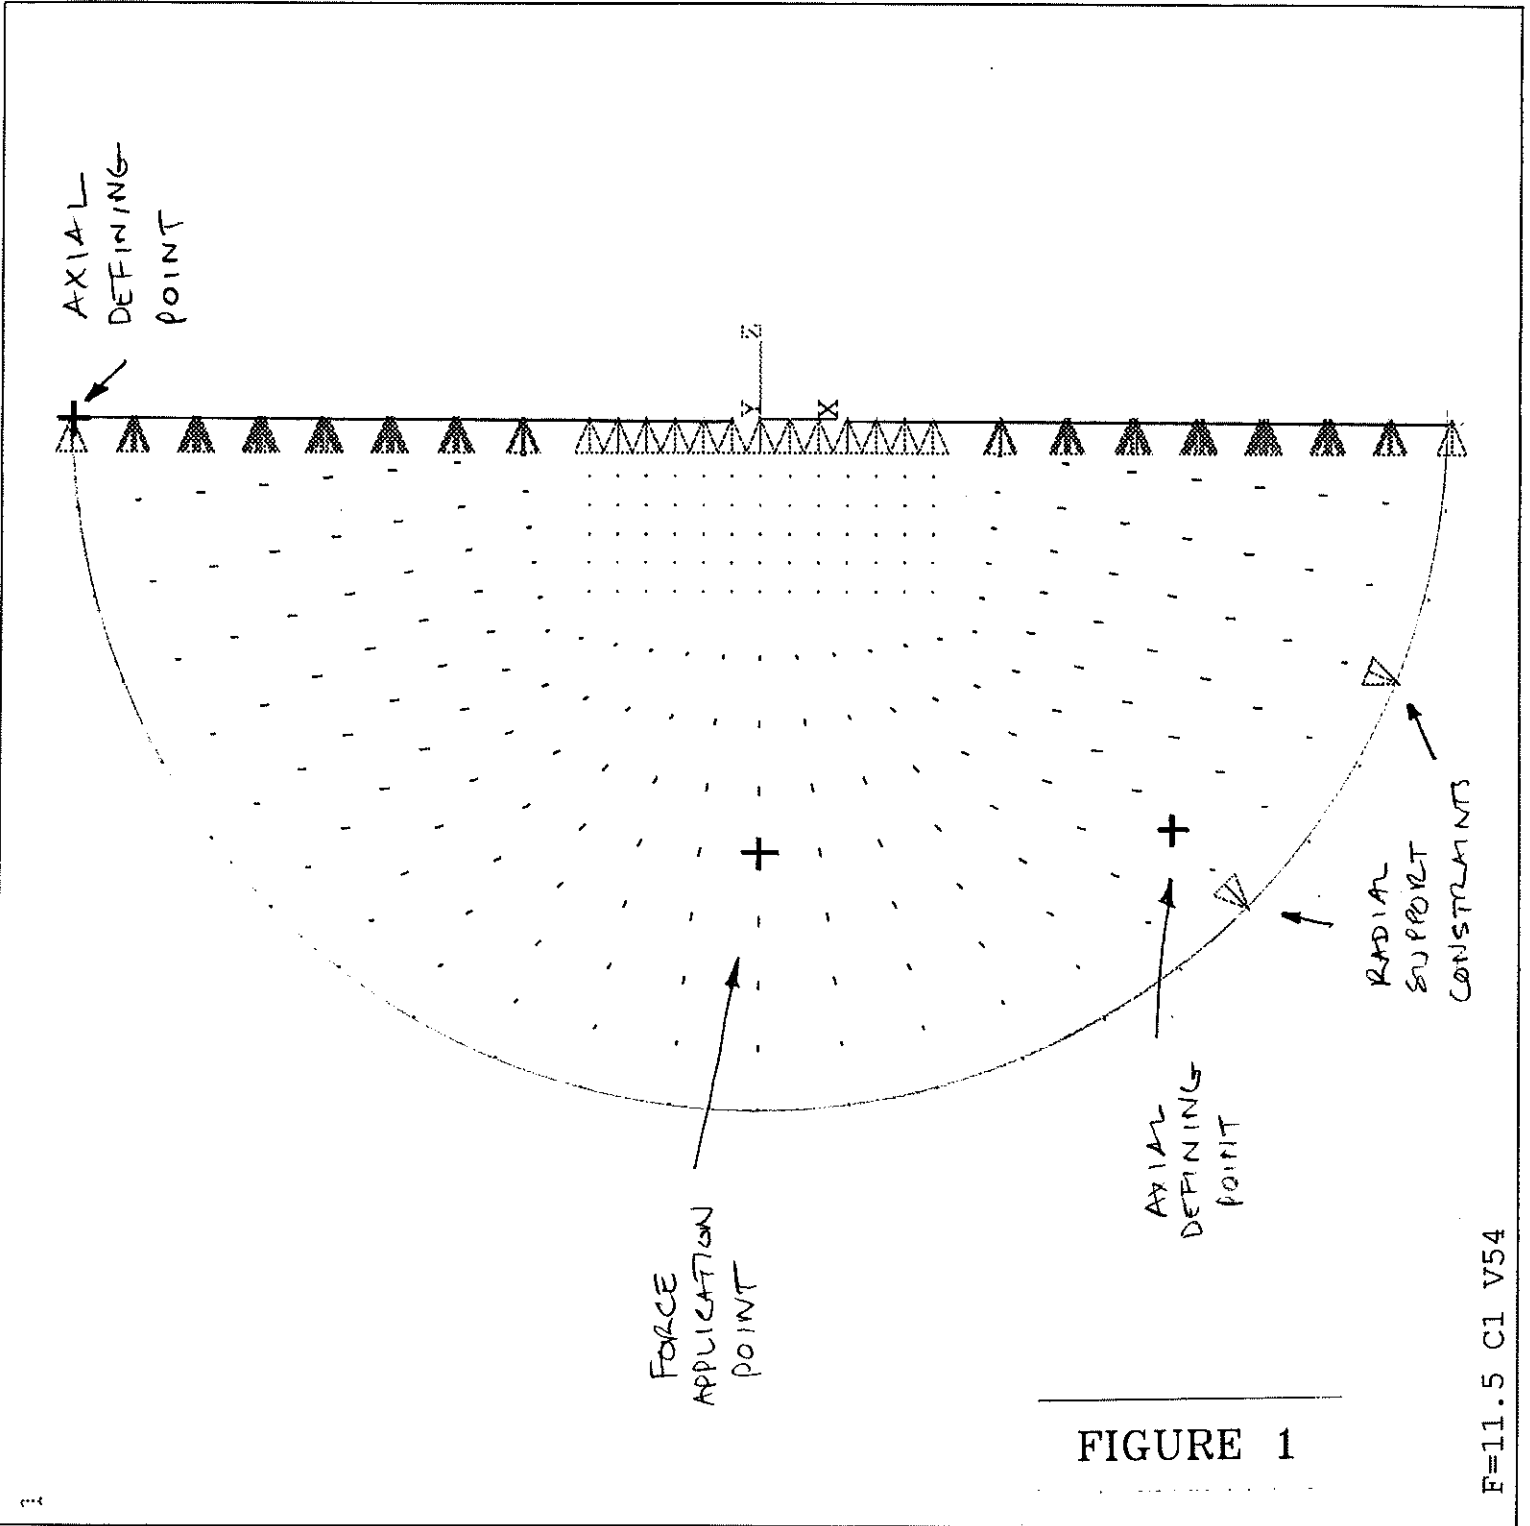

ANSYS 4.4A
JUL 22 1992
16:10:57
PLOT NO. 1
POST1 STRESS
STEP=2
ITER=1
UY
D GLOBAL
SMN =-0.358E-04
SMX =0.182E-04
TDIS

YV =-1
DIST=16.678
YF =1.68
ZF =-7.581
VUP =-X
FACE HIDDEN
-0.358E-04
-0.298E-04
-0.238E-04
-0.178E-04
-0.118E-04
-0.580E-05
0.194E-06
0.619E-05
0.122E-04
0.182E-04

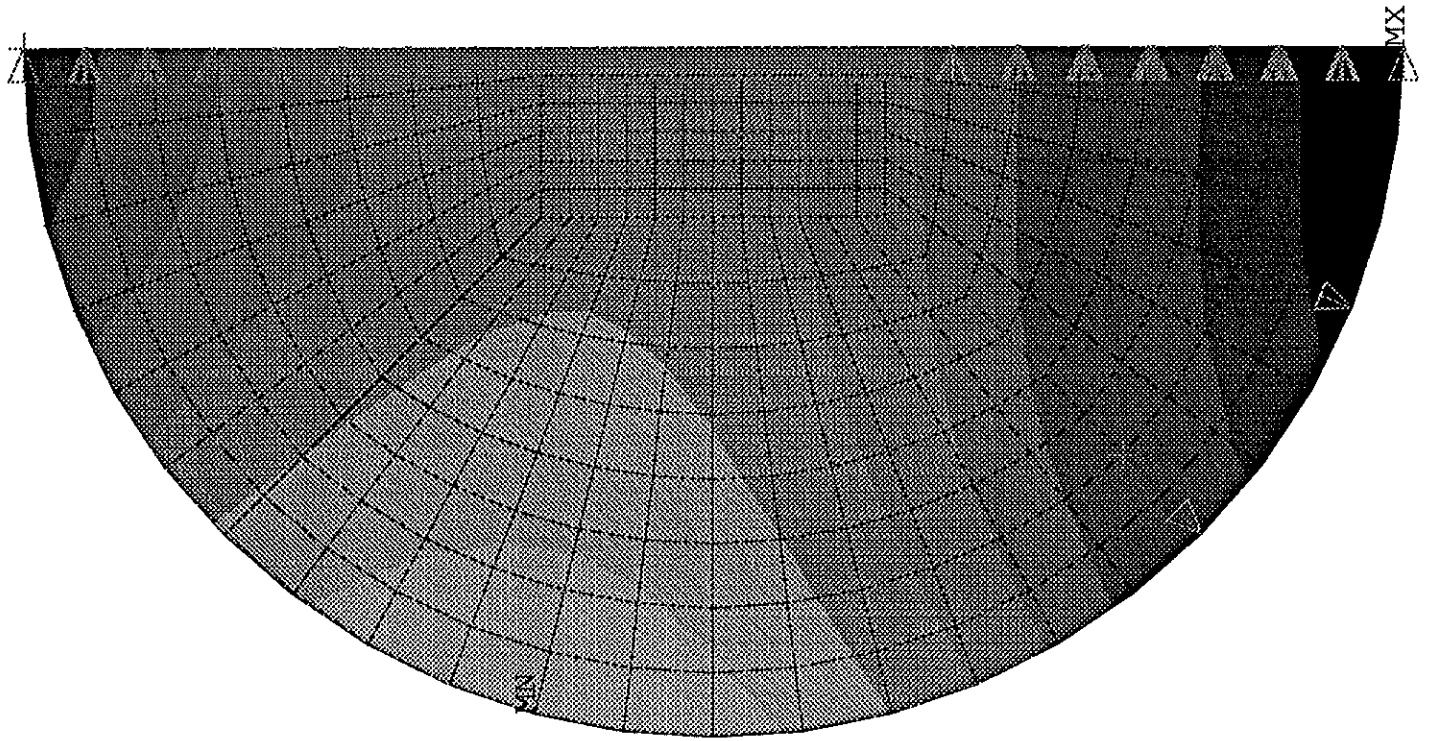


FIGURE 2

ANSYS 4.4A
JUL 22 1992
15:39:08
PLOT NO. 1
POST1 STRESS
STEP=3
ITER=1
UY

D GLOBAL
SMN =-0.558E-05
SMX =0.247E-05
TDIS

YV =-1
DIST=16.678
YF =1.68
ZF =-7.581
VUP =-X

FACE HIDDEN
-0.558E-05
-0.469E-05
-0.379E-05
-0.290E-05
-0.200E-05
-0.111E-05
-0.216E-06
0.678E-06
0.157E-05
0.247E-05

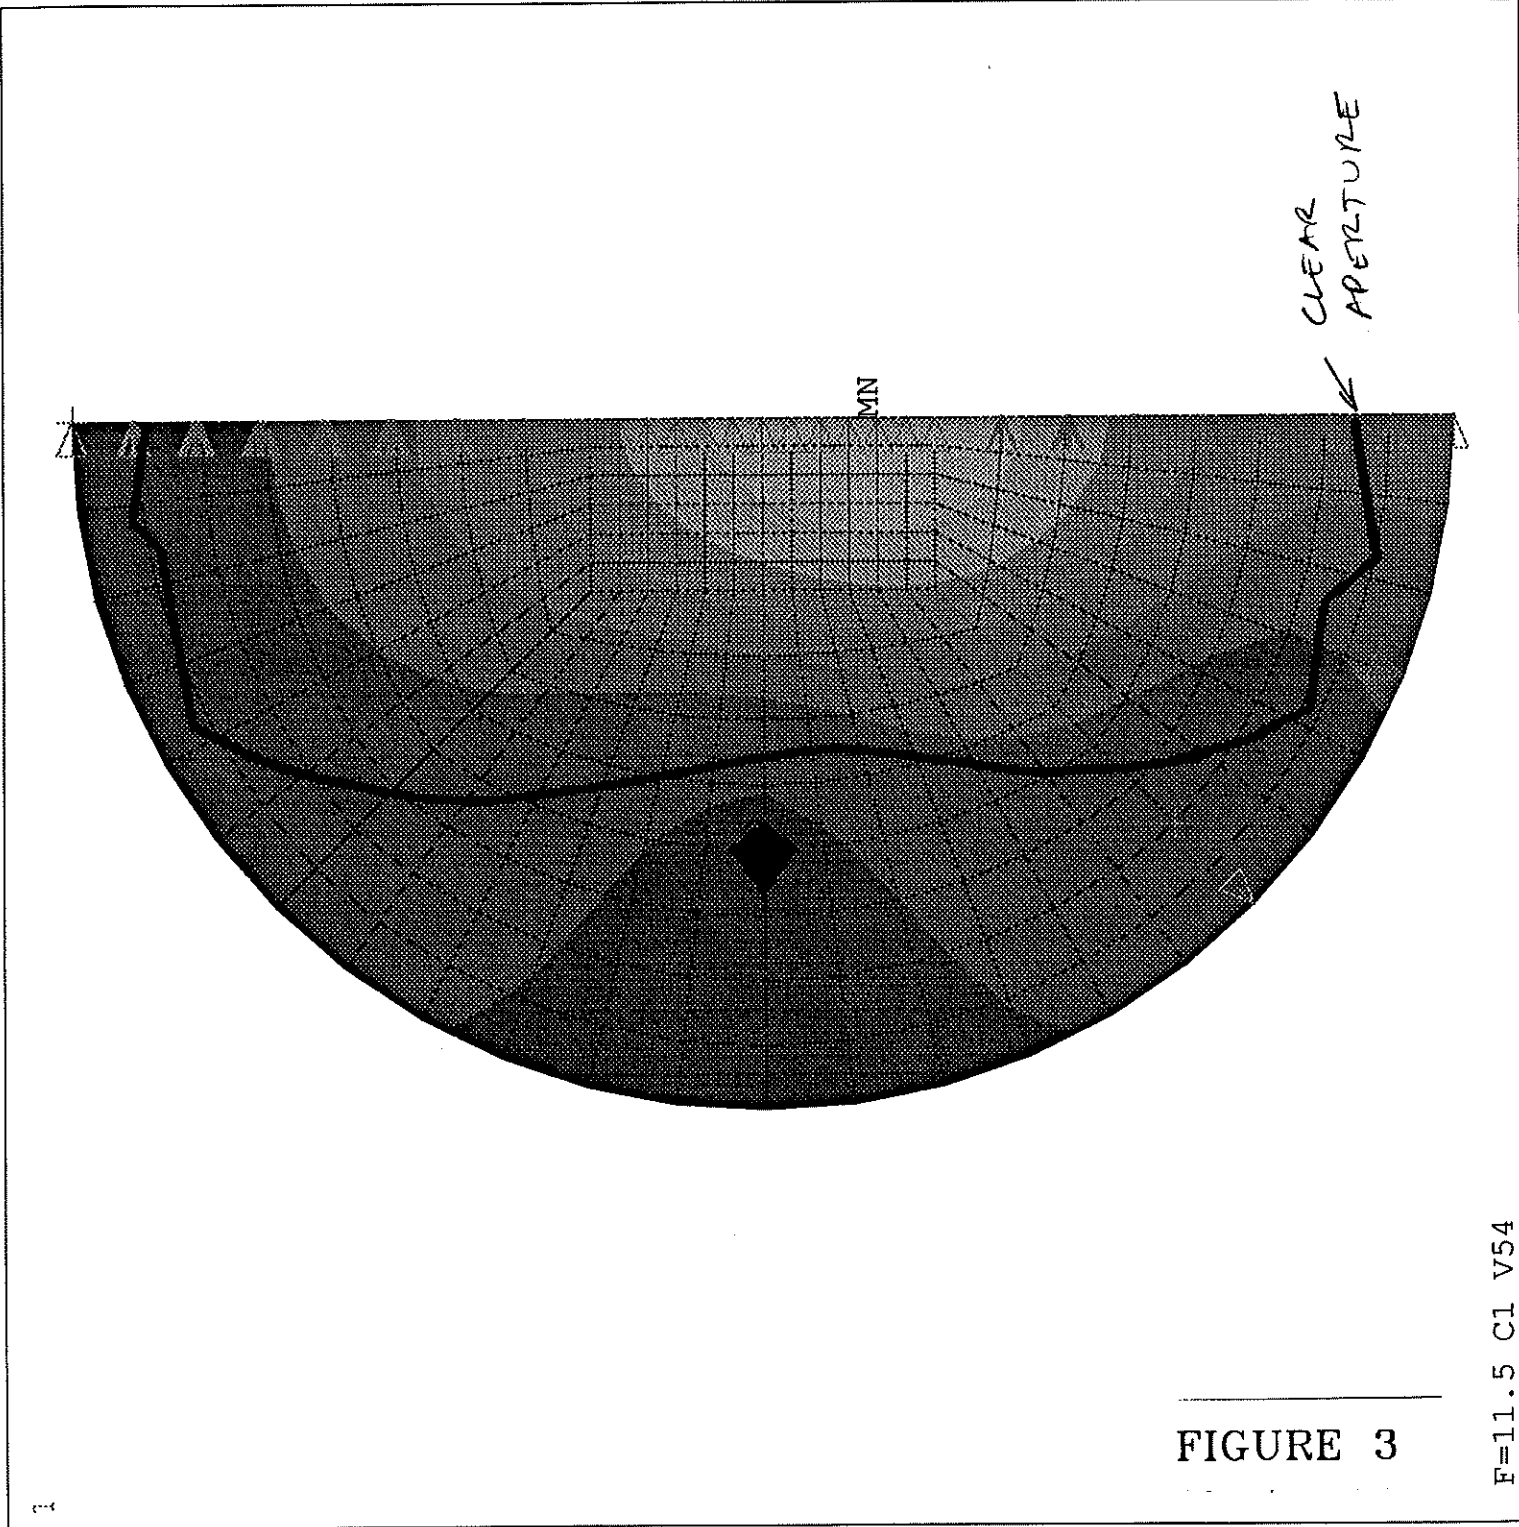


FIGURE 3

ANSYS 4.4A
AUG 18 1992
13:48:02
PLOT NO. 2
POST1 STRESS

STEP=2
ITER=1
UY

D GLOBAL

SMN =-0.298E-04

SMX =0.590E-05

TDIS

FORC

YV =-1

DIST=17.677

YF =-1.437

ZF =-8.035

VUP =-X

FACE HIDDEN

-0.298E-04

-0.258E-04

-0.219E-04

-0.179E-04

-0.139E-04

-0.997E-05

-0.600E-05

-0.203E-05

0.193E-05

0.590E-05

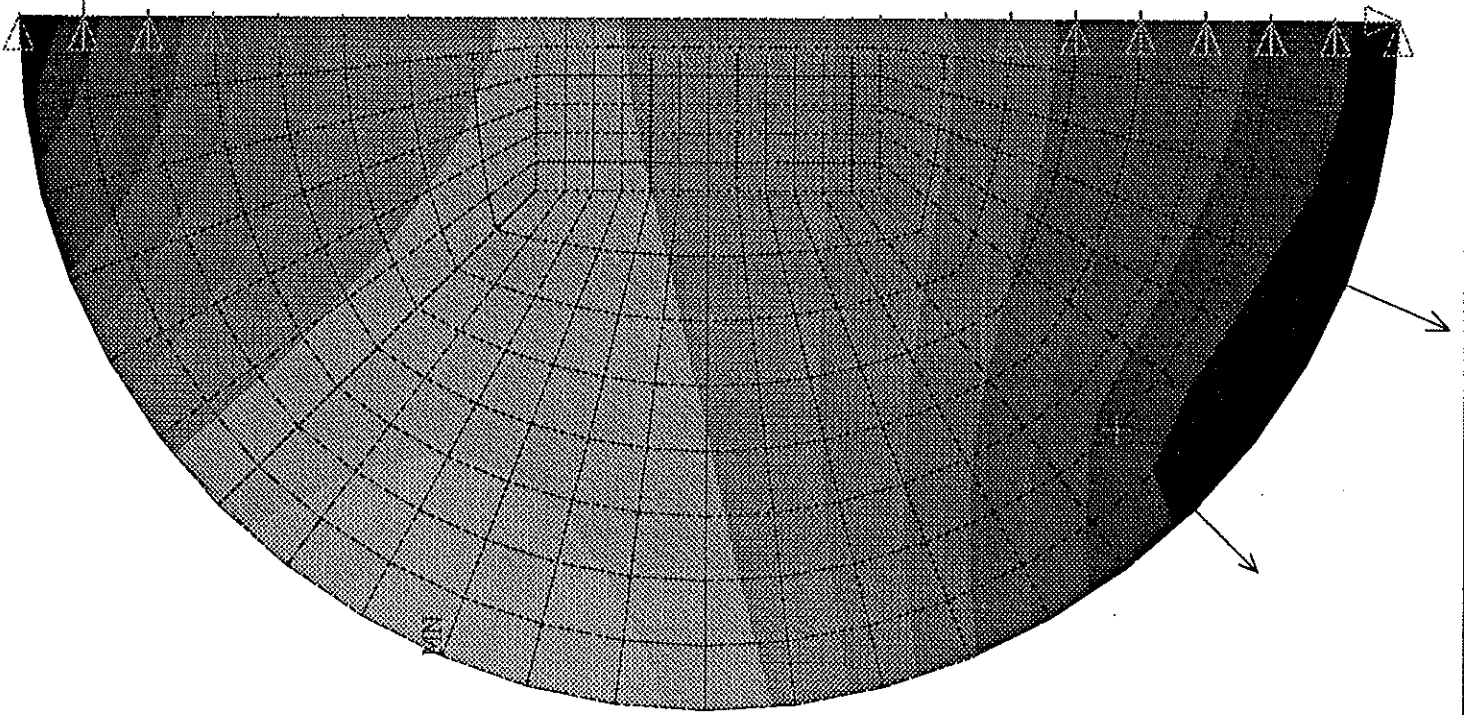


FIGURE 4

ANSYS 4.4A
AUG 18 1992
13:46:51
PLOT NO. 1
POST1 STRESS
STEP=1
ITER=1
UY

D GLOBAL
SMN =-0.686E-05
SMX =0.130E-05
TDIS
FORC

YV =-1
DIST=17.677
YF =-1.437
ZF =-8.035
VUP =-X

FACE HIDDEN

-0.686E-05
-0.595E-05
-0.504E-05
-0.414E-05
-0.323E-05
-0.232E-05
-0.142E-05
-0.510E-06
0.396E-06
0.130E-05

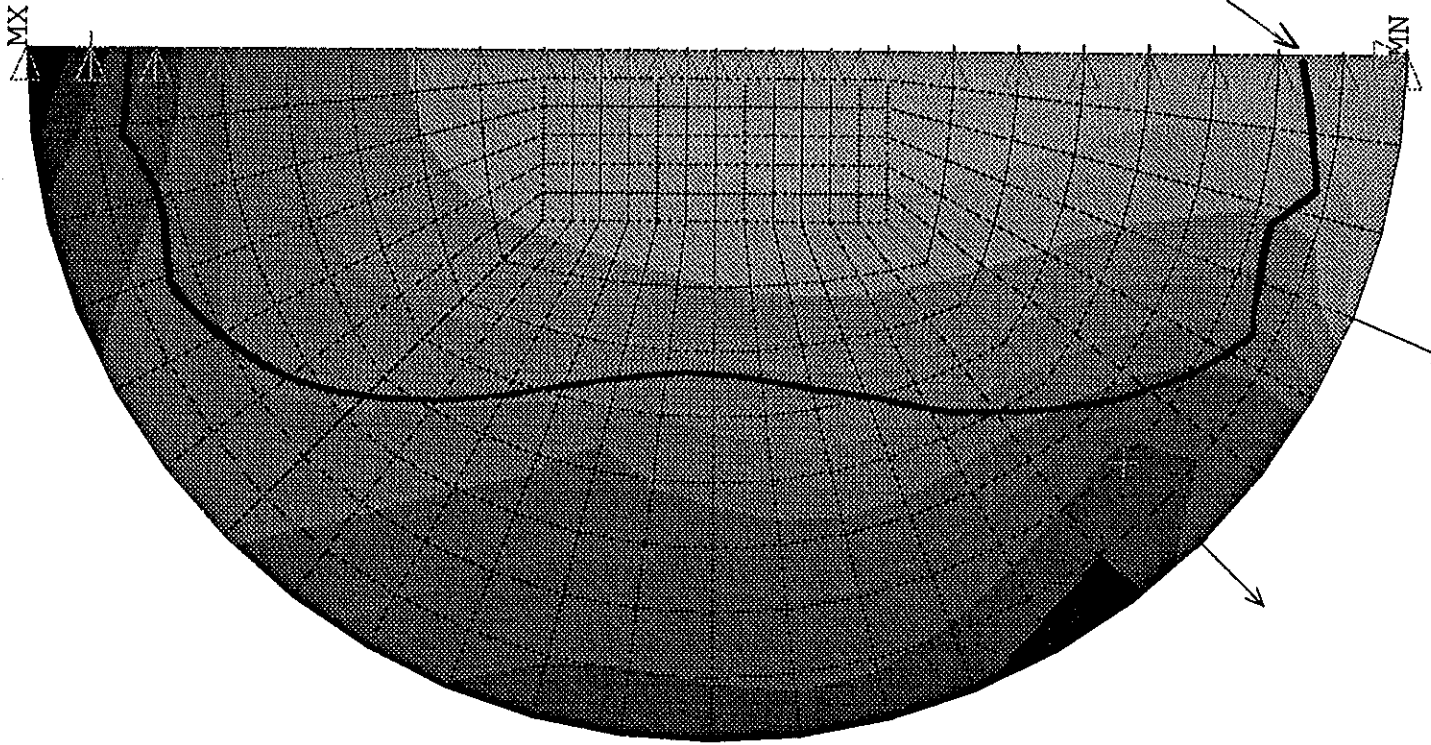


FIGURE 5

Corrector #2 7-17-92

10° lean

No Tweaking / 3 pt. support

File: ~~CRNF#1~~
CRNF#1
No Forces

#1

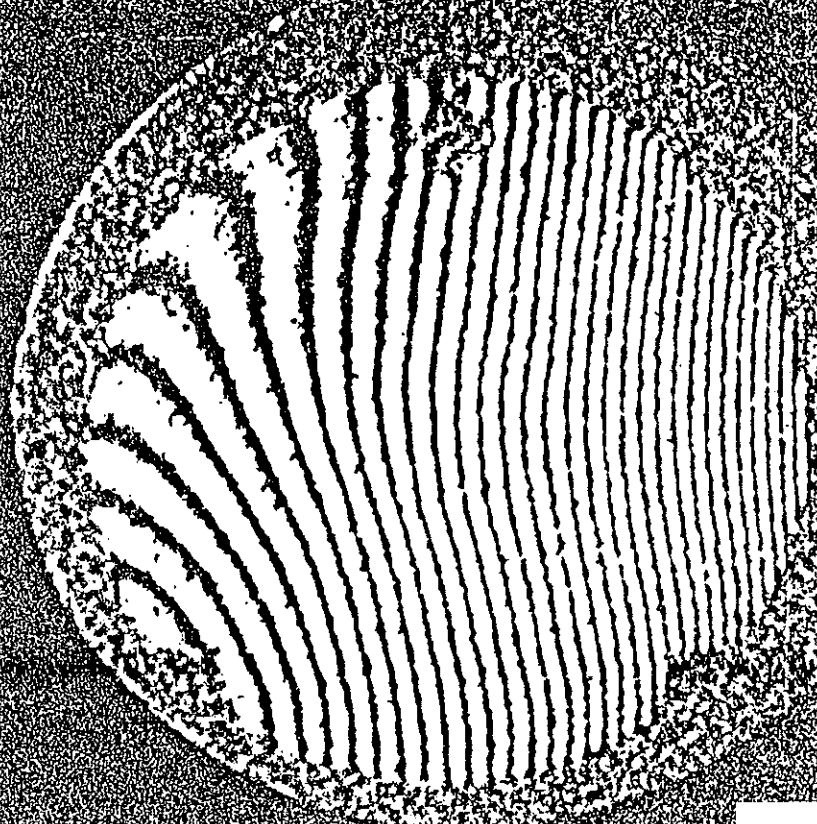


FIGURE 9

Corr #2 No Forces 08:29:44 08-02-92 TF

Rms: 0.747 P-V: 4.347


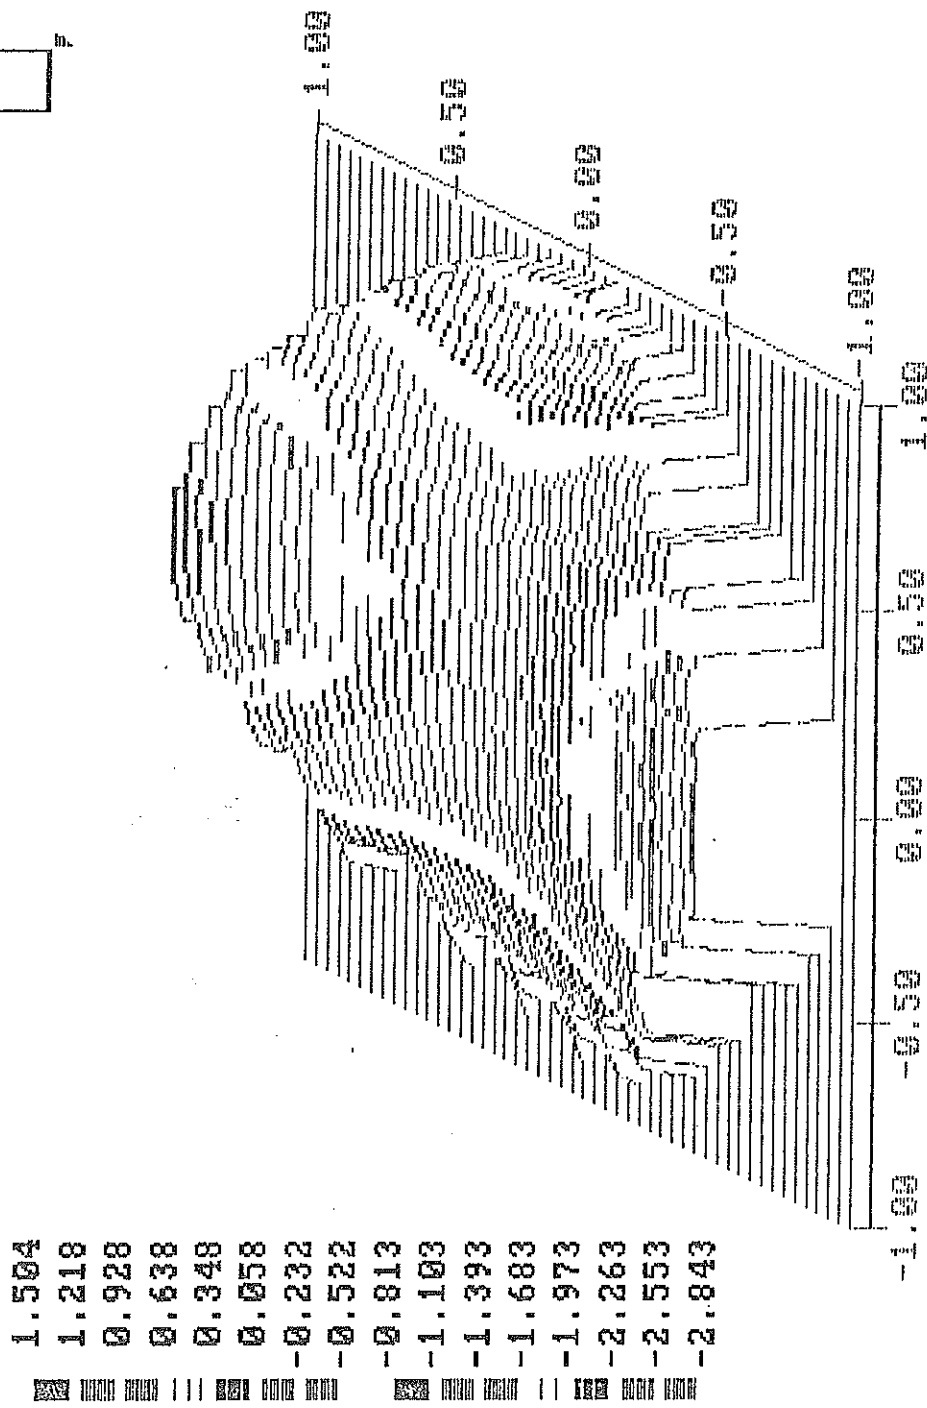


FIGURE 11

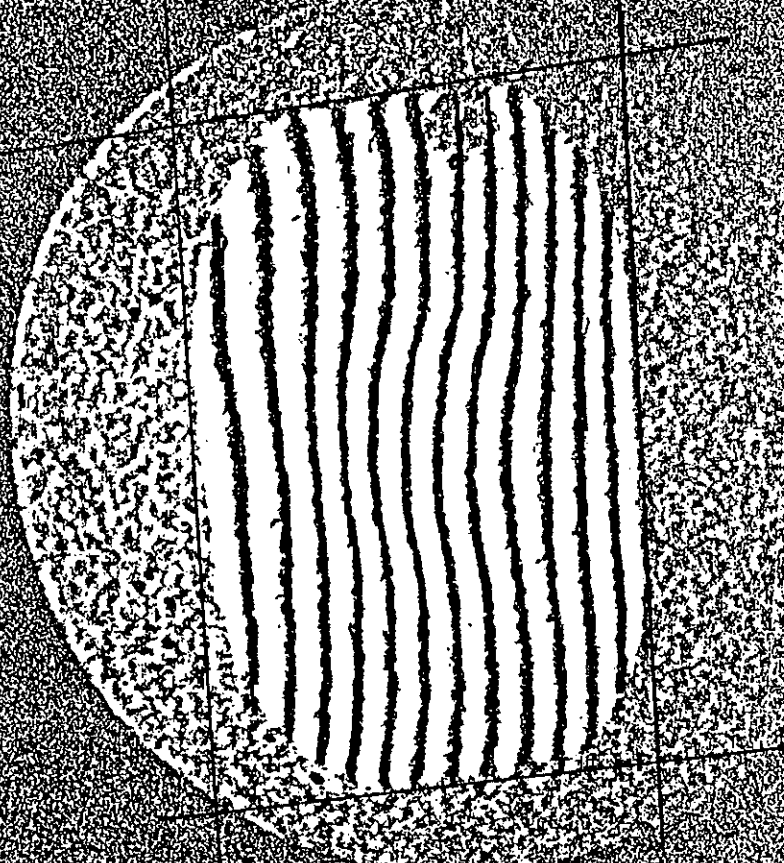

#1 Forces Applied 7-20-92
Masked C.A.

Corr. #2

File:
CR2FACAI

Final 10° Lean Test
Best Representative
Forces applied.

P-V. = .657

FIGURE 17

Corr2 Cell Forces CA 06:42:40 07-19-92

OPD data

TERM	RMS FIT	COEFFICIENTS			
TILT	0.103	-4.9845	-0.0879		
FOCUS	0.097	-4.9897	-0.0828	0.0653	
SEIDEL	0.060	-4.8561	-0.0934	-0.1466	-0.3611
		0.0887	0.1285	-0.0331	-0.1432


	AMT	ANGLE
TILT	5.113	180.4
FOCUS	0.194	
ASTIG	0.744	83.1
COMA	0.398	-14.5
SAG	-0.859	

TERMS REMOVED: TILT FOCUS

x center	y center	radius
50.00	50.00	39.81

DATA PTS	WEDGE	PEAK	VALLEY	P-V	RMS	STREHL RATIO
3096	0.50	0.222	-0.427	0.648	0.103	0.656

FIGURE 18

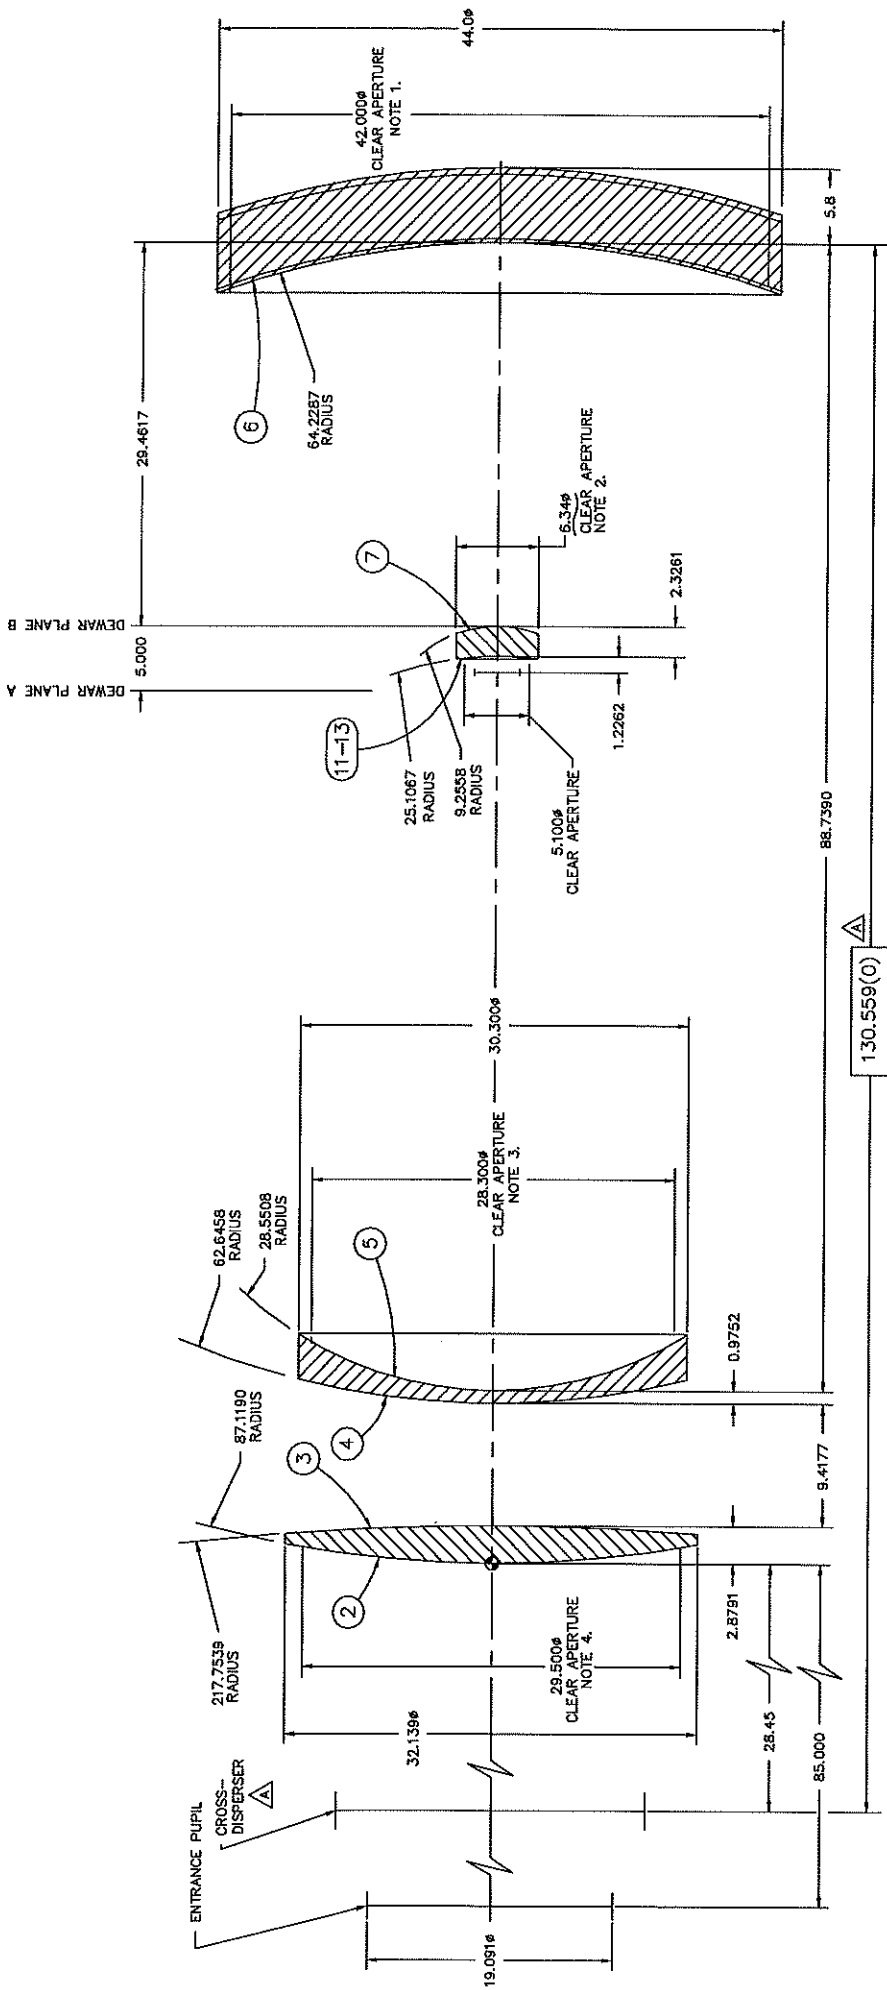

⊖ EPPS DESIGN #4052 (6/3/92)

FINAL "AS-BUILT" PRESCRIPTION
 USE WITH R=65.0" CONVEX TEK CCD
 T = 0°C
 THIS DRAWING REPLACES H0135, SUPER-DUPER II
 WHICH WAS EPPS DESIGN #7465 (11/15/90)
 THE FLAT FIELD VERSION #4753 IS DRAWING H0149.
 ⚠ 6.7° FOV (FIELD OF VIEW)

- NOTES:
1. 37.6036 CLEAR APERTURE FOR THIS CCD. SEE H5400-H5405, H5415, H0144 FOR DETAILS
 2. 6.349 C.A. FROM 6.449 BLANK SEE H7181 FOR LENS DETAIL
 3. 25.909 C.A. SEE H0136, H0142, H0145, H0147
 4. 27.139 C.A. SEE H0136, H0141, H0145


1/4

A	ENTRANCE PUPIL
B	ENTRANCE PUPIL

KECK/HIRES
 SUPER-DUPER CAMERA III
 AS-BUILT "CURVED FIELD"
 H0148.8

H5000	THIS DRAWING		
H5016	CELL DOOR VS. DEWAR CLEARANCE	H5700	OPEN
H5100	OPEN	H5800	FABRICATION AND TEST TOOLING H5807 OPTICS PALET L/O
H5200	CORRECTOR TOOLING		
	H5210 CORRECTOR TOOLS		
	H5214 CAMERA MIRROR TOOLS	H5900	FEA MODELS AND TEST
H5300	CORRECTOR CELLS AND SUPPORT STRUCTURE		
	H5303 CORRECTOR BASE ASSY (ISOMETRIC)		
	H5314 CORRECTOR CELL TOOLING L/O		
	H5324 MENISCUS CORRECTOR CELL ASSY		
	H5328 CORRECTOR CELL AXIAL SUPPORT ASSY'S		
	H5324 MEN. CORR. DOOR ASSY		
	H5349 BICONVEX CORRECTOR CELL ASSY		
	H5363 CORRECTOR CELL ASSEMBLY FIXTURE		
	H5370 BI-FOLDING DOOR ASSEMBLY	(H4532	CROSS DISPERSER DOORS VS BIFOLDING DOOR CLEARANCE)
H5400	CAMERA MIRROR AND TOOLING		
	H5401 CAMERA MIRROR L/O		
	H5409 CAMERA MIRROR SUPPORT ASSY (FOR STRASBAUGH)		
	H5411 CAMERA MIRROR 25" LAP (STRASBAUGH)		
	H5412 CAM. MIRROR 30" LAP (STRASBAUGH)		
	H5415 CAM. MIRROR (HEXTEK DRAWING)		
	H5420 BEAM1 RAYTRACE AT CAMERA PLANE		
	H5421 BEAM1 RAYTRACE OF TELESCOPE AND HIRES		
H5500	CAMERA MIRROR CELL		
	H5530 CAM. MIRROR RADIAL SUPPORT ASSY.		
	H5536 CAM. MIRROR AXIAL SUPPORT ASSY.		
	H5539 CAM. MIRROR TANGENT LINK ASSY.		
	H5541 CAM. MIRROR CELL SPIDER ASSY.		
	H550 CAM. MIRROR DOOR ASSY.		
H5600	FIELD FLATTENER		
	H56XX		


KECK/HIRES
 SUPERCAMERA
 LOCATING TREE
 10/1/72
 H5000

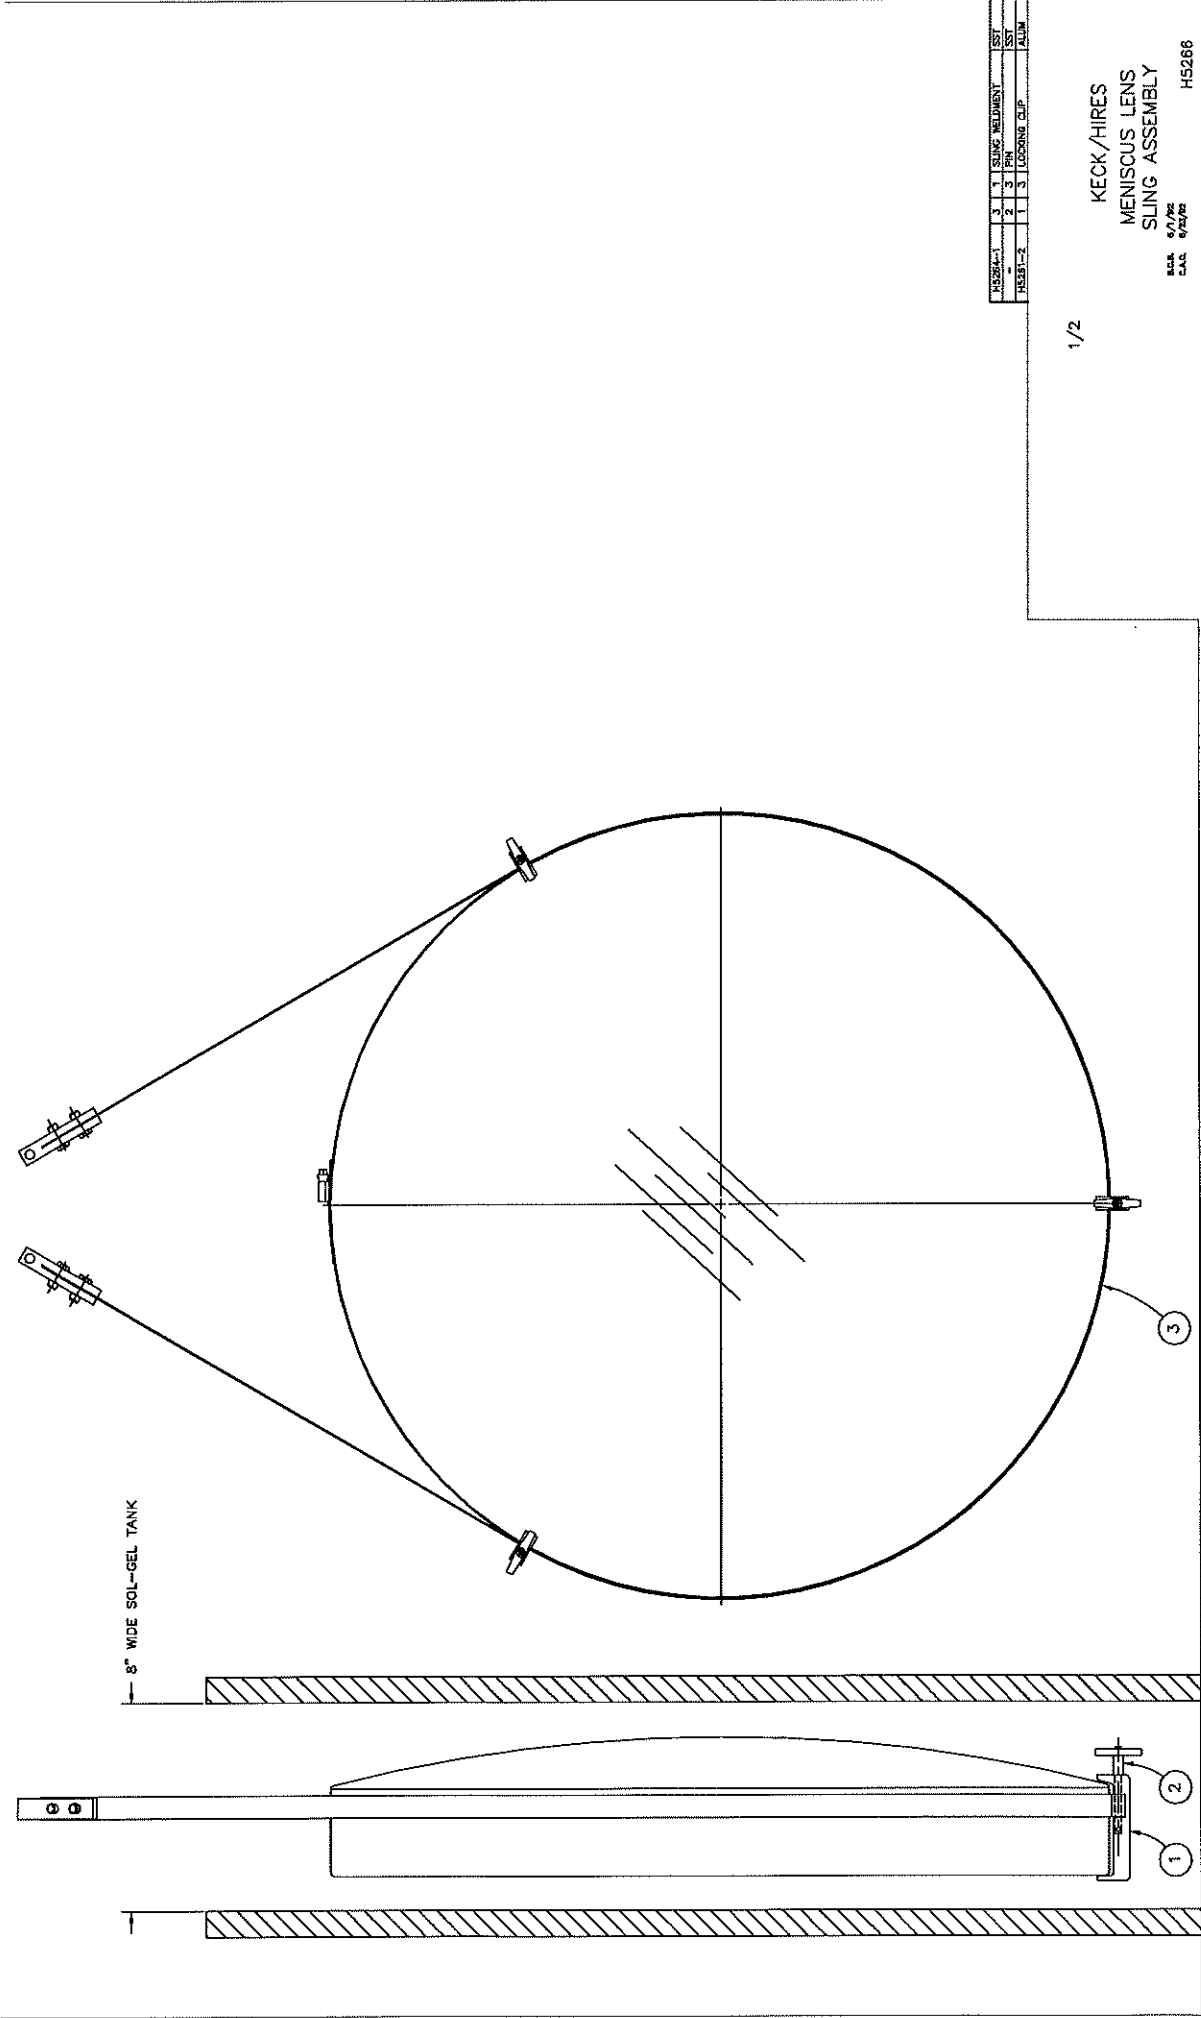

WASHER-1	3	1	SLING, HELDFAST	ST
ROSETTE-1	2	3	FRN	SSP
ROSETTE-2	1	3	LOADING CLIP	ALUM

1/2


KECK/HIRES
 MENISCUS LENS
 SLING ASSEMBLY
 MAR. 67/MS
 CAL. 67/MS
 H5266

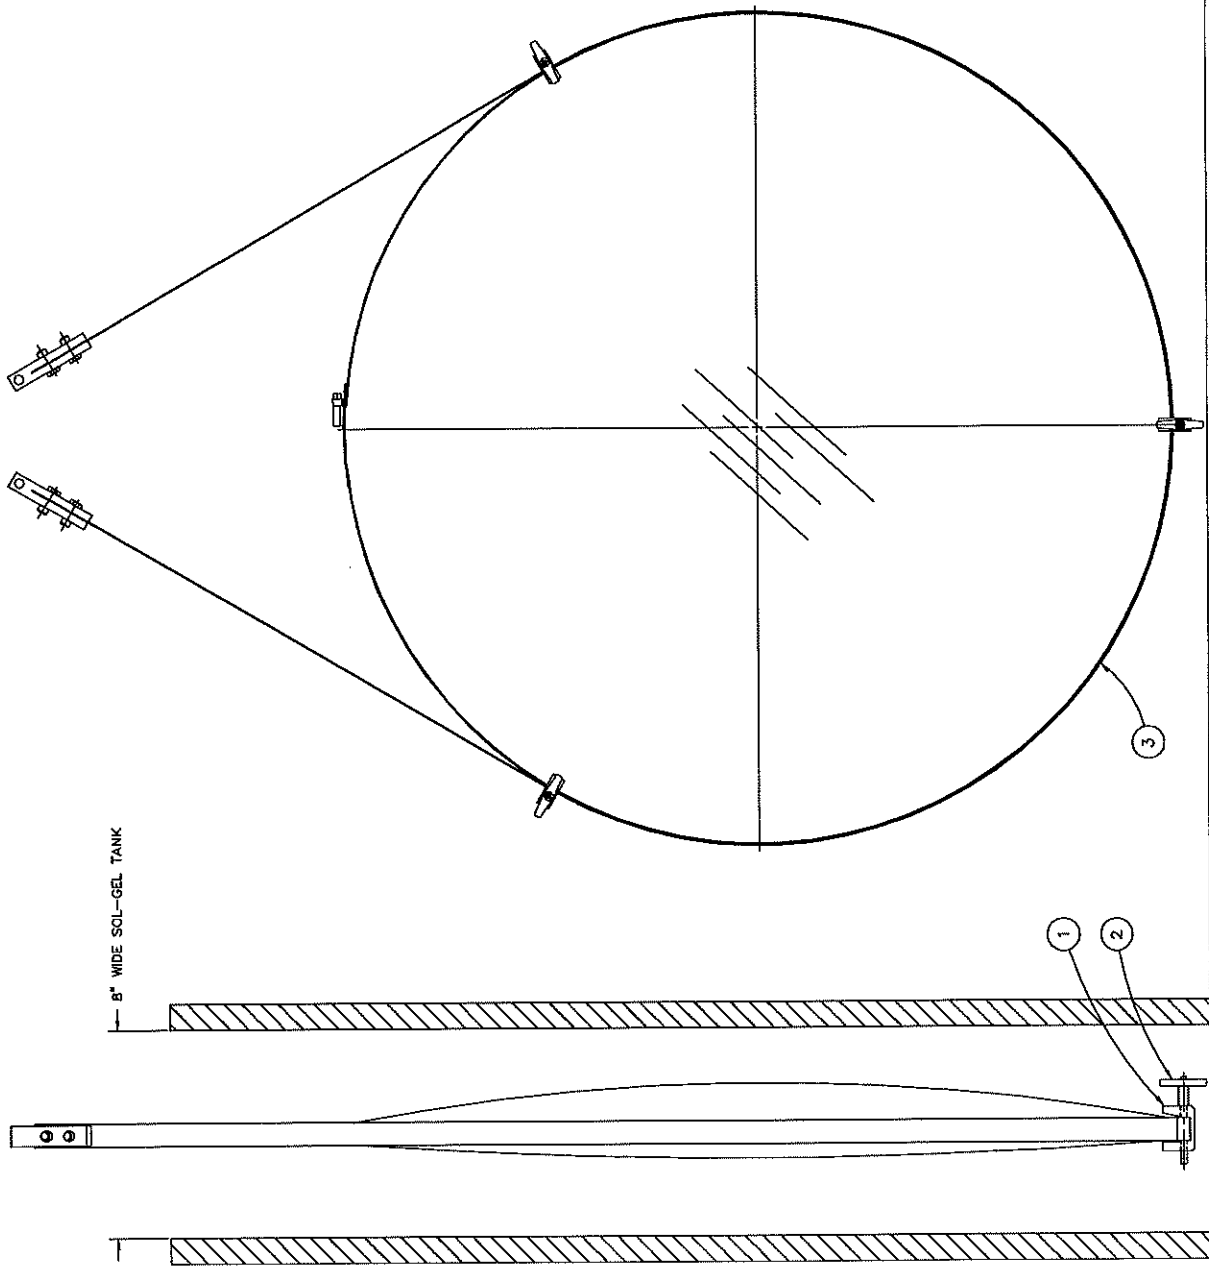


1/2

PK228-1	3	1	SLING WELDMENT	SST
	2	3	PIN	SST
PK228-5	1	3	LOCKING CLIP	ALUM

KECK/HIRES
 BICONVEX LENS
 SLING ASSEMBLY
 M.C.E. 8/1/62
 C.A.G. 8/21/62
 H5267

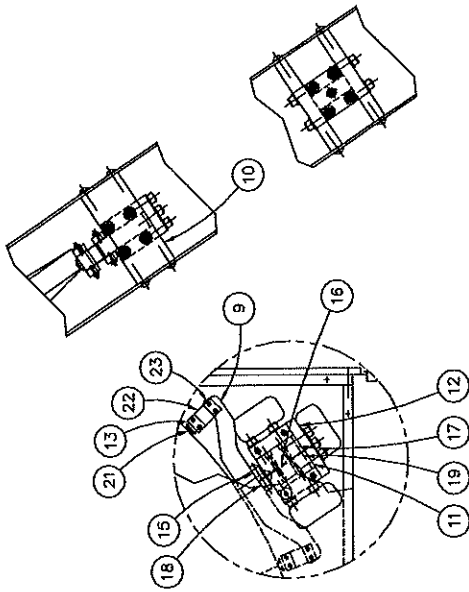

DETAIL A
SCALE 1/2

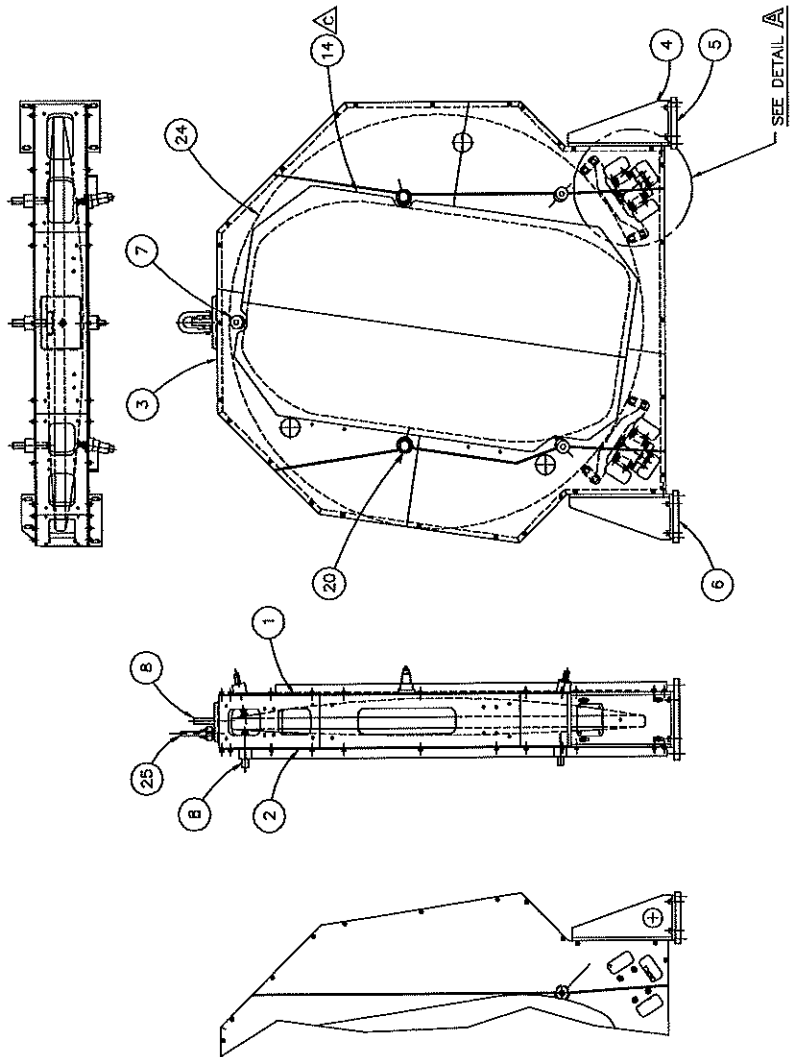

-1 BICONVEX CORRECTOR LENS CELL

1 REQ'D
NOTES:


- 1. SEE H5370 AND H5376 FOR OPENER AND CLOSER DETAIL.
- 2. SEE H5383 FOR MANUAL DOOR LATCHES.

1/4


KECK/HIRES
BICONVEX CORRECTOR CELL
ASSEMBLY
H5349.C
R.C.B. 010
C.A.G. 0230

A	1/2" DIA	UPDATE PER AS BUILT
B	1/4" DIA	REVISED WITH DOOR MOD.
C	1/2" DIA	REVISION 01-19-82 DOOR


H5376-1	25	1	BRASS DOOR	STEEL
H5376-2	26	1	BRASS CORRECT. LENS	ST. STEEL
H5383-4	23	4	CLAMP	ST. STEEL
H5383-2	22	4	SPRING	ST. STEEL
H5383-1	21	2	CONTACT POINT	ALUM.
H5383-5	19	2	CLAMP	ALUM.
H5383-4	18	2	CLAMP	ALUM.
H5383-3	17	2	CLAMP	ST. STEEL
H5383-2	16	2	SPRING	ST. STEEL
H5383-1	14	2	CLAMP	ALUM.
H5383-5	13	2	CONTACT SUPPORT	ST. STEEL
H5383-4	12	2	BASE PLATE	ST. STEEL
H5383-3	11	4	SIDE PLATE	ST. STEEL
H5383-2	10	2	ROCKER ARM	ALUM.
H5383-1	8	4	RETAINING POINT	ALUM.
H5383-7	7	3	DEFINING POINT	ST. STEEL
H5383-3	6	1	INSULATING PLATE	ST. STEEL
H5383-4	5	1	CELL MOUNT WELD	ST. STEEL
H5383-1	3	1	BRASS CORRECT. CELL W/D	ST. STEEL
H5383-1	2	1	BACK PLATE WELD	ST. STEEL
H5383-1	1	1	FRONT PLATE WELD	ST. STEEL

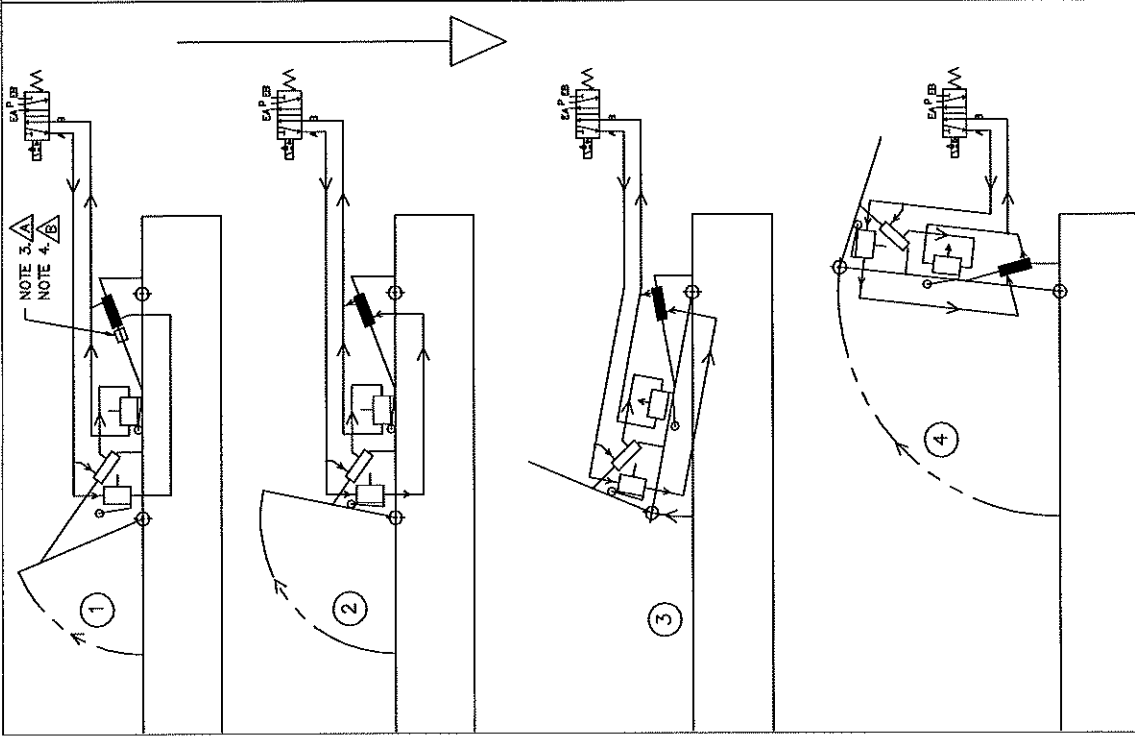

OPENING SEQUENCE

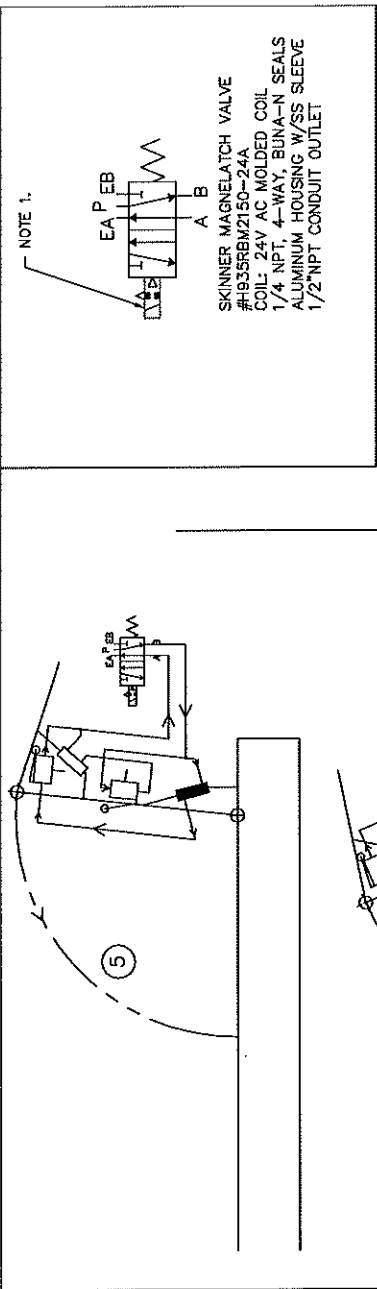

CLOSING SEQUENCE

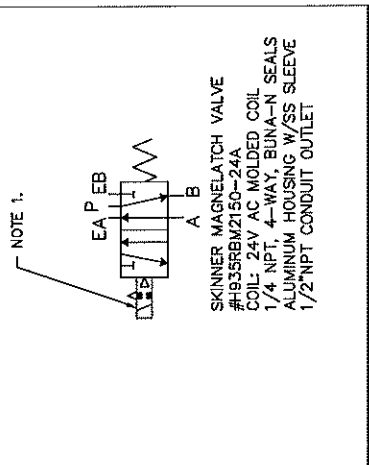

(-i) PNEUMATIC PLAN

OPENING AND CLOSING SEQUENCES

NOTES:

1. LATCHING SOLENOID #CV5-LAAM-F24, SKINNER ELECT-AIR 245 SINGULAR FRONTAGE RD MILPITAS, CA 95035 (408) 262-2252.
2. ADD ARO SWITCH TO THIS SWITCH POSITION.
3. SPRING-OPERATED BRAKE, AIR-RELEASED.
4. MAIN DRIVE CYLINDER ADDED. BRAKE WAS NOT NEEDED AND SO WAS REMOVED.

- ⚠ NOTE 3
- ⚠ NOTE 4
- ⚠ NOTE 2


N/A

KECK/HIRES
 BI-FOLD DOOR
 PNEUMATIC PLAN

10 10 82

H5375.B


A	DATE	BY
B	DATE	BY
C	DATE	BY

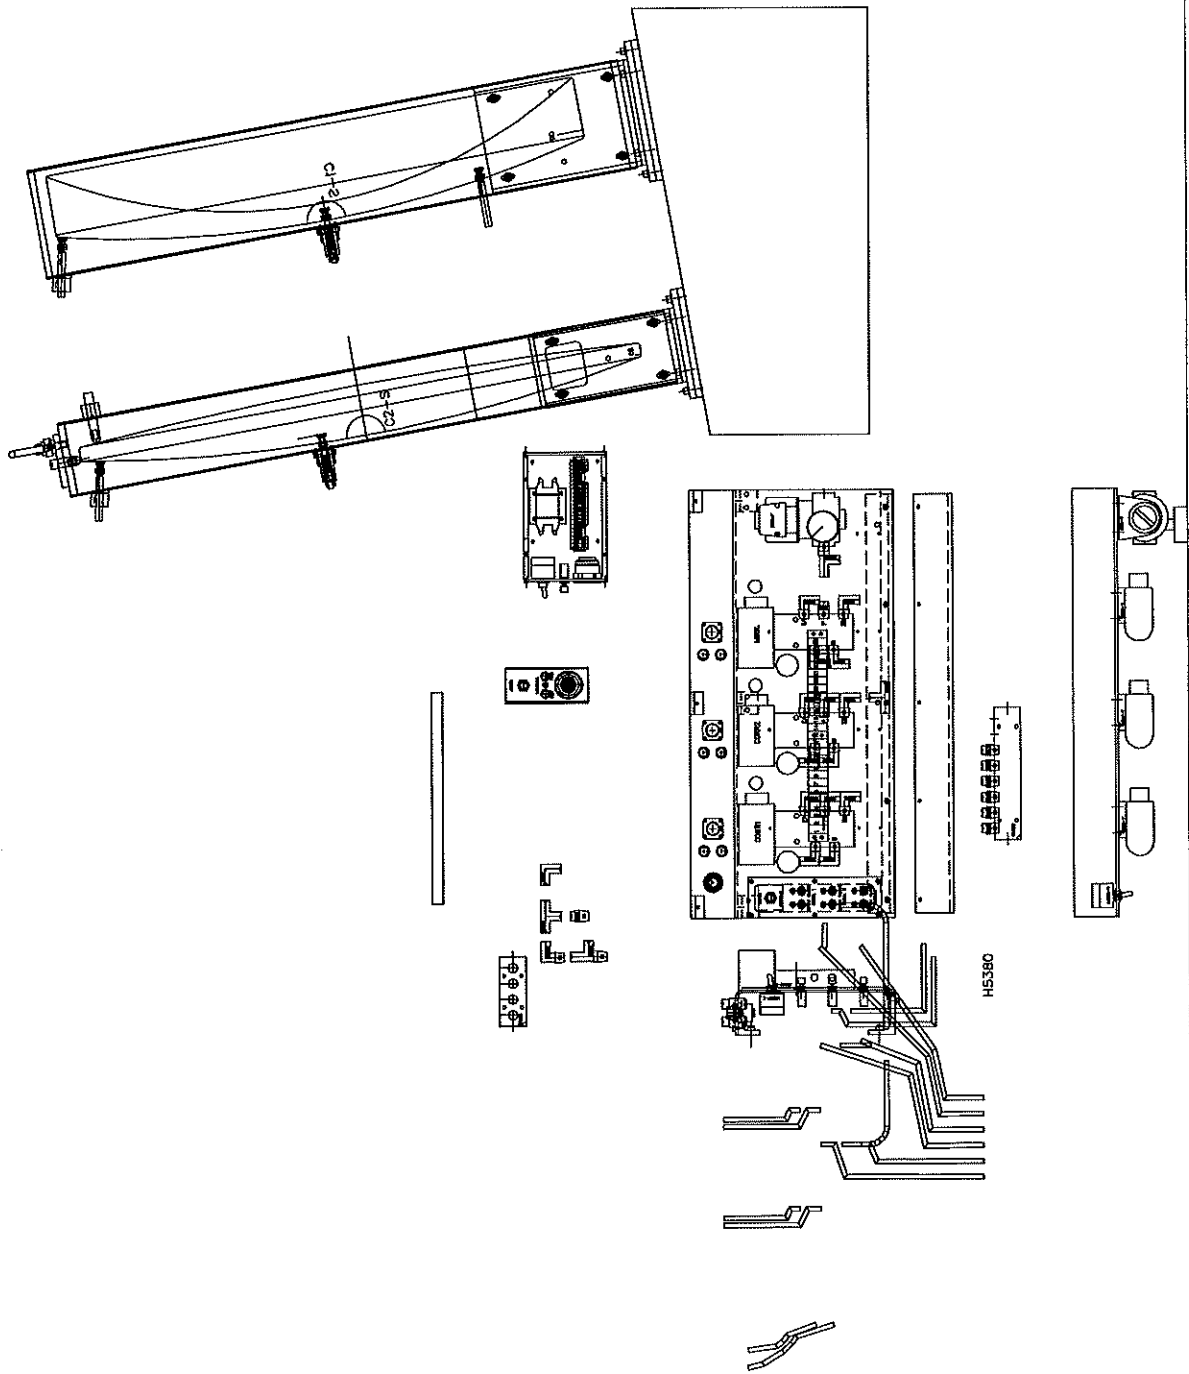

N/A

A. JAMES JO REORGANIZED FOR PRINTING

KECK/HIRES
 CORRECTOR CELLS
 AIR SYSTEM LAYOUT
 BCB 2 18 62
 H5380.A

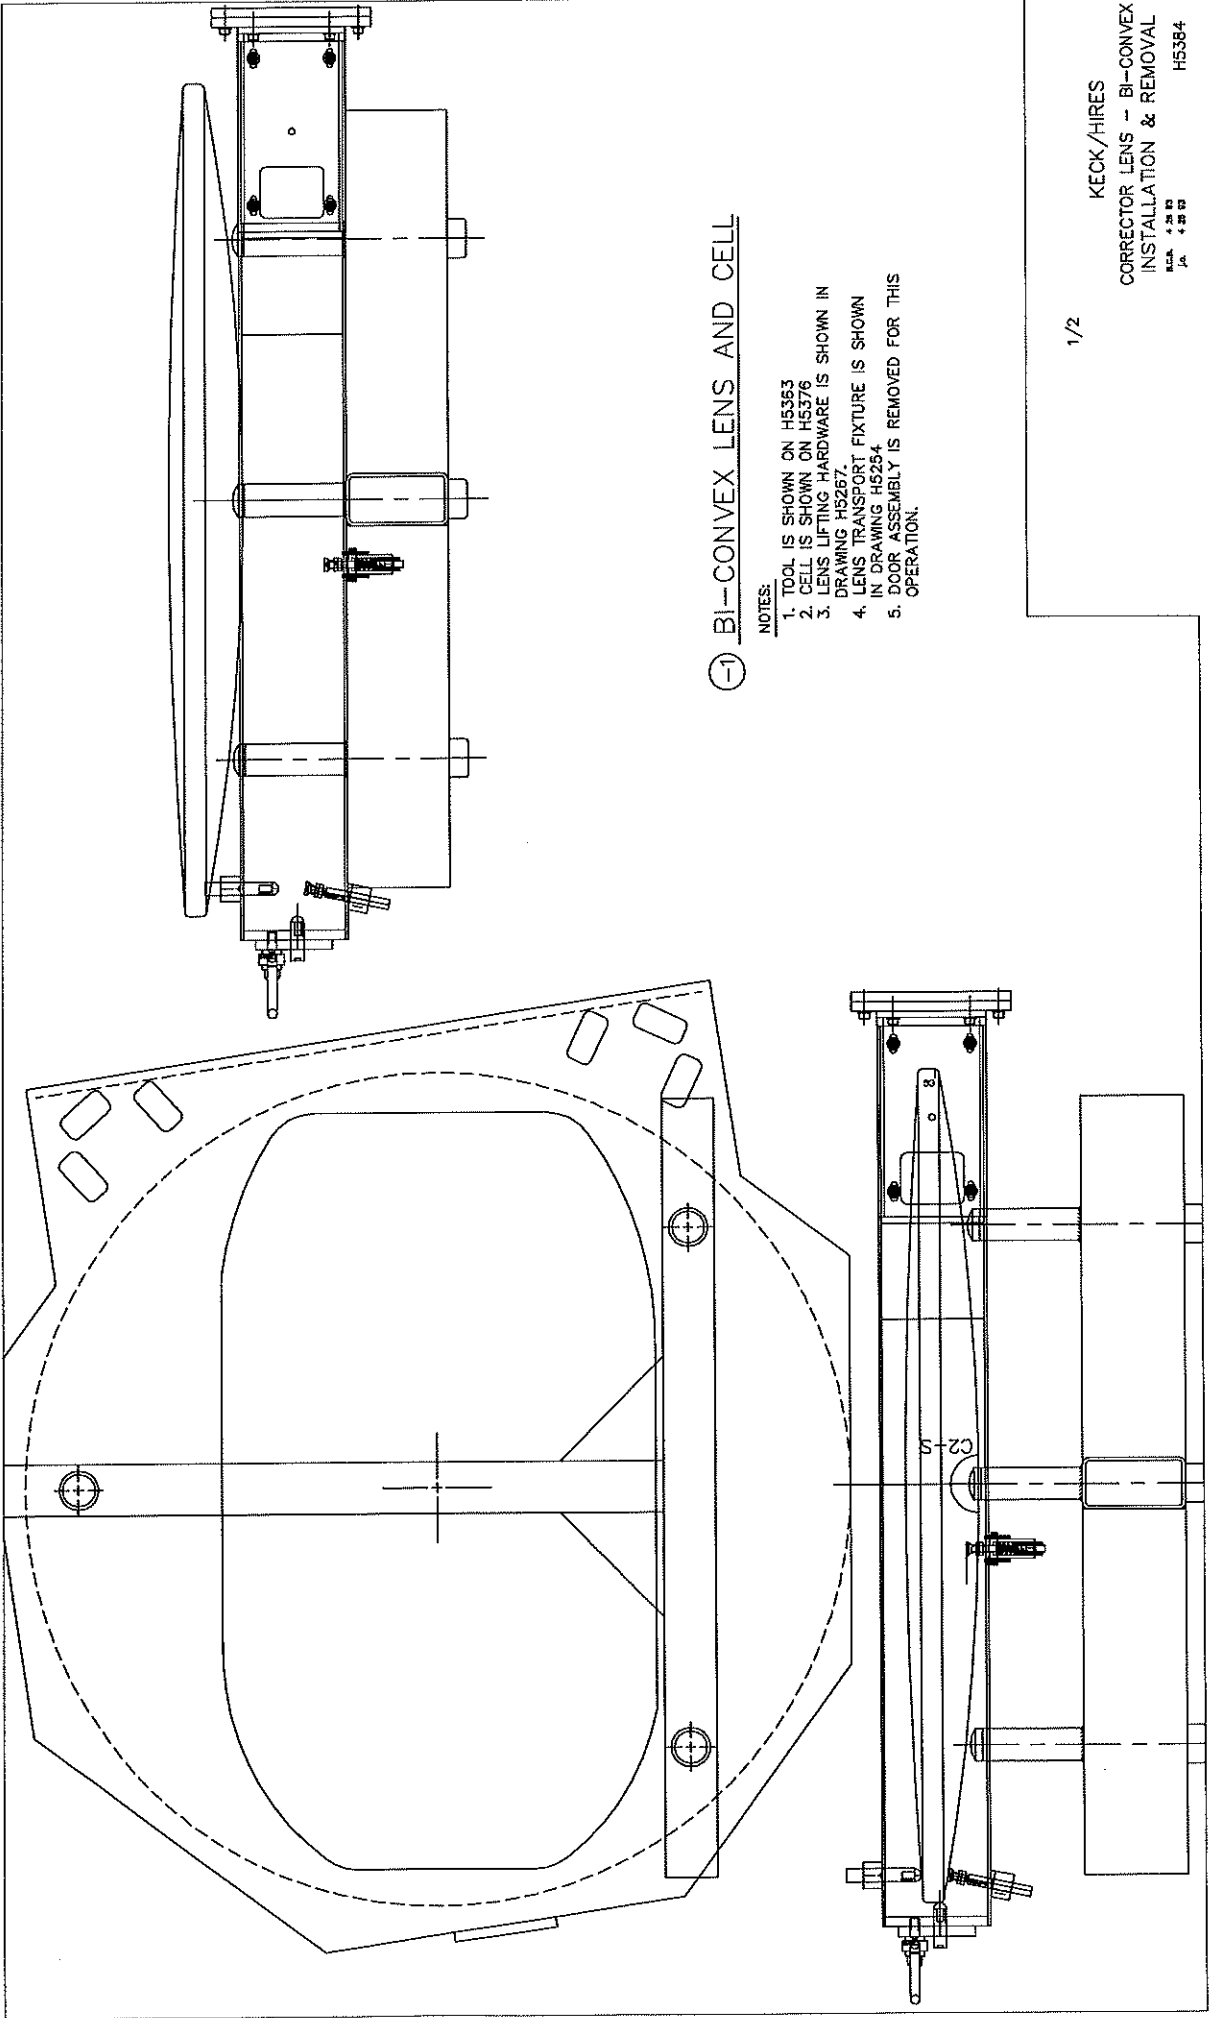


① BI-CONVEX LENS AND CELL

NOTES:

1. TOOL IS SHOWN ON H5353
2. CELL IS SHOWN ON H5376
3. LENS LIFTING HARDWARE IS SHOWN IN DRAWING H5267.
4. LENS TRANSPORT FIXTURE IS SHOWN IN DRAWING H5254
5. DOOR ASSEMBLY IS REMOVED FOR THIS OPERATION.

1/2

KECK/HIRES
 CORRECTOR LENS - BI-CONVEX
 INSTALLATION & REMOVAL
 1/2 4 25 80
 1/2 4 25 80
 H5384

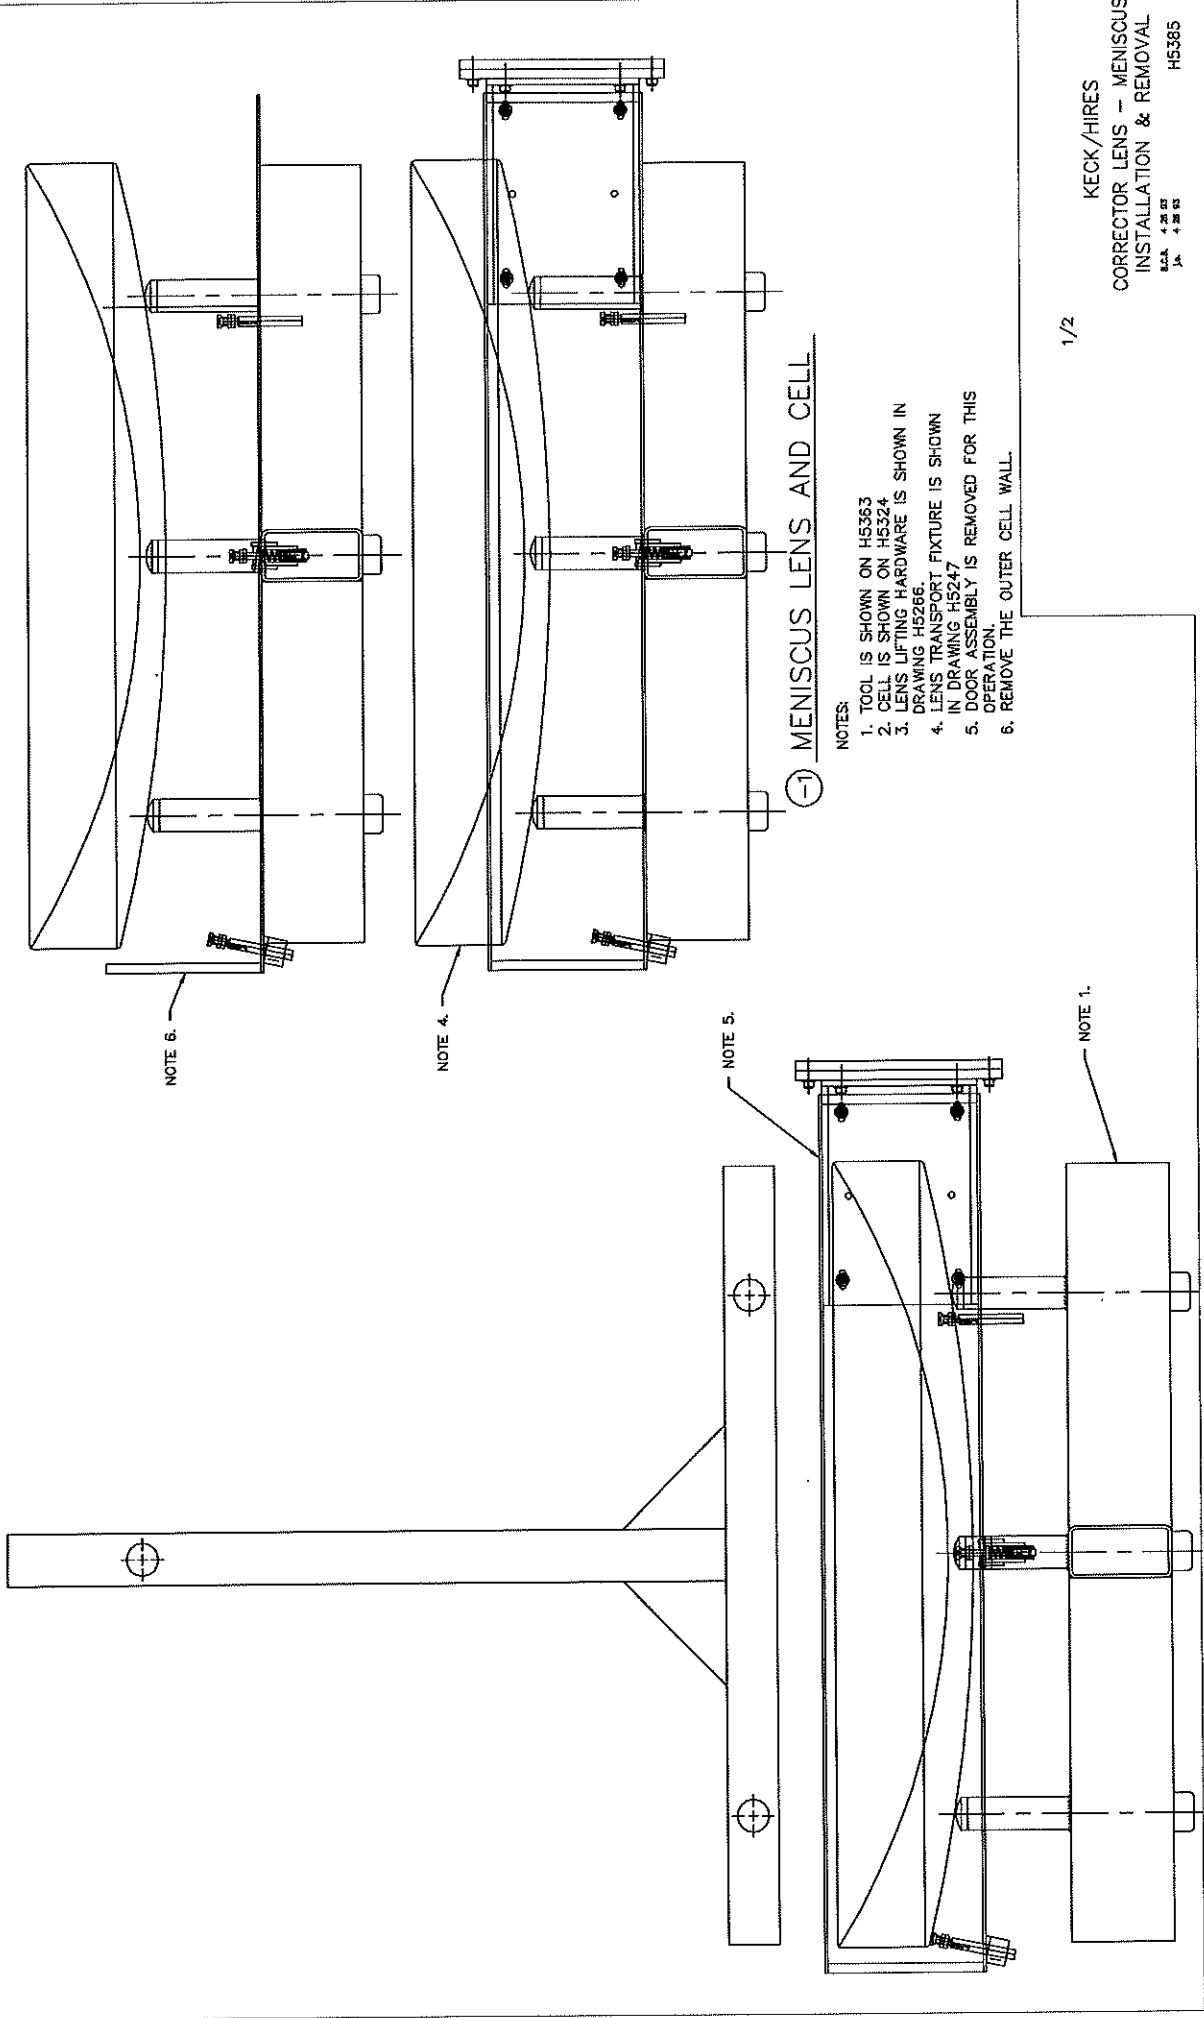


⊖ MENISCUS LENS AND CELL

NOTES:

1. TOOL IS SHOWN ON H5363
2. CELL IS SHOWN ON H5324
3. LENS LIFTING HARDWARE IS SHOWN IN DRAWING H5266.
4. LENS TRANSPORT FIXTURE IS SHOWN IN DRAWING H5247
5. DOOR ASSEMBLY IS REMOVED FOR THIS OPERATION.
6. REMOVE THE OUTER CELL WALL.

1/2

KECK/HIRES
 CORRECTOR LENS - MENISCUS
 INSTALLATION & REMOVAL
 JAN 4 2003
 H5365

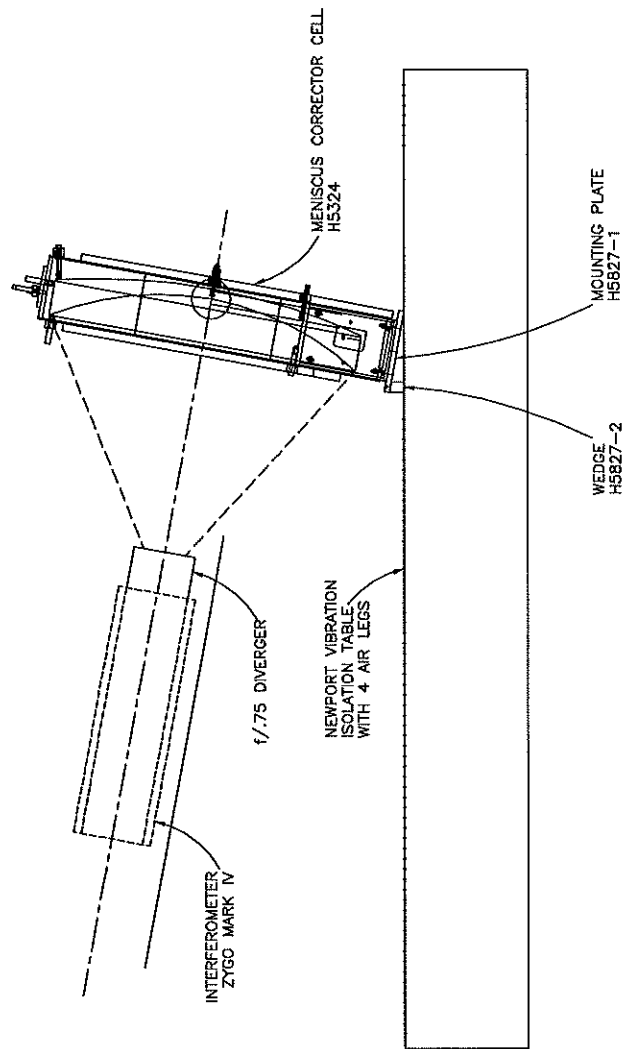

.2

KECK/HIRES
MENISCOUS LENS
10" TEST SET-UP
B.C.B. 8/1/82
D.A.G. 8/2/82
H5626.A

Appendix W HIRES Control Functions

August 1, 1991

HIRES Control Functions

prepared by Jack Osborne

see /u/jack/text/hires17.cf

1. ECHELLE MOSAIC

- a. 1 DC motor: 50 in-oz minimum, 1000 RPM.
- b. Rotation limits: (2 primary, 2 secondary)
- c. Encoder, linear, to measure 1 micron over 100 mm travel. This represents 0.32 arc-sec least count over about 9° total travel.
- d. An air-operated brake will be required.
- e. An air-operated cover will be used. (2 limits)
- f. Dual fiducials using an interrupter in conjunction with stage encoder index track.
- g. 'Brake off' is a special privilege requiring a password.

2. CROSS-DISPERSER (Uses a Heidenhain rotary incremental encoder with 3 arc-sec resolution: 10,800 lines with x40 logic = 432,000)

- a. 1 DC motor: 50 in-oz min, 1000 RPM.
- b. Encoder interface to Heidenhain electronics driver box is required.
- c. Limits for about 30 degrees rotation. (2 primary and 2 secondary)
- d. An air-operated, *user-optional* brake will be required.
- e. An air-operated cover will be used. (2 limits)
- f. A dual fiducial system like "ECHELLE MOSAIC" above.

3. CAMERA FOCUS (aka DEWAR FOCUS or DETECTOR FOCUS)

- a. 1 DC motor: 50 in-oz min, 1000 RPM.
- b. Linear encoder: position to 5 microns with 140 mm travel.
- c. Limits: 2 primary and 2 secondary.
- d. Electric-operated fail-safe brakes will be required.
- e. A dual fiducial system like "ECHELLE MOSAIC" above.

4. SHUTTER
 - a. Opening solenoid (spring return, so that shutter closes on power failure).
 - b. Magnetic reed switch sensing open condition.
5. DARK SLIDE
 - a. A slow-moving dark cover for the detector. Air cylinder, 2 limits.
6. FILTERS (2 wheels of 12 positions right behind the slit)
 - a. 2 DC motors: 50 in-oz min, 1000 RPM.
 - b. No limits.
 - c. Encode 12 positions each wheel using motor encoder.
 - d. A fiducial will be used for indexing each wheel.
7. TV Guiding
 - a. Focus: DC motor: 50 in-oz min, 1000 RPM.
 - b. Encode using motor encoder.
 - c. Limits: 2 primary and 2 secondary.
 - d. Two filter wheels of 8 positions each. See "FILTERS" above.
 - e. Aperture adjuster: DC motor and f-stop ring; 50 in-oz min, 1000 RPM.
 - f. Shutter (Ilex or equivalent)
8. COMPARISON LIGHTS
 - a. 6-position linear stage; 6" each, moves parallel to slit jaws.
 - b. 1 DC motor: 50 in-oz min, 1000 RPM.
 - c. Limits: 2 primary and 2 secondary.
 - d. Motor encoder is used for each of 6 positions.
 - e. A mirror is positioned by an air cylinder. (2 limits)
9. DECKER SLIDE (aka SLIT ACCESSORY SERVER)
 - a. 4 positions, linear motion.
 - b. DC motor is 50 in-oz min., 1000 RPM.
 - c. Encoding is done by using motor encoder.
 - d. Limits: 2 primary and 2 secondary
10. SLIT
 - a. A bilateral slit will be used. (both sides move, keeping the center fixed)
 - b. DC motor: 50 in-oz min, 1000 RPM.
 - c. Limits: 2 primary and 2 secondary.
 - d. Encoding will measure 0.001" (0.03 arc-sec on the sky), over 0.25" travel (each jaw). (Use the motor encoder to do this.)
11. CAMERA MIRROR (44" diameter) will be stationary.
 - a. Air-operated cover. (2 limits)

12. COLLIMATOR MIRRORS (17" diameter) Red and Blue.

- a. 2-position stage uses 2 air cylinders. Either Red or Blue mirror is "in".
- b. Limits: 2.
- c. Air-operated clamp will be required.
- d. Air-operated covers. (2 limits per cover = 4 limits total) Covers are interlocked, in software, with stage limits so that a cover may be opened only for the "in" position mirror.
- e. User with special password may open mirror cover which is in "out" position.
- f. Focus will be required. (1" travel)
 - DC motor: 50 in-oz min, 1000 RPM.
 - Encoding is via the motor encoder.
 - Limits: 2 primary and 2 secondary.
 - Electric-operated fail-safe brakes will be required.

13. ACCESS PORT TO SEAL HIRES (Near the slit)

- a. Air-operated hinged door. (2 limits)

14. FILTER WHEEL / COMPARISON LIGHTS

- a. 1 DC motor: 50 in-oz min, 1000 RPM.
- b. No limits.
- c. Encode 12 positions with motor encoder.
- d. A fiducial will be used for indexing.

15. LOCAL LOCKOUT

- a. This feature prevents injury to a worker inside the instrument. Lockout status will be visible at all control stations.
- b. The lockout switch is located at the spectrograph and its status should be obvious.

NOTES:

1. Dual fiducials: All moving stations have at least 1 fiducial (an optical interrupter) At power-up this indicates which side of center you are. Coarse center-locating is done with this fiducial. A fine fiducial comes with the encoders on the three stages which use separate encoders. Position information then comes from the incremental encoder.
2. The "core" HIRES has no field rotator and so has no need for an X-Y stage for the TV.
3. The TV zoom function will be by "pixel-binning".

4. The 6 comparison source positions could each have up to 3 separate lamps (and lamp controllers). The stage will scan a single source along the slit or be driven to one of 6 pre-selected positions.
5. Limits: Secondary (heavy duty) will be the Microswitch DTE6 enclosed style. All others will be the low current Microswitch BZ style (we usually call these "logic" limits).

= modified or new items since last change.

See also drawing # H0200.E .

Distribution: HIRES file (Osborne)

Vogt

Bigelow

Jern


Kibrick

Ricketts

Delaney

Tucker

Bresee

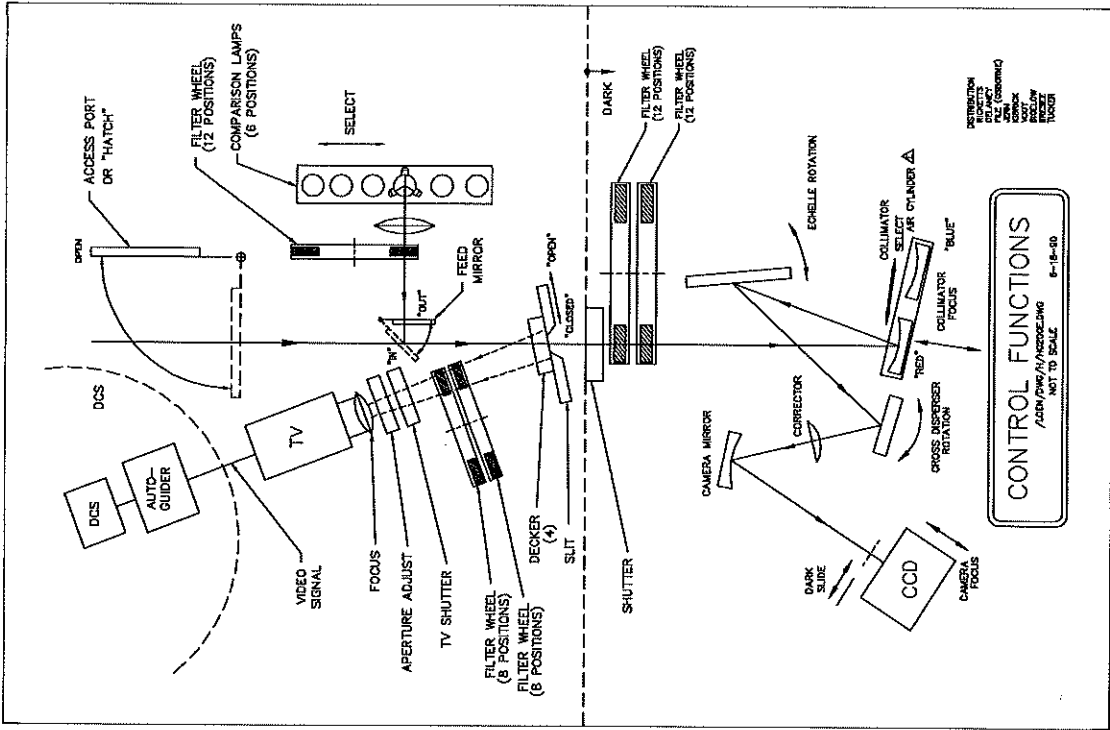

CONTROL FUNCTIONS
 ADDN CHG/REV/REVISIONS
 6-18-80
 NOT TO SCALE

DEFINITION
 DCS DATA CONTROL SYSTEM
 TV TELEVISION CAMERA
 VIDEO SIGNAL
 AUTO-GUIDER
 TELEVISION CAMERA
 TELEVISION CAMERA

REV	DATE	DESCRIPTION
A	1-1-80	ISSUE
B	1-1-80	ISSUE
C	1-1-80	ISSUE
D	1-1-80	ISSUE
E	1-1-80	ISSUE
F	1-1-80	ISSUE
G	1-1-80	ISSUE
H	1-1-80	ISSUE
I	1-1-80	ISSUE
J	1-1-80	ISSUE
K	1-1-80	ISSUE
L	1-1-80	ISSUE
M	1-1-80	ISSUE
N	1-1-80	ISSUE
O	1-1-80	ISSUE
P	1-1-80	ISSUE
Q	1-1-80	ISSUE
R	1-1-80	ISSUE
S	1-1-80	ISSUE
T	1-1-80	ISSUE
U	1-1-80	ISSUE
V	1-1-80	ISSUE
W	1-1-80	ISSUE
X	1-1-80	ISSUE
Y	1-1-80	ISSUE
Z	1-1-80	ISSUE

KECK/HIRES
 CONTROL FUNCTIONS
 SCHEMATIC

Appendix X Glossary

1. TPI is threads per inch, referring to screws and nuts. 5 TPI means that each revolution advances the nut $1/5$ inch or 0.20" per rev.
2. CCD is charge-coupled device referring to the main HIRES Super-Duper Camera detector or the TV guider photo-sensitive detector
3. FEA is Finite Element Analysis. ANSYS is the software used.
4. OPD is Optical Path Difference.
5. Sol-gel is an anti-reflection lens coating..

100